


- B.M. 127.82 Top S-End W-Pump Island Filling
- Sta. NE cor. Hillside & Harry
- B.M. 107.77 NE Cor. Conc. base Signal Lite
- SE cor. G.W. B. & Harry
- B.M. 129.22 "M" in Mueller F. Plug NE cor.
- Harry & Hillside
- B.M. 107.77 NE cor. conc. base Signal Lite
- SE cor. G.W. Blvd. & Harry
- B.M. 109.26 "M" Top N. cb Osie at W-Ret. NW
- of Osie & Geo. Wash. Dr.

Floor CoCa Cola Bldg.  
50' E. of S.W. cor.  
107.71

Plan Scale 1"=40'  
Profile Scale 1"=5' Vert.

NOTE:  
Saw joint.  
Replace pavement to  
City of Wichita specifications.

NOTE TO CONTRACTOR  
This project will be constructed under  
the supervision of the CITY ENGINEER  
and conforming to the SPECIFICATIONS  
of the CITY OF WICHITA. The CON-  
TRACTOR will reimburse the City of  
Wichita for all cost of Engineering, Plans,  
and Inspection.

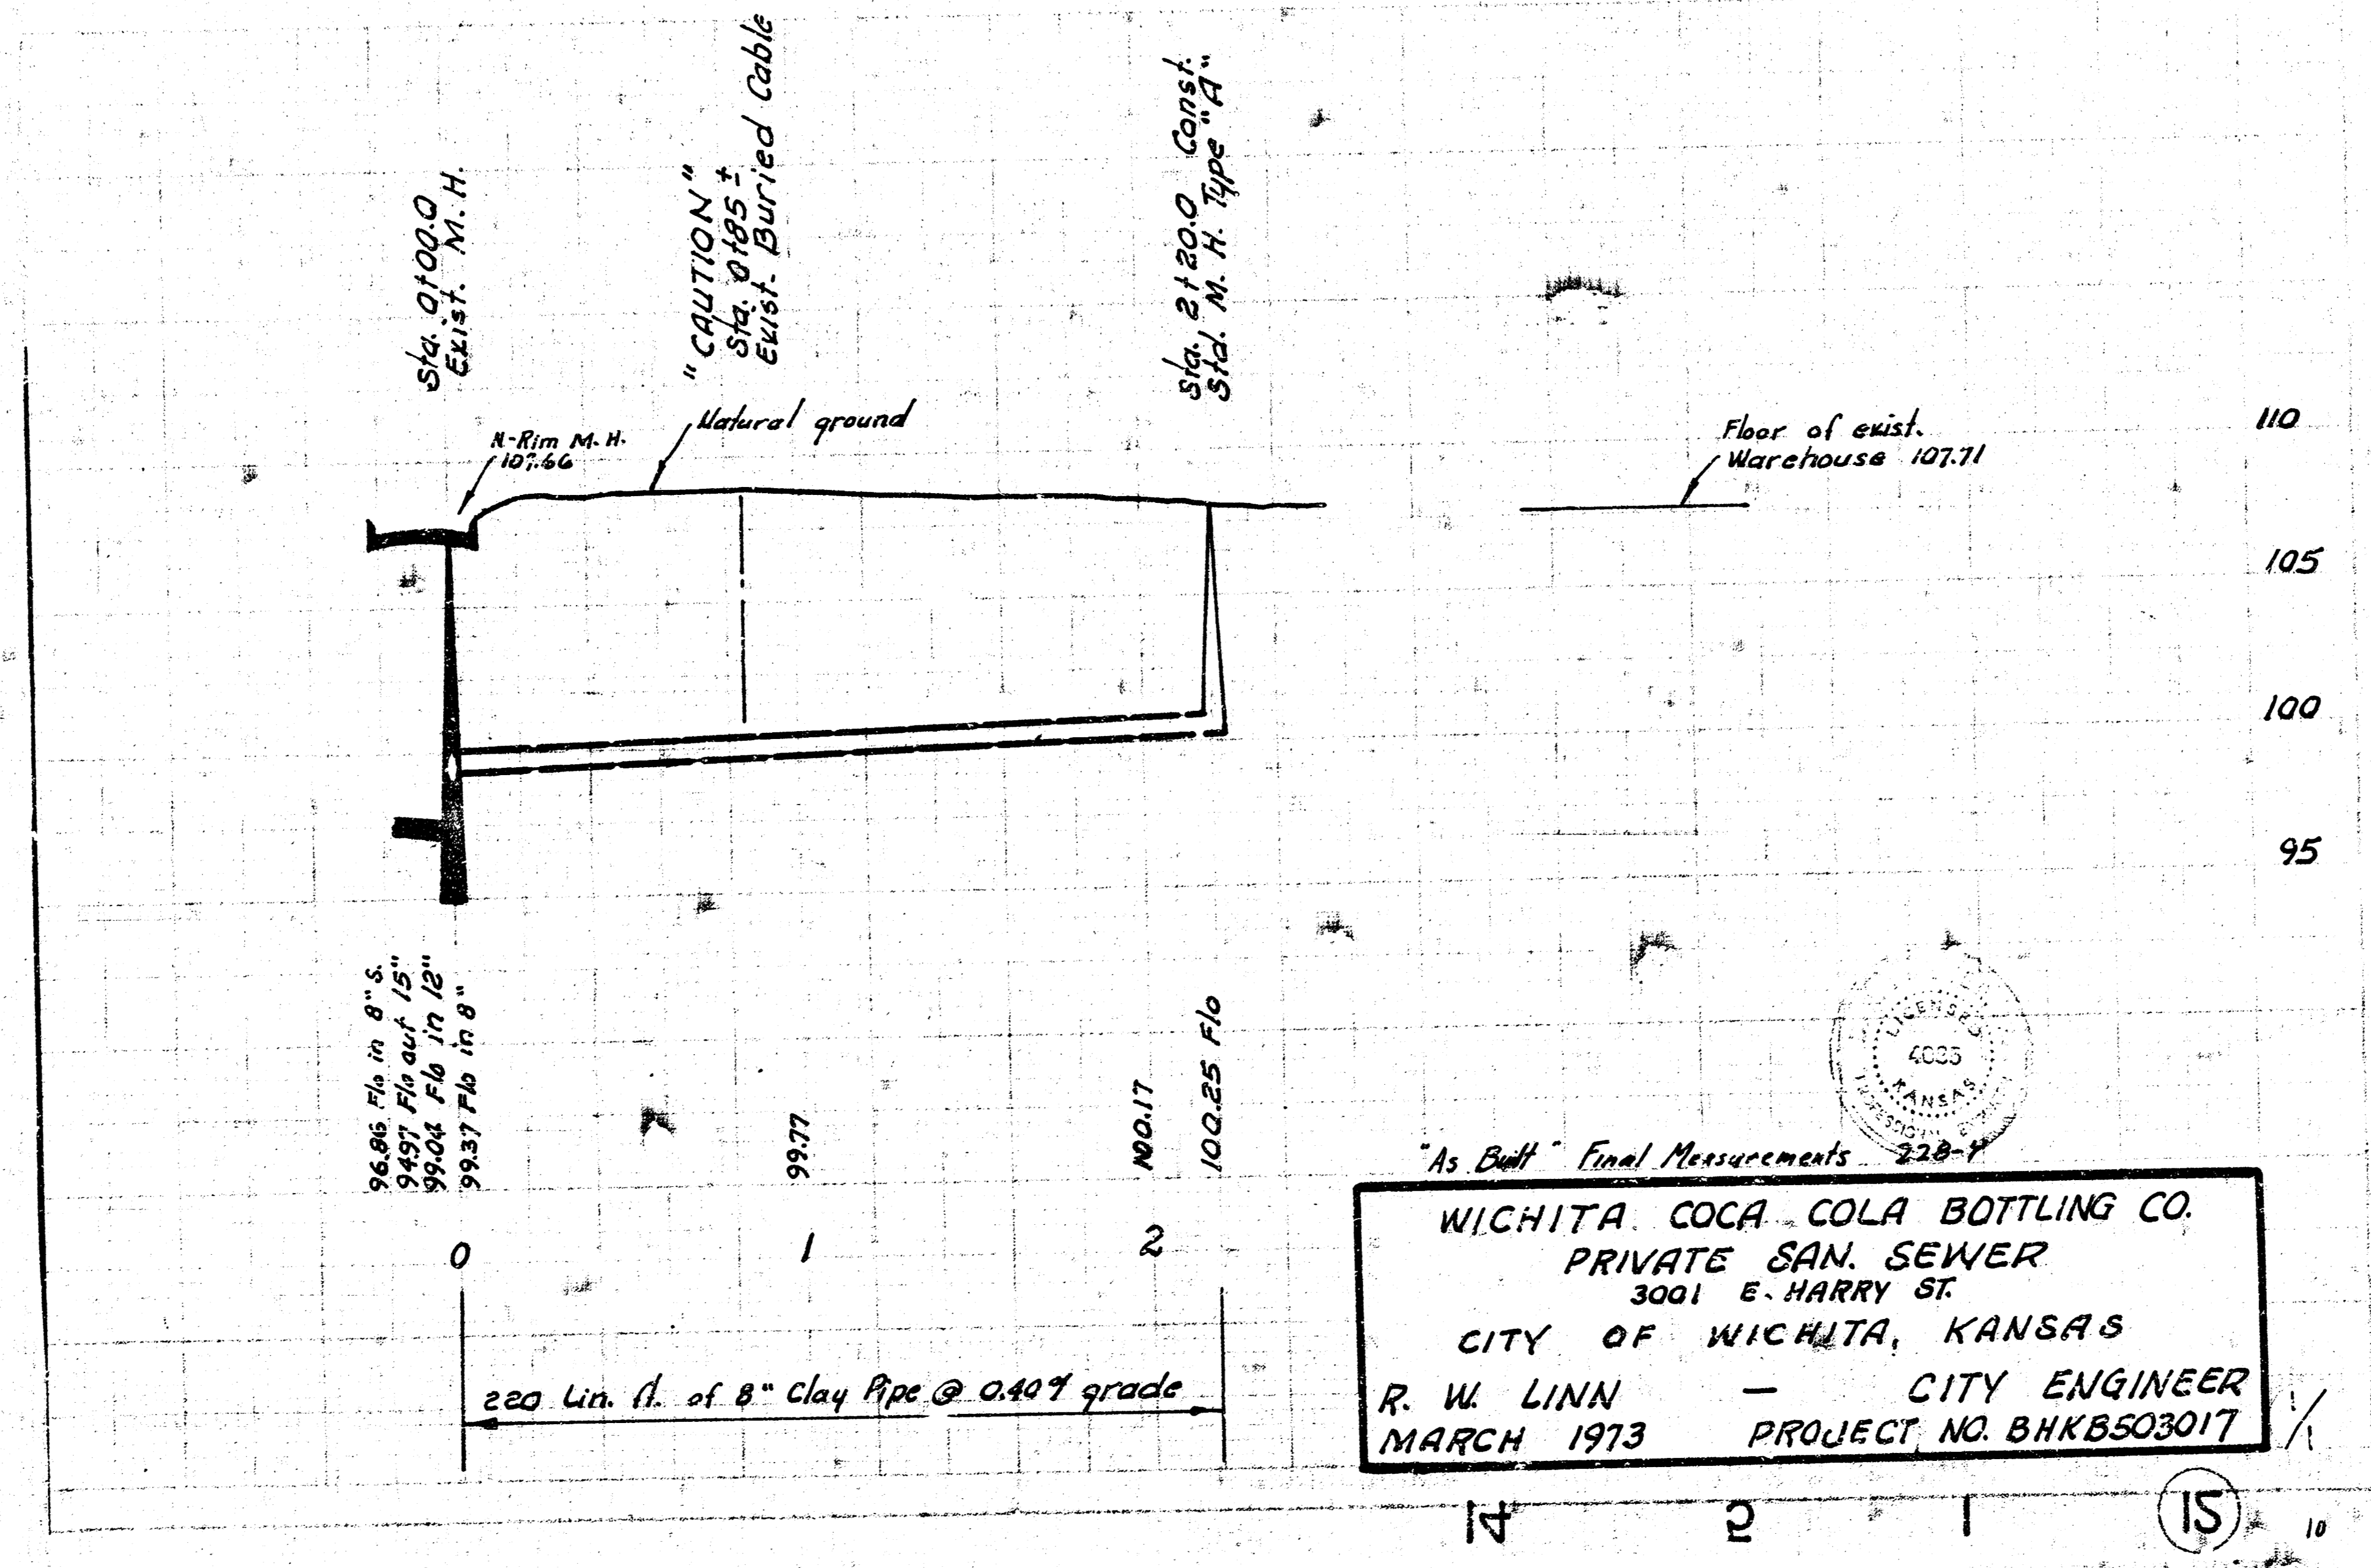

As Built Final Measurements 228-P  
**WICHITA COCA-COLA BOTTLING CO.**  
**PRIVATE SAN. SEWER**  
 3001 E. HARRY ST.  
 CITY OF WICHITA, KANSAS  
 R. W. LINN — CITY ENGINEER  
 MARCH 1973 PROJECT NO. BHKBS03017