
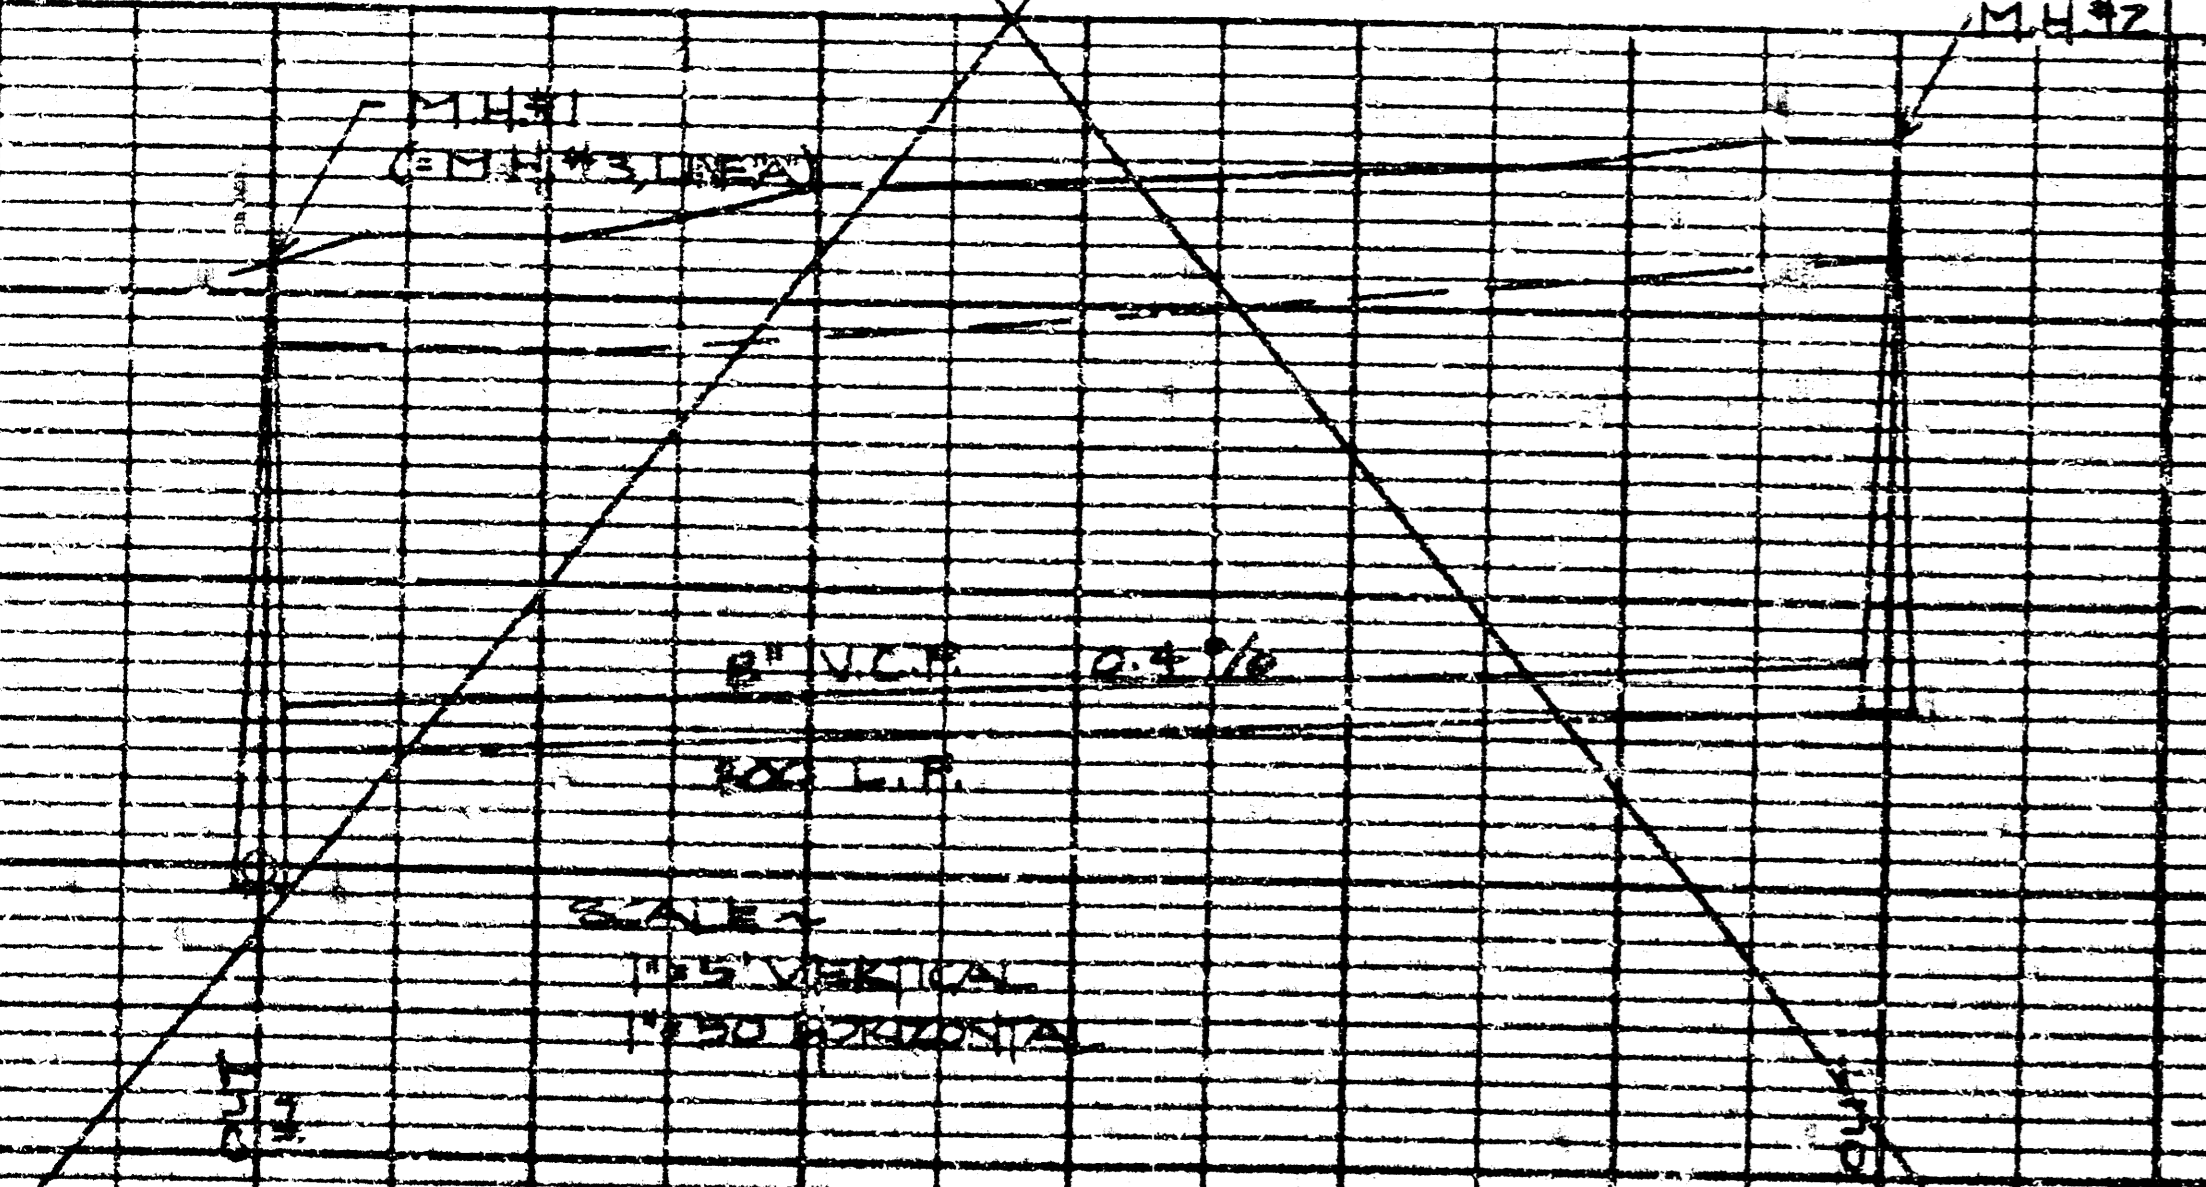


REVISED 3-17-77 J.W.H.

NOTE: ALL SANITARY SEWER TO BE CONSTRUCTED TO CITY OF WIGHTA STANDARDS AND SPECIFICATIONS

LINE 'B' DELETED. 3-17-77

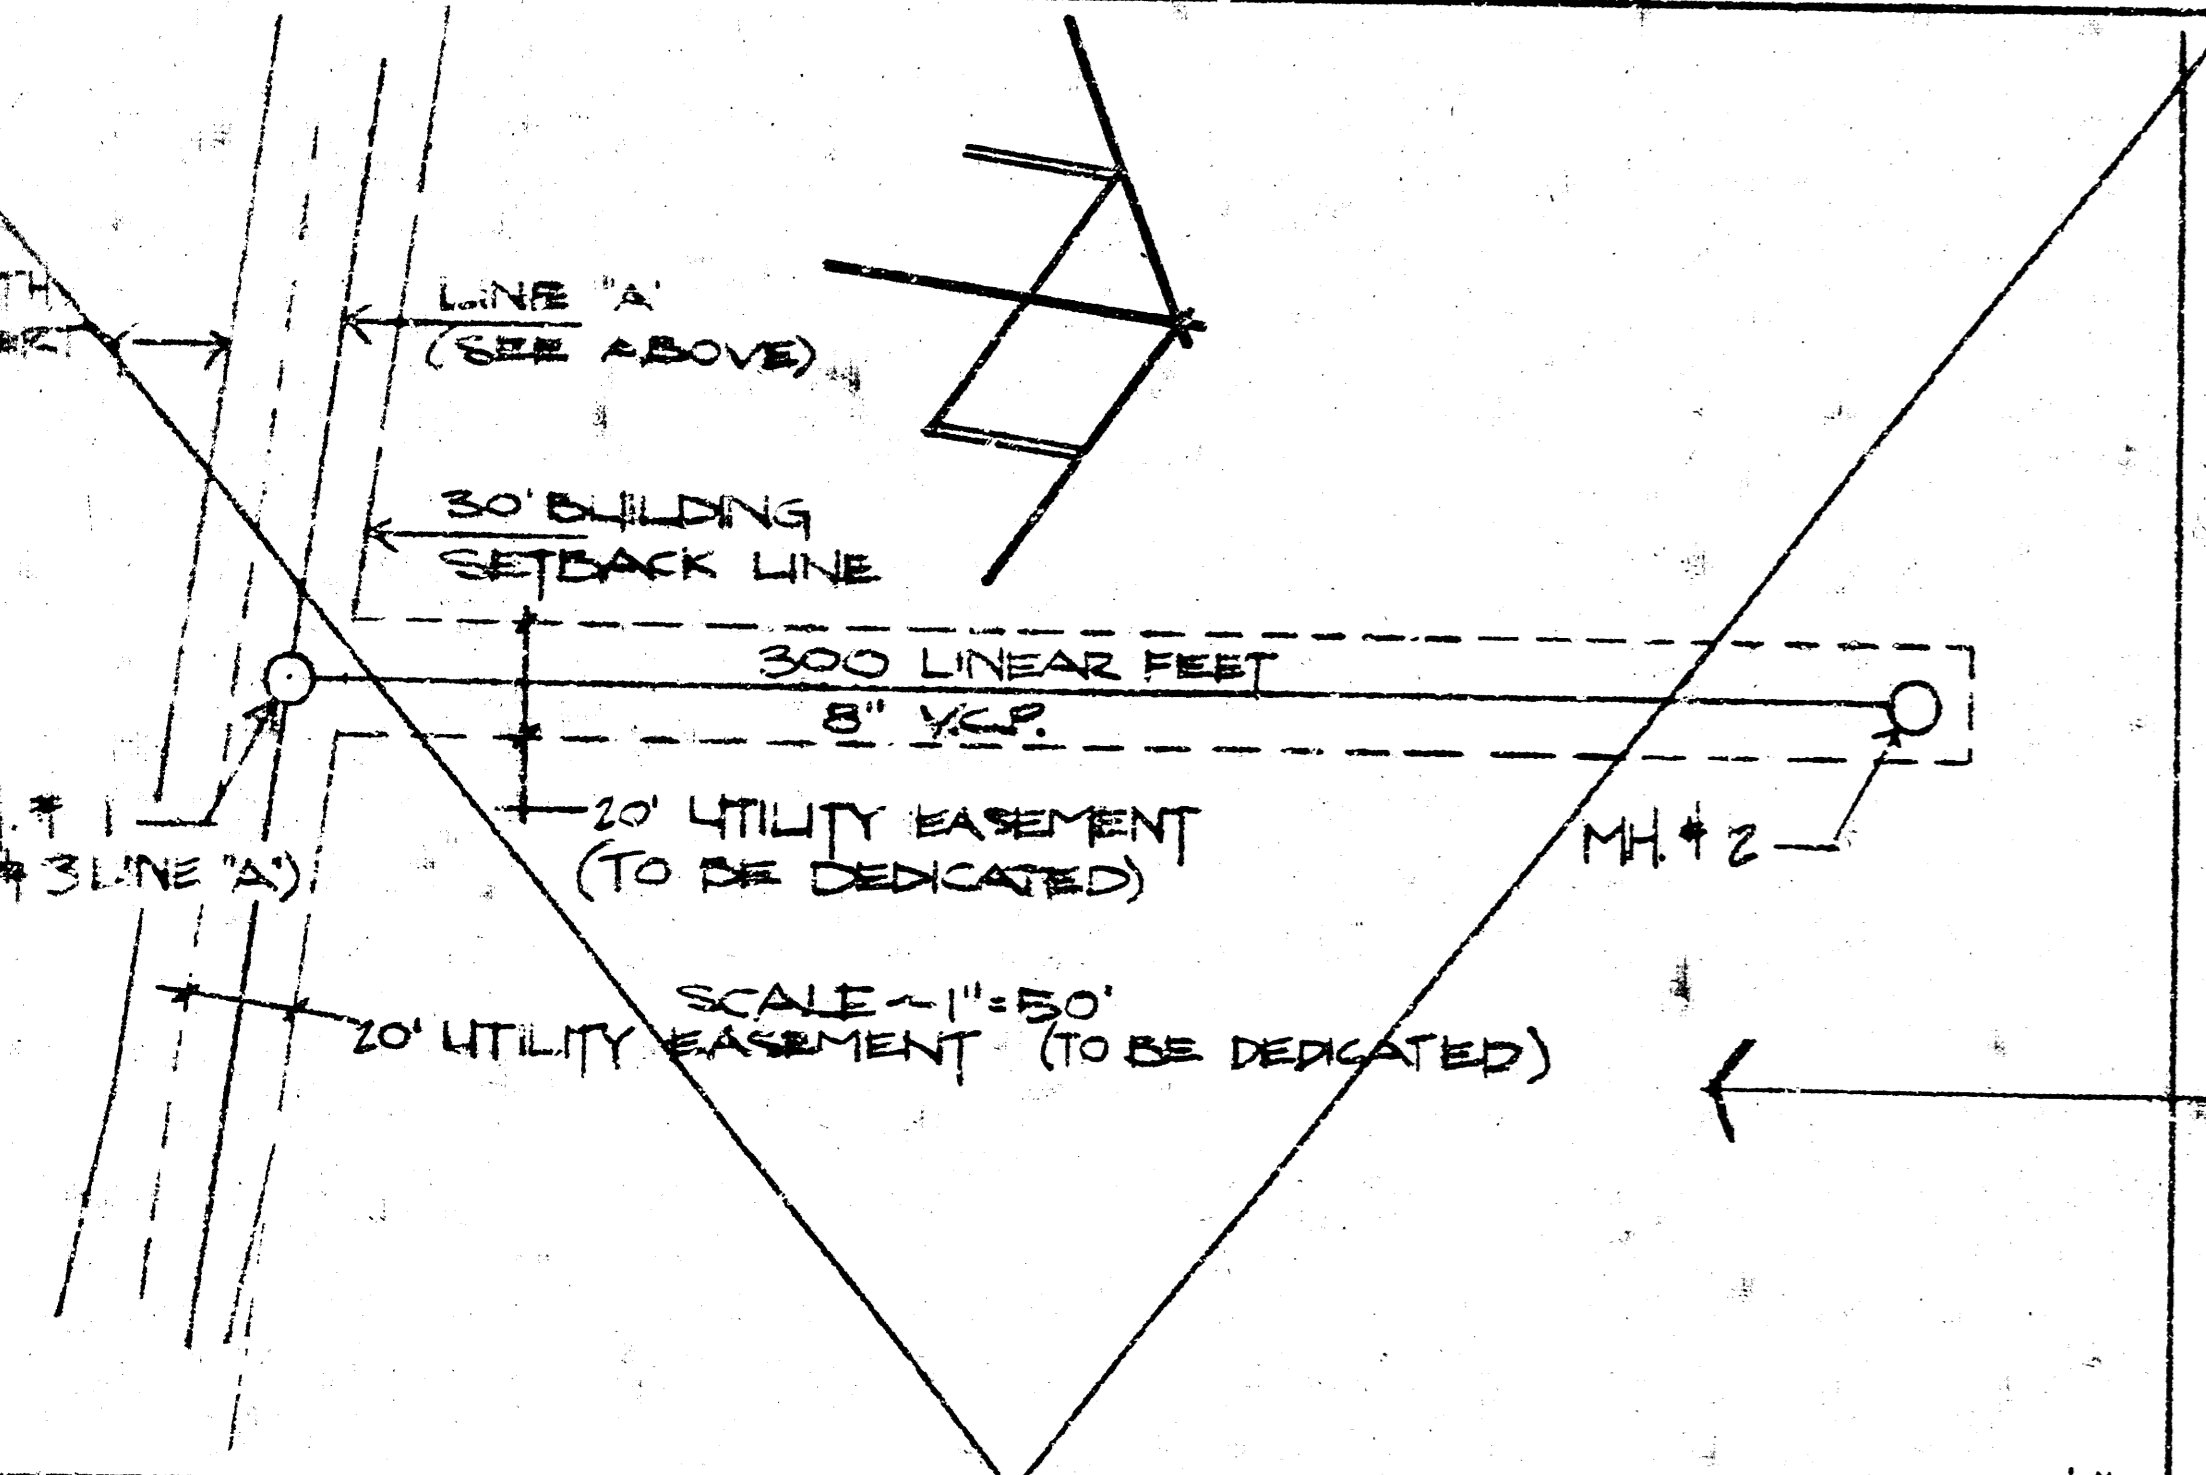

MOUNT CARMEL BUILDINGS