

# SANITARY SEWER

## LATERAL 34 MAIN 5A WAR INDUSTRIAL SEWER IN ROCKWOOD SOUTH 5<sup>TH</sup> ADD.

PROJ. NO. 468-76-245-80787-000-000-001


CITY OF WICHITA, KANSAS

DEPT. OF PUBLIC WORKS — ENG. DIV.

DEAN SELLERS, ACTING CITY ENGINEER

BY LAW/KINGDON, P.A., WICHITA, KANSAS

DATE: \_\_\_\_\_

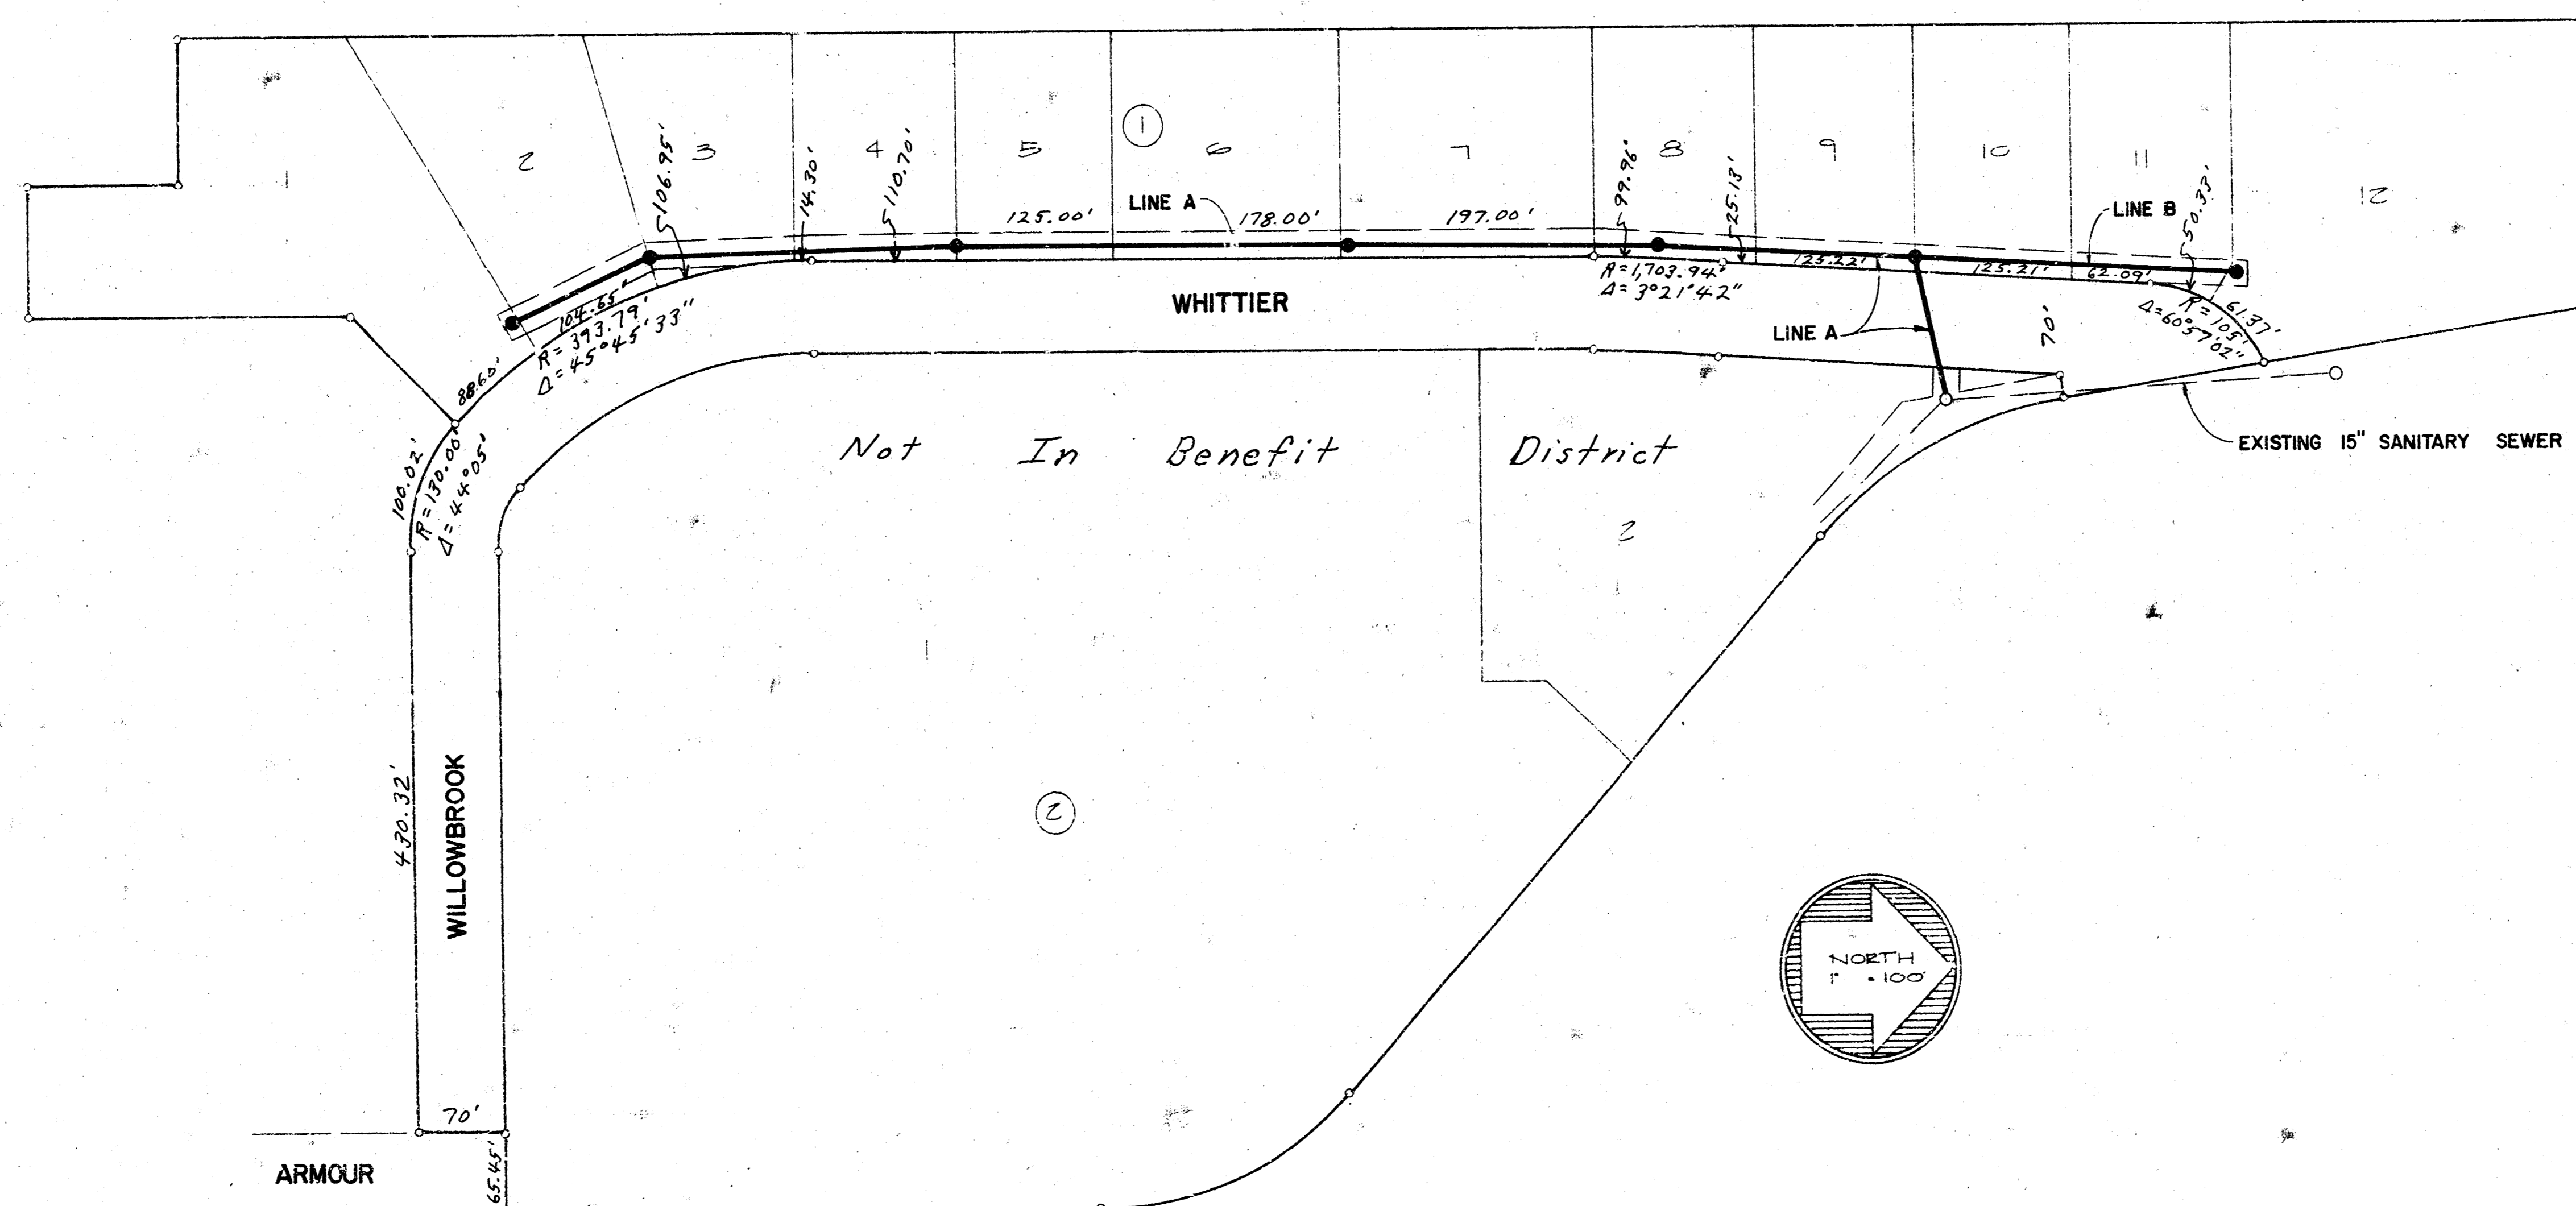

As Built  
4/8/81  
JJS

