



B.M. 167.28 City Std. Central And W. Pkwy.
 B.M. 163.36 "M" Muller Fire Hyd. @ #2 W. Pkwy.
 B.M. 164.62 "M" Muller Fire Hyd. @ #6 W. Pkwy.
 B.M. 157.21 Top Brick N.W. Cor. S. Light Brick Hubgd.
 To Drive #8 W. Pkwy.

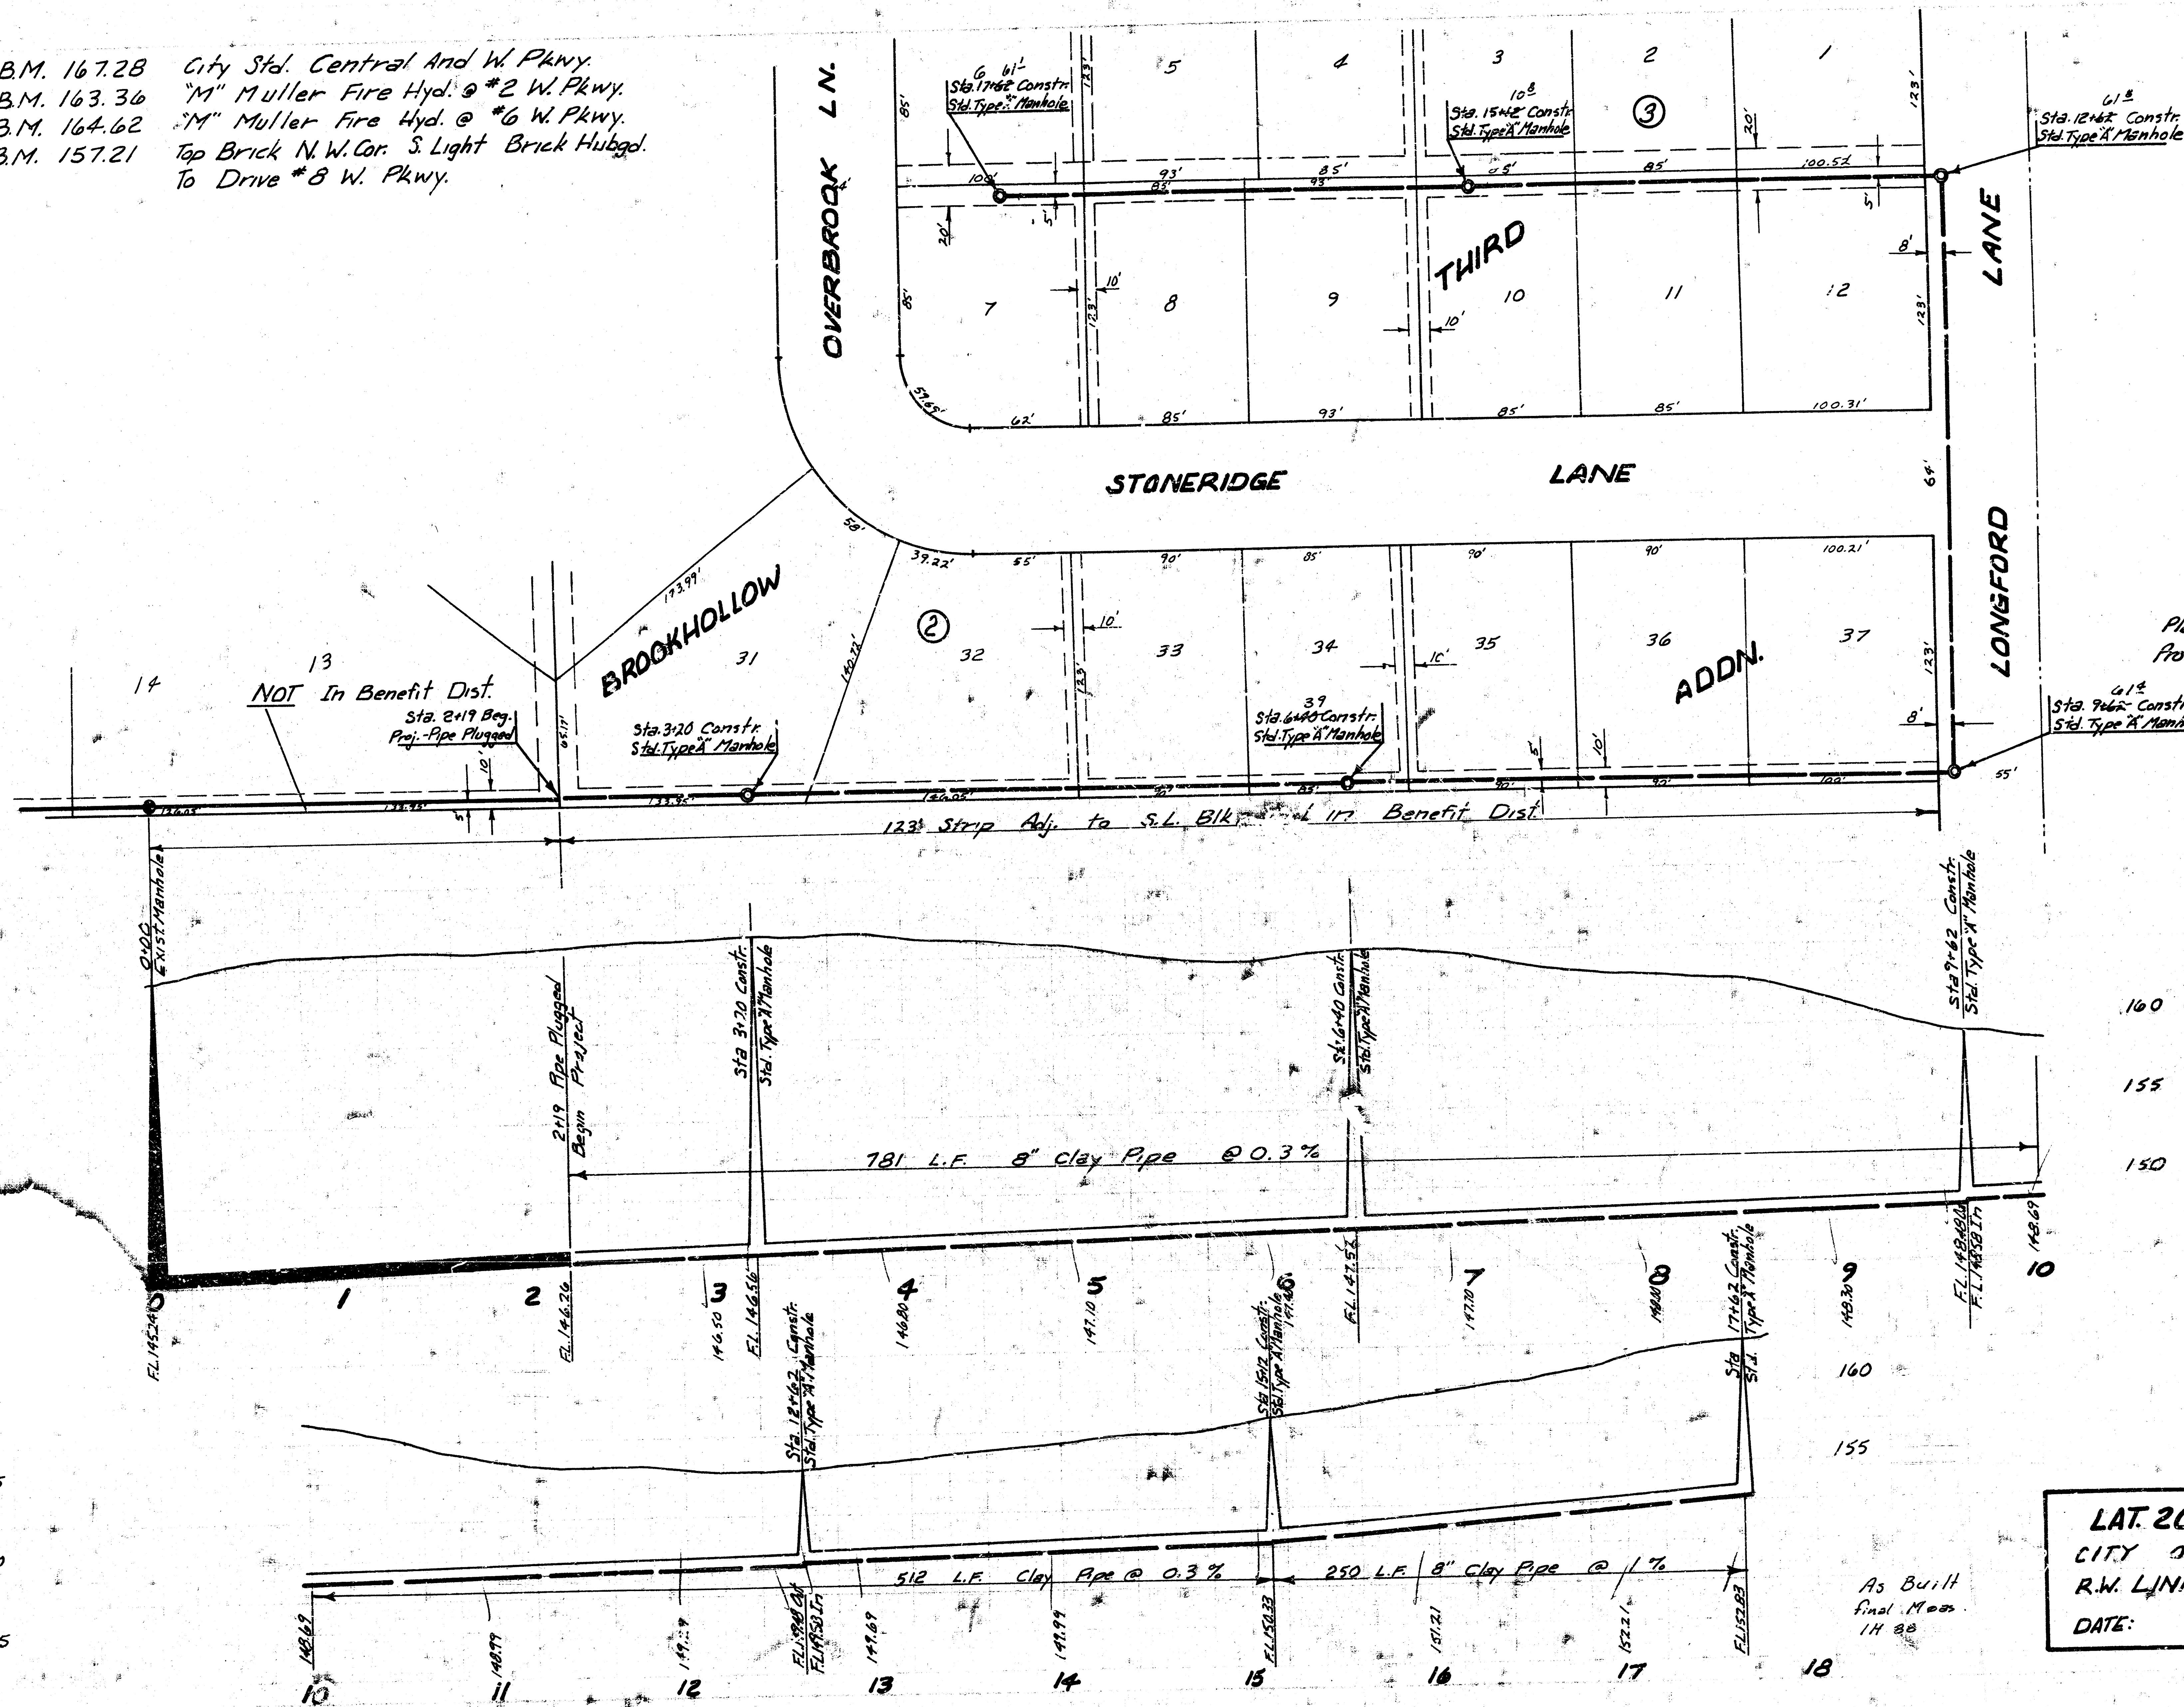

Plan Scale: 1" = 40'
 Profile Scale: 1" = 40' Horiz.
 1" = 5' Vert.

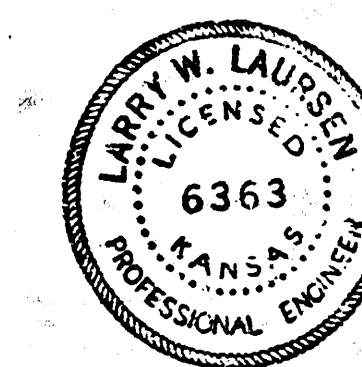

LAT. 20, MAIN 9, W.I.S.
 CITY OF WICHITA, KS.
 R.W. LINN - CITY ENGINEER
 DATE: PROJ. NO. DBKL57304B

As Built
 Final Meas.
 14 88

FILMED FROM THE REAR