


B.M. 161.28 City Std. Central And W. Pkwy.
 B.M. 163.36 "M" Muller Fire Hyd. @ #2 W. Pkwy.
 B.M. 164.62 "M" Muller Fire Hyd. @ #6 W. Pkwy.
 B.M. 151.21 Top Brick N.W. Cor. S Light Brick Hdbgd.
 To Drive #8 W. Pkwy.

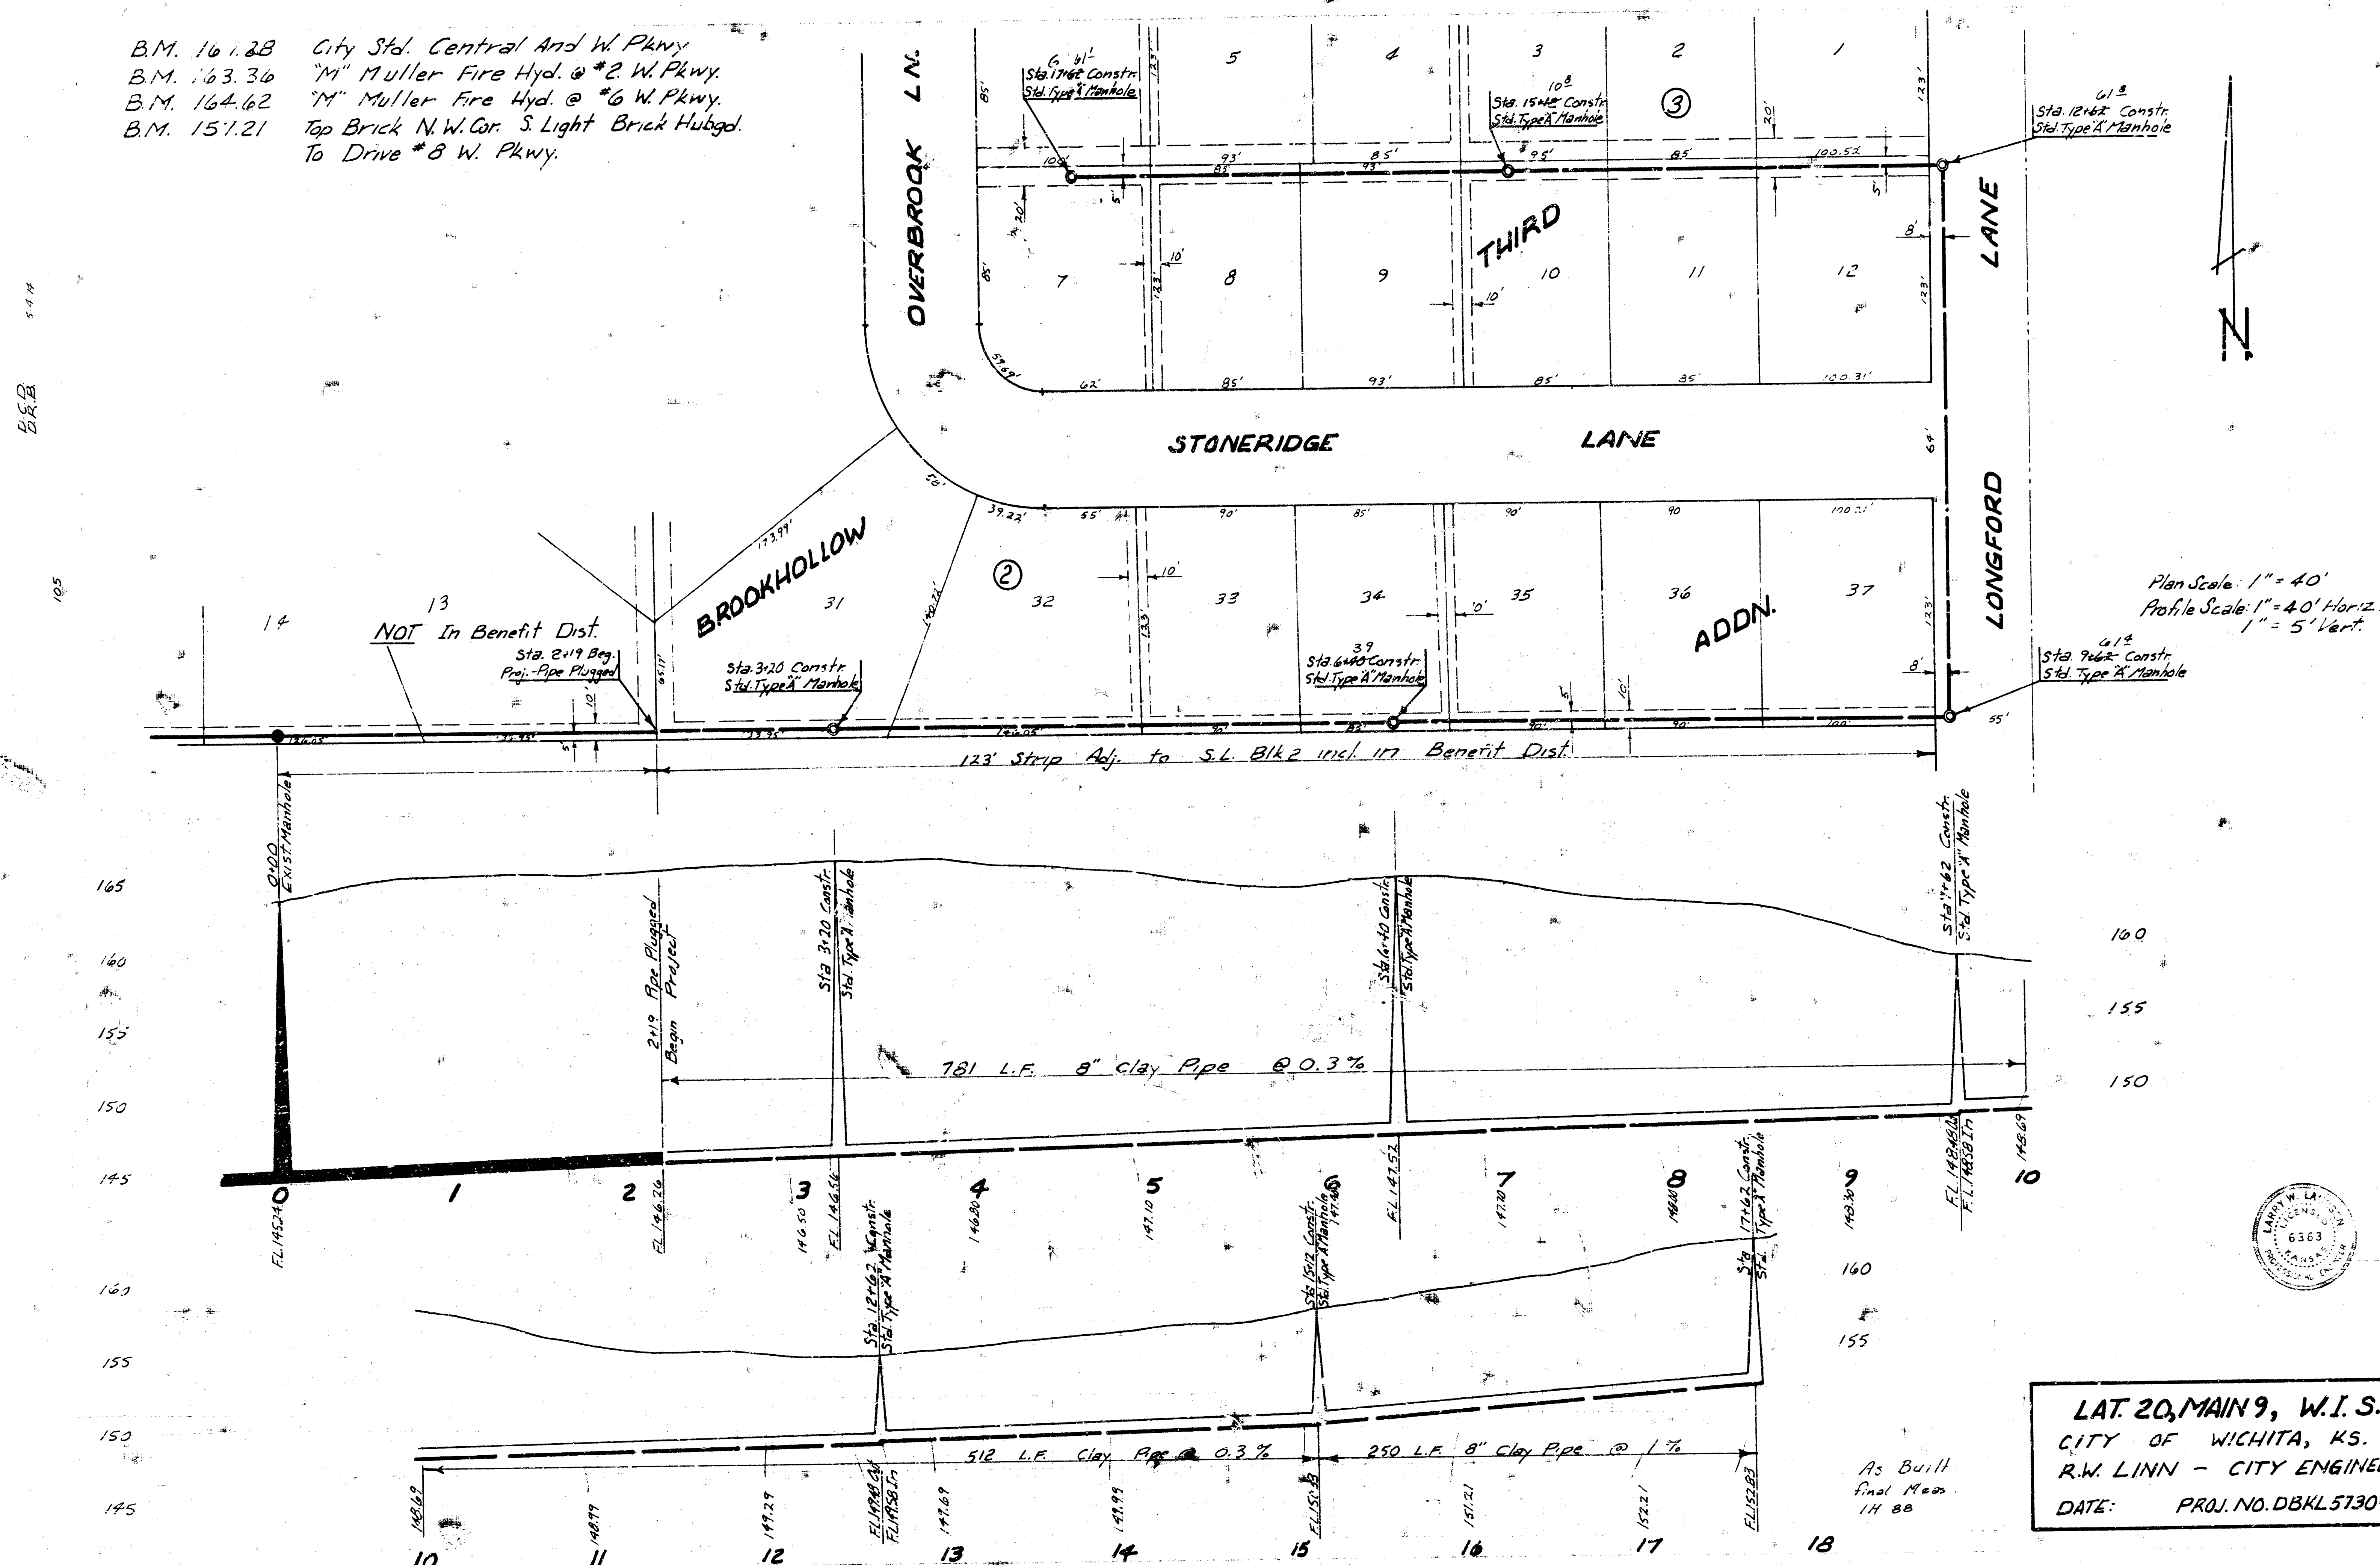

LAT. 20, MAIN 9, W.I.S.
 CITY OF WICHITA, KS.
 R.W. LINN - CITY ENGINEER
 DATE: PROJ. NO. DBKL 573048