


Plan Scale 1"=40'
 Profile Scale Horiz. 1"=40'
 Vert. 1"=5'

170
 160
 150
 140

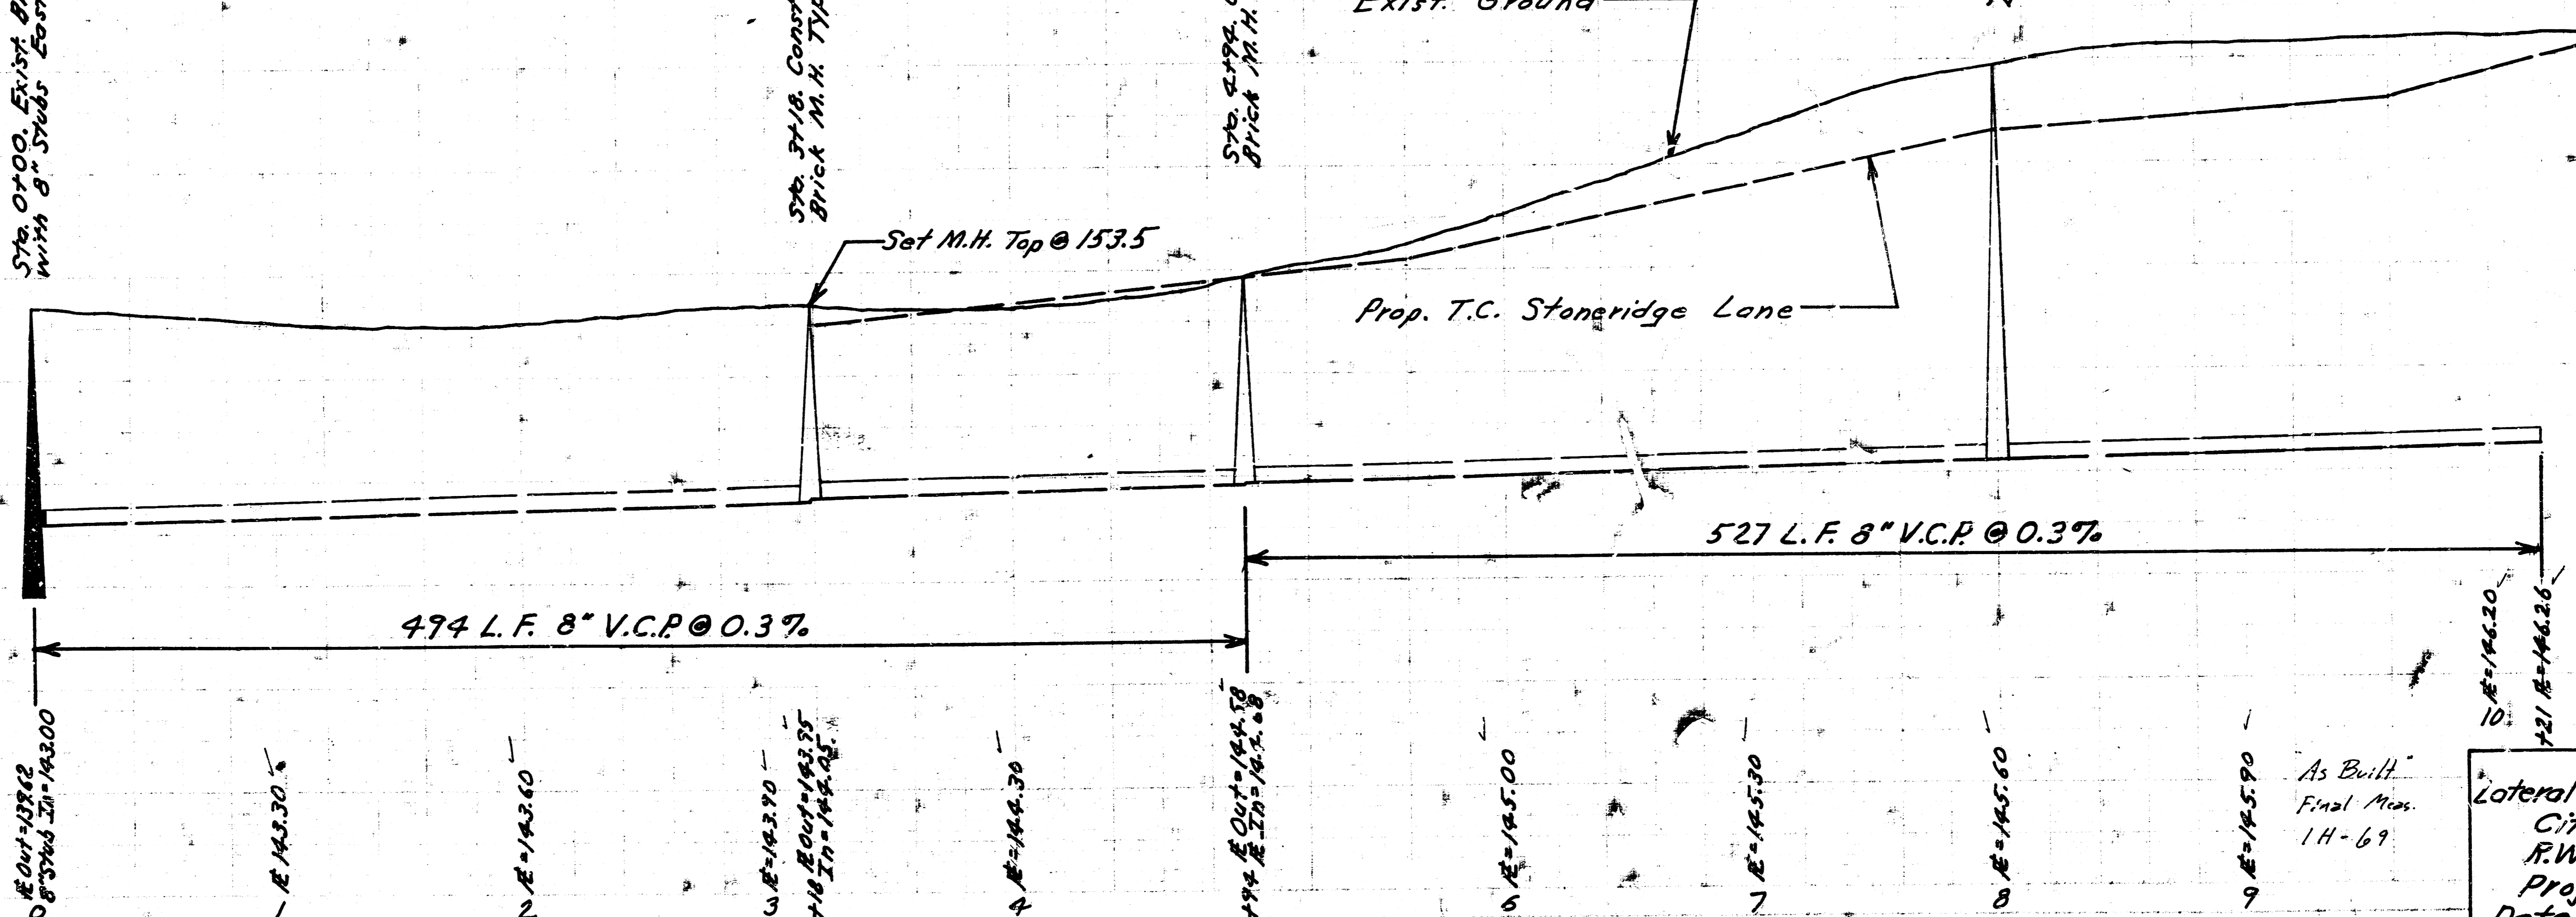

As Built
 Final Plans
 14-69
 Lateral 21, Main 9, War Ind. Sewer
 City of Wichita, Kansas
 R.W. Linn, City Engineer
 Proj. No. DBKL 573047
 Date: Dec. 1973 Sh. No. 1 of 1

FILMED FROM THE BEST AVAILABLE COPY