


B. M. 167.69 Rock Rd. & Central City B. M.
 a chiseled on S.E. cor. conc. valve
 box NW cor. intersection S. N. of N.
 cb on Central.


B. M. 156.23 set a chiseled on S.E. cor
 conc. pkg. lot behind Privy Shop
 366 Rock Rd.

Sta. 0100.0 Const.
 Std. M. H. Type "A"
 over exist. 12" S.S.

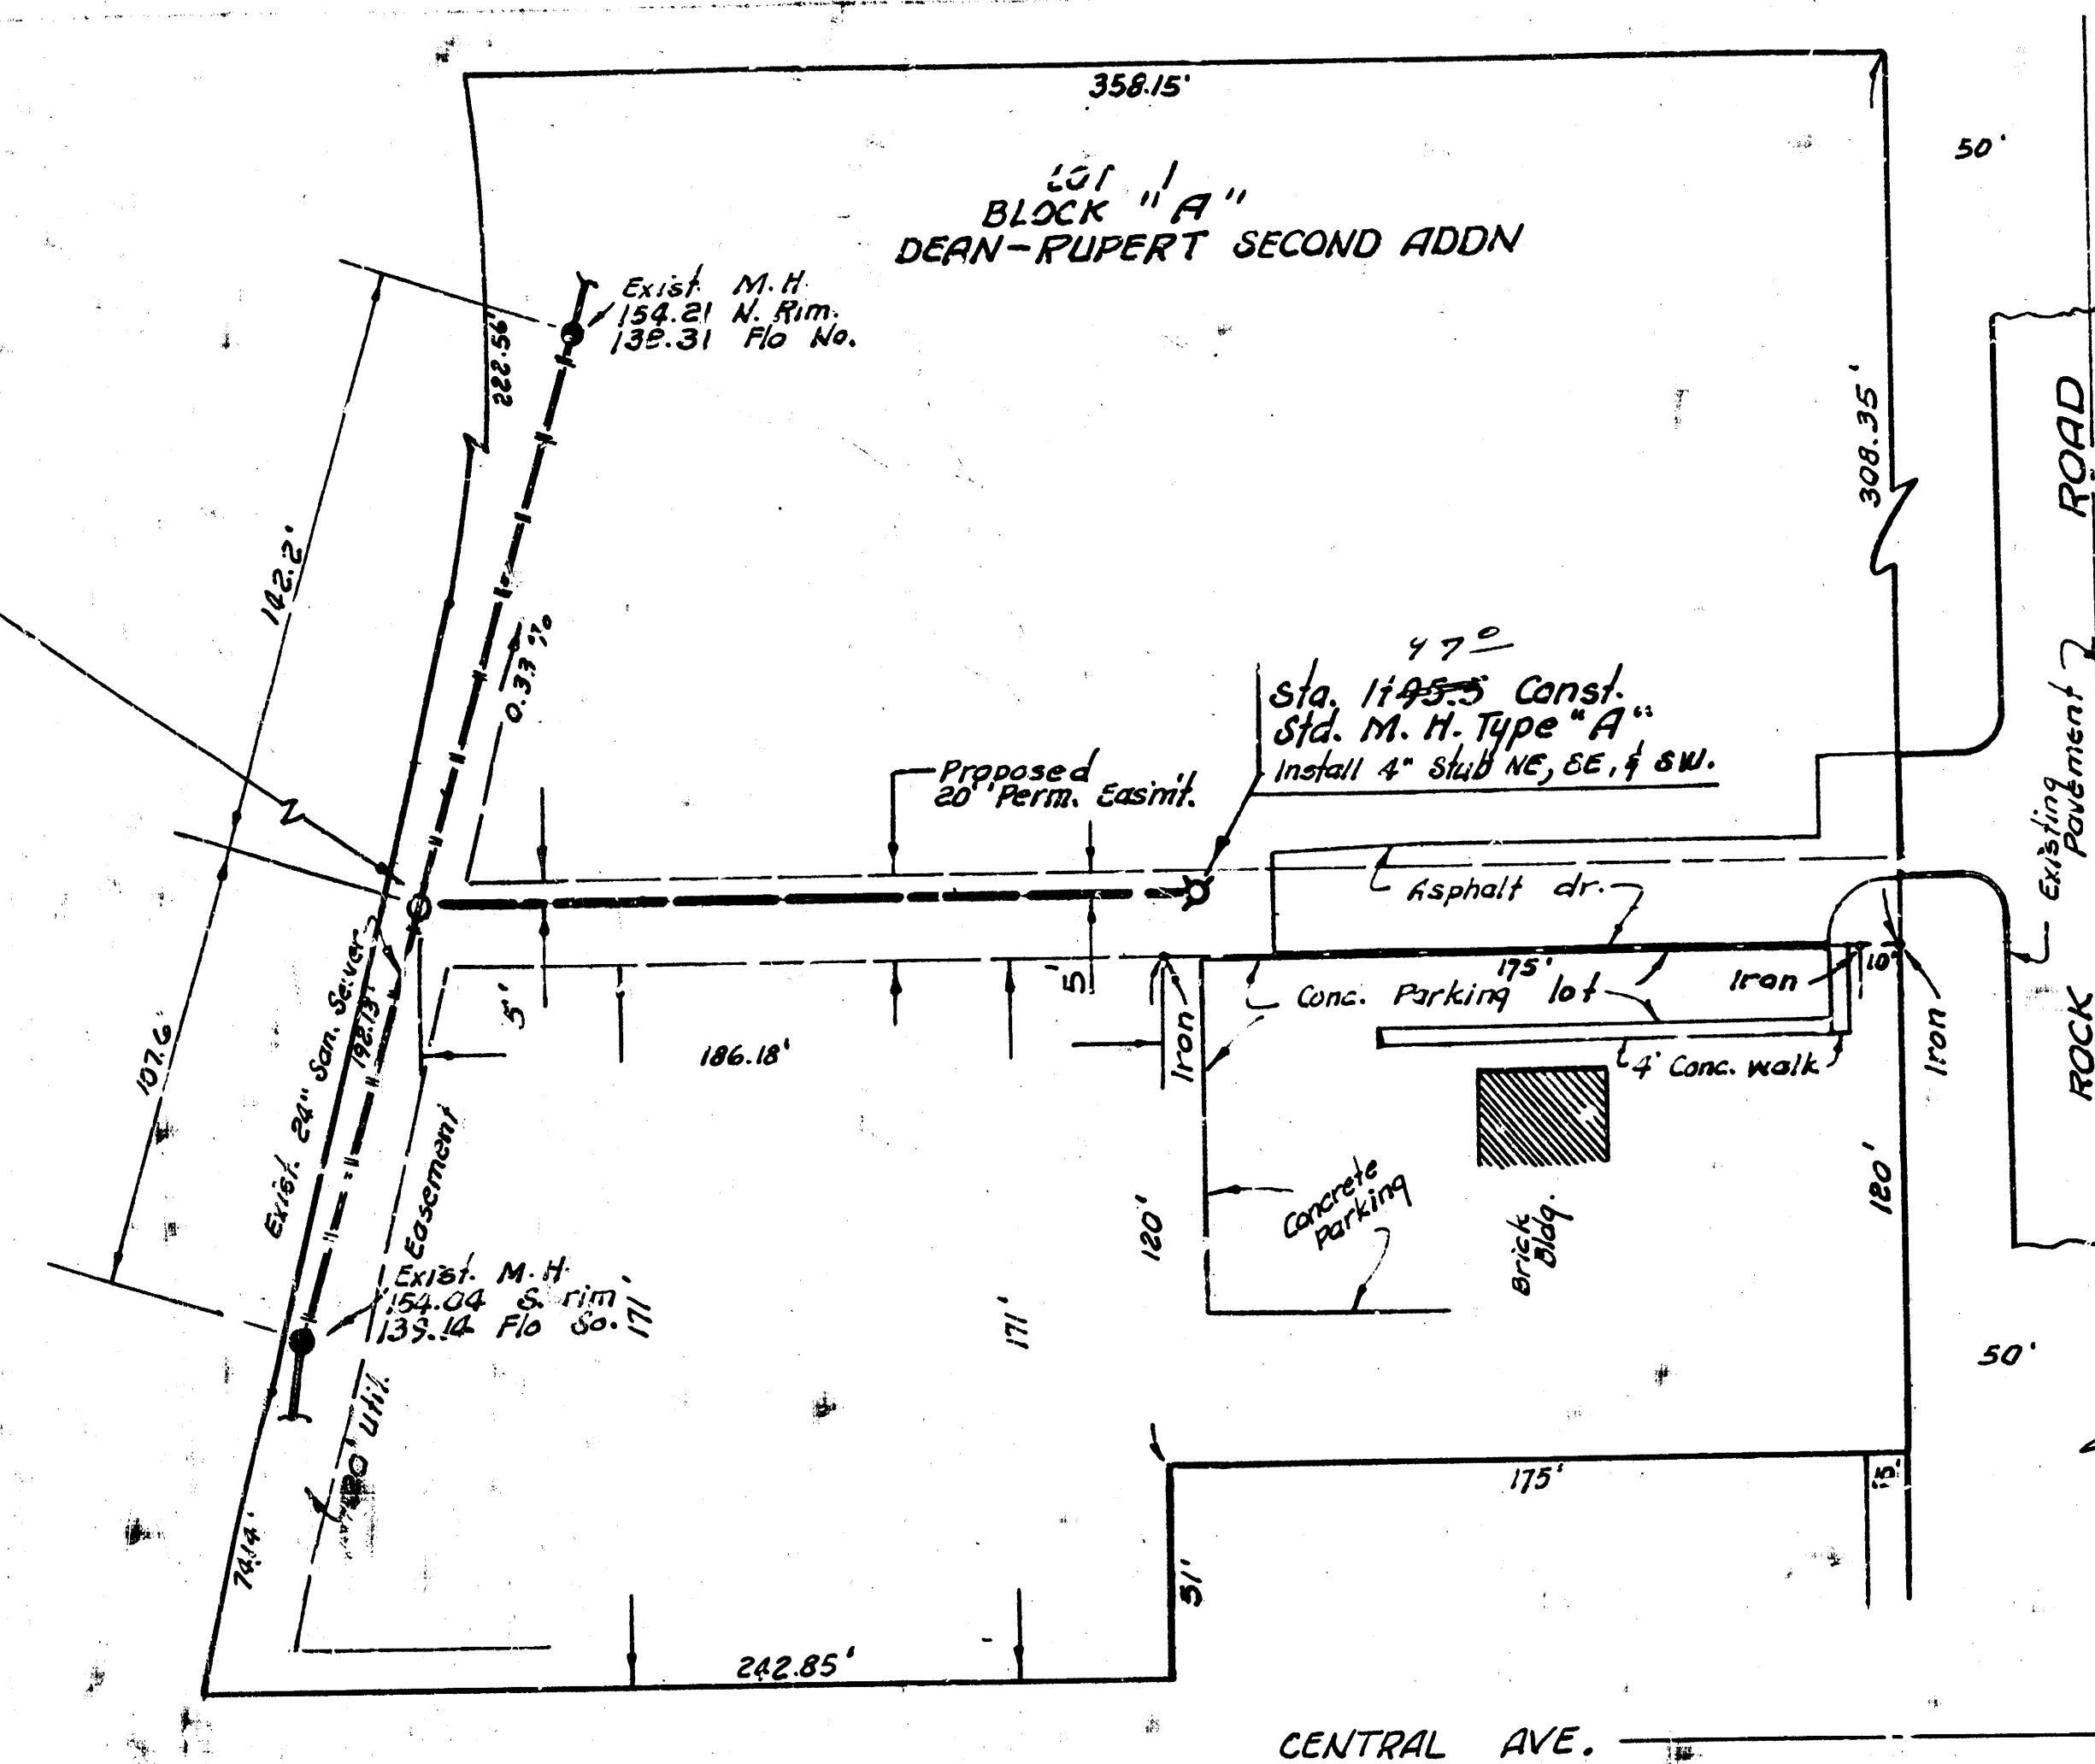


Sta. 0100.0 Const.
 Std. M. H. Type "A"
 over exist. 12" S.S.

Sta. 1495.5 Const.
 Std. M. H. Type "A"
 install 4" slab NW, SE, & SW.

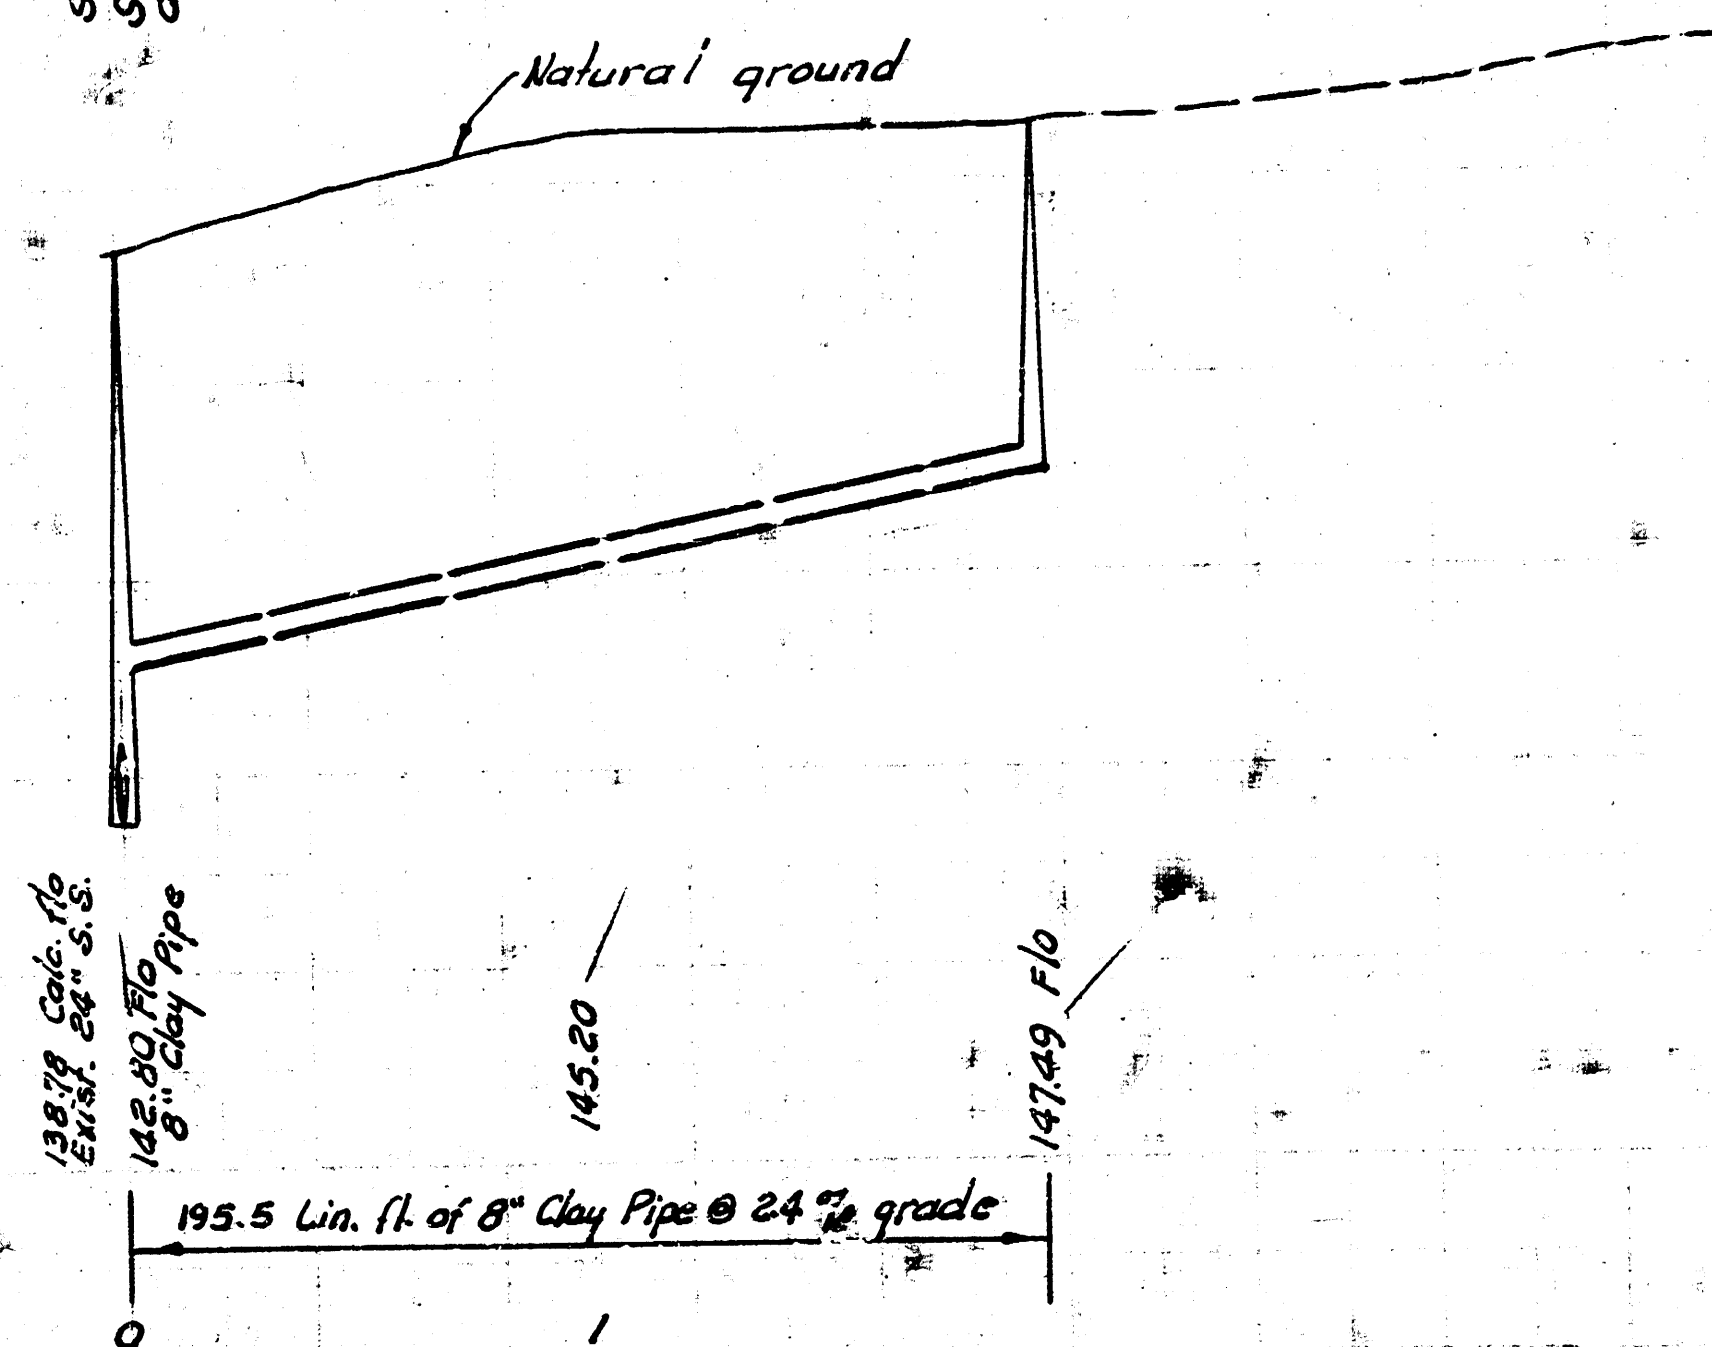

Plan Scale 1" = 40'
 Profile Scale 1" = 5' Vert.

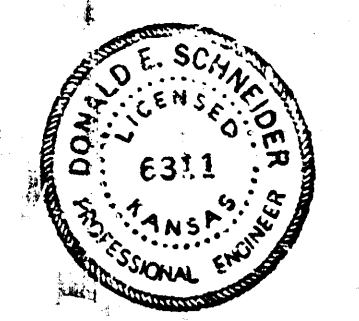

As Built Final Plans 7-1-75
 LAT. 22, MAIN 9, W. I. S.
 CITY OF WICHITA, KANSAS
 R. W. LINN — CITY ENGINEER
 MAR. 1974 PROJECT NO. DBKL574007

FILMED FROM THE BEST
 AVAILABLE COPY