


B. M. 167.69 Rock Rd. & Central City B. M.  
 a chiseled on S.E. conc. conc. valve  
 box NW cor. intersection S.N. of N.  
 cb on Central.

B. M. 156.23 set a chiseled on S.E. cor  
 conc. pkg. lot behind Privy Shop  
 366 # Rock Rd.

Sta. 01000 Const.  
 Sid. M. H. Type "A"  
 over Exis. 24" S.S.

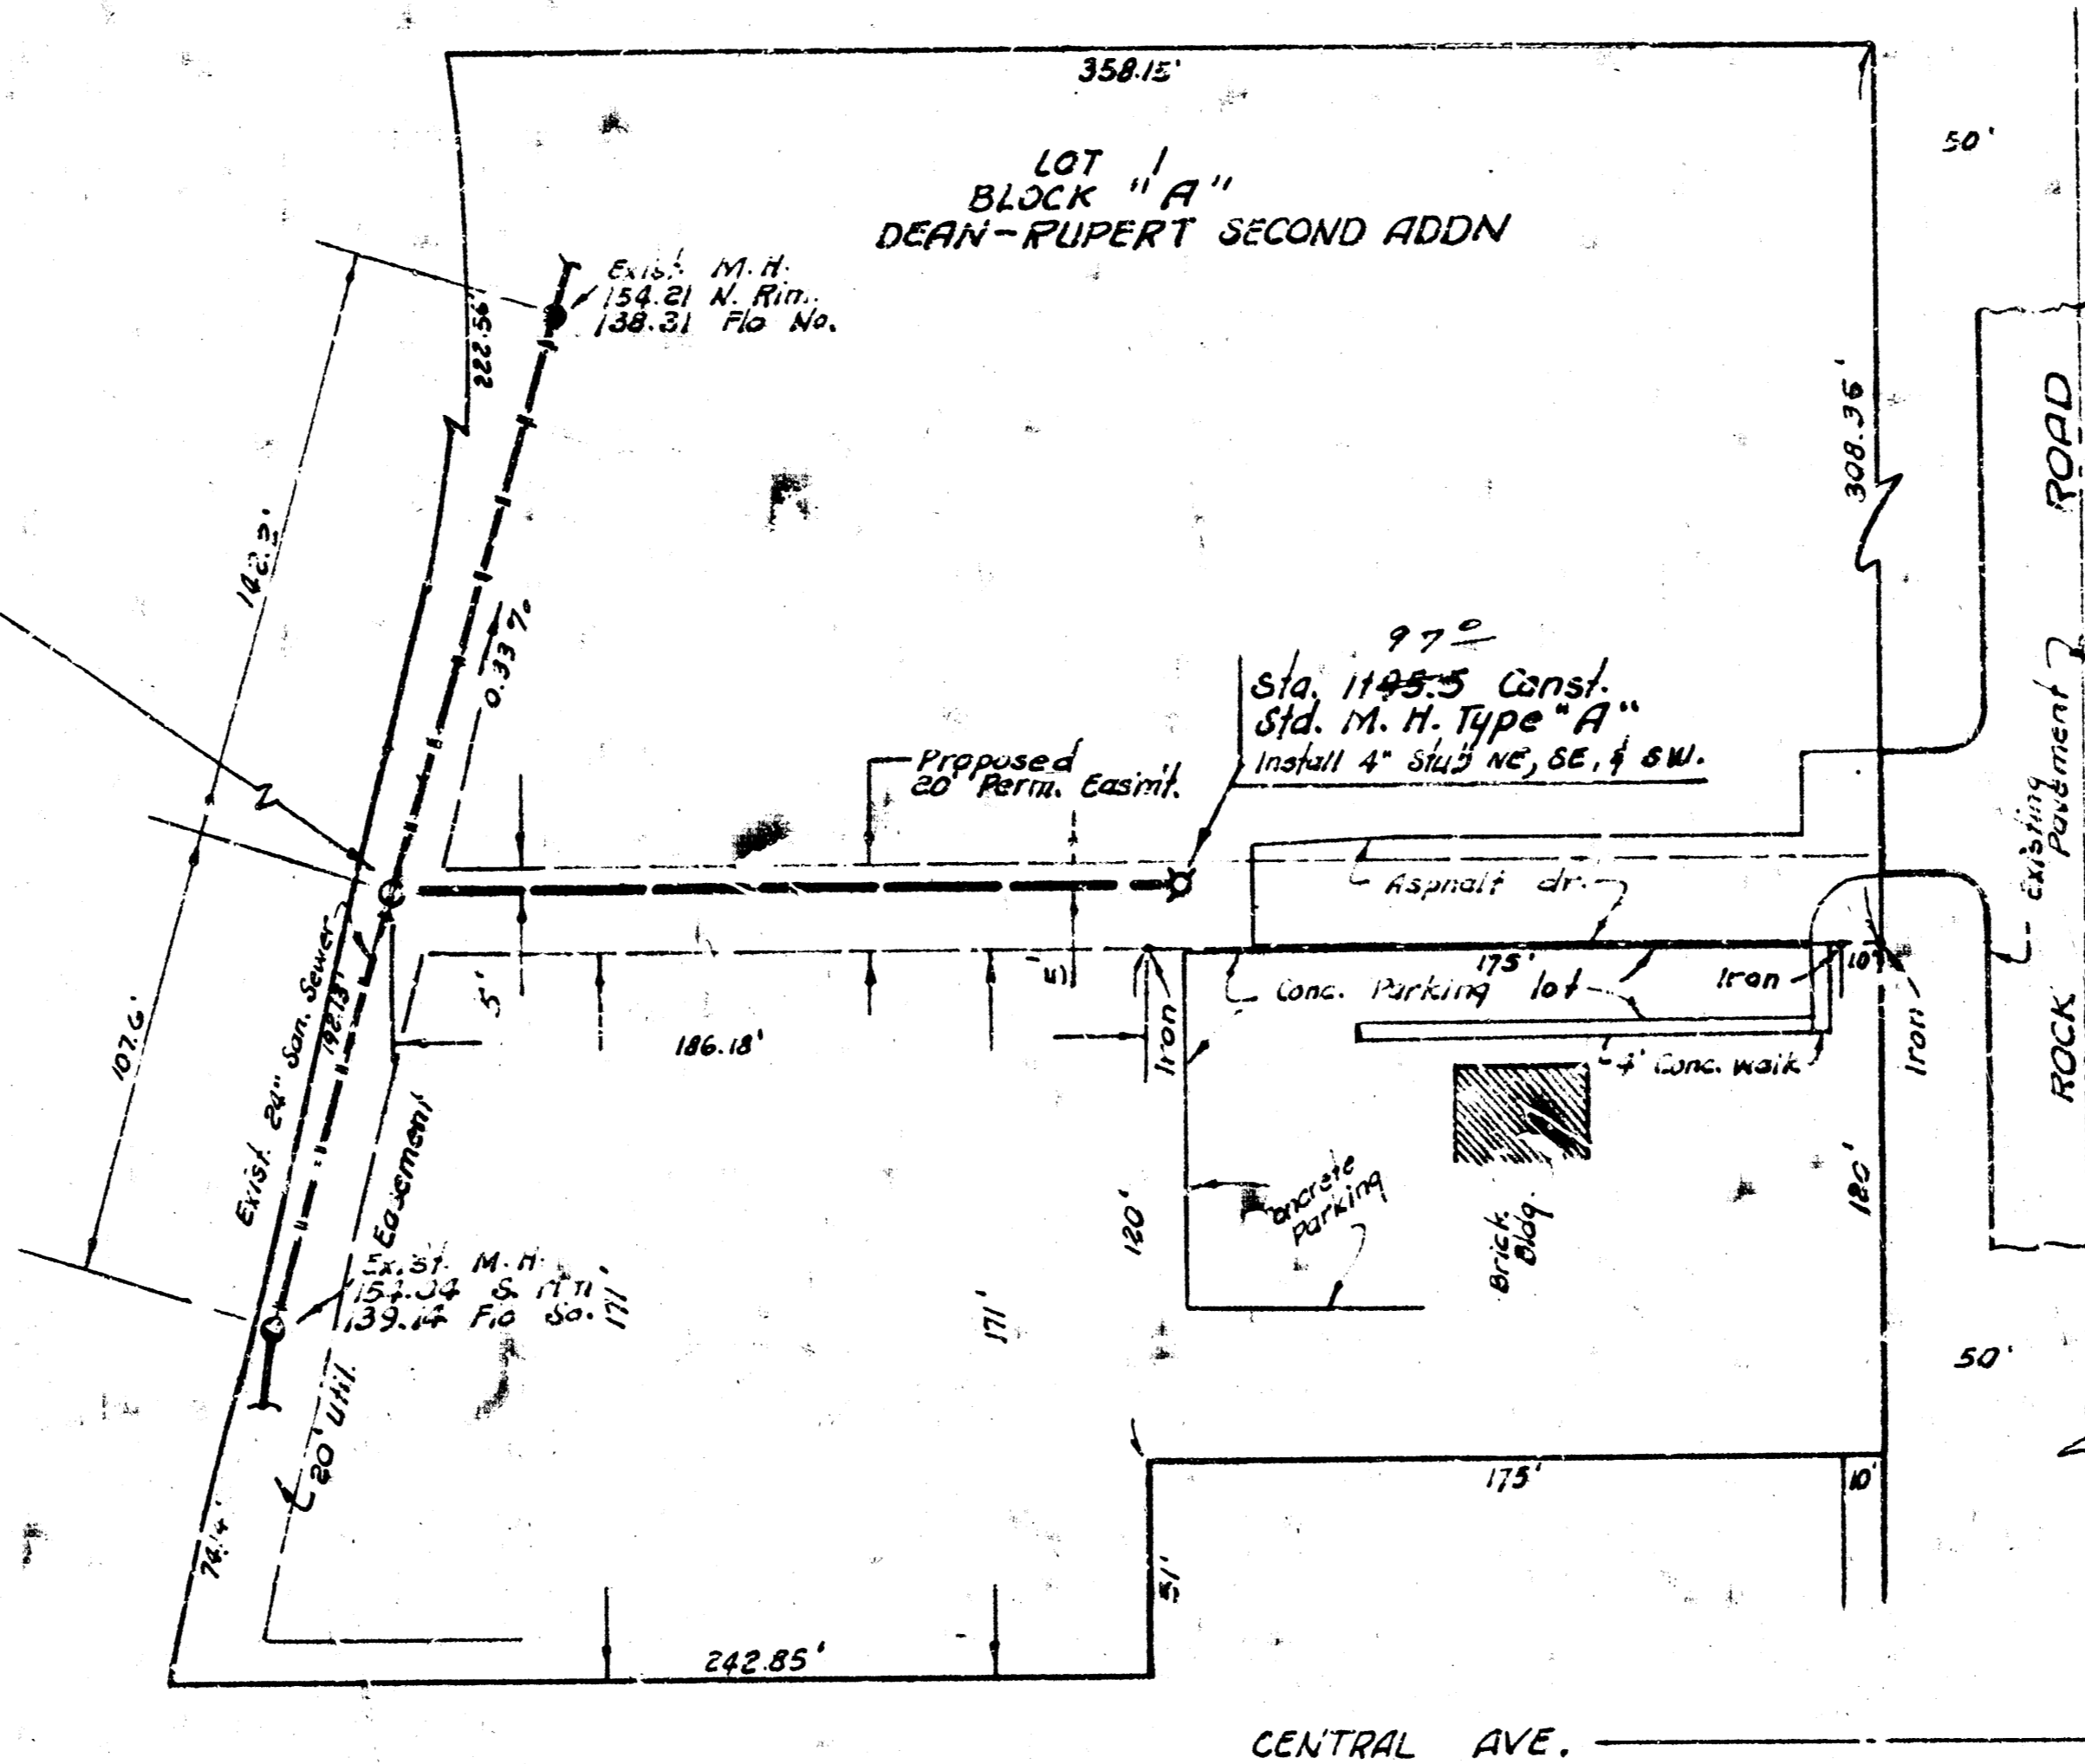


Plan Scale 1" = 40'  
 Profile Scale 1" = 40' Horiz.  
 1" = 5' Vert.

A.R.W.  
 76

Sta. 01000 Const.  
 Sid. M. H. Type "A"  
 over Exis. 24" S.S.

Sta. 1195.5 Const.  
 Sid. M. H. Type "A"  
 install 4" sub. we. & sw.

140  
 155  
 150  
 145  
 140  
 135

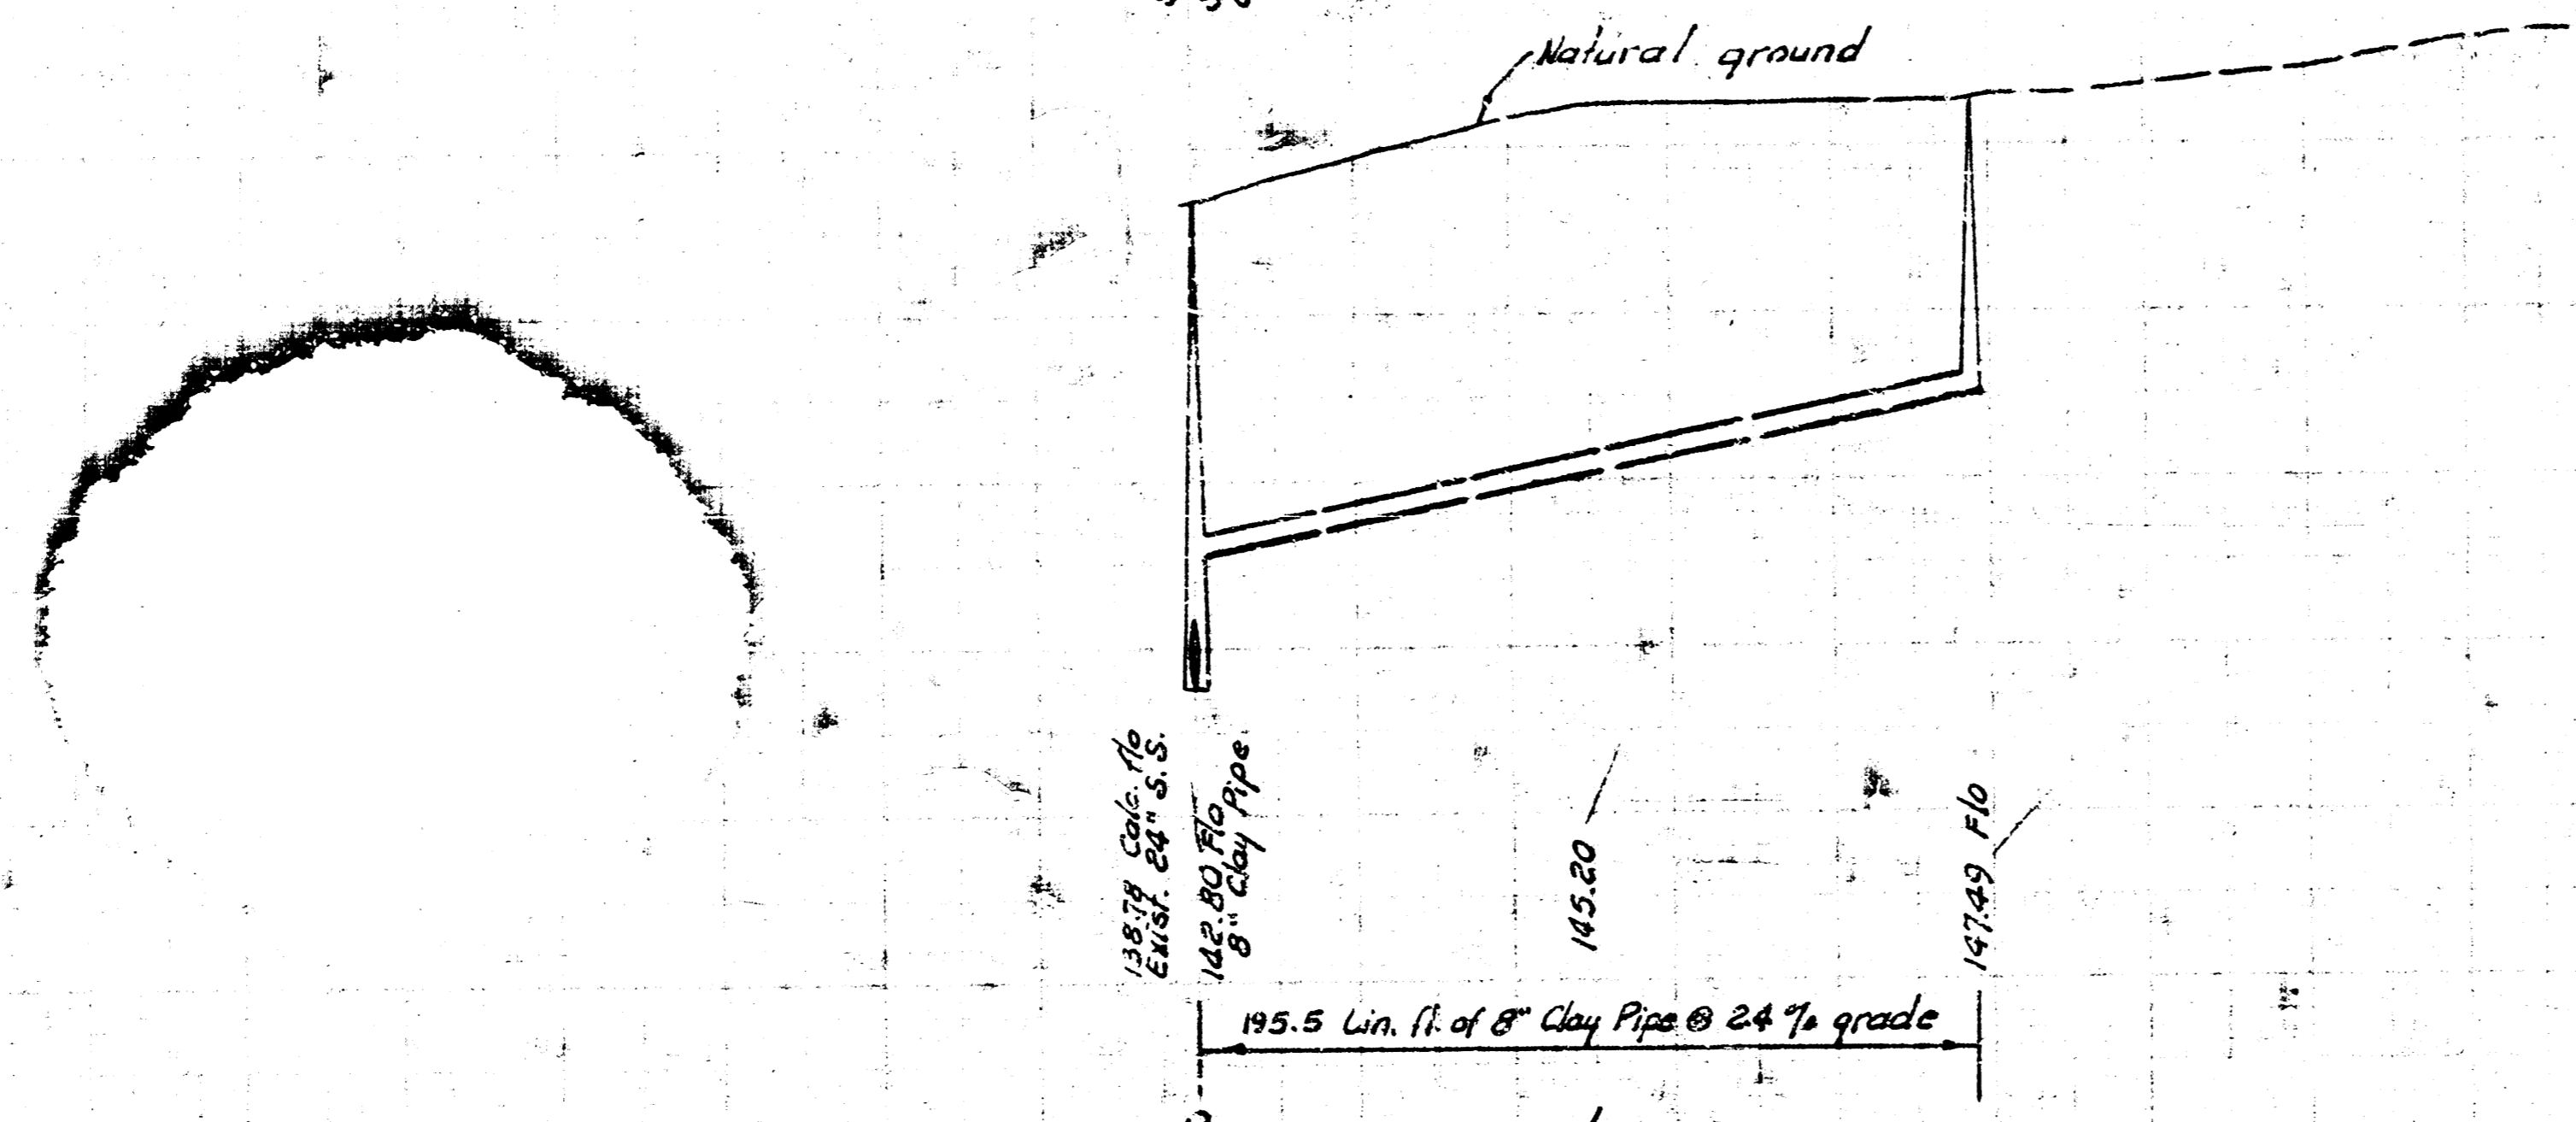

160  
 155  
 150  
 145  
 140  
 135



As Built Final Plans 7H-25  
 LAT. 22, MAIN 9, W. 1. S.  
 CITY OF WICHITA, KANSAS  
 R. W. LINN — CITY ENGINEER  
 MAR. 1974 PROJECT NO. DBKL574007