



B.M. 146.09 "a" Head Bolt SW Side P.P. N-Side NEW JERSEY E 150' W
 W.L. GEORGE WASHINGTON Blvd.

NOTE: WORK ORDER FOR THIS PROJECT WILL BE ISSUED AS SOON AS POSSIBLE AFTER AWARD OF CONTRACT SINCE DEVELOPER HAS BUILDINGS COMPLETED AND NEEDS THE PROPOSED SEWER FOR THESE BUILDINGS. CONTRACTOR IS ANTICIPATE BEGINNING WORK IMMEDIATELY AFTER CONTRACT HAS BEEN EXECUTED.

SCALE
 PLAN 1" = 40'
 PROFILE Horiz. 1" = 40'
 Vert. 1" = 5'

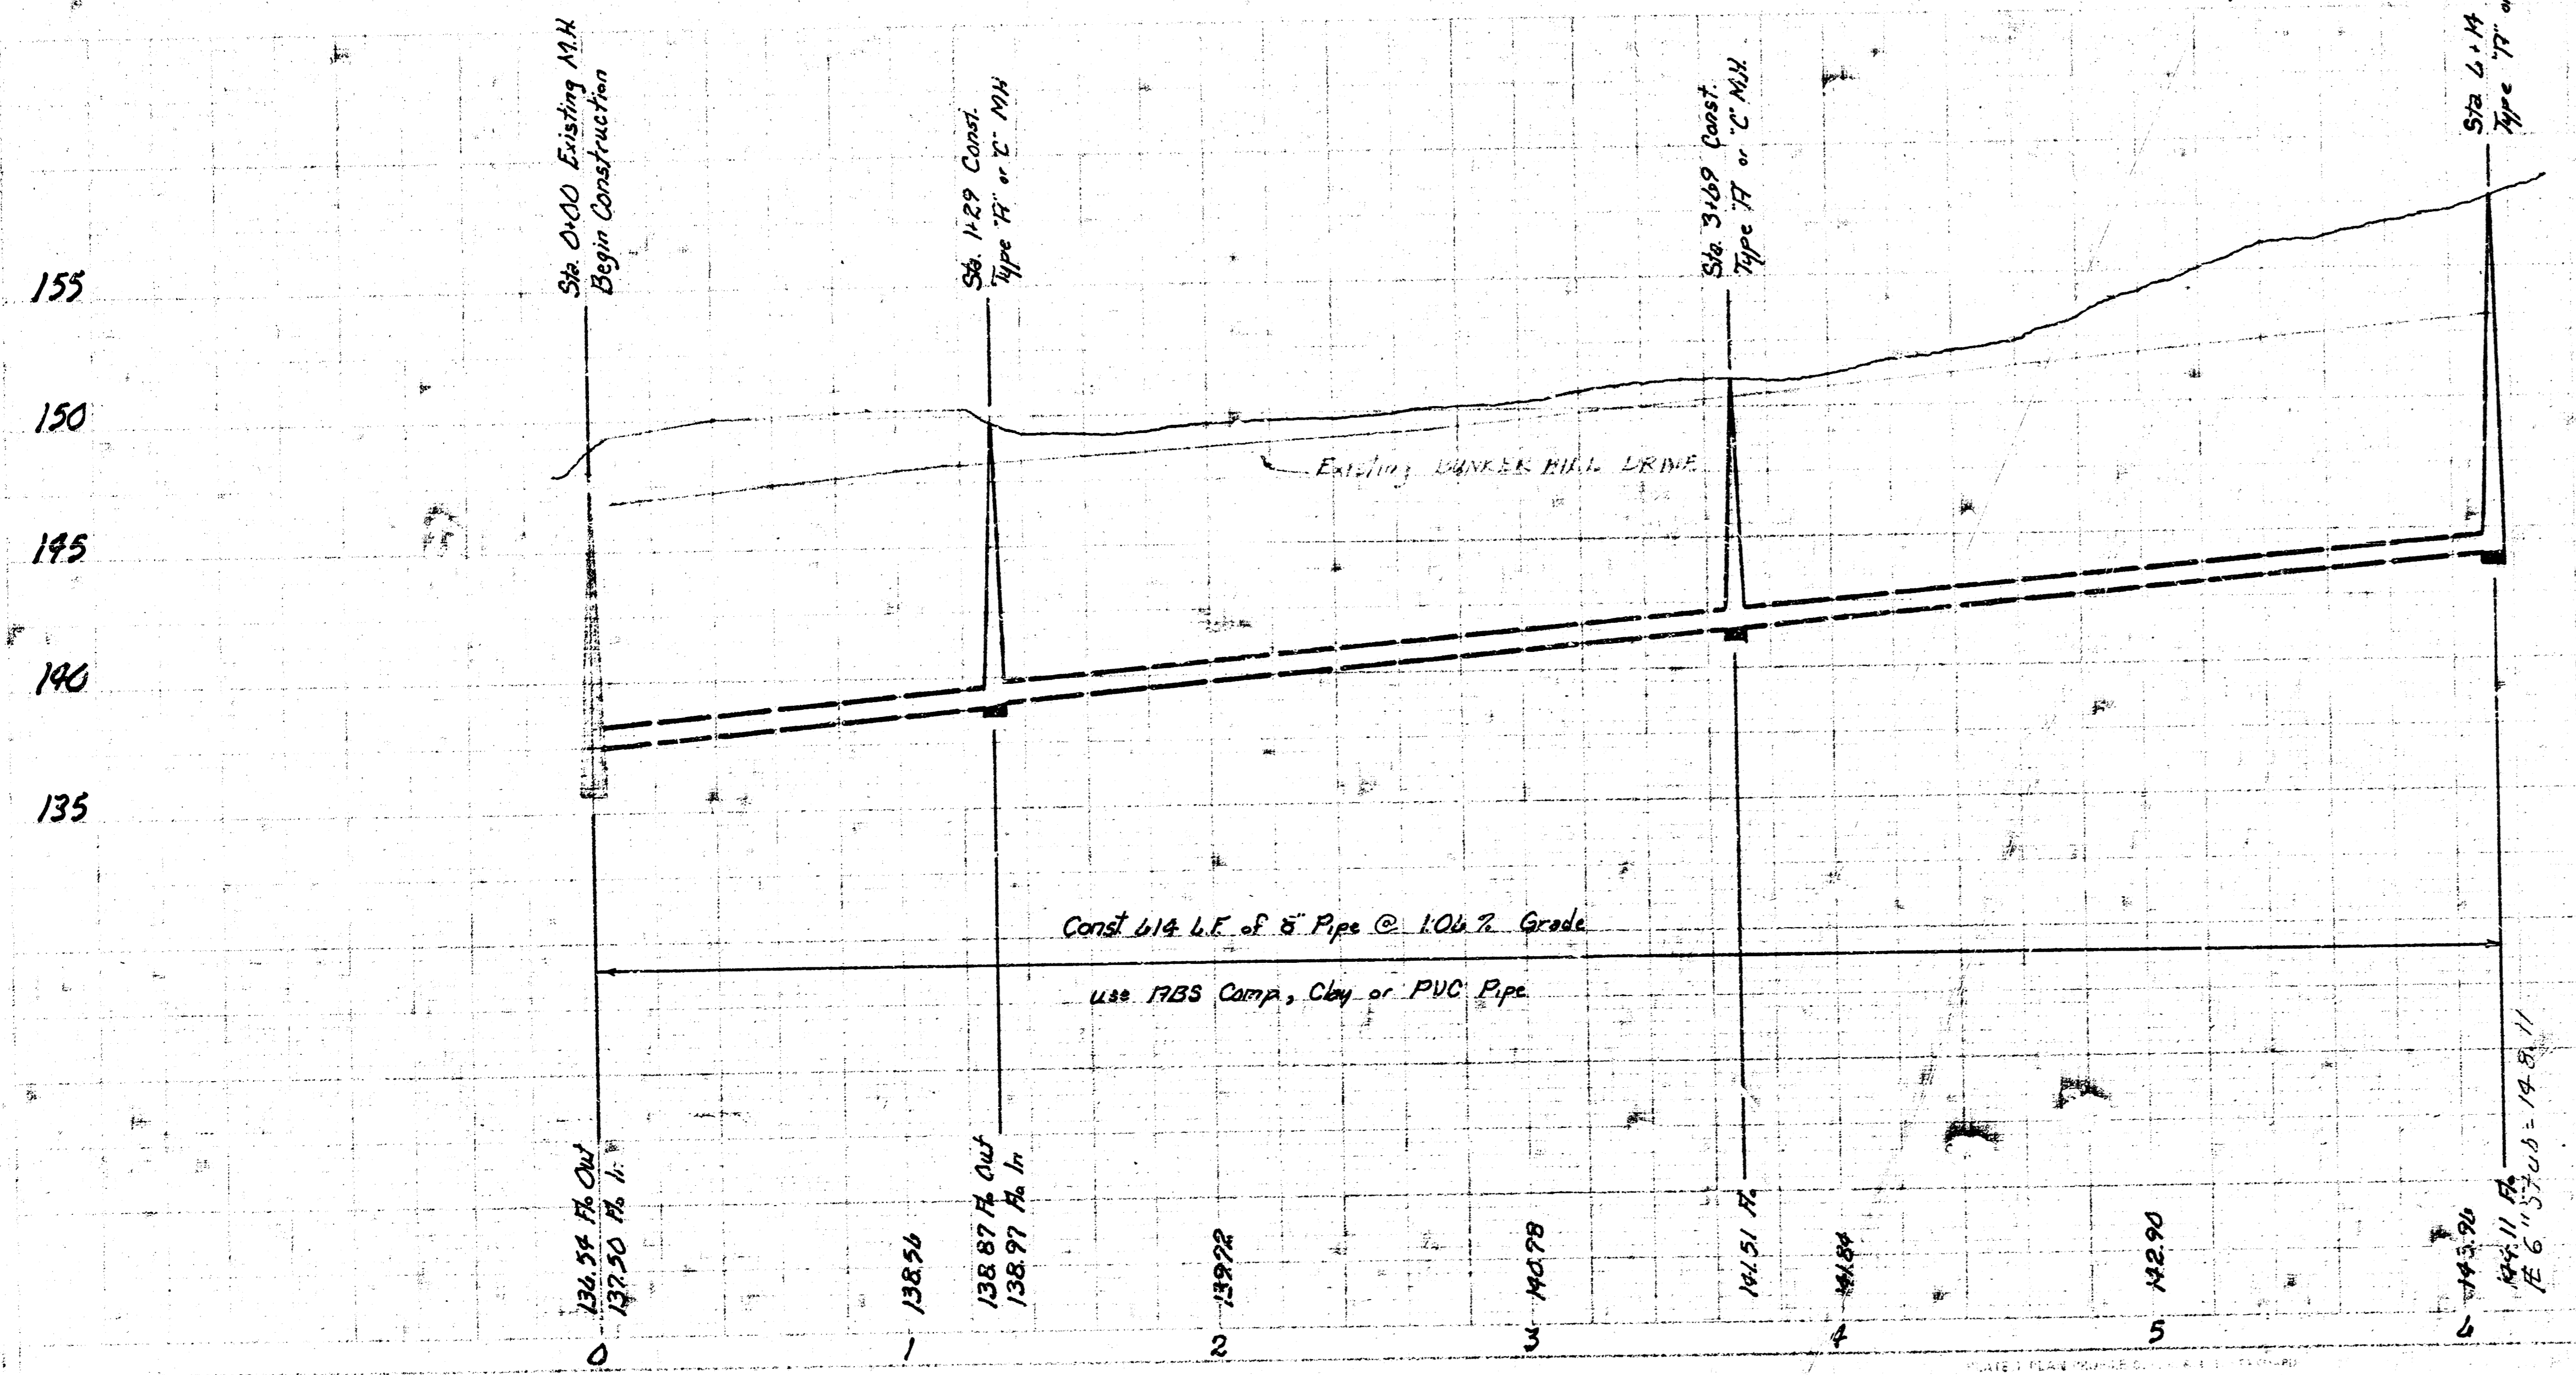

AS BUILT
 10/25/80
 6293
 LATERAL B, MAIN 10, WAR INDUSTRIES SEWER
 Proj. No.: 468-76-245-80770-000-000-001
 WICHITA, KANSAS
 DEAN SELLERS - Pctyng CITY ENGINEER
 DATE: _____

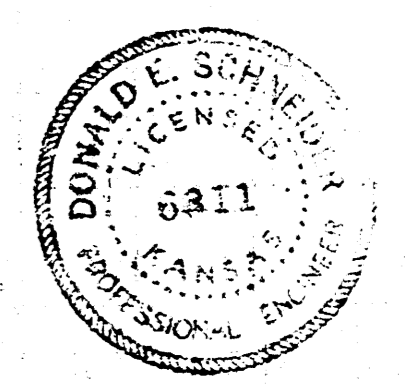

P. KRUEG
 J.D. WILKINSON
 6/80
 6/80
 D.L.S.