
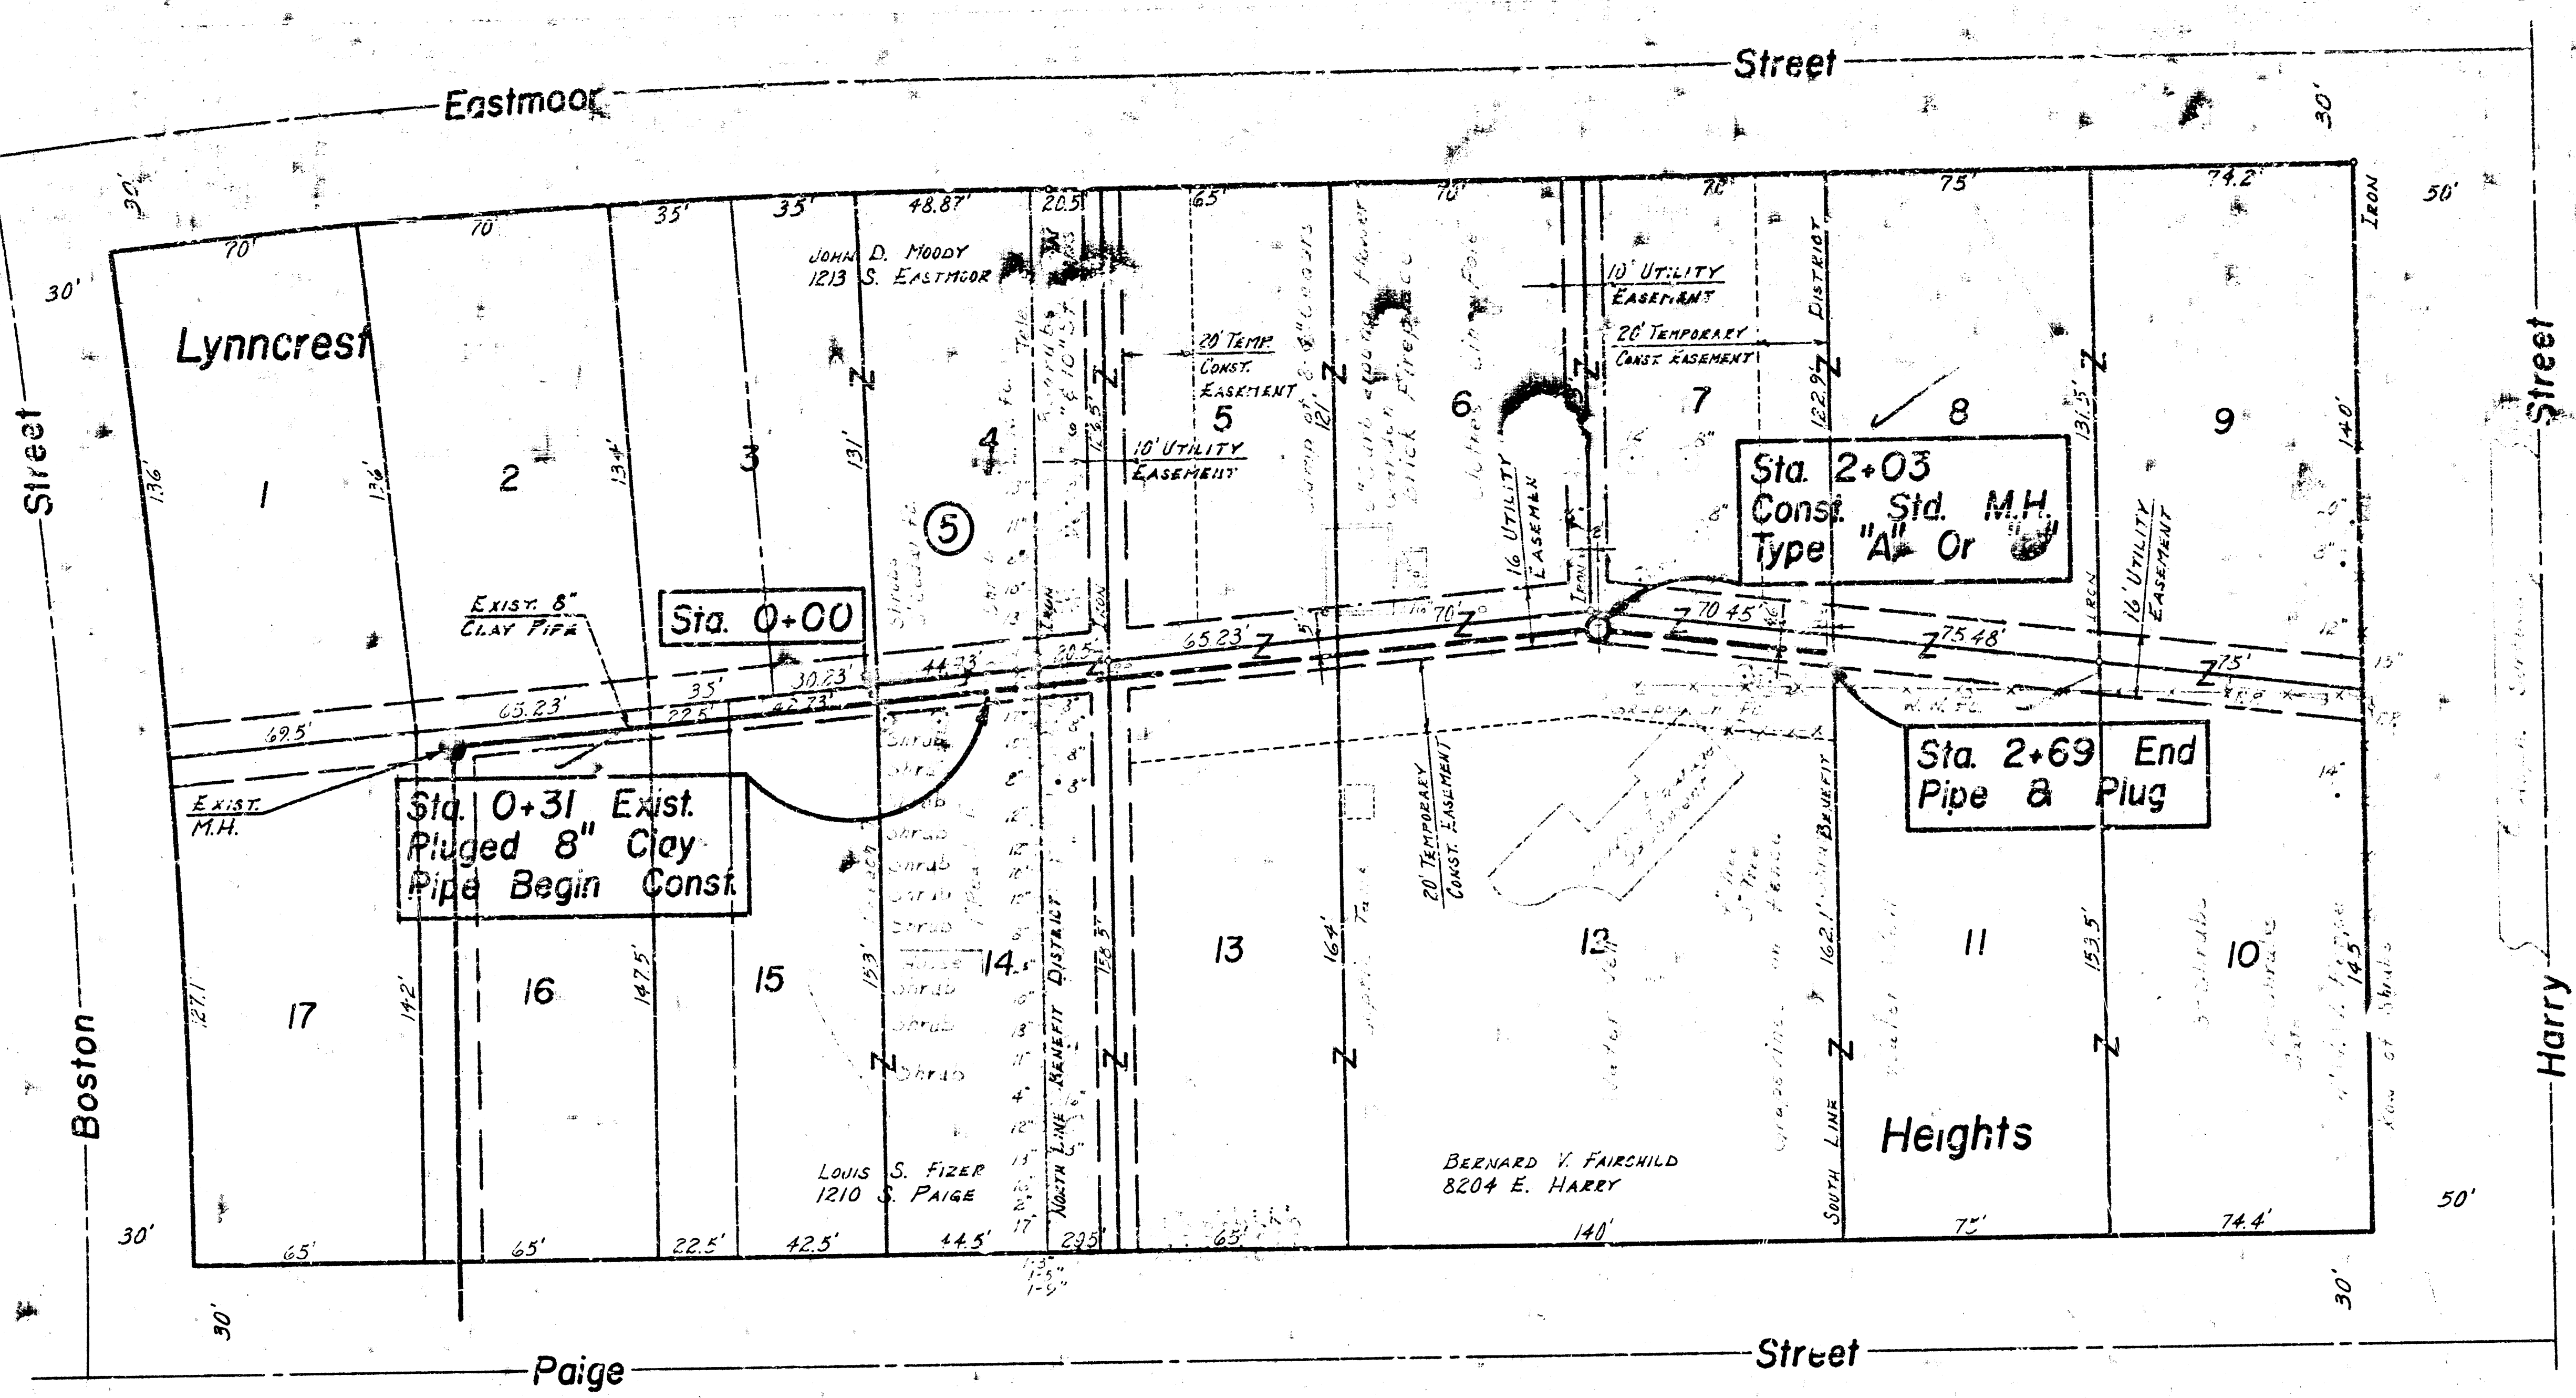




B.M. 148.52 F.H. - E.S. Paige, N.S. Harry
 "O" in Open
 B.M. 145.41 Rock Rd. & Harry, "+" Cut
 West End North Handrail
 RCB 250' E Of Rock Rd.

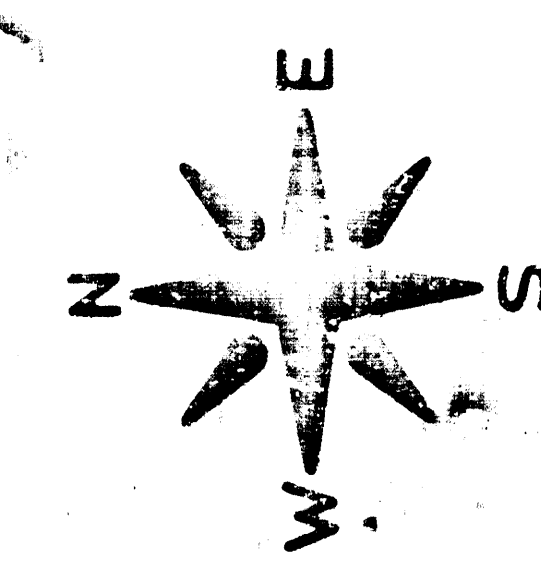

Scale =
 Plan 1" = 40'
 Profile 1" = 40' Horiz.
 1" = 5' Vert.

NOTE: CONTRACTOR WILL BE REQUIRED TO OBTAIN FIELD ENGINEER'S APPROVAL PRIOR TO REMOVING ANY EXIST. CONTRACTOR WILL BE REQUIRED TO GIVE PROPERTY OWNER A MINIMUM OF 24 HOUR NOTICE PRIOR TO STARTING CONSTRUCTION. THE PROPERTY OWNER HAS INDICATED THAT OTHER ROUTES ARE ACCESS TO THE ADJACENT LOT. CONTRACTOR MUST HAVE PROPERTY OWNER'S APPROVAL FOR USE OF 12" FOR WORK AREA TO BE USED IN ADDITION TO THAT SHOWN BY PLANS.

155
150
145
140
135
130
125

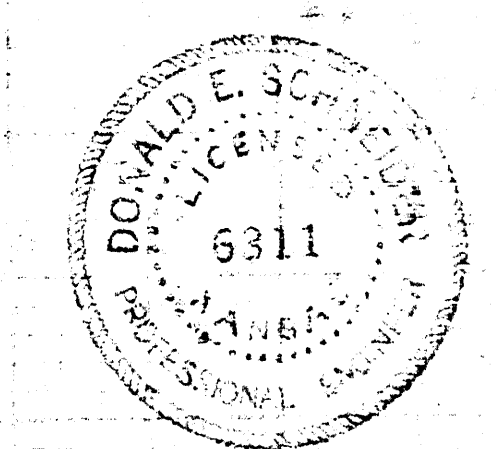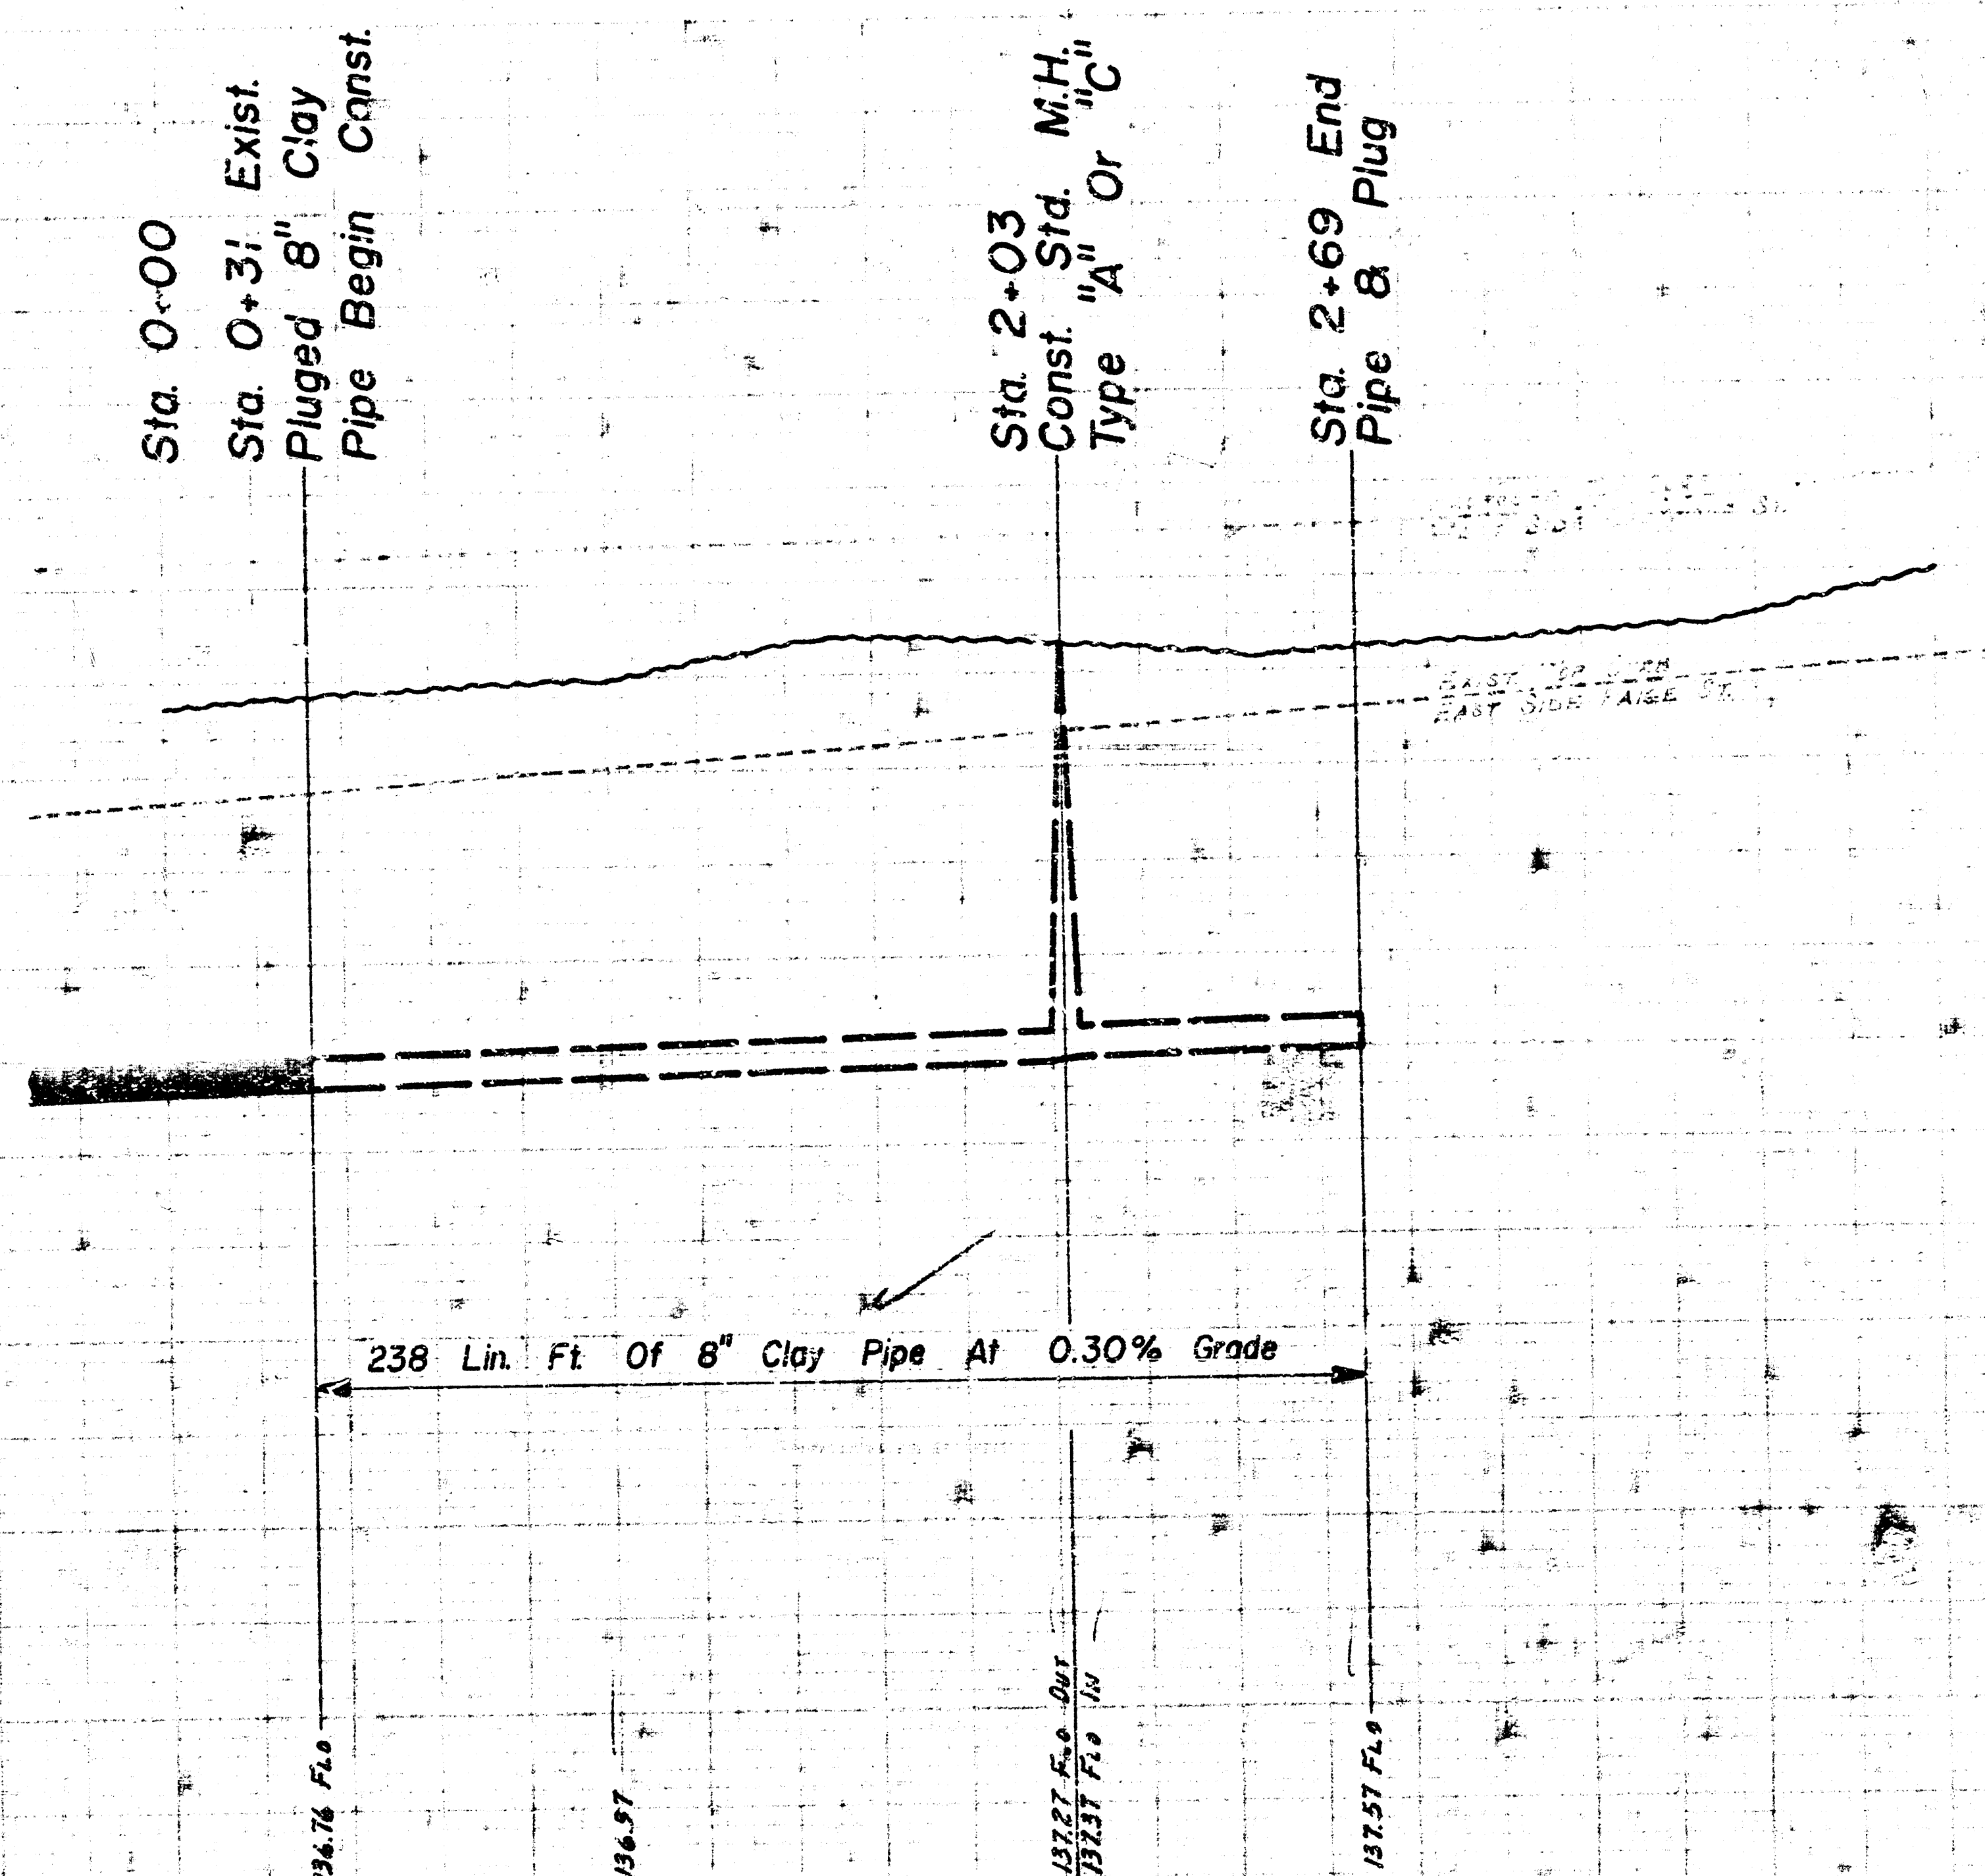

As built 10-30-

Lat. 10, Main 11, War Industries Sewer
 City Of Wichita, Kansas
 R. W. Linn City Engineer
 Proj. No. 468 76 80398 OGA-000 001 Date:
 Proj. No. DBK1577056 Sheet 1 of 1