
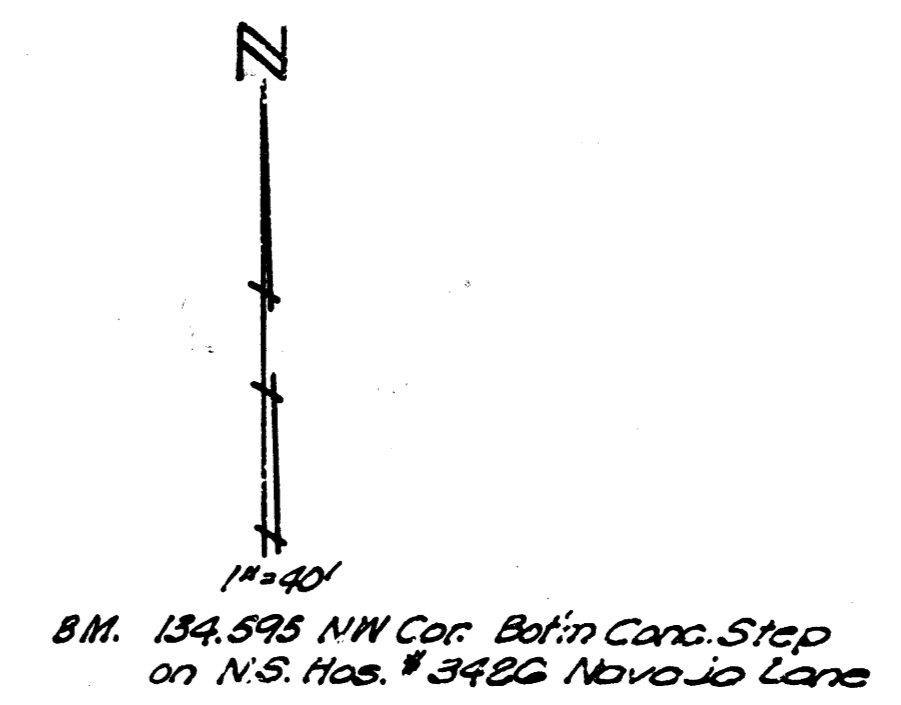


629
3801


629
3801

63

63

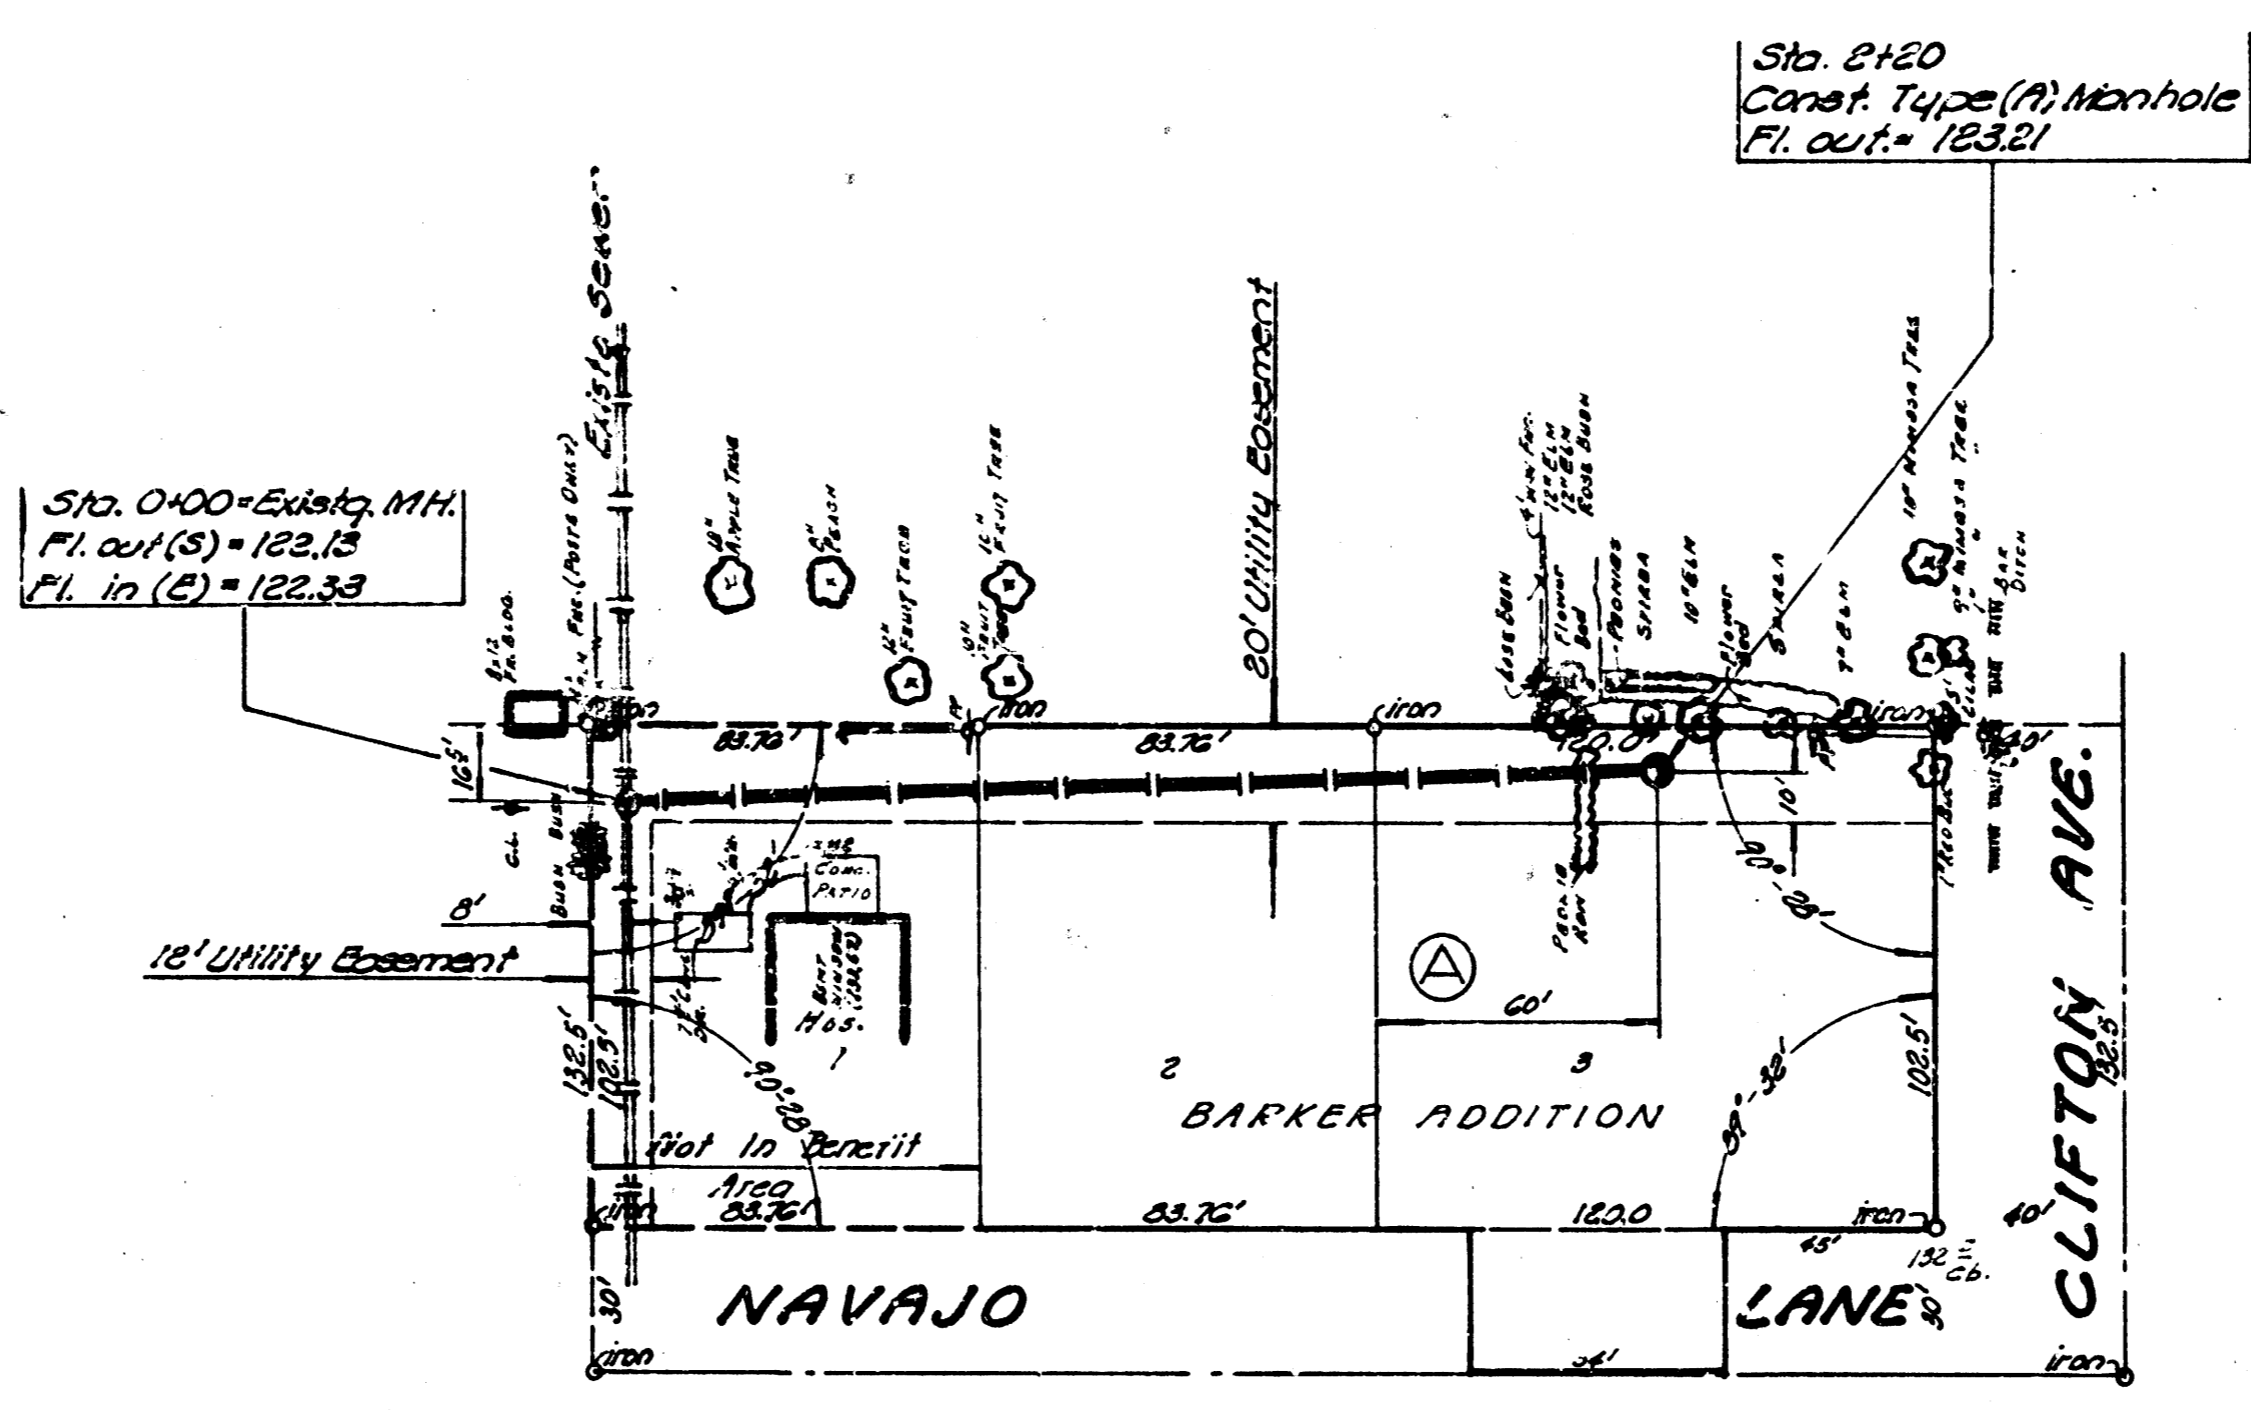

Profile - 1" = 20' Horiz.
1" = 5' Vert.

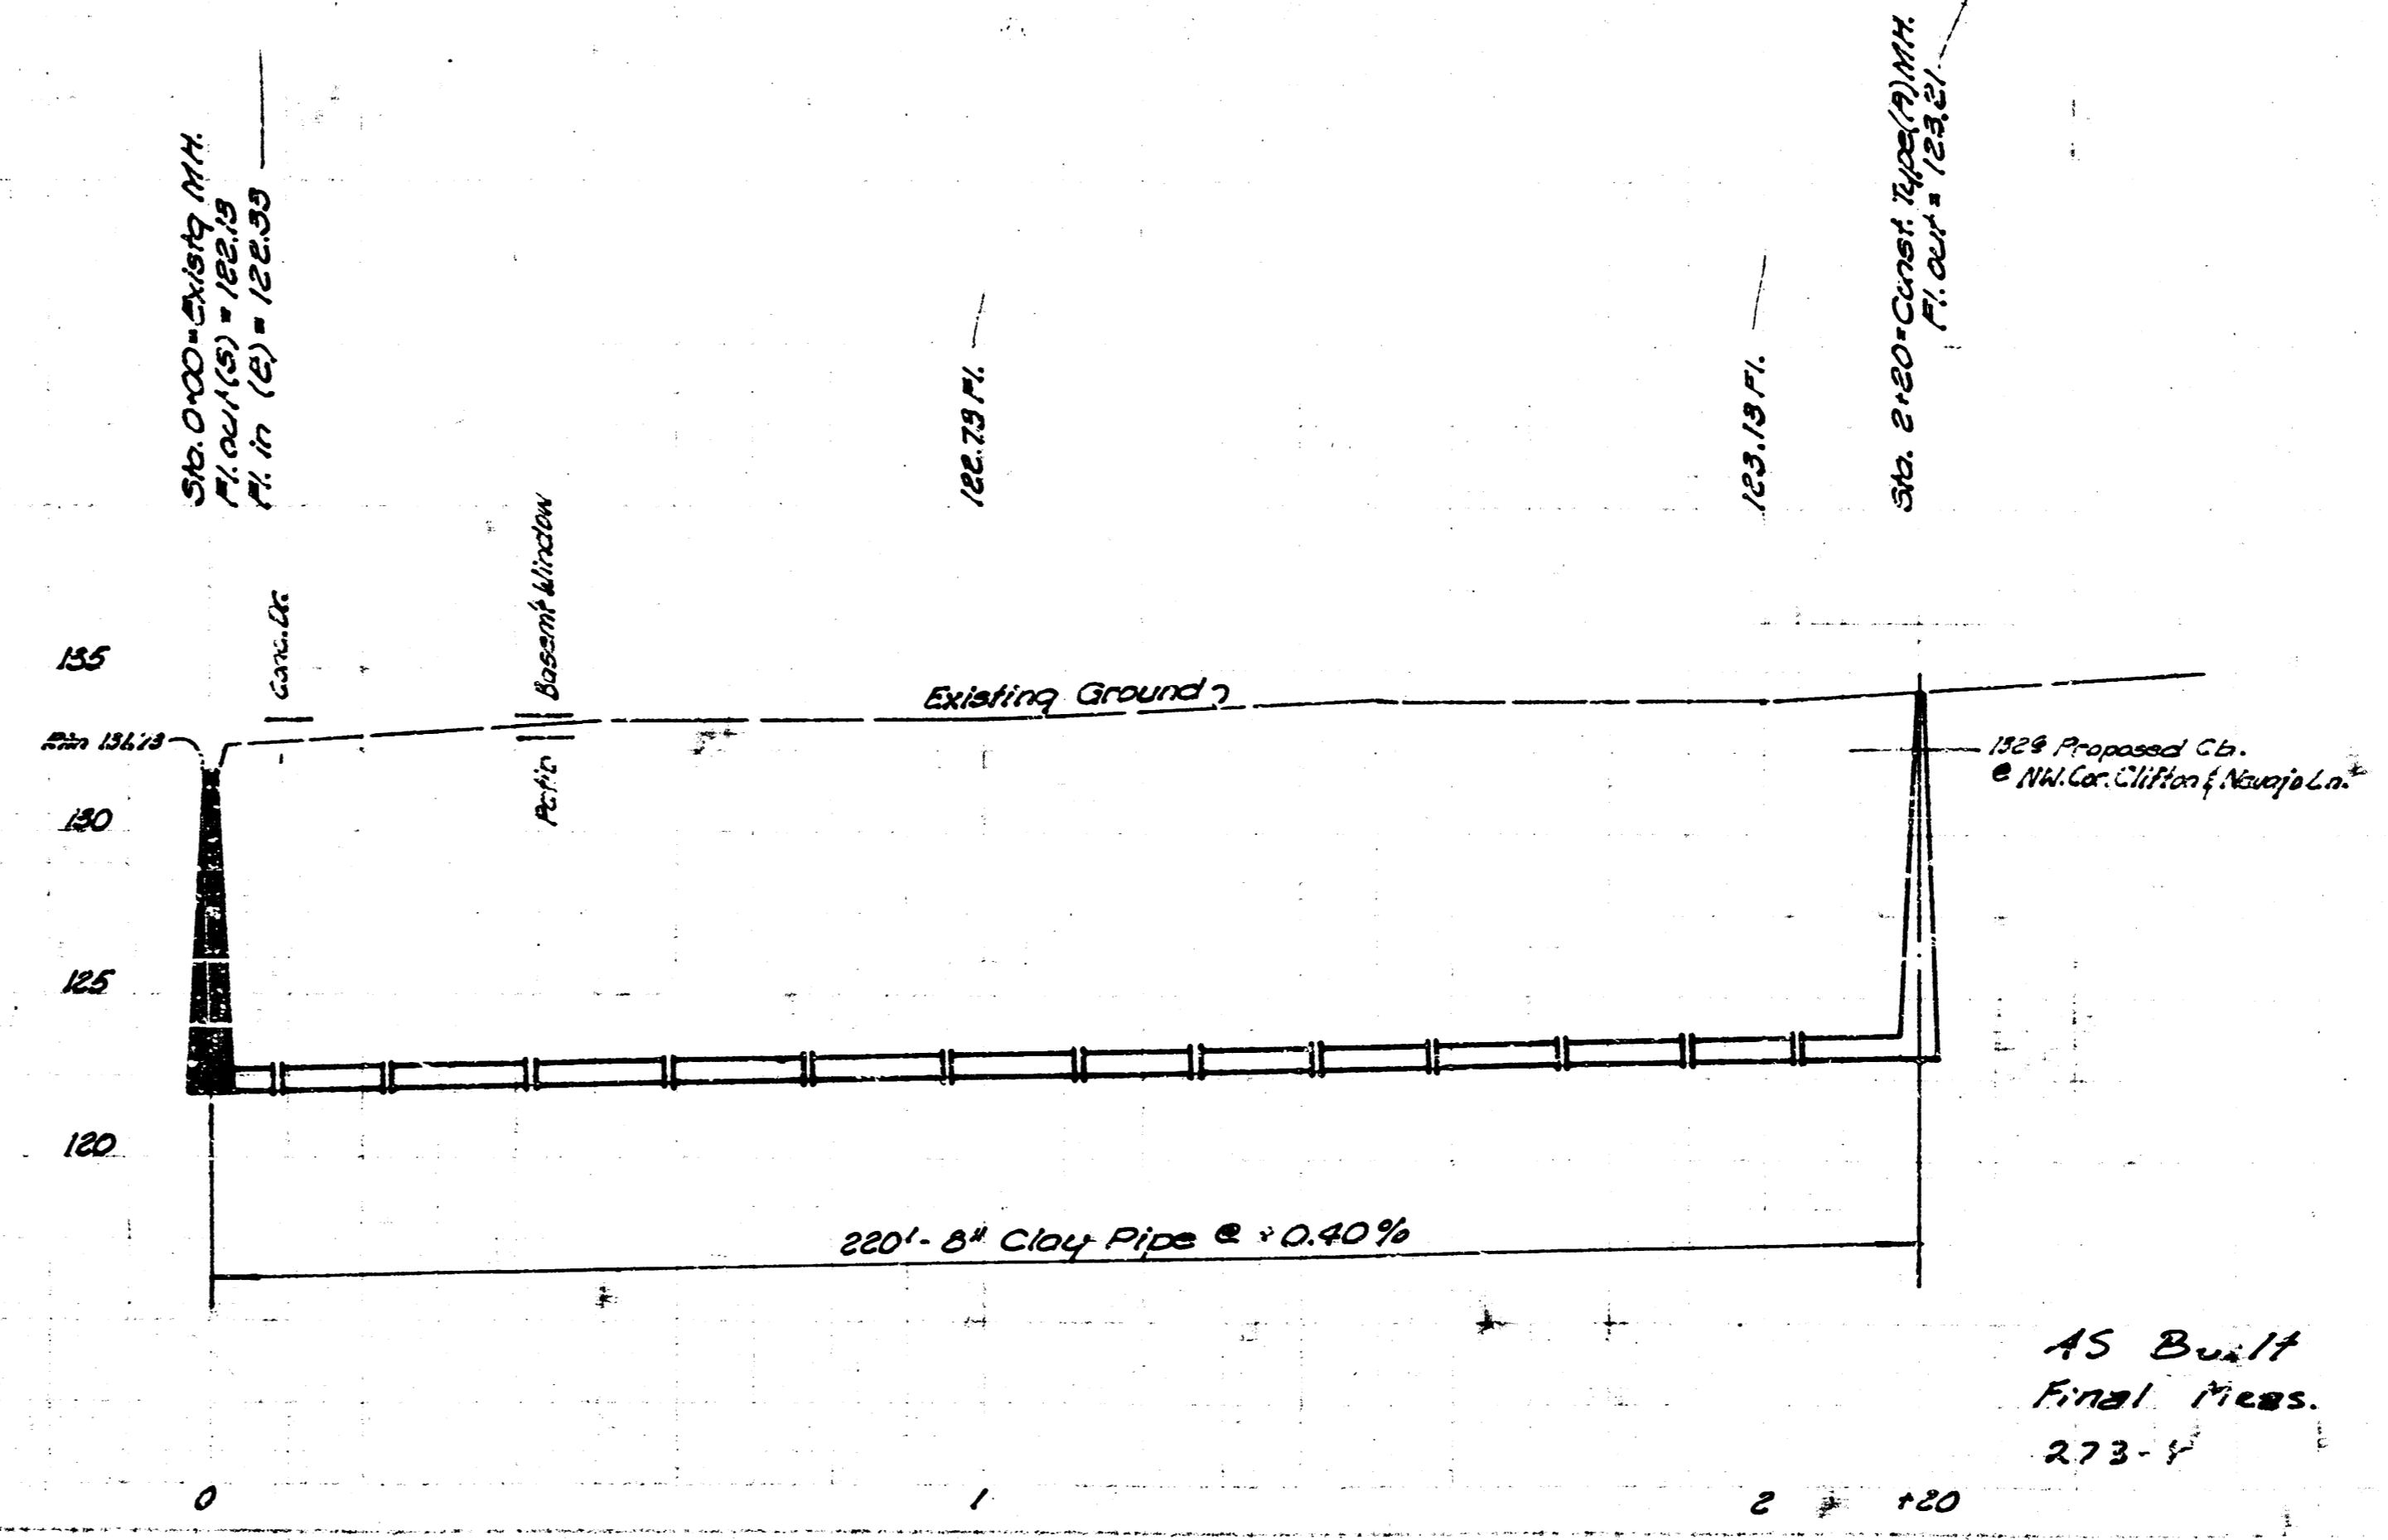

AS BUILT
Final Meas.
273-V

LAT. 5, SUBMAIN 14, M.I.S.
 City of Wichita, Kansas
 R.W. Linn City Engineer
 Date - Jan. 1974 DBK 2 570057



10-Eng 3
1-11-74