



D.C.D. 8-39
D. Cranner

B.M. 98.97 R.R. Spike 5' ~ 10' Tree 50' N. of Butler Dr. E. Side of K-15 Hwy.

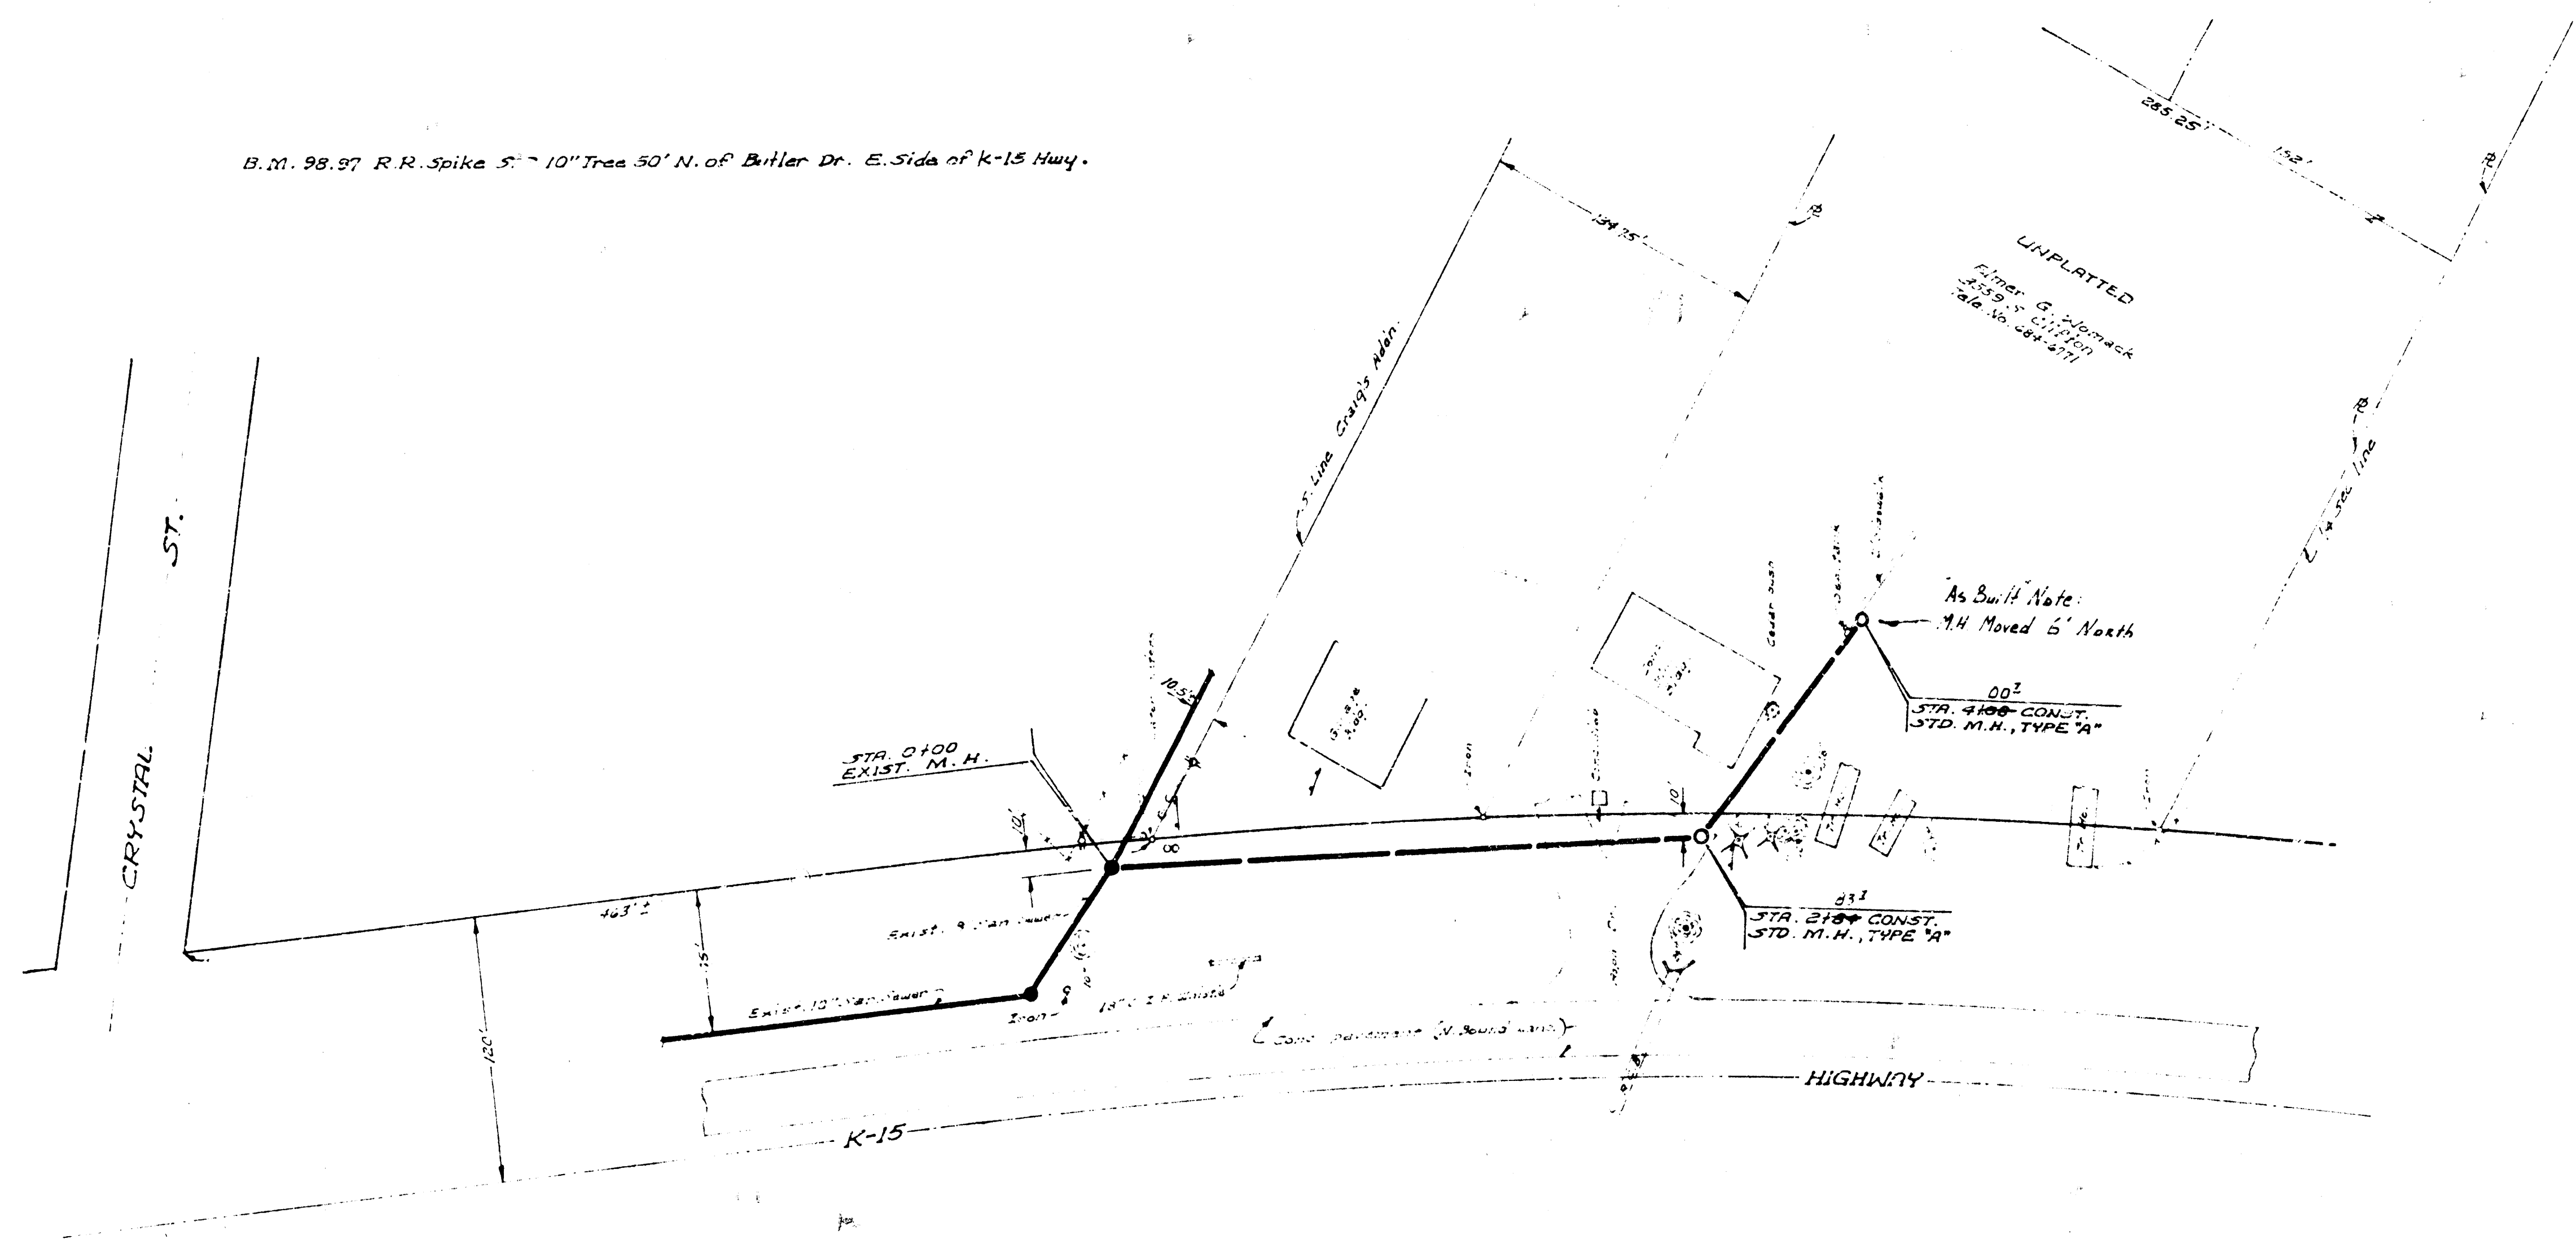

Plan Scale 1"=50'
Profile Scale 1"=5' Vert.

150
120
110

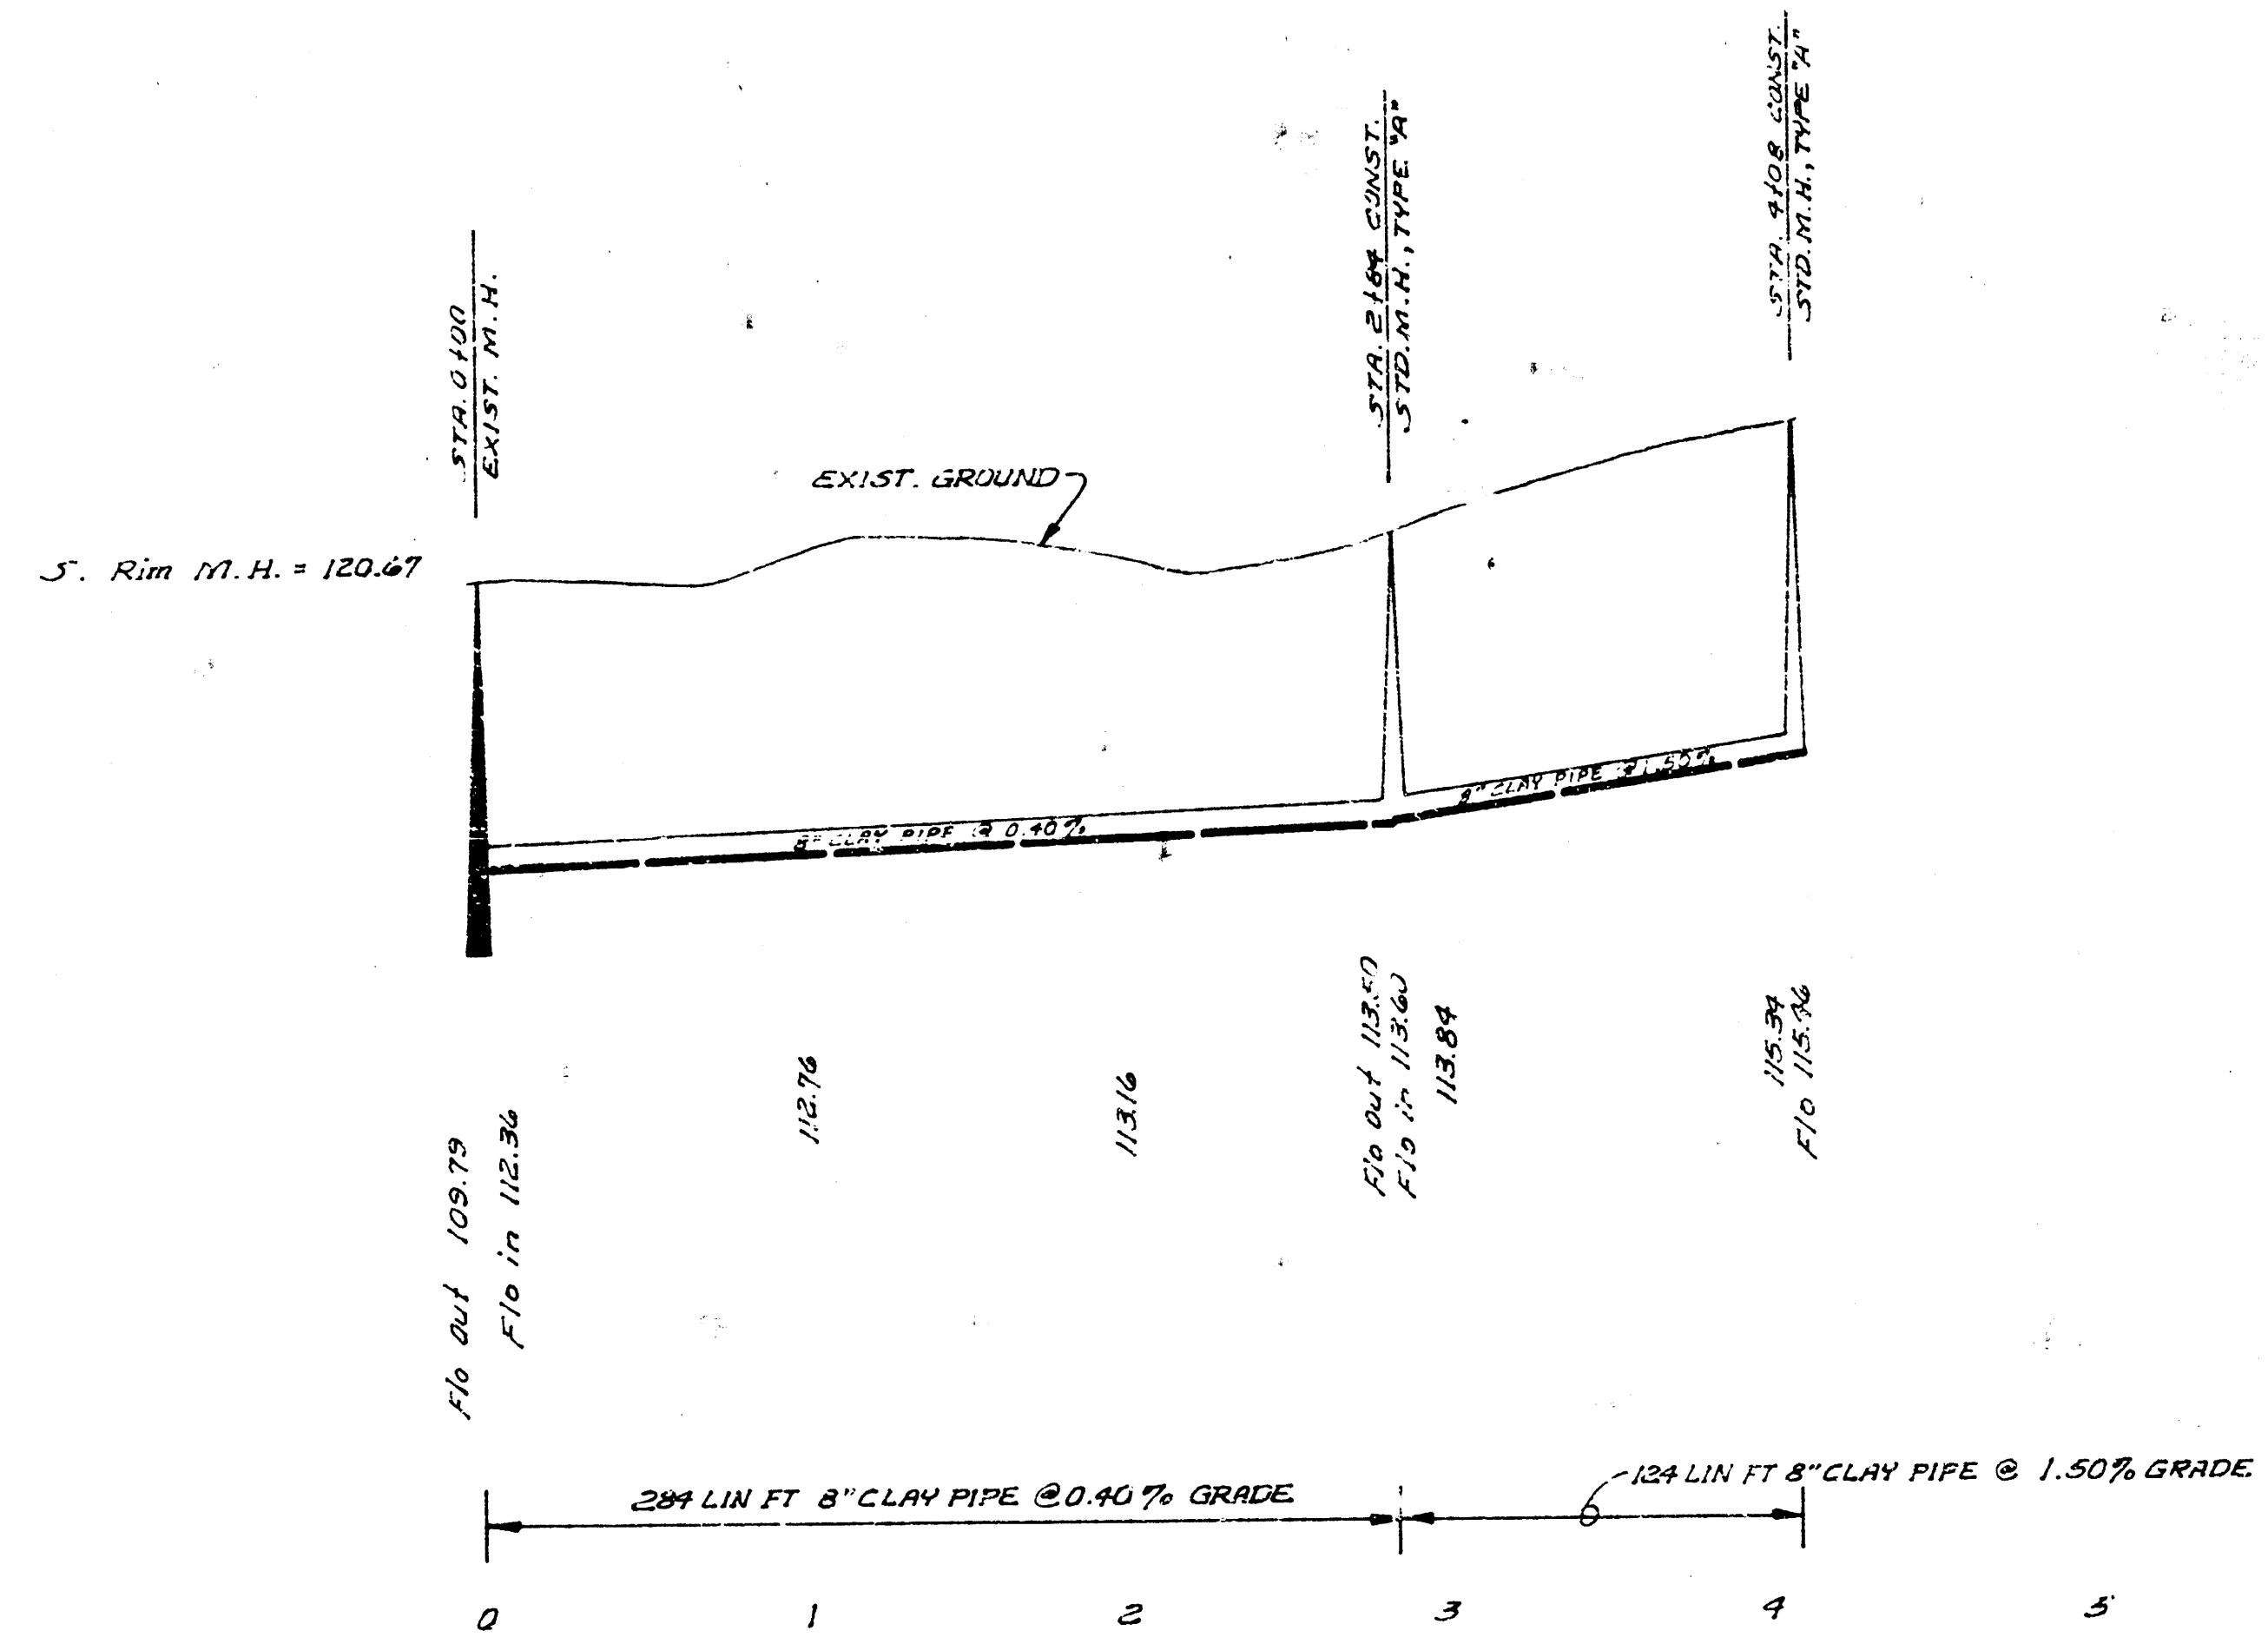

130
120
110

As Built Final Map JFS 184
LAT. G., MAIN 14, W. I.S.
CITY OF WICHITA, KANSAS
R.W. LINN, CITY ENGINEER
DATE: SEPT. 1971

3 5 10