


BM 145.41 Chiseled "+" in center on top West end handrail on North Side of triple 8x8 RCBC 250 ft. East of Rock Rd. on Hwy.

BM 139.64 Chiseled "□" in N.E. corner of top of Concrete Inlet at West edge of Rock Rd. between Zimmerly and Grail St.

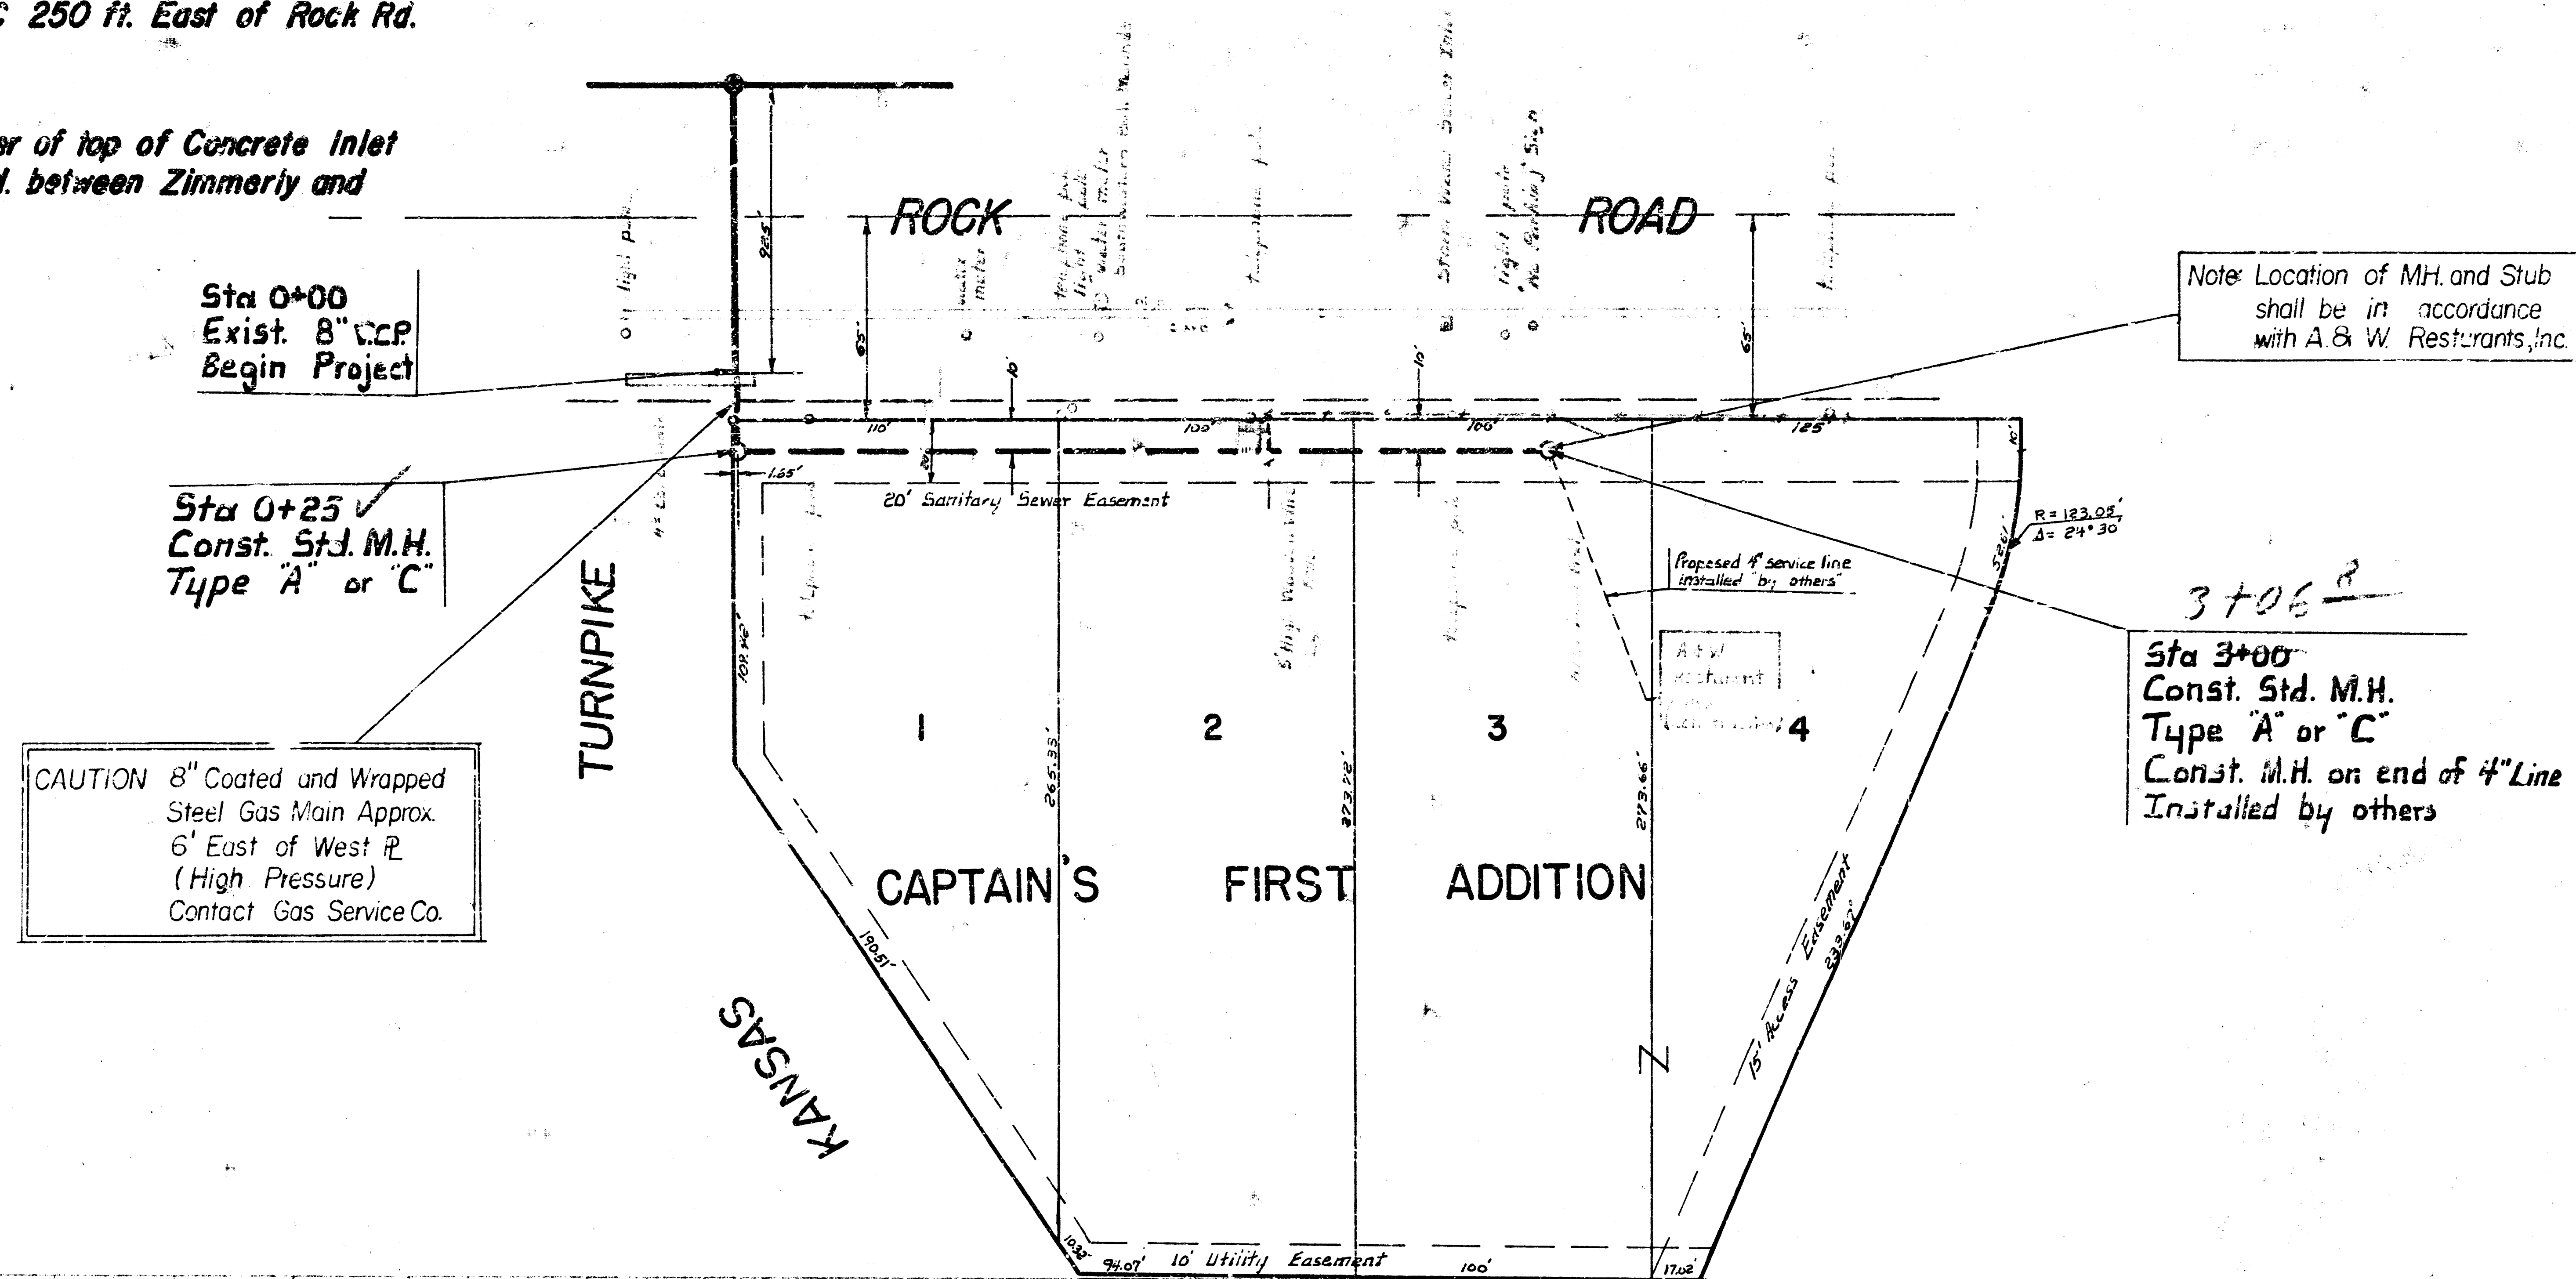


Plan Scale 1" = 40'
Profile Scale 1" = 40'
1" = 5'

CAUTION 8" Coated and Wrapped Steel Gas Main Approx. 6' East of West R. (High Pressure) Contact Gas Service Co.

Note: Location of M.H. and Stub shall be in accordance with A & W Restaurants, Inc.

Sta 3+00 Const. Std. M.H. Type "A" or "C" Const. M.H. on end of 4" Line Installed by others

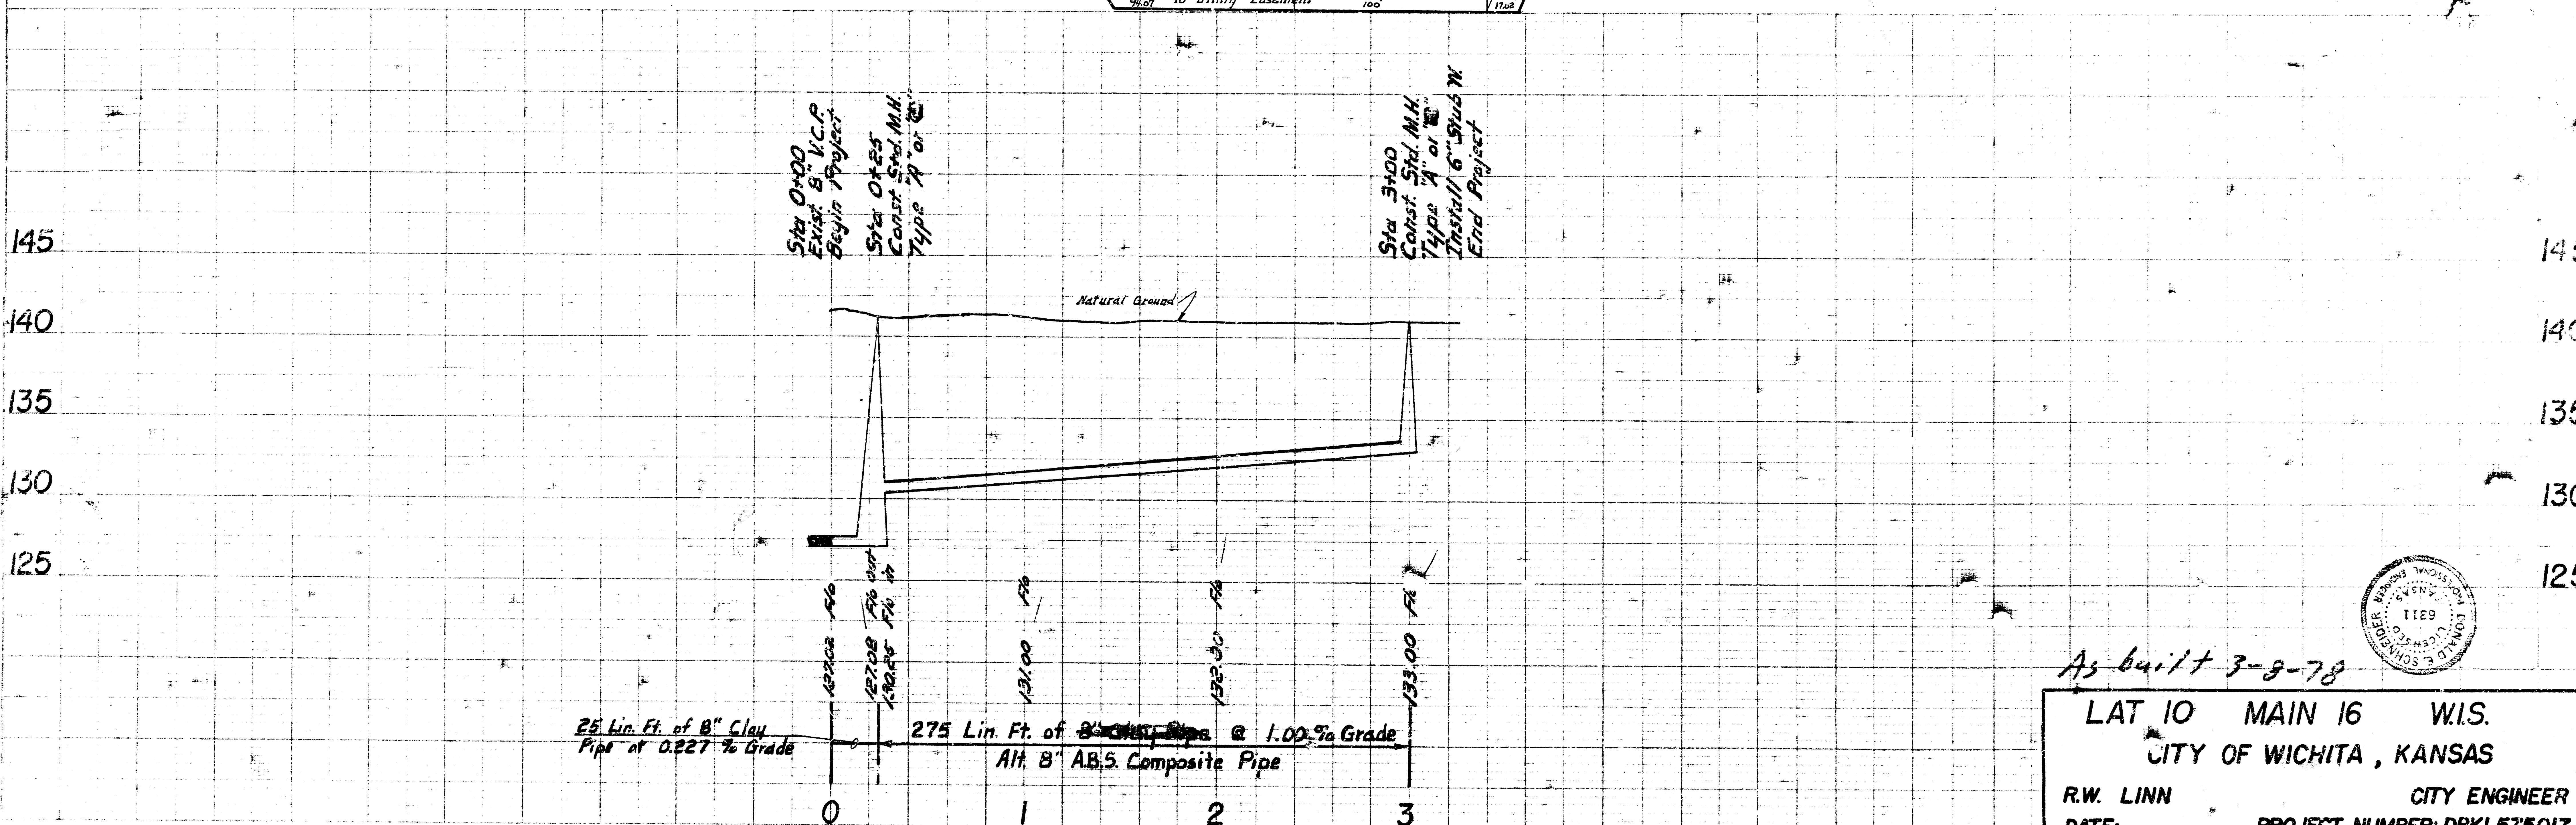

As built 3-9-78

LAT 10 MAIN 16 W.S.
CITY OF WICHITA, KANSAS

R.W. LINN CITY ENGINEER
DATE: PROJECT NUMBER: DBKL575017