


B.M. 145.4' Chiseled "X" in Ctr. of top W. End Handrail N.S. Triple 8x8 R.C.B. 250' East of Rock Rd. on Harry.




SCALES:
 PLAN: 1"=40'
 PROFILE: 1"=40'
 vert. 1"=5'

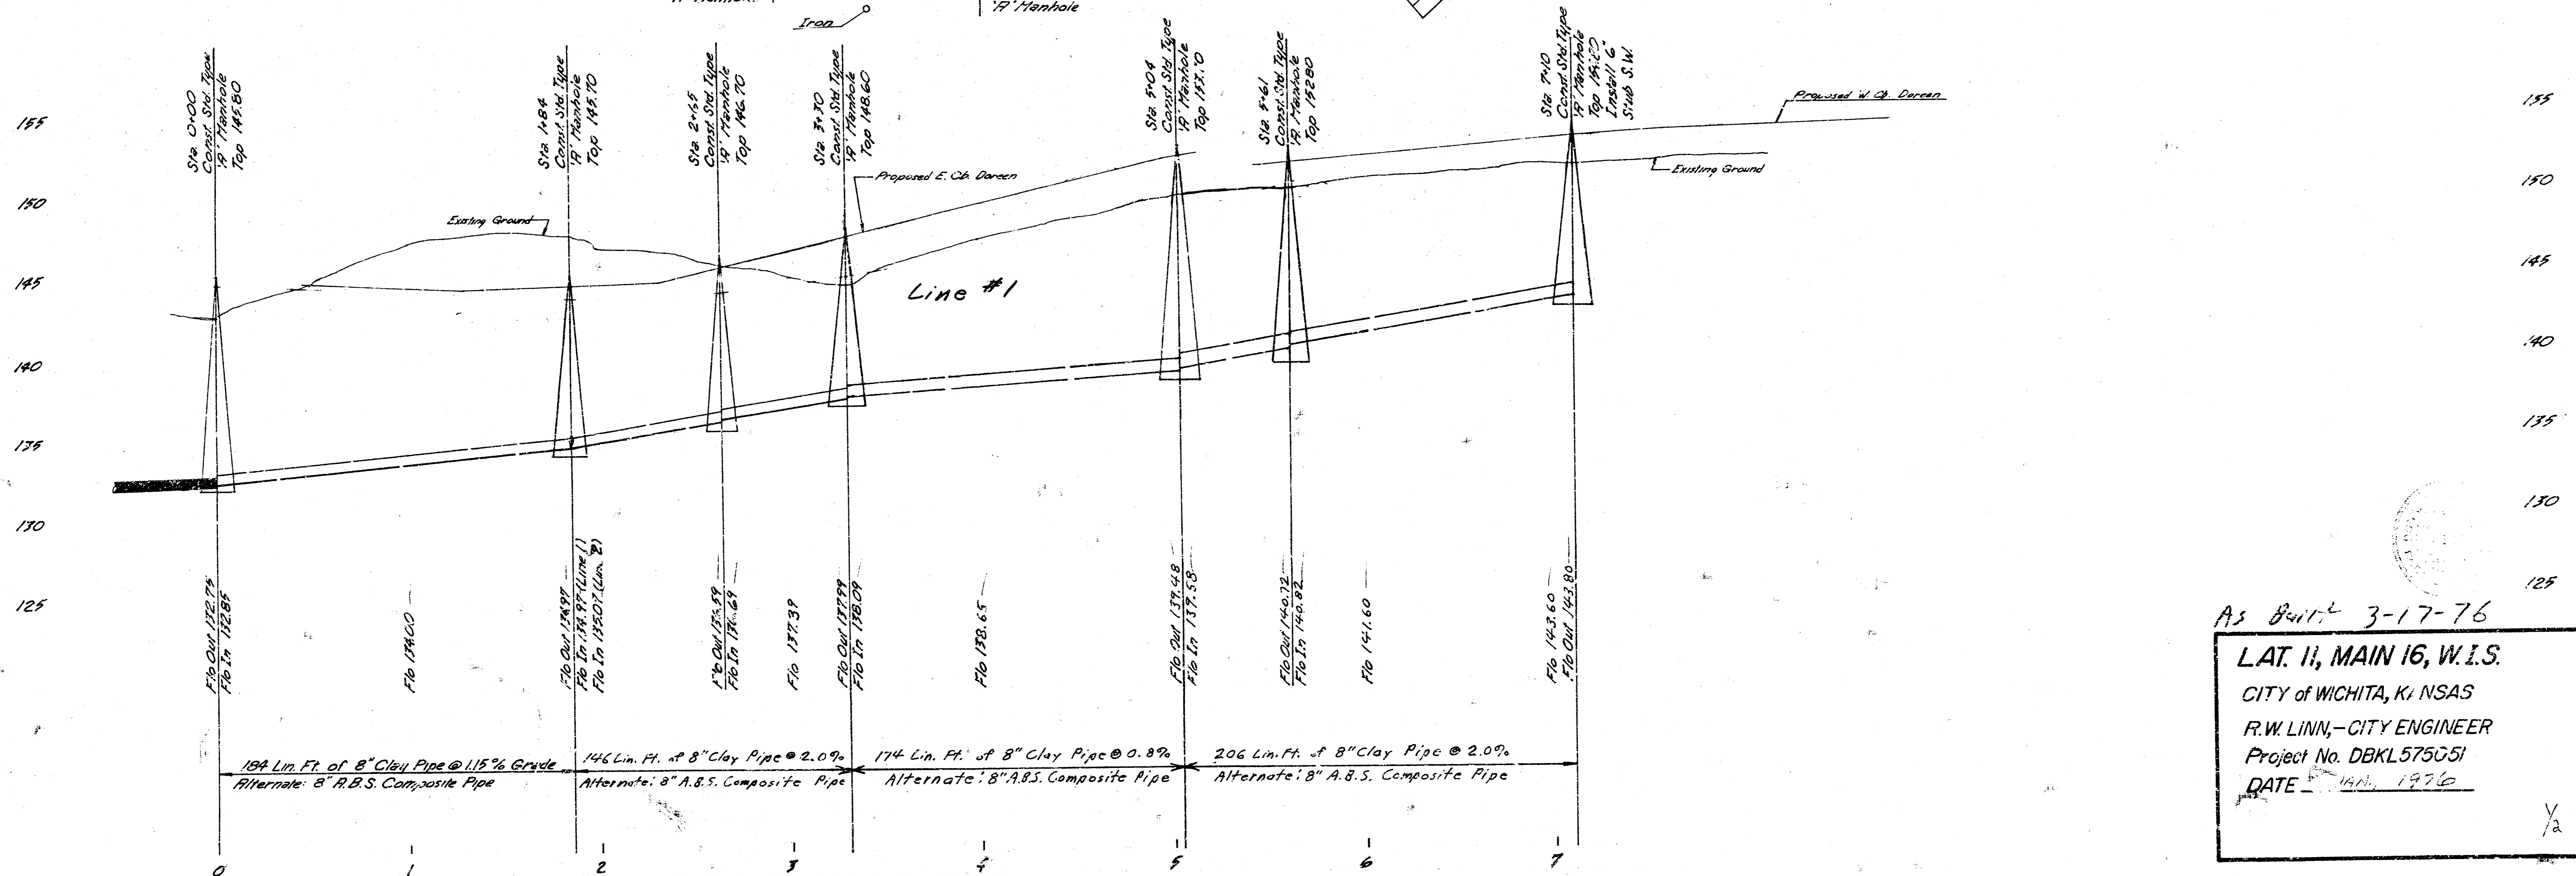


As Built 3-17-76


LAT. II, MAIN 16, W.I.S.
 CITY OF WICHITA, KANSAS
 R.W. LINN, CITY ENGINEER
 Project No. DBKL575051
 DATE: APR. 1976

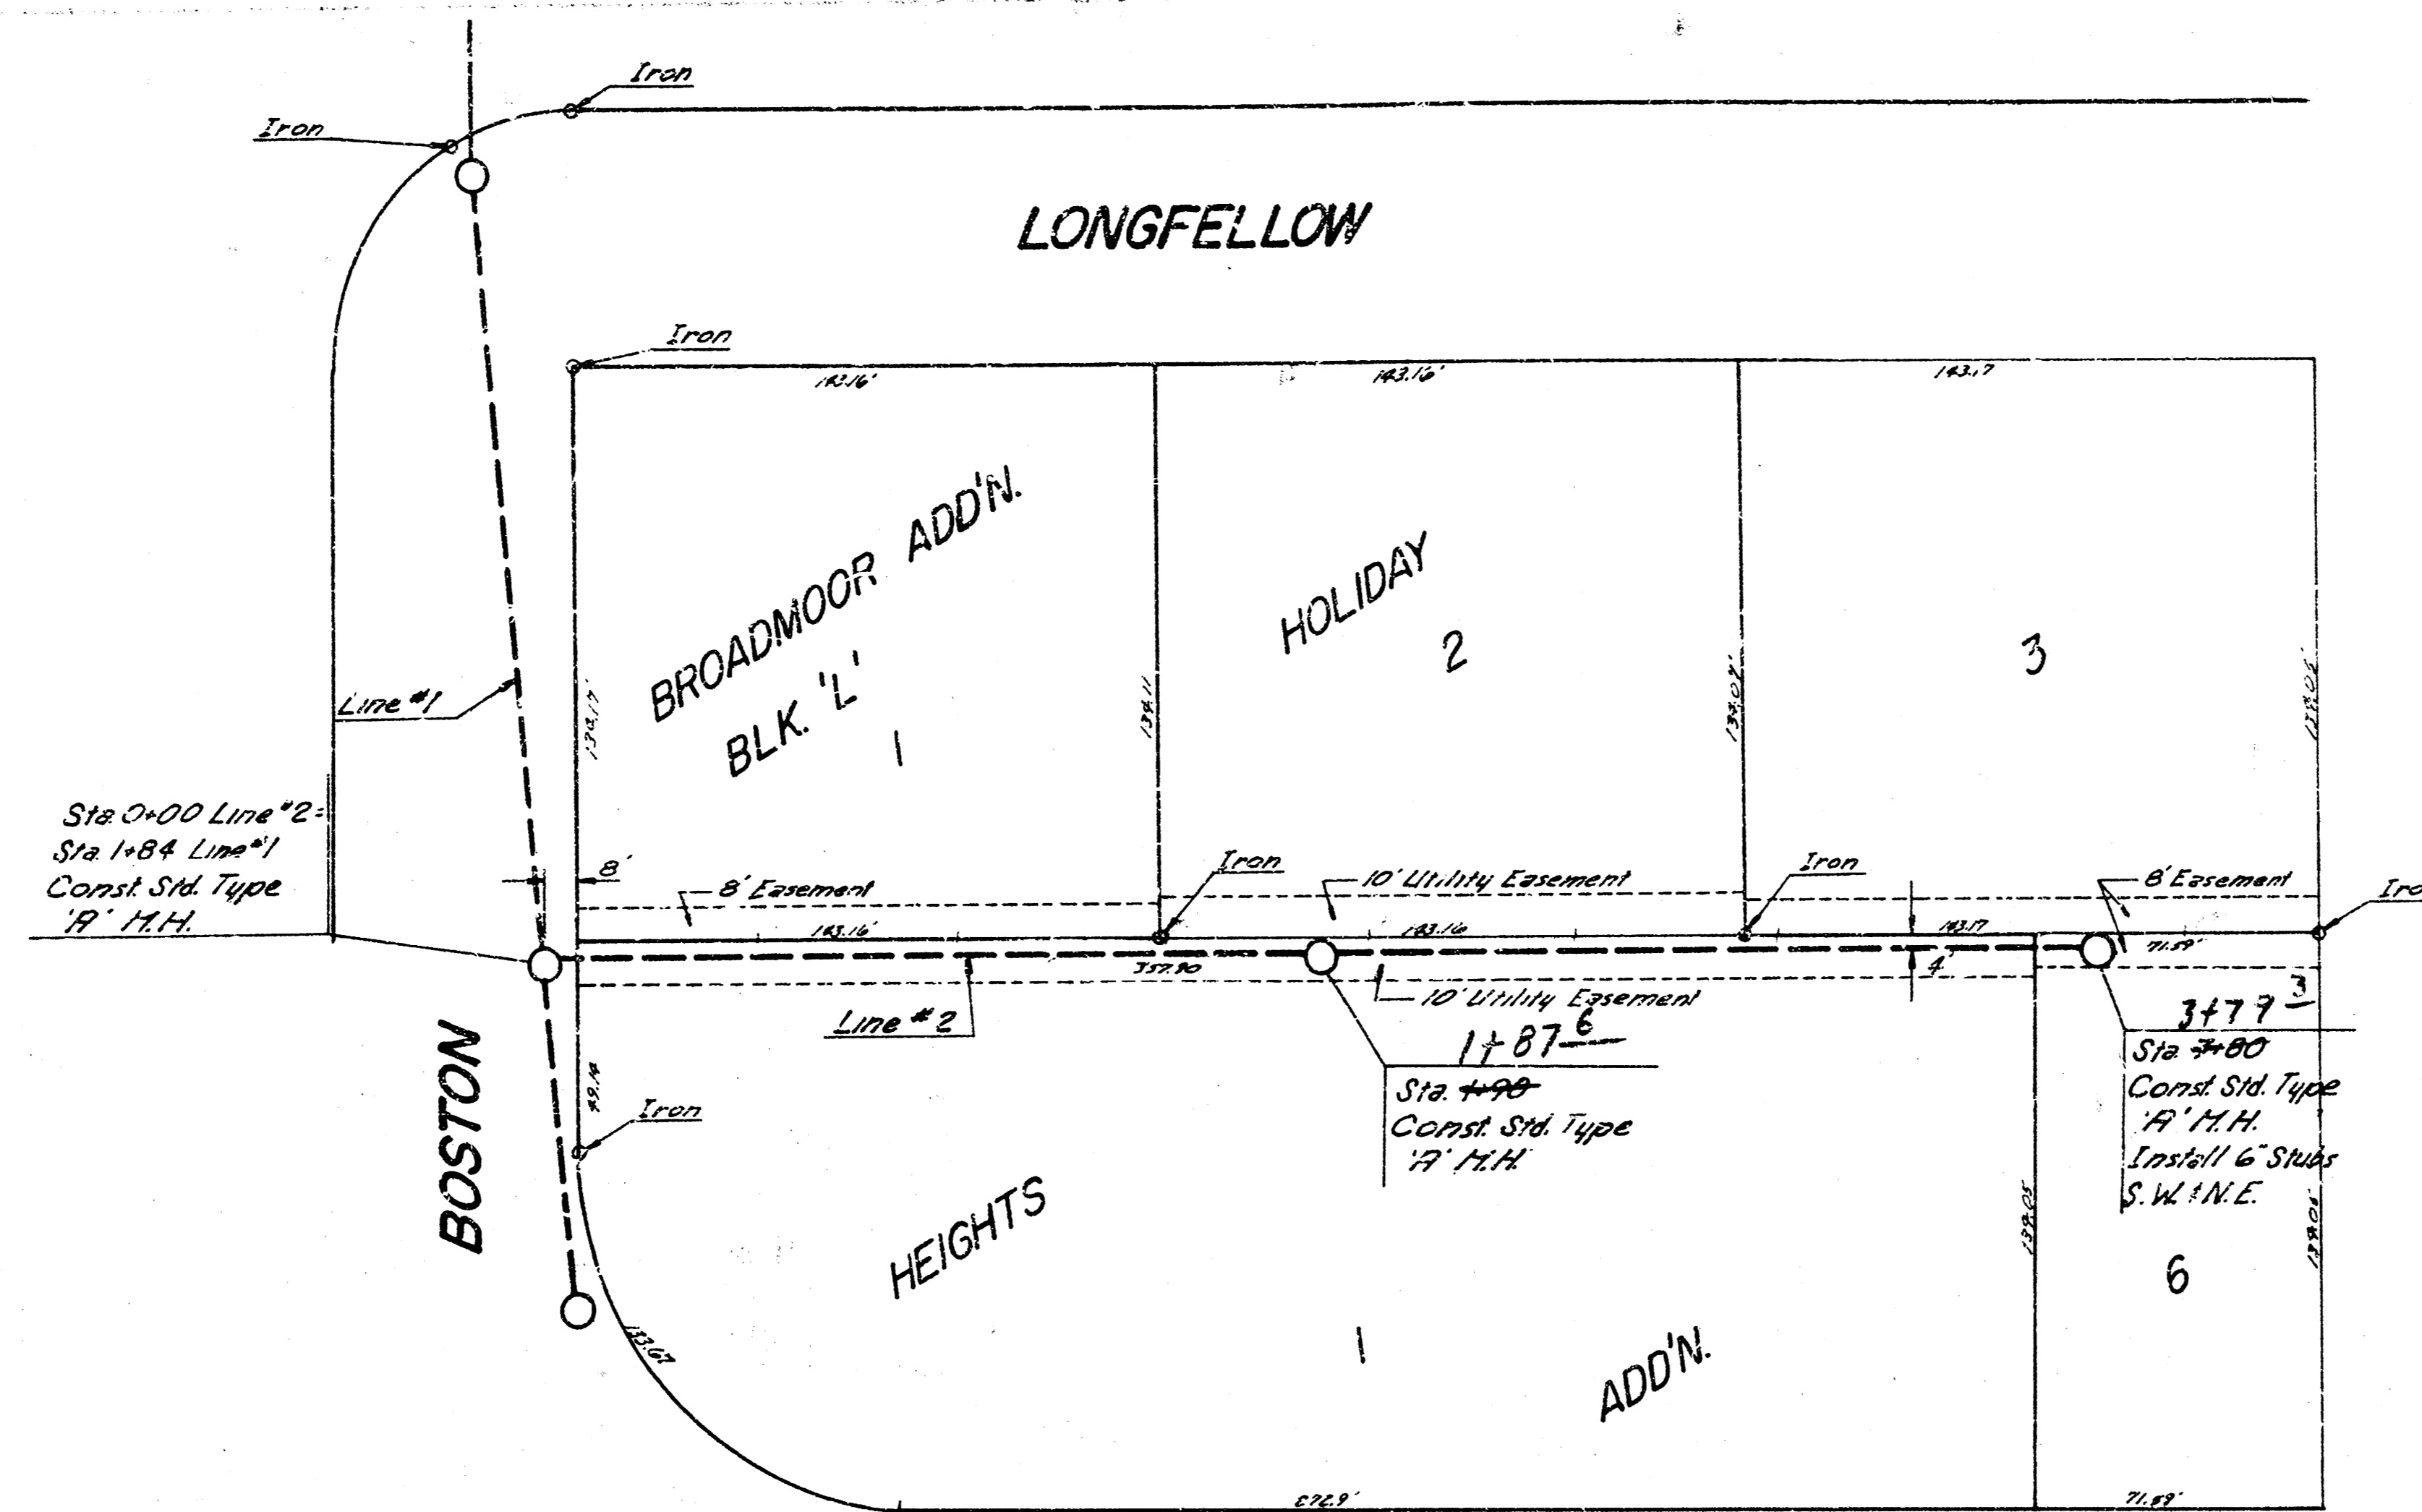

B.M. 145.41 Chiseled "X" Ctr. of top W. End Handrail N.S. Triple 8x8 R.C.B. 250' East of Rock Rd. on Harry

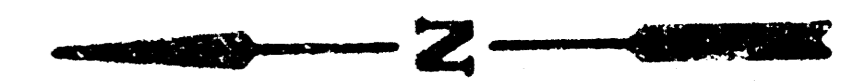

SCALE
Plan 1"=40'
Profile 1"=40'
Vert 1"=5'

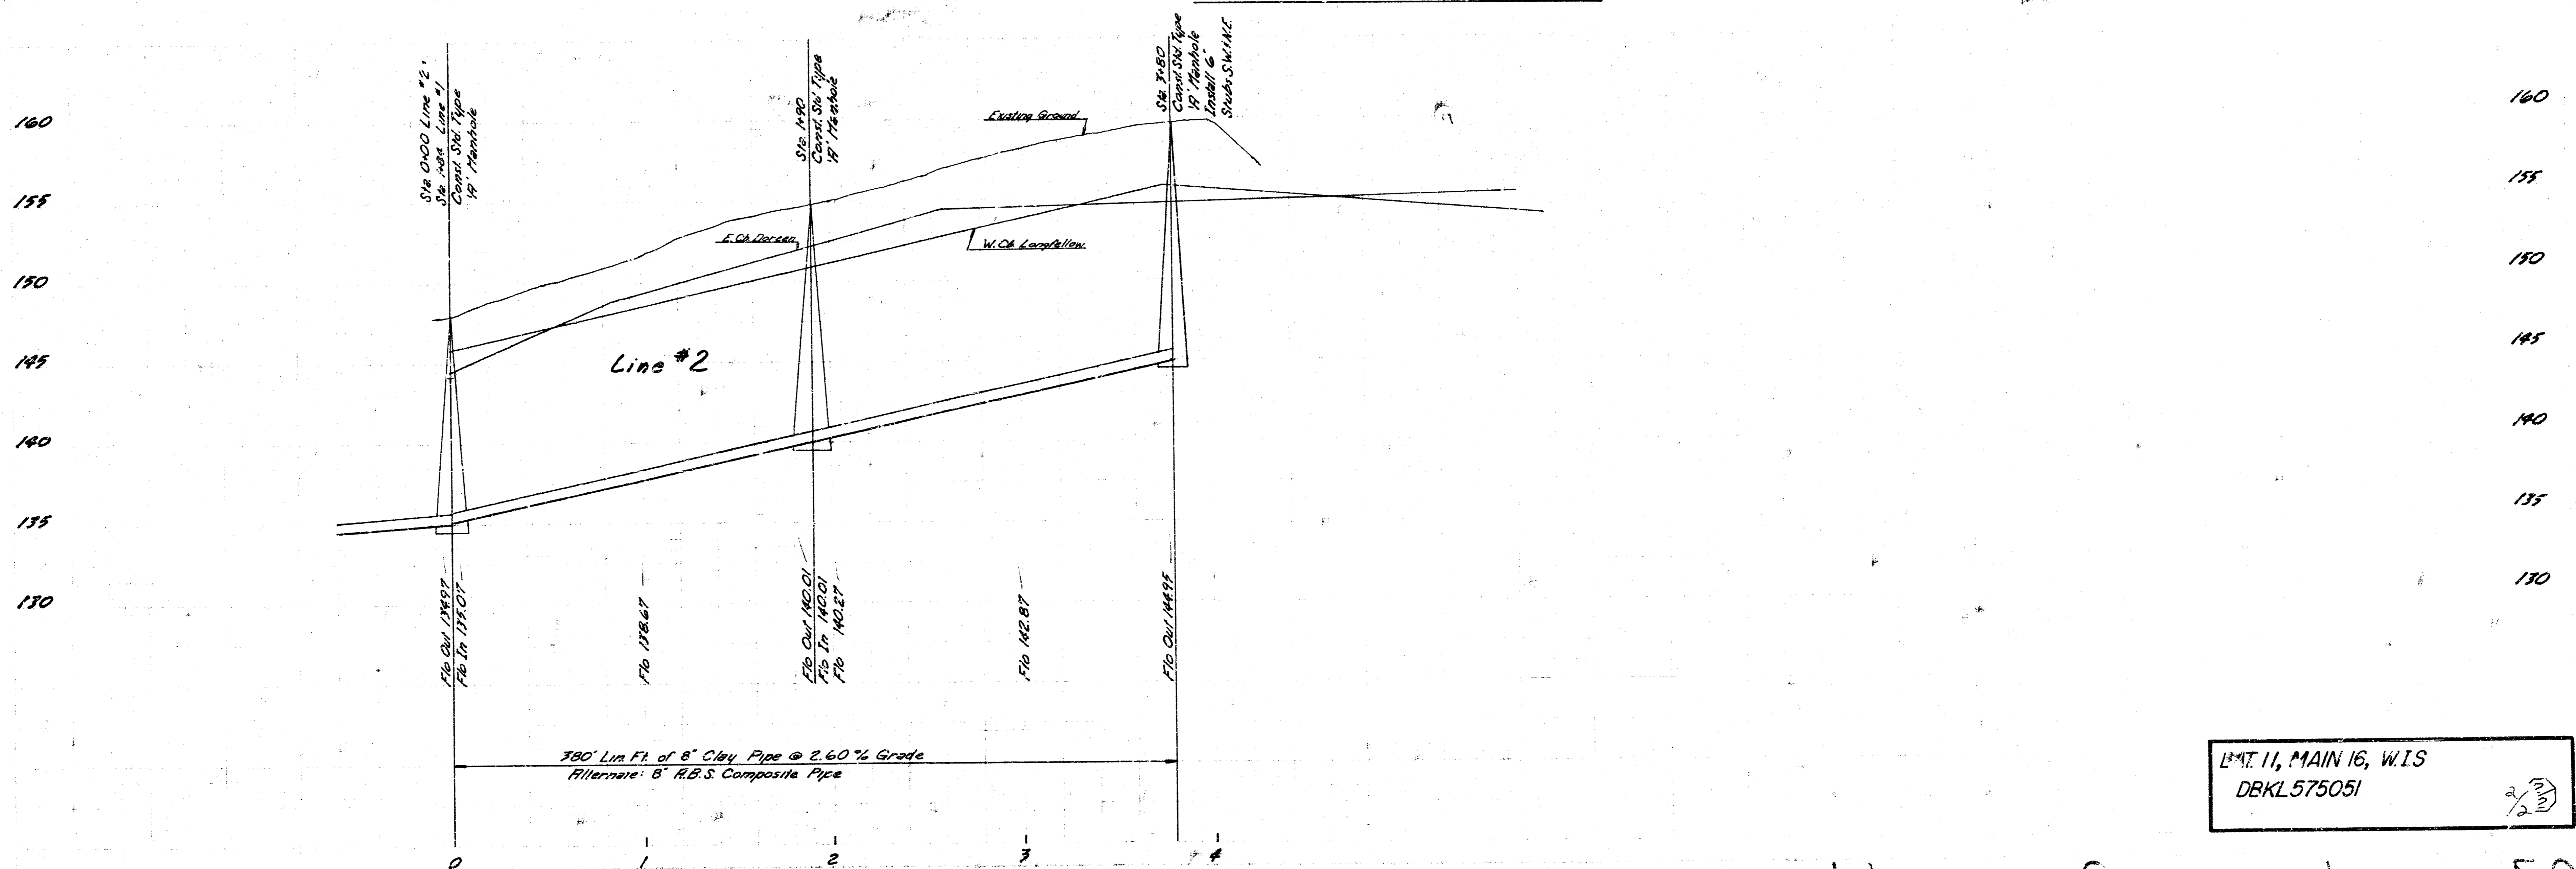

1"=40', MAIN 16, W.I.S
DEKL575051

14 8 4 50