



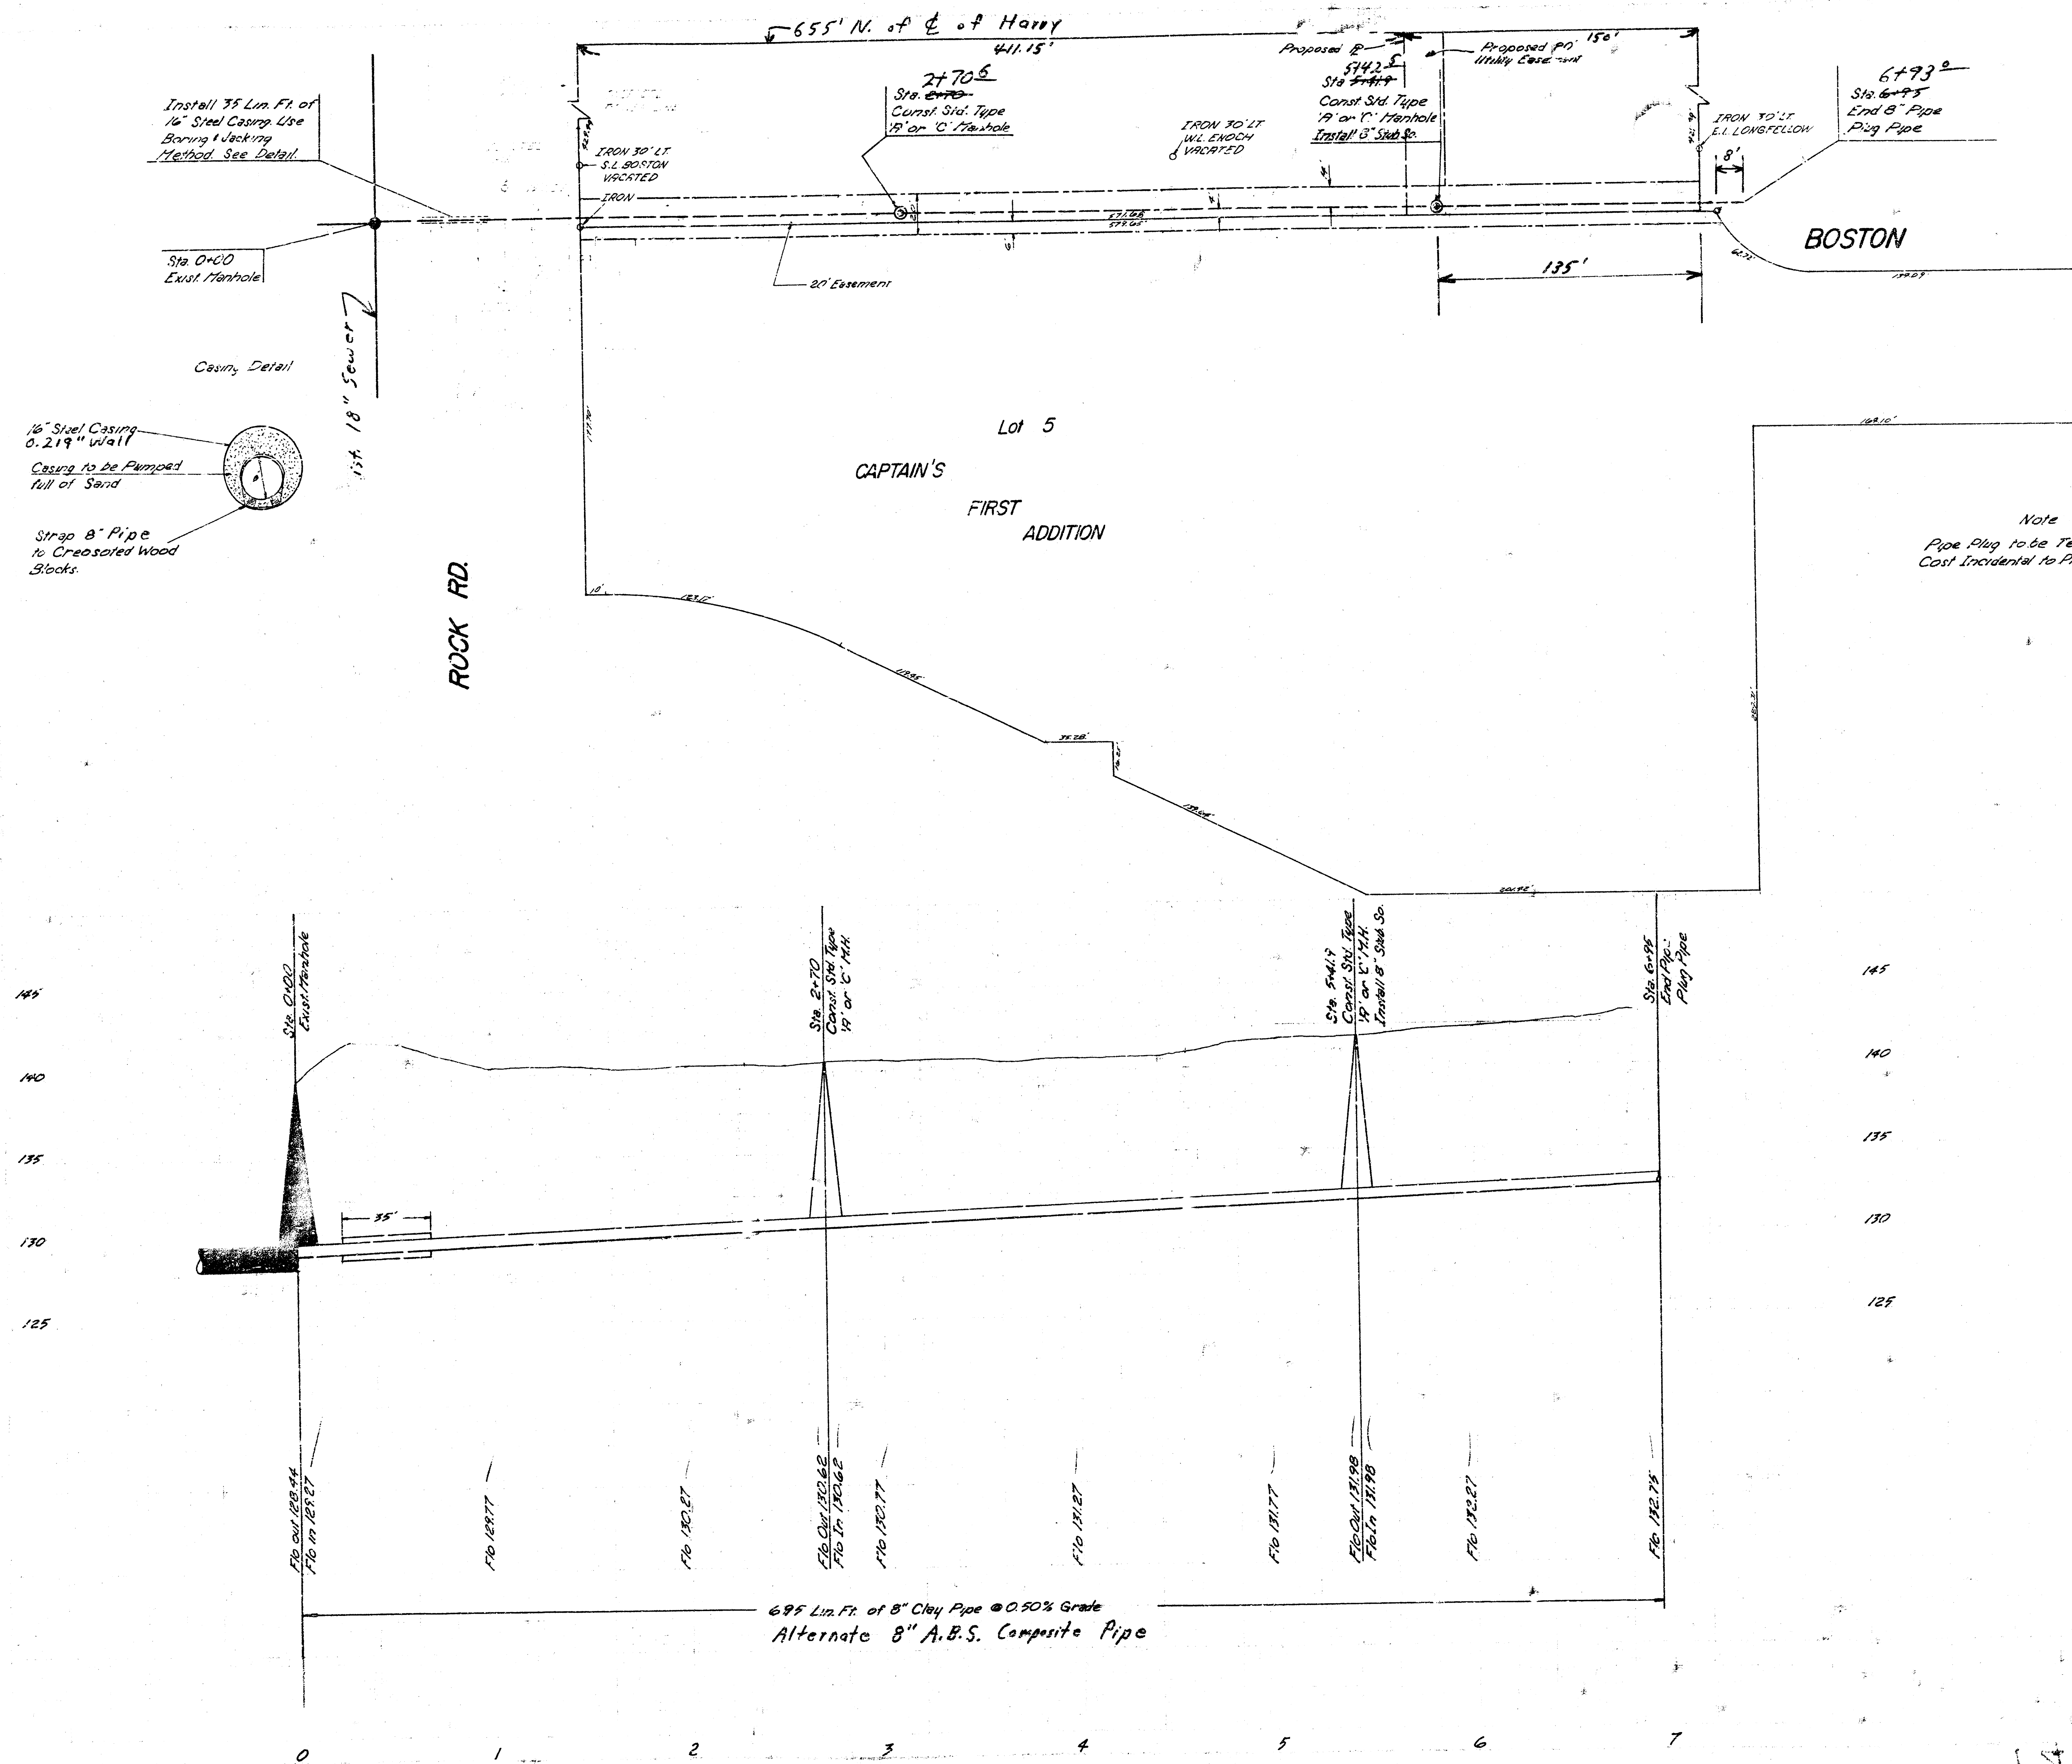


B.M. 145.41 Chiseled "X" in Ctr. of top W End Handrail U.S. Triple 8x8 R.C.B. 250' East of Rock Rd. on Harry.

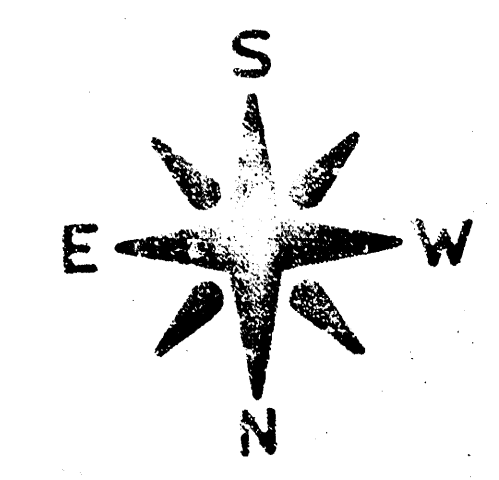

Note
Pipe Plug to be Temporary Type
Cost Incidental to Project.

Scale
Plan 1"=40'
Profile
H.C.R.T. 1"=40'
VERT. 1"=5'

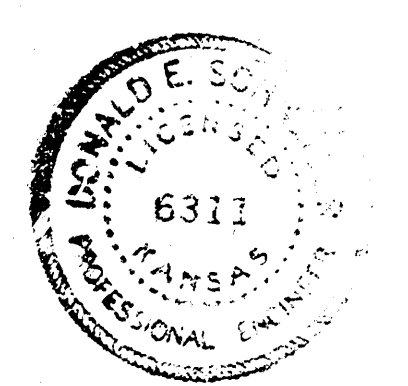

As Built 12-16-75

LAT. 12, MAIN 16, W.I.S.

CITY of WICHITA, KANSAS

R.W. LINN—CITY ENGINEER

Project DBKL575055

DATE SEPT. 24, 1975