
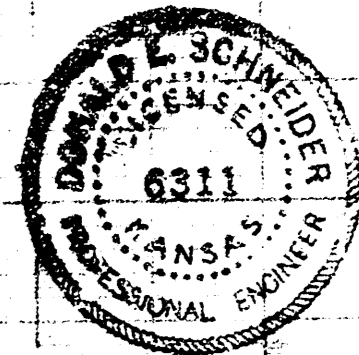
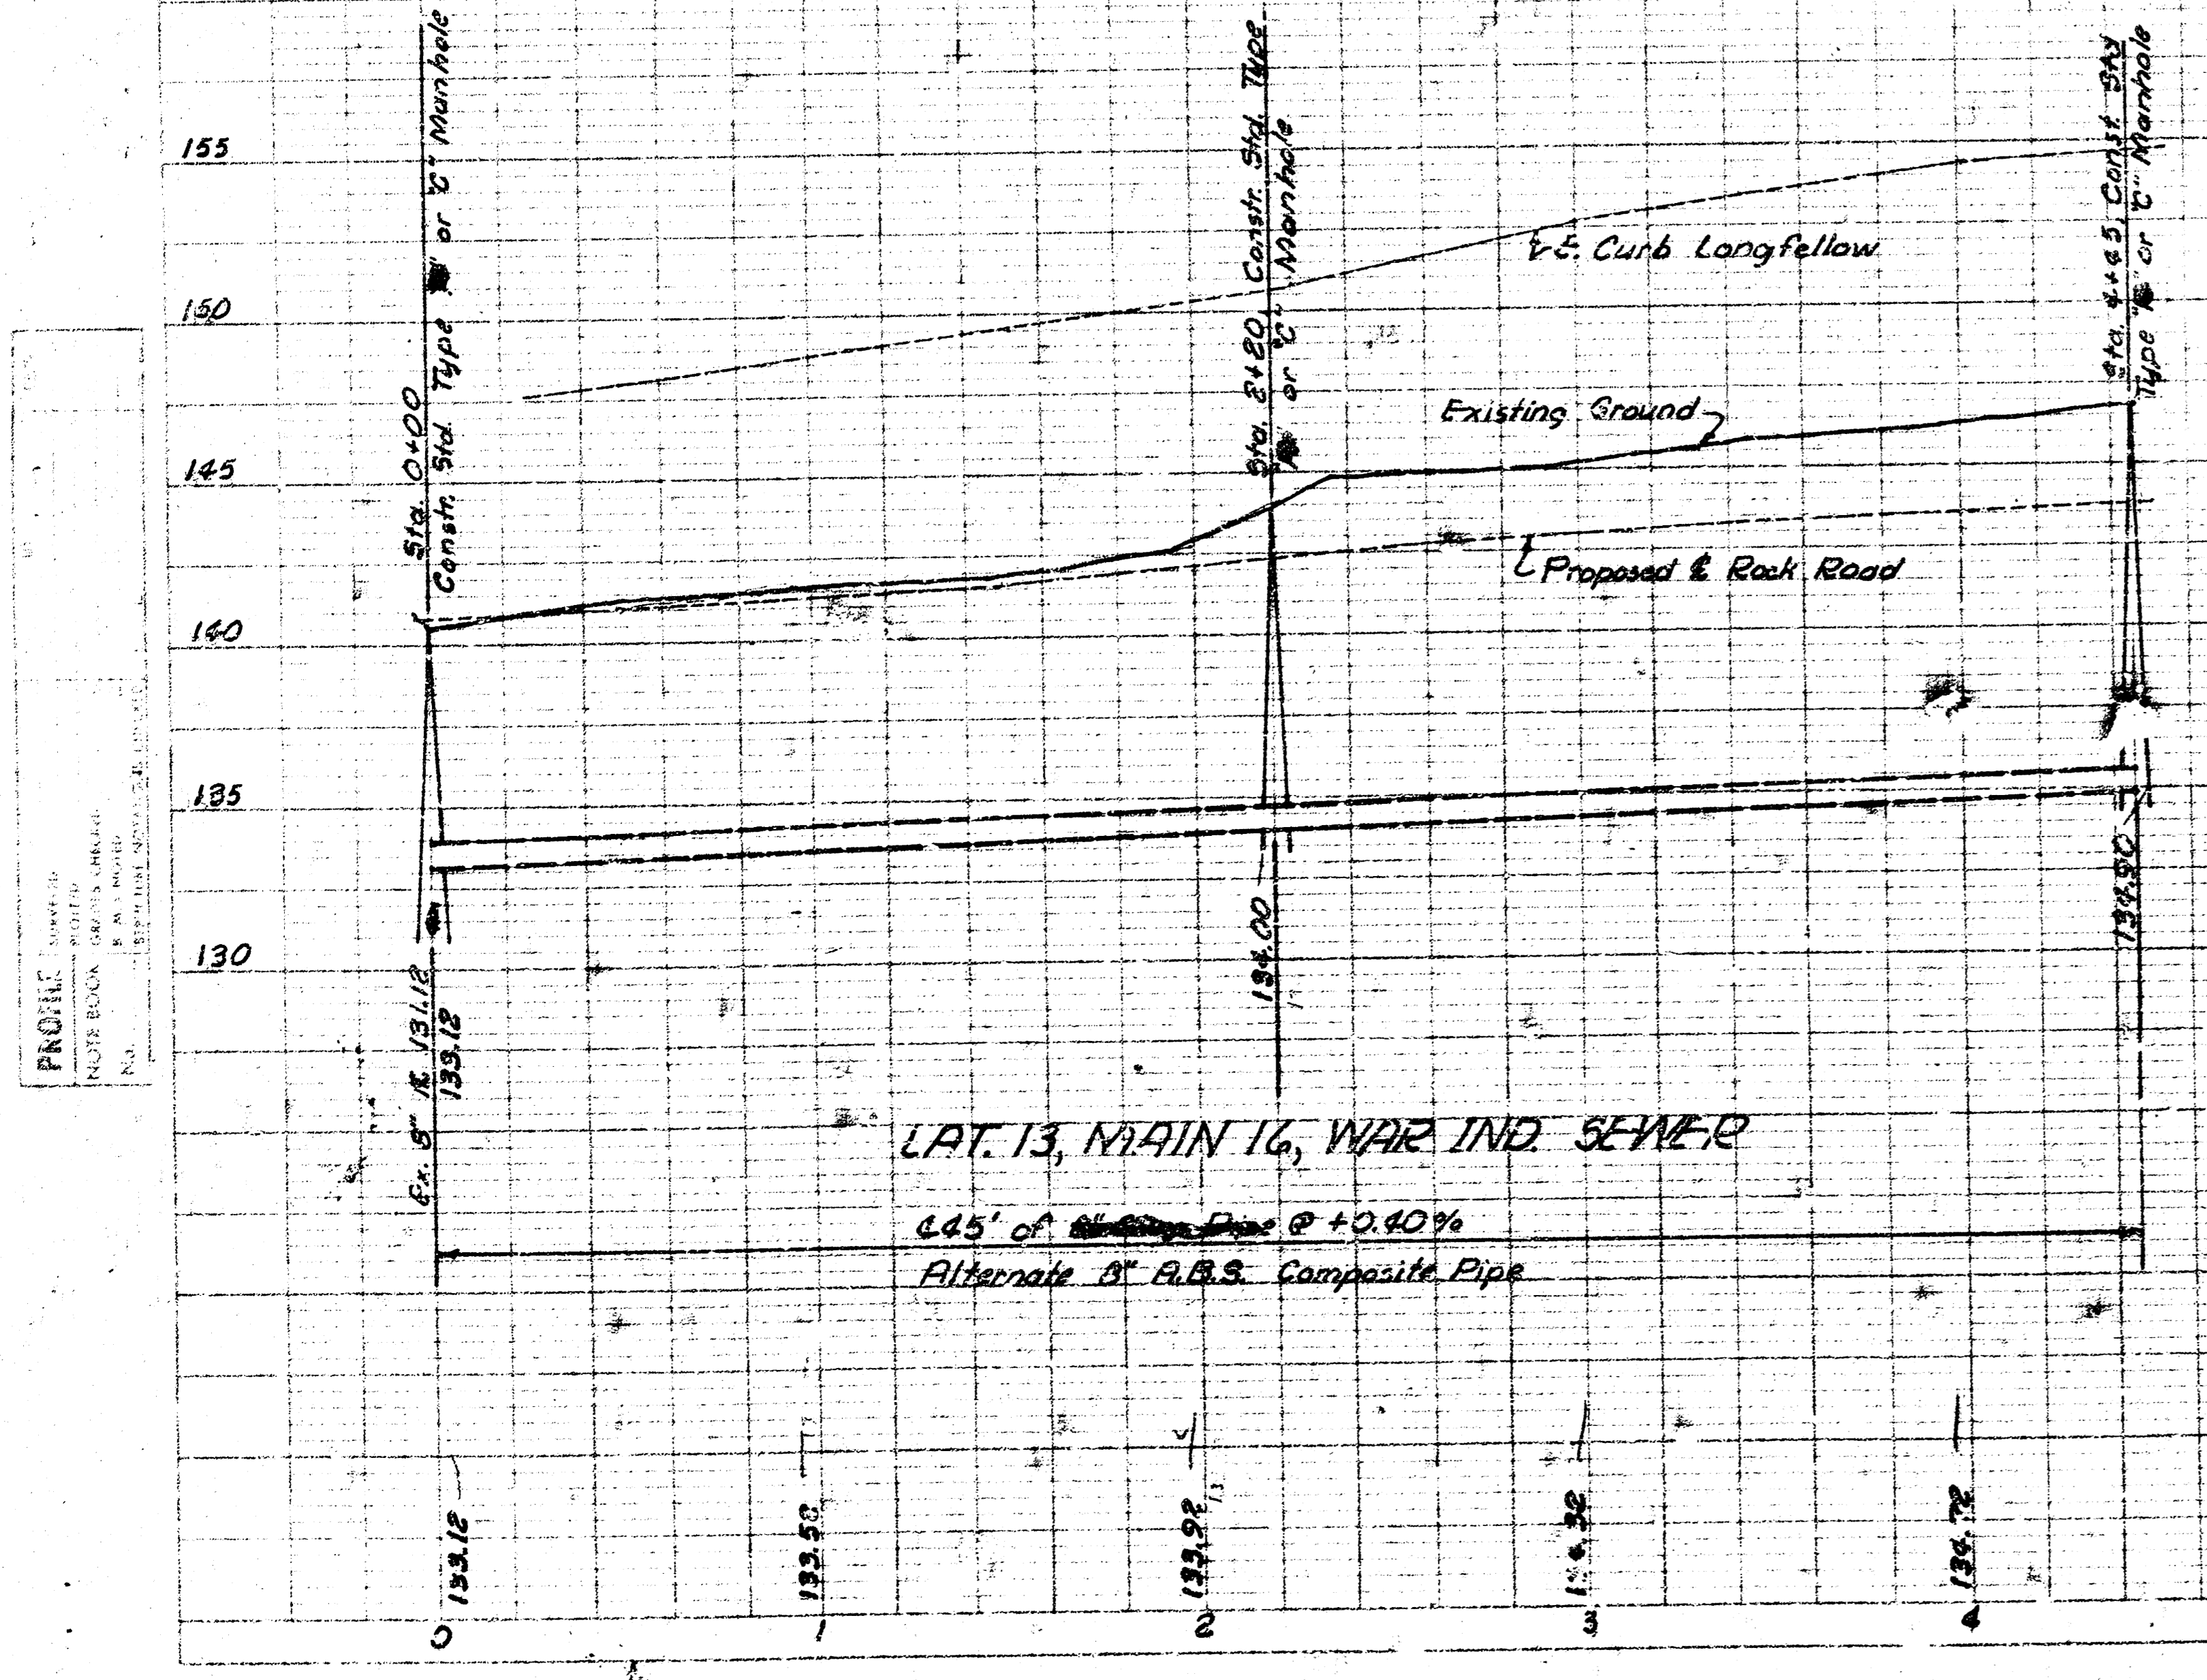


PLAN SHEET DBL-102 (4 of 13)  
 PROJECT: BRANSON, WICHITA, KANSAS  
 DATE: 6-28-77  
 DRAWN BY: R.W. LINN  
 CHECKED BY: R.W. LINN

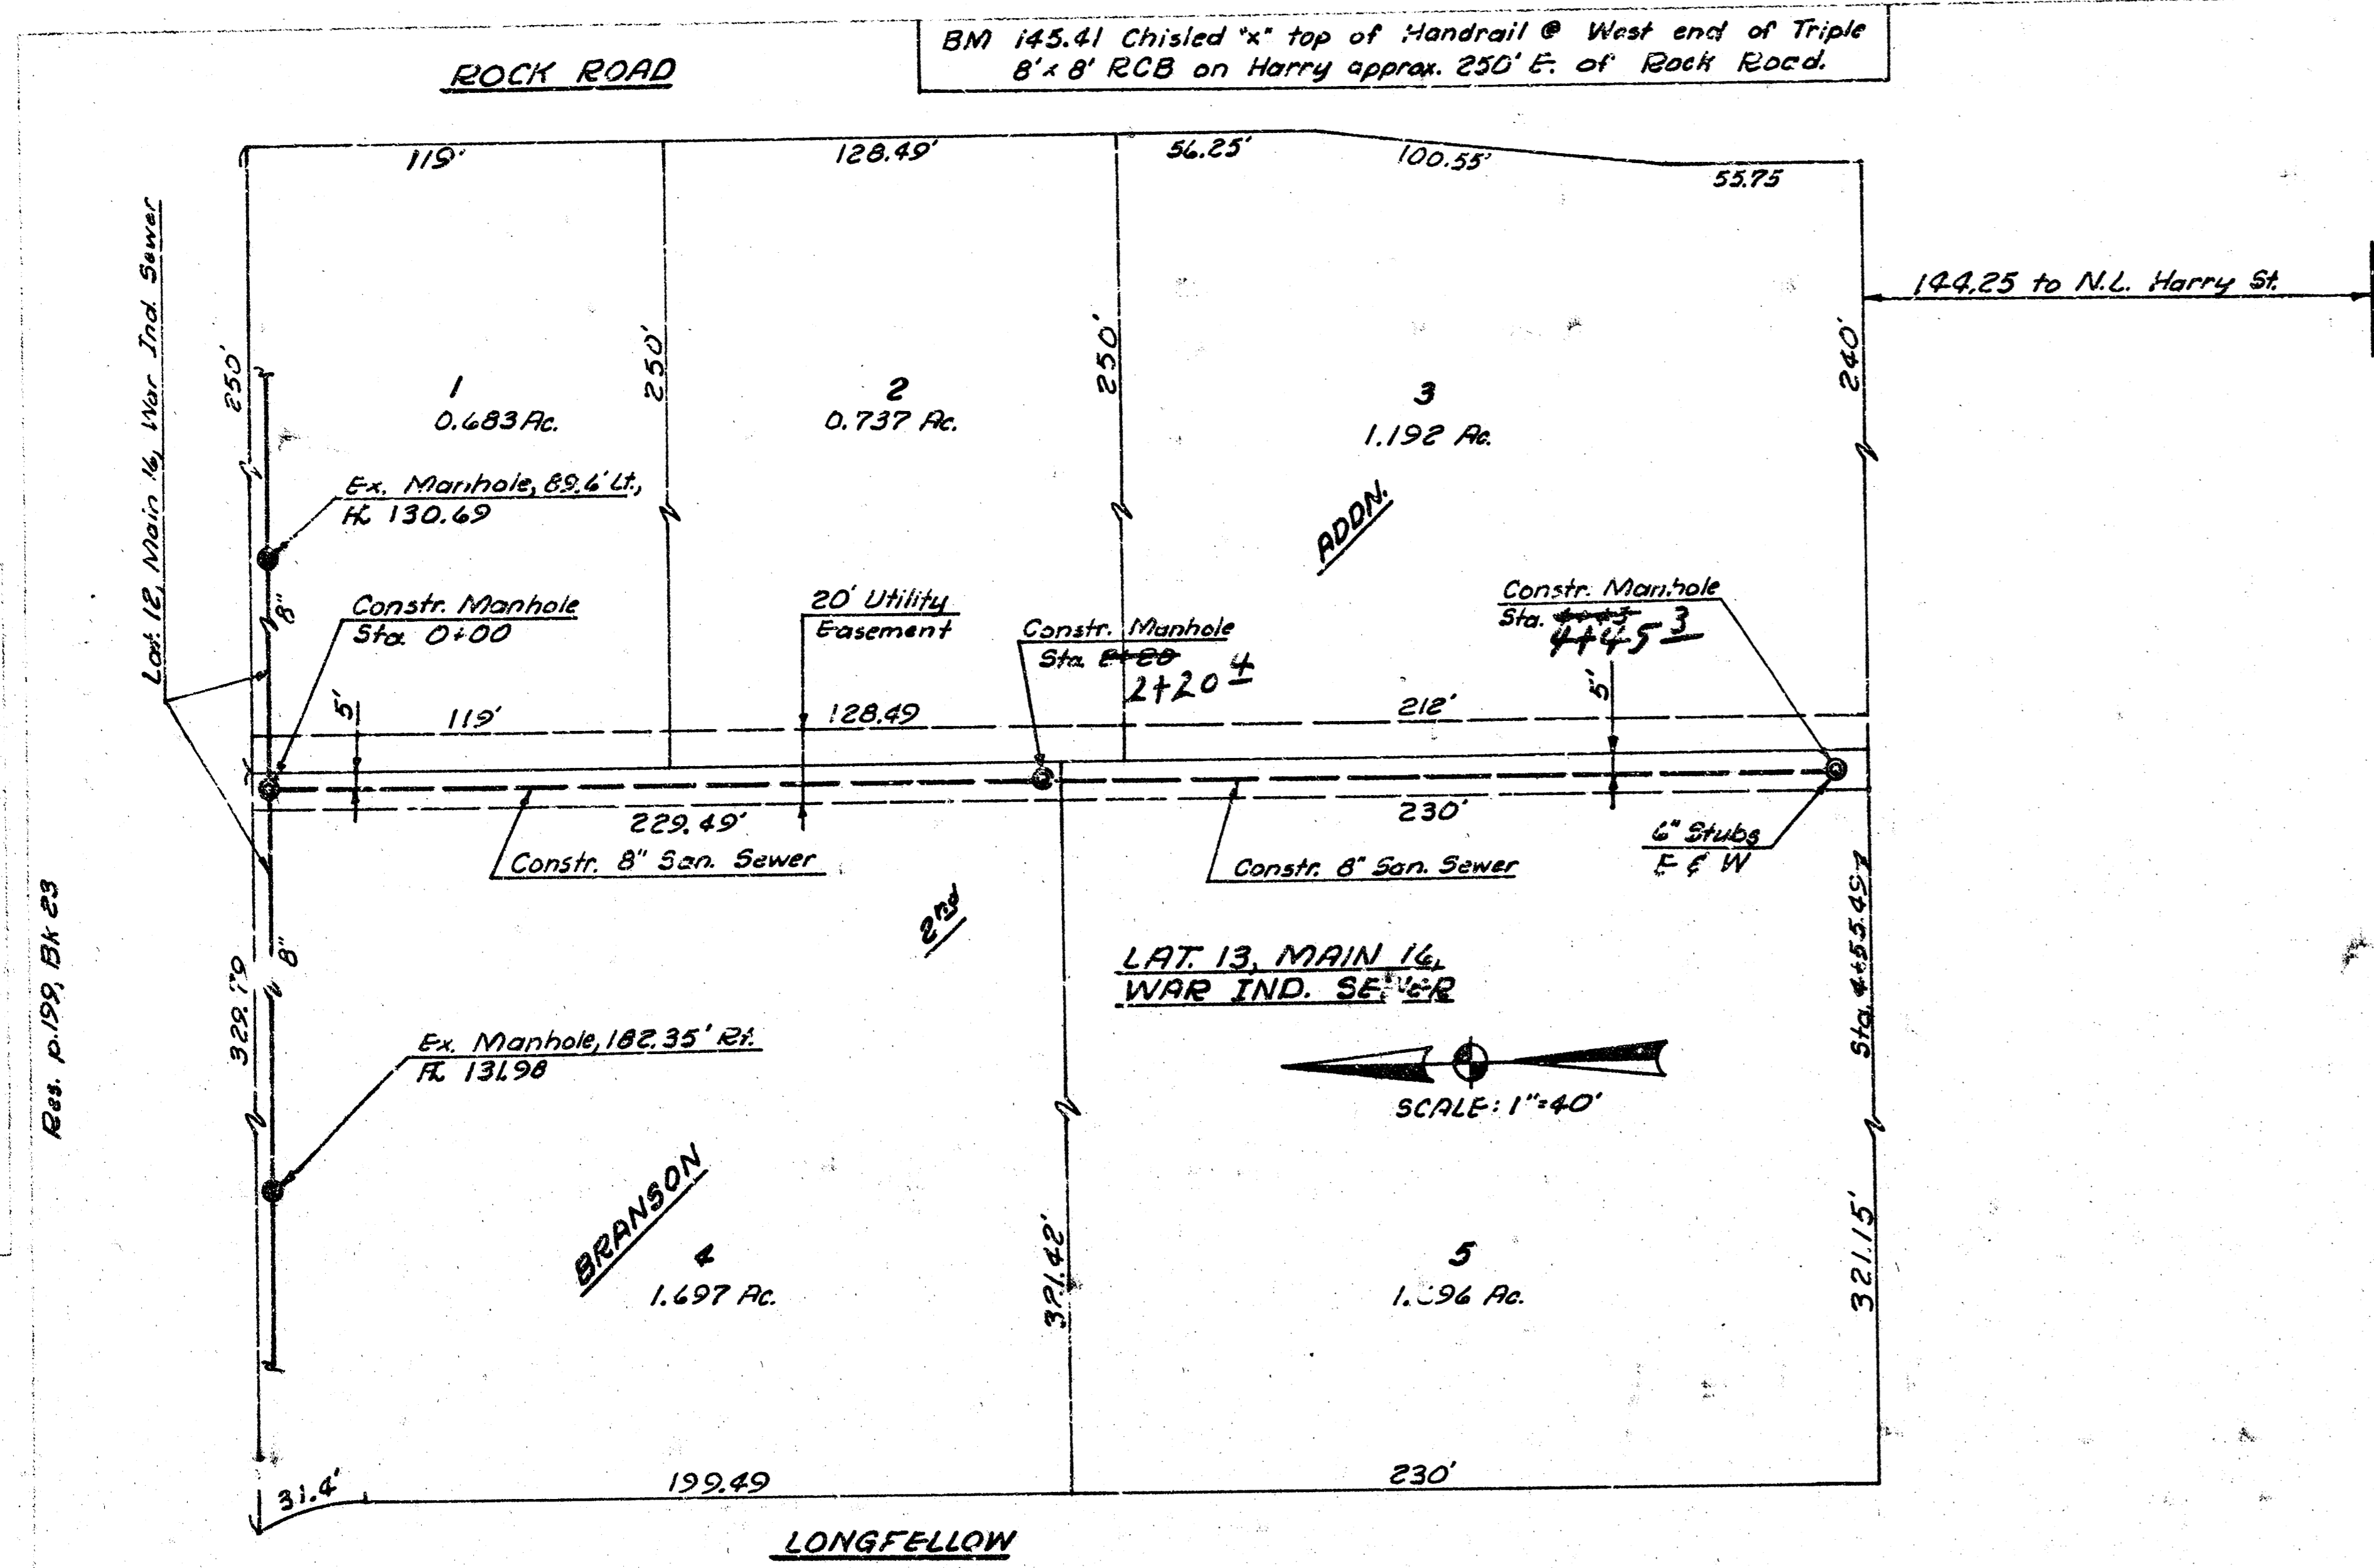

As built 6-28-77

LAT 13, MAIN 16, W.I.S.  
 CITY OF WICHITA, KANSAS  
 R.W. LINN - CITY ENGINEER  
 Project DBL 57508U  
 DATE 6-28-77 Sheet 1 of 1