
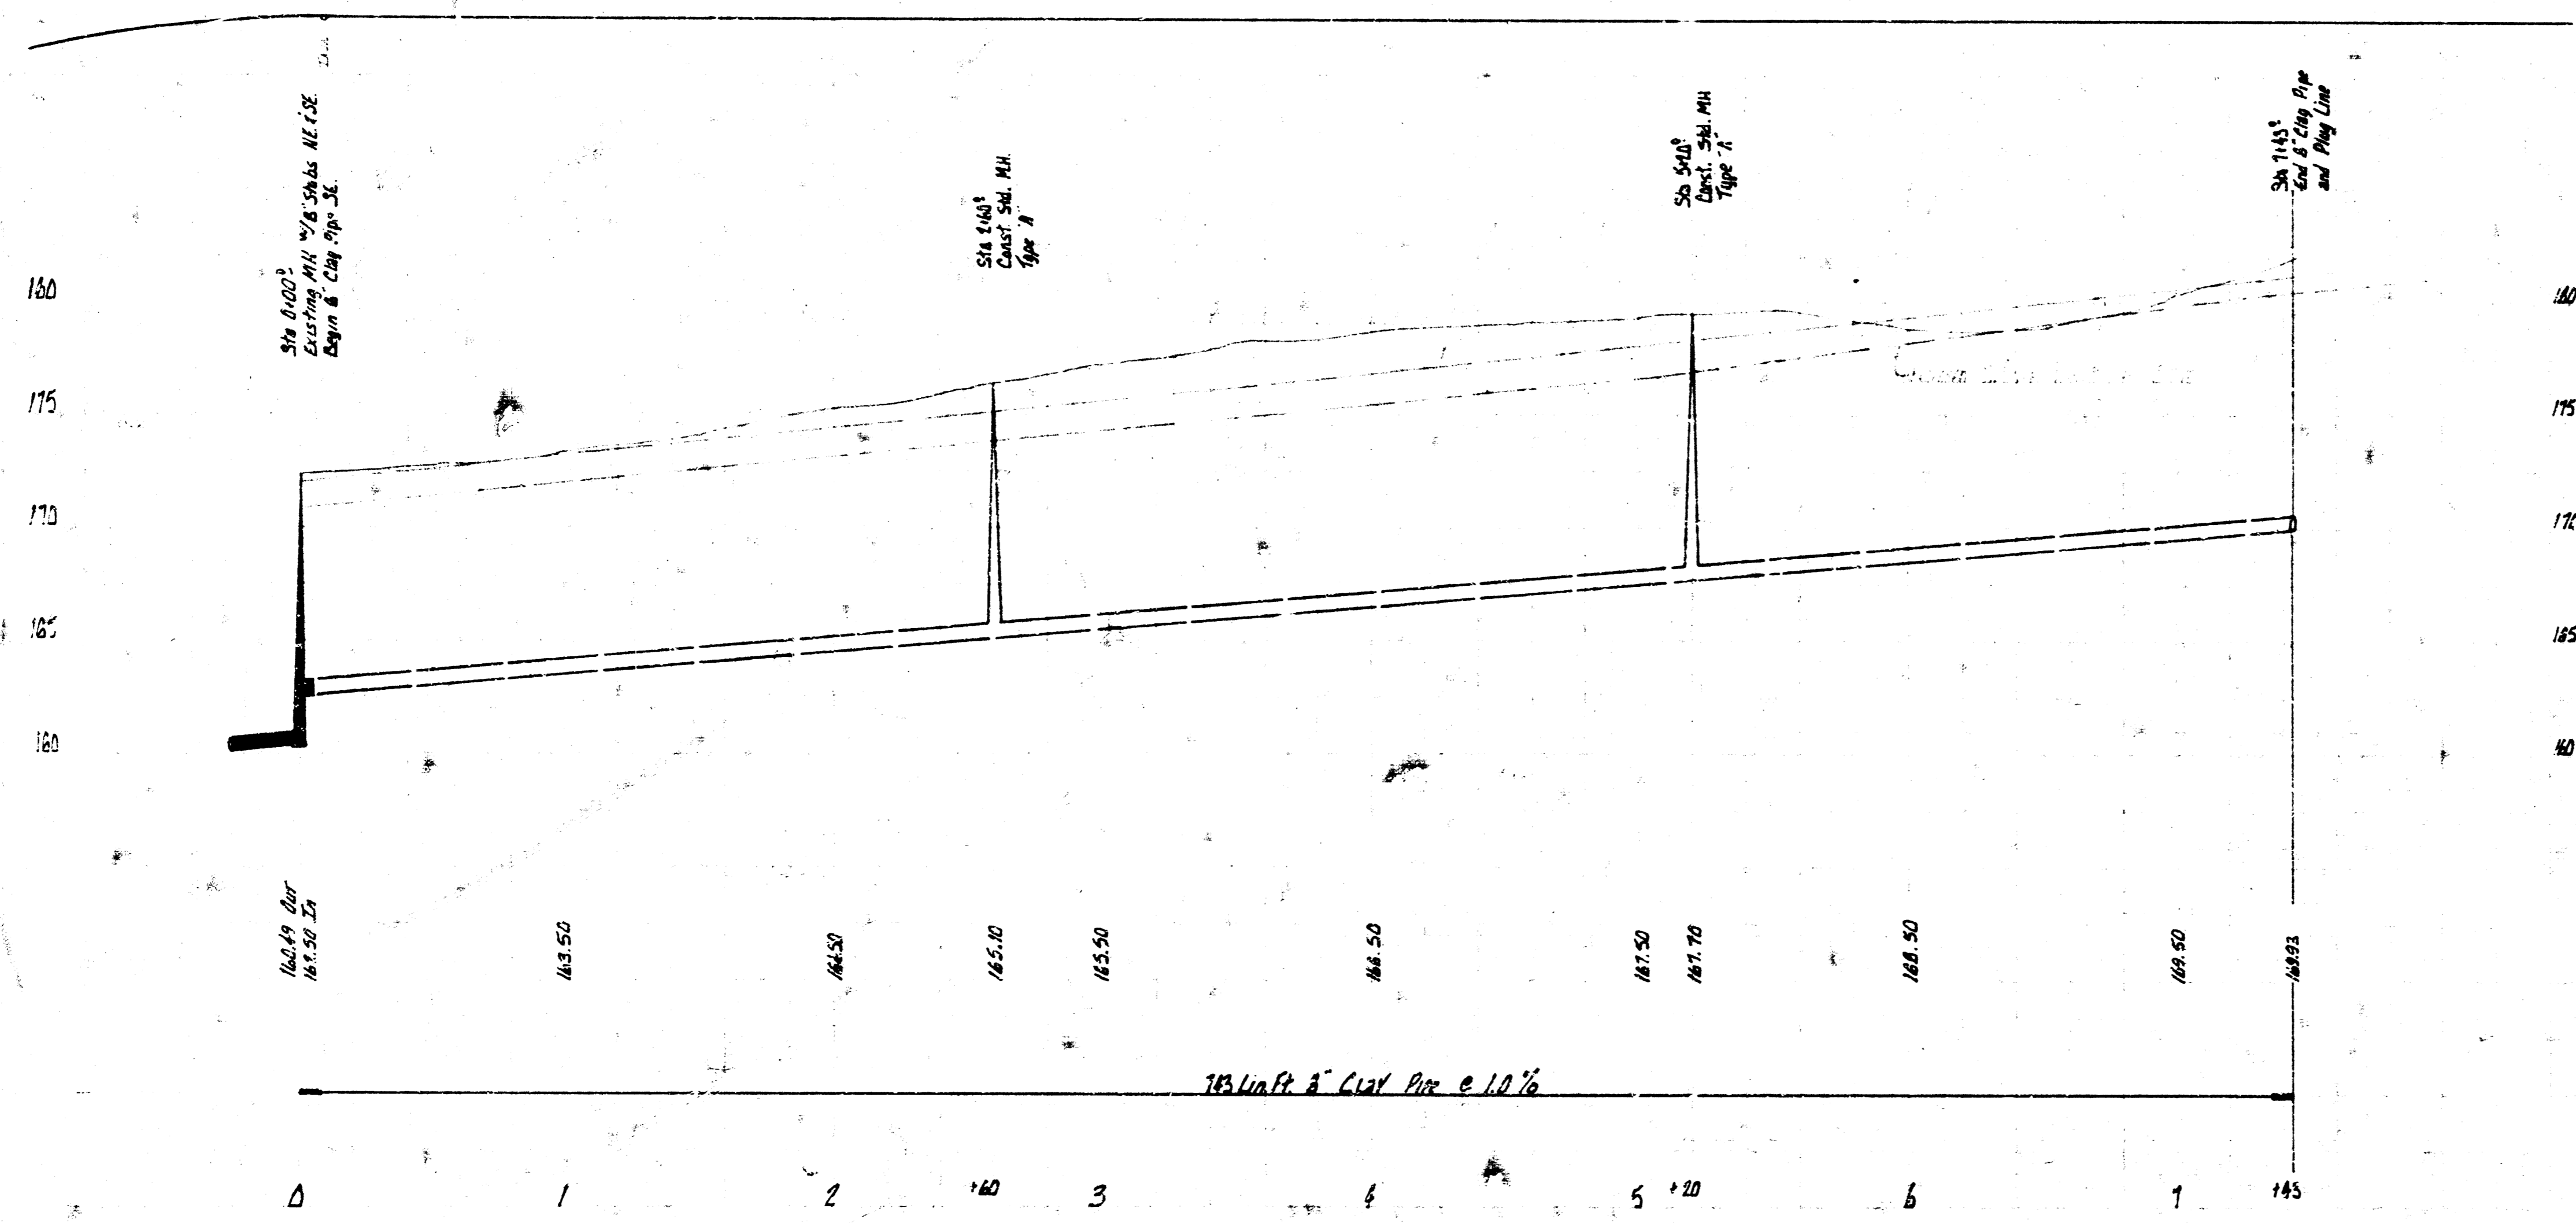


BM 165.71 on Center Line of Rock Rd. & Center of Pawnee West  
 SCALE:  
 PLAN 1"=40' PROFILE 1"=40' HOR. 1"=5' VERT.

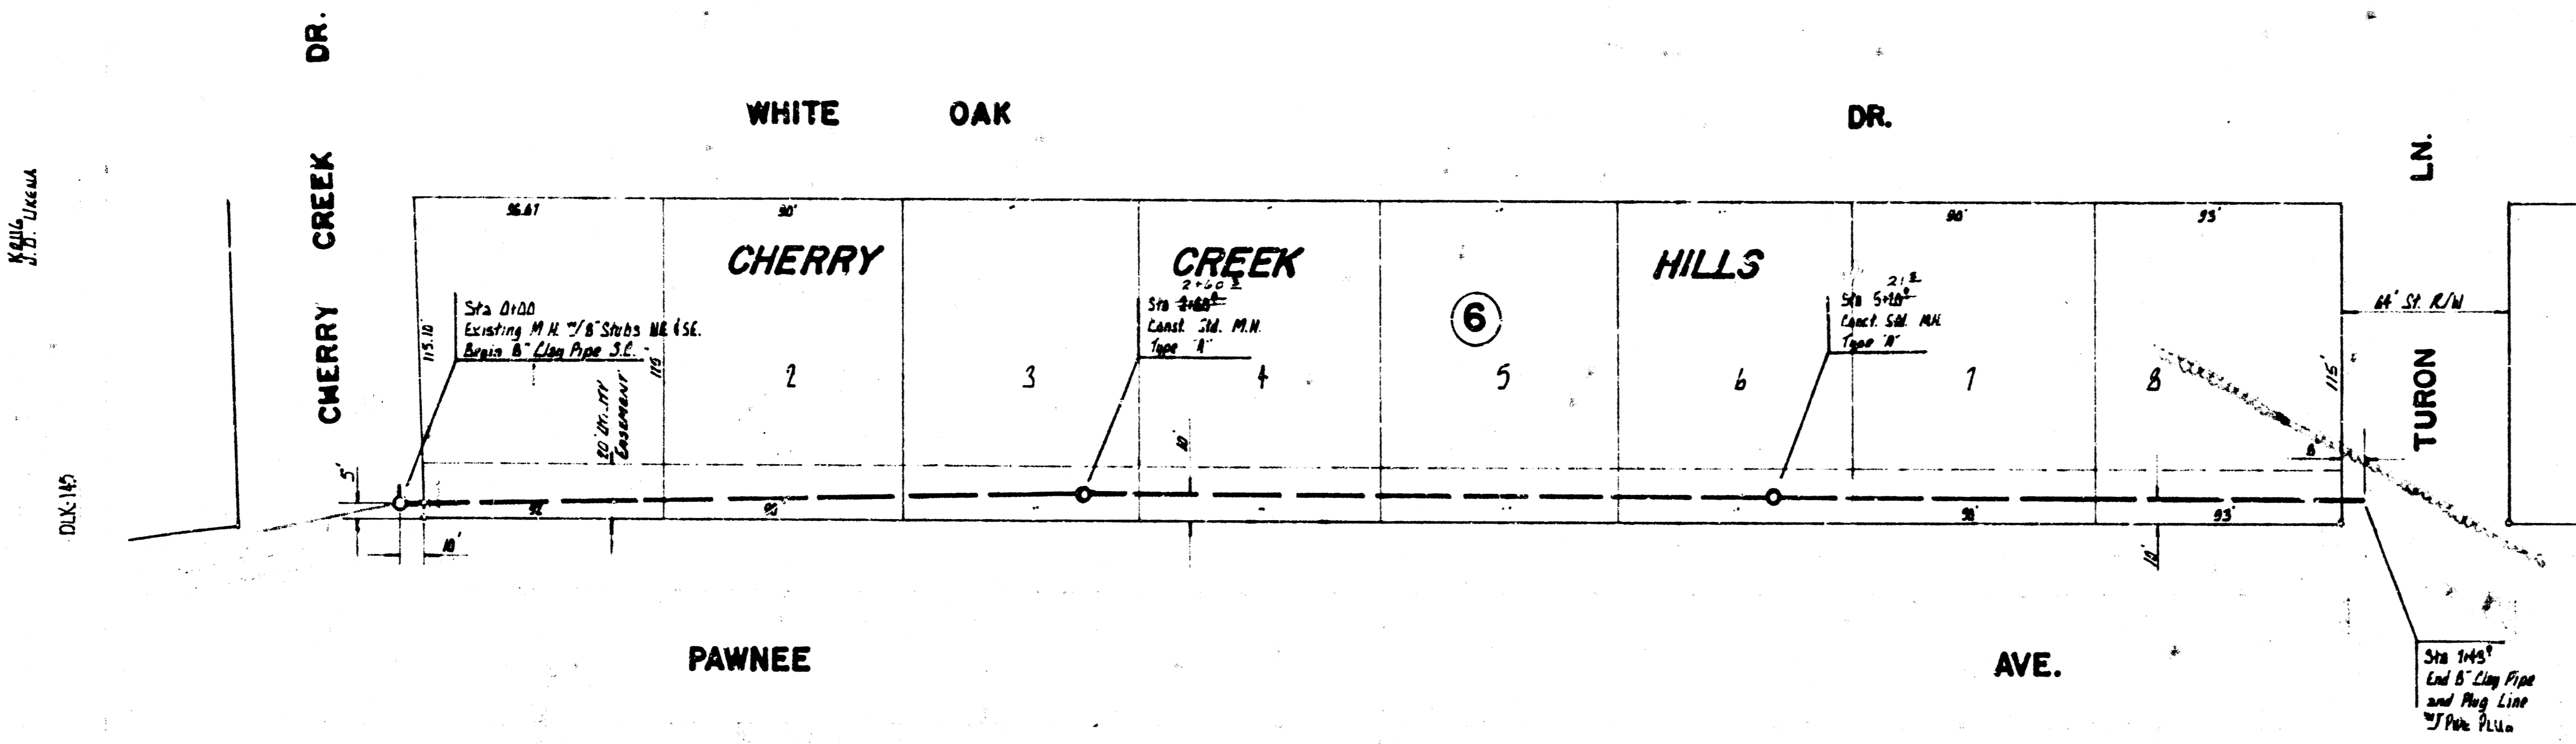

NOTE: CONSTRUCTION OF THIS PROJECT SHALL BE COORDINATED WITH MAIN SEWER CONSTRUCTION ALONG THE EAST SIDE OF ROCK ROAD.

As Built Final Plans 280 P  
**Lat. 2, Main 17, W.I.S.**  
 R. W. LINN City Engineer  
 City of Wichita, Kansas  
 Date: July 1973  
 Project No. DBKL573013