


10415
10415

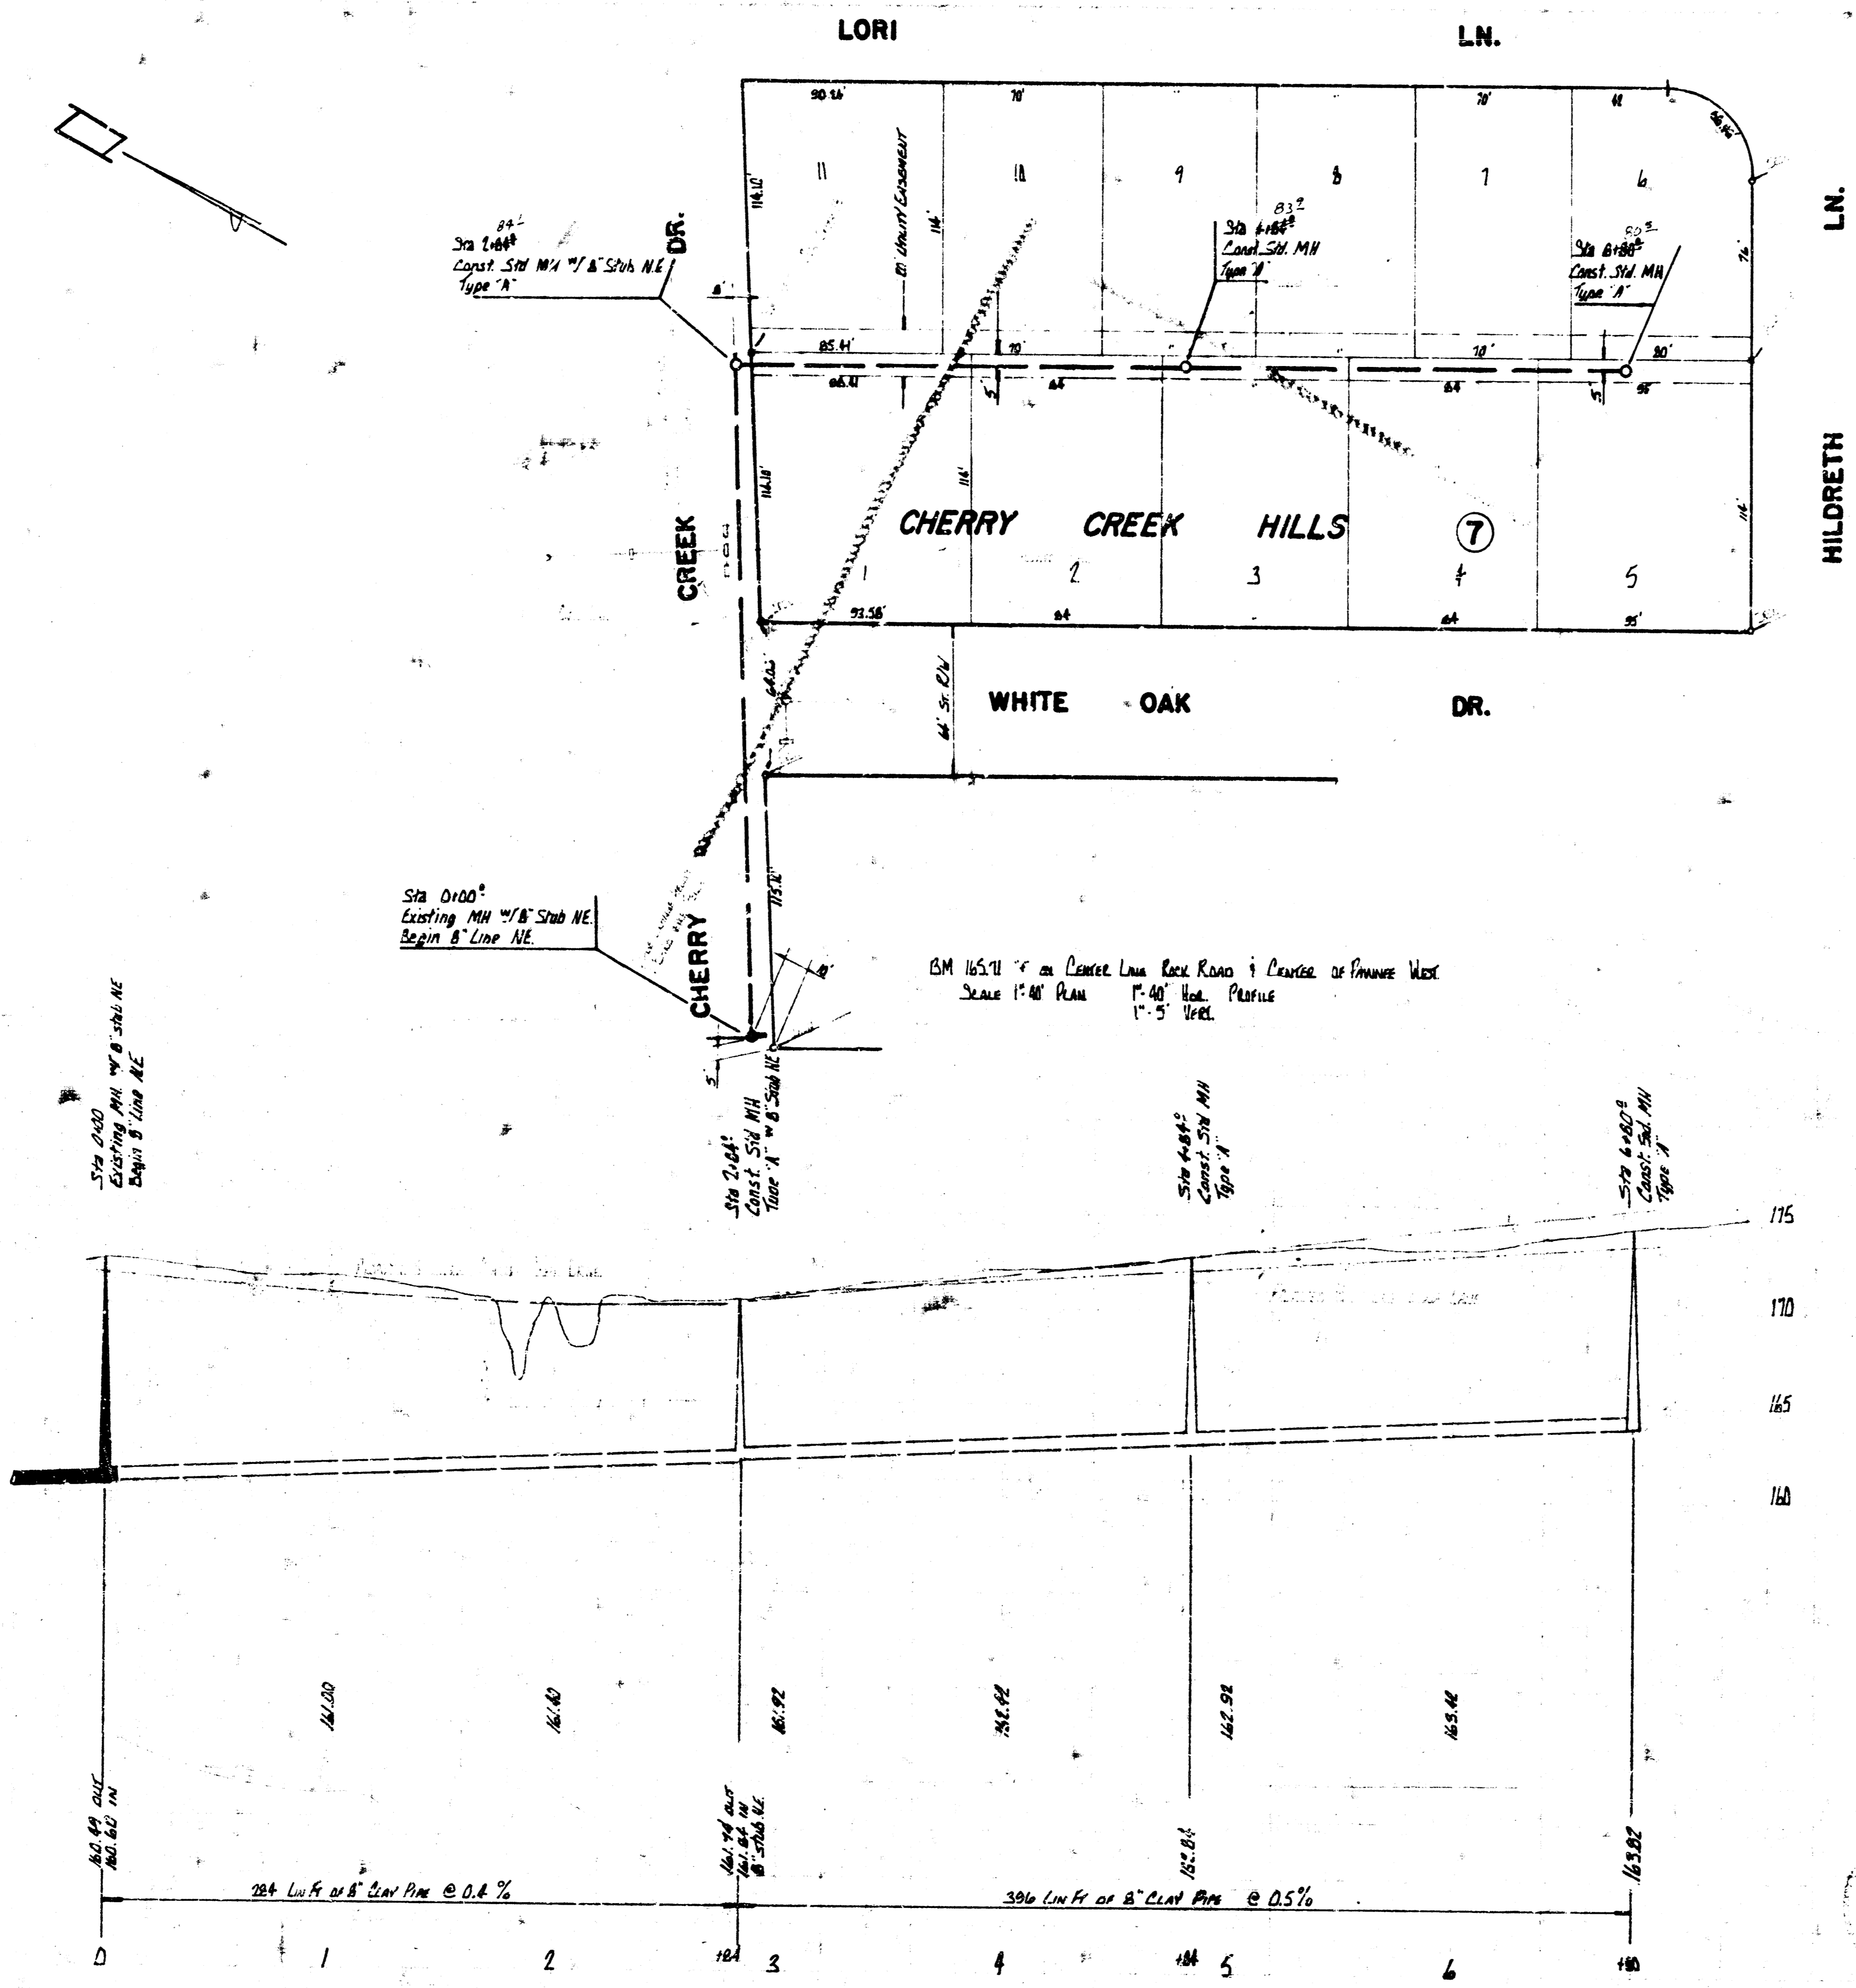

NOTE: CONSTRUCTION OF THIS PROJECT SHALL BE COORDINATED WITH MAIN SEWER CONSTRUCTION ALONG THE EAST SIDE OF ROCK ROAD.

As Built Final Plans 280-Y
Lot 3, Main 17, W.I.S.
R.W. LINN CITY ENGINEER
CITY OF WICHITA, KANSAS
DATE: July 1973
PROJECT NO. DBKL573014

14 2 5 - 140