



B. M. 171.69 R. R. Spk. N. face
Osage Orange hedge SW cor.
Cherry Creek Dr. & Lori Ln.

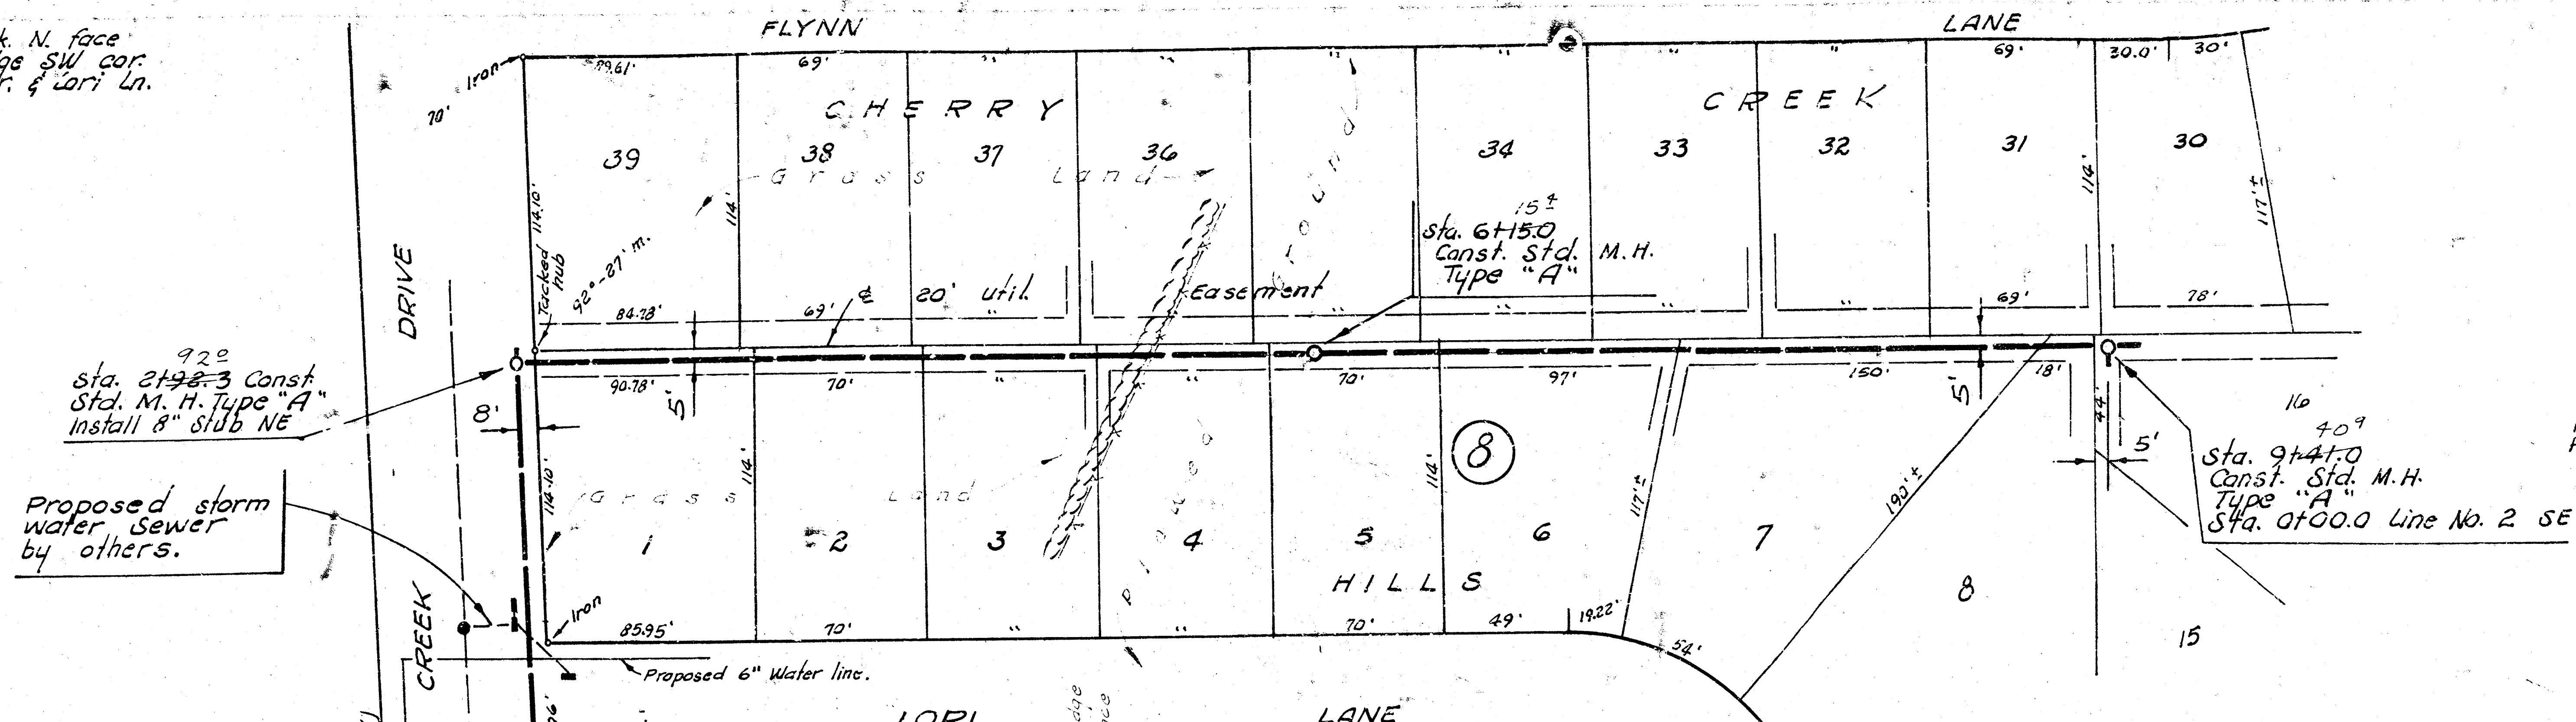


Plan Scale 1" = 40'
Profile Scale 1" = 40' Horiz.
1" = 5' Vert.


Sta. 0100.0
Exist. M. H.
Exist. 8" Stub NE.

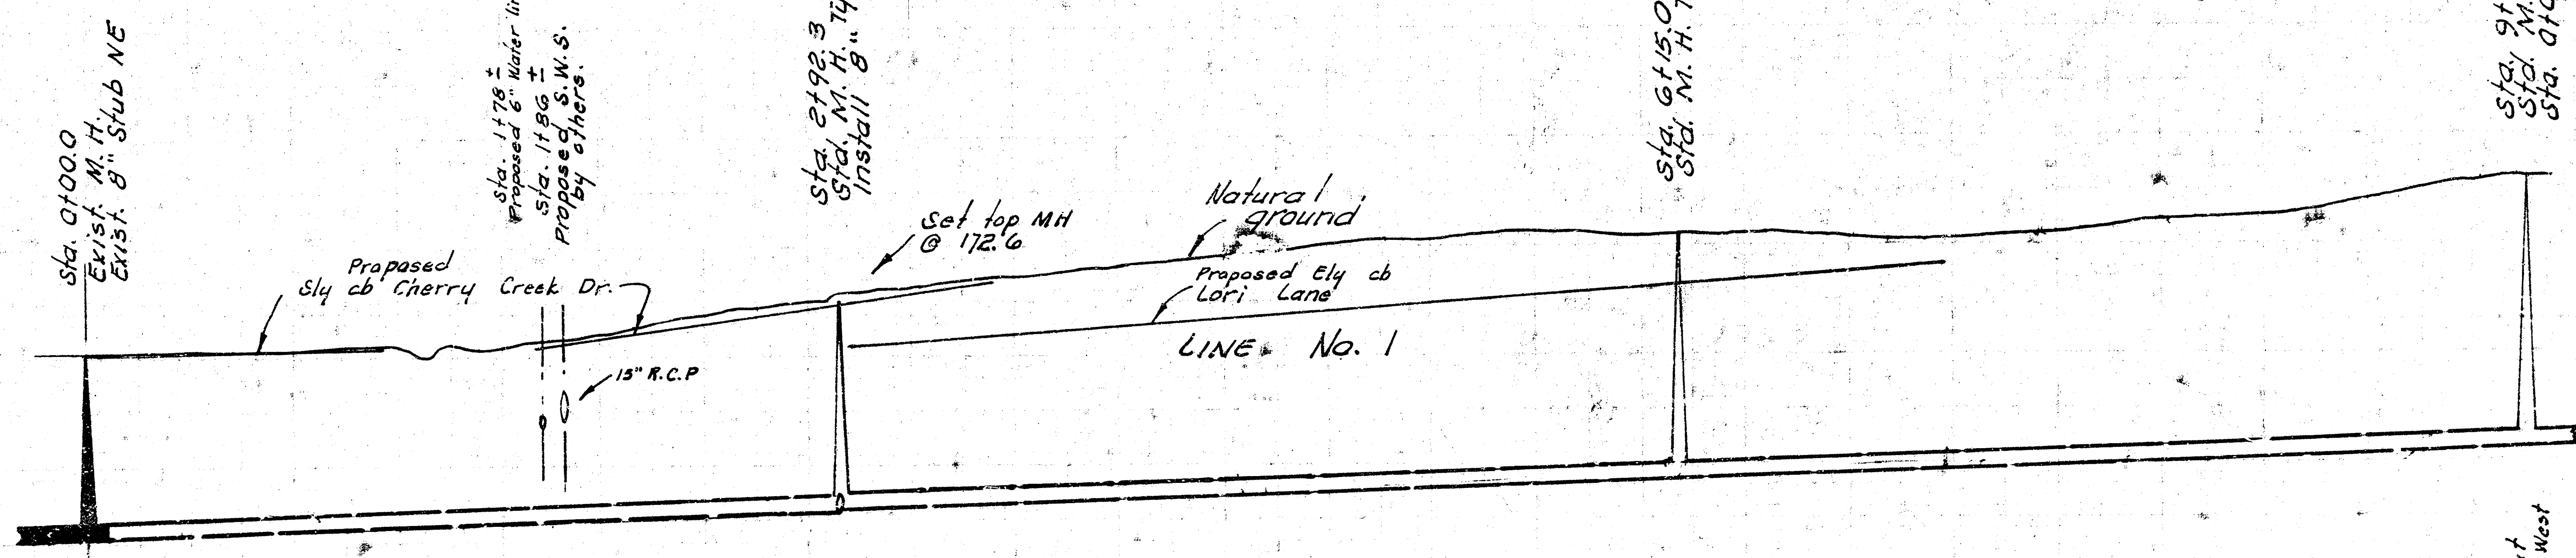


NOTE: CONSTRUCTION OF THIS PROJECT SHALL BE
COORDINATED WITH MAIN SEWER CONSTRUCTION
ALONG THE EAST SIDE OF ROCK ROAD.

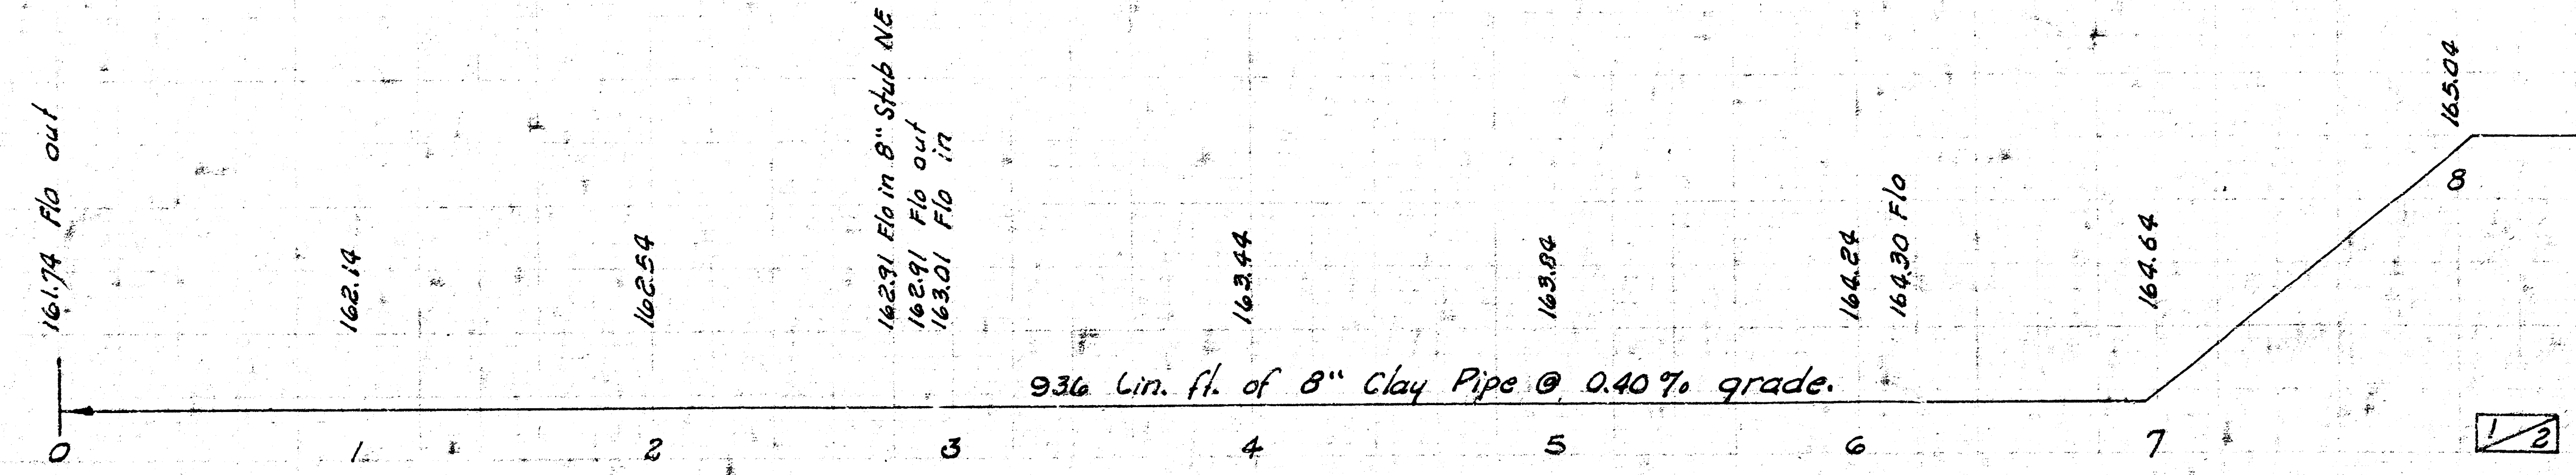

LAT. 4, MAIN 17, W. I. S.
CITY OF WICHITA, KANSAS
R. W. LINN — CITY ENGINEER
JULY 1973 PROJECT NO. DBKLS73015

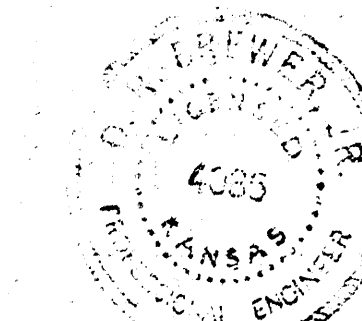

As Built Final Map 280-4

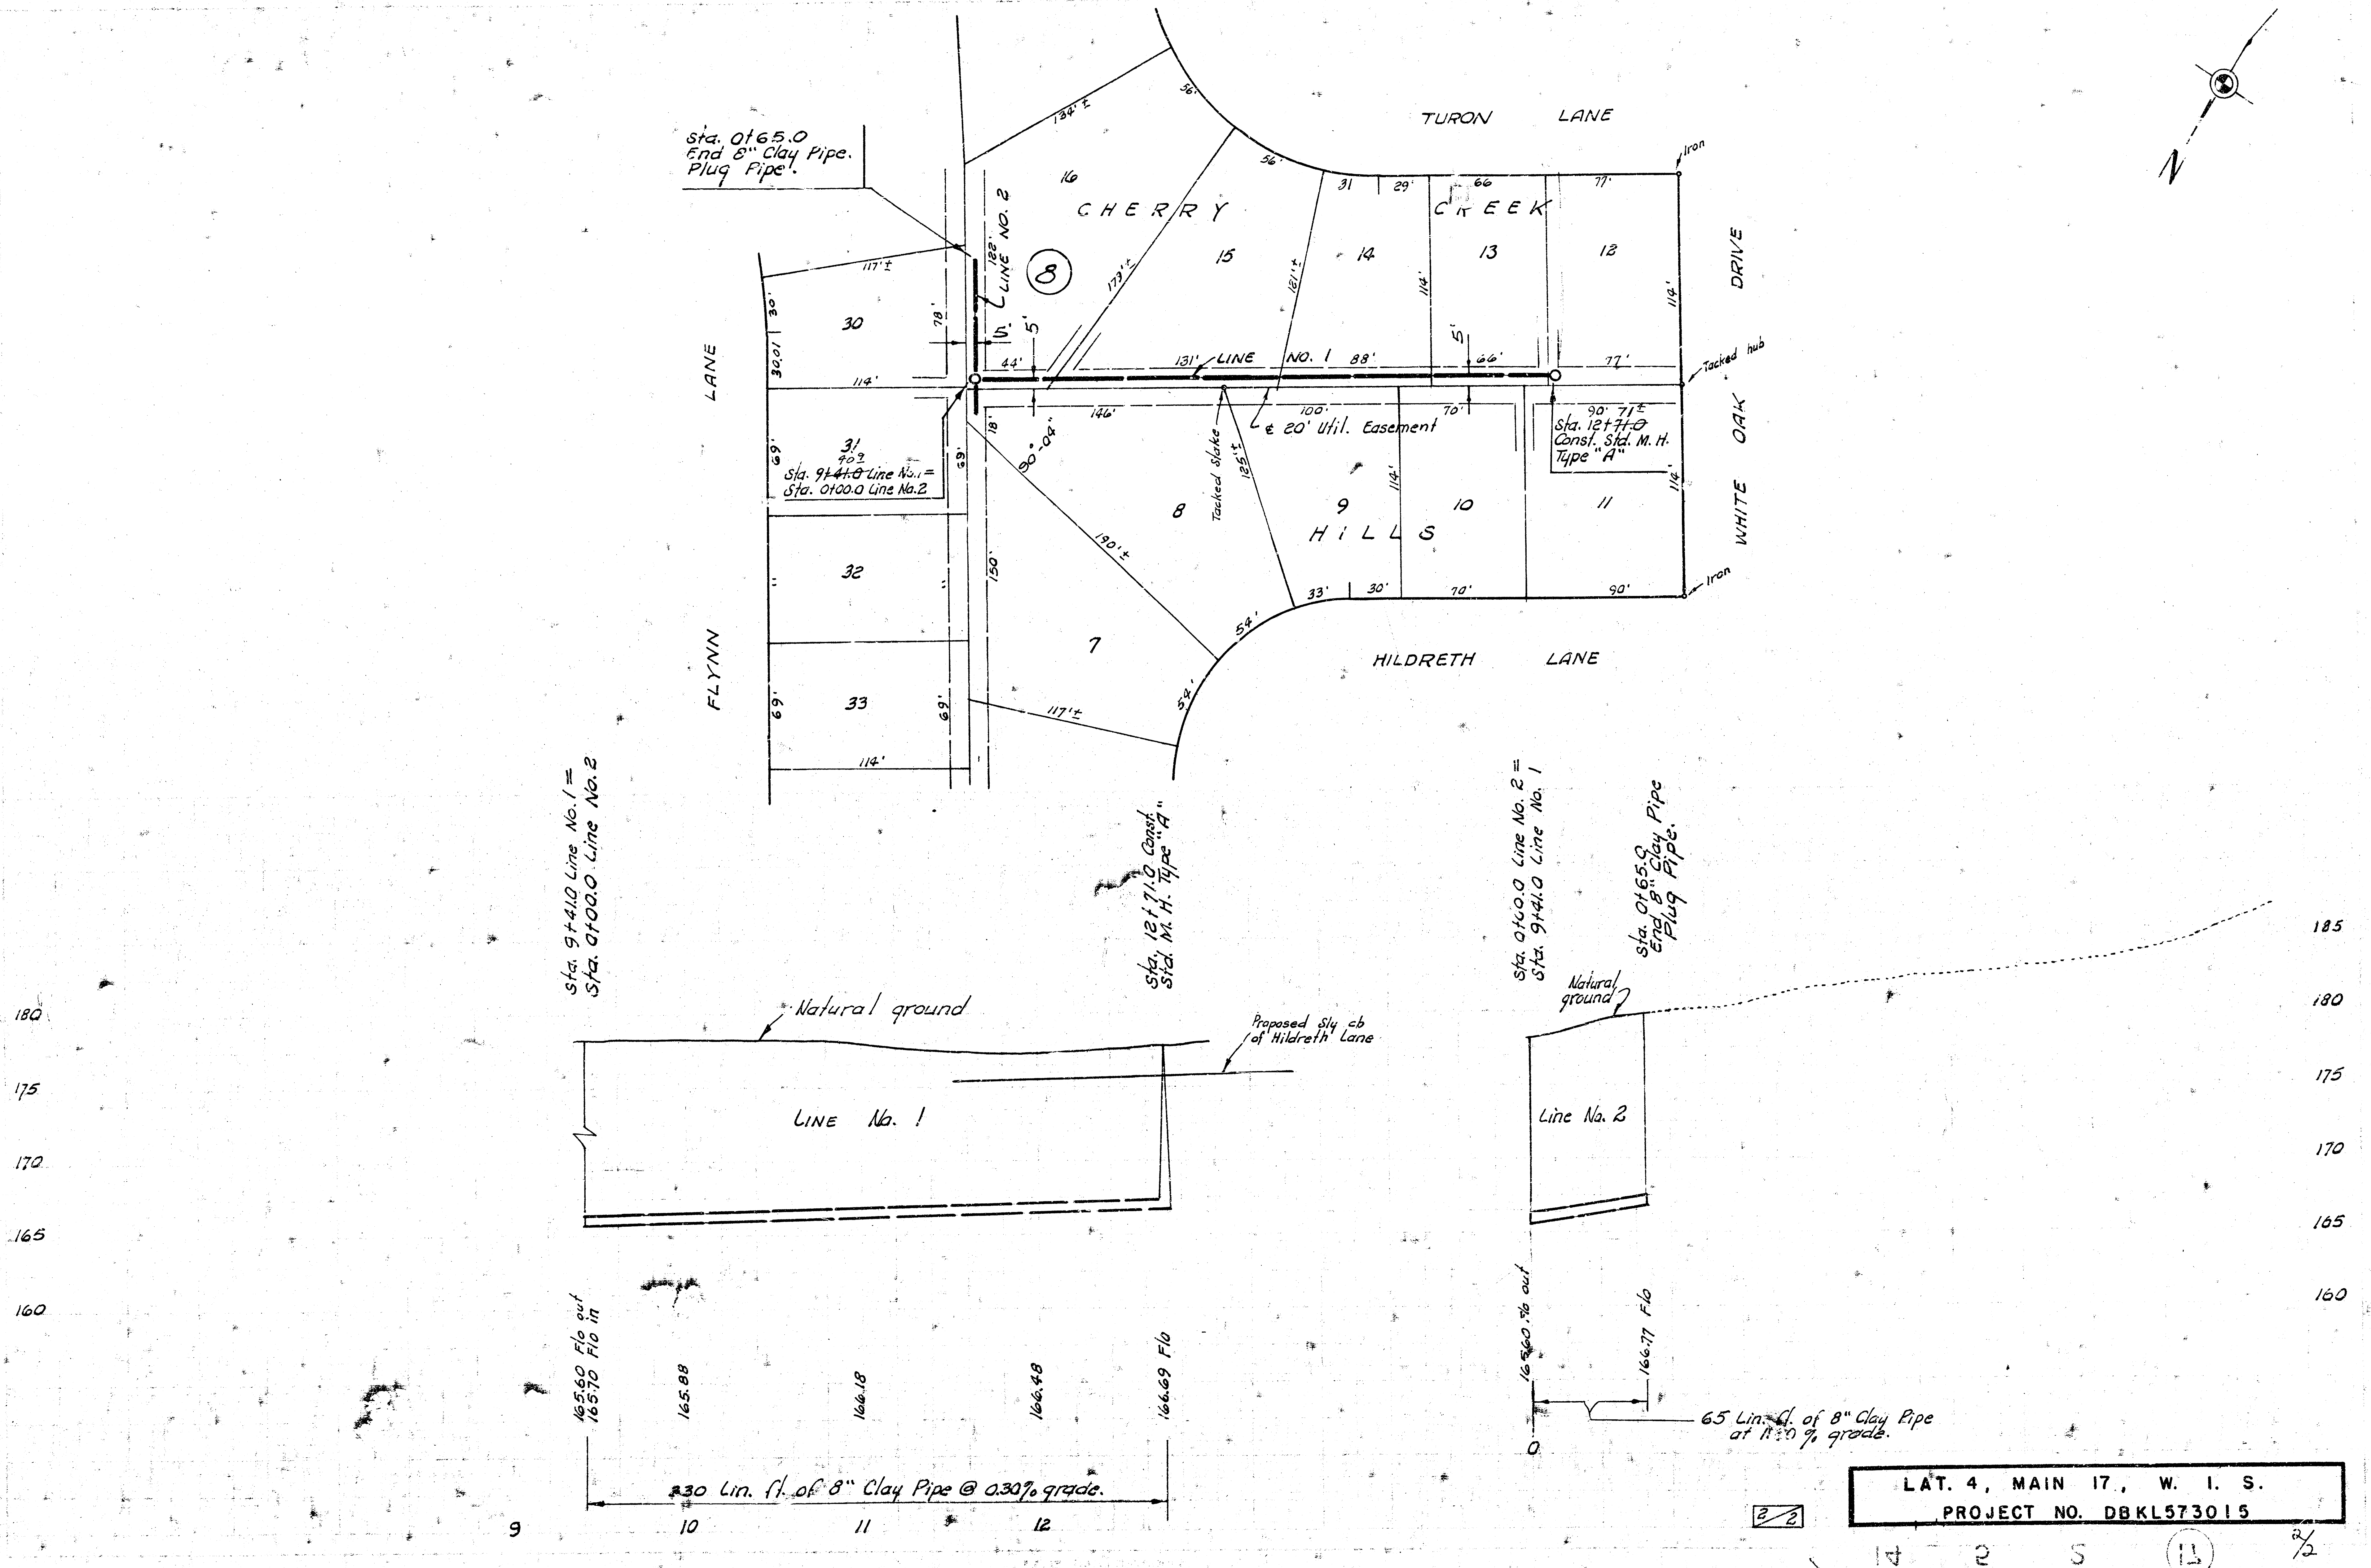

LAT. 4, MAIN 17, W. I. S.
PROJECT NO. DBKL573015

2/2

11

2/2