

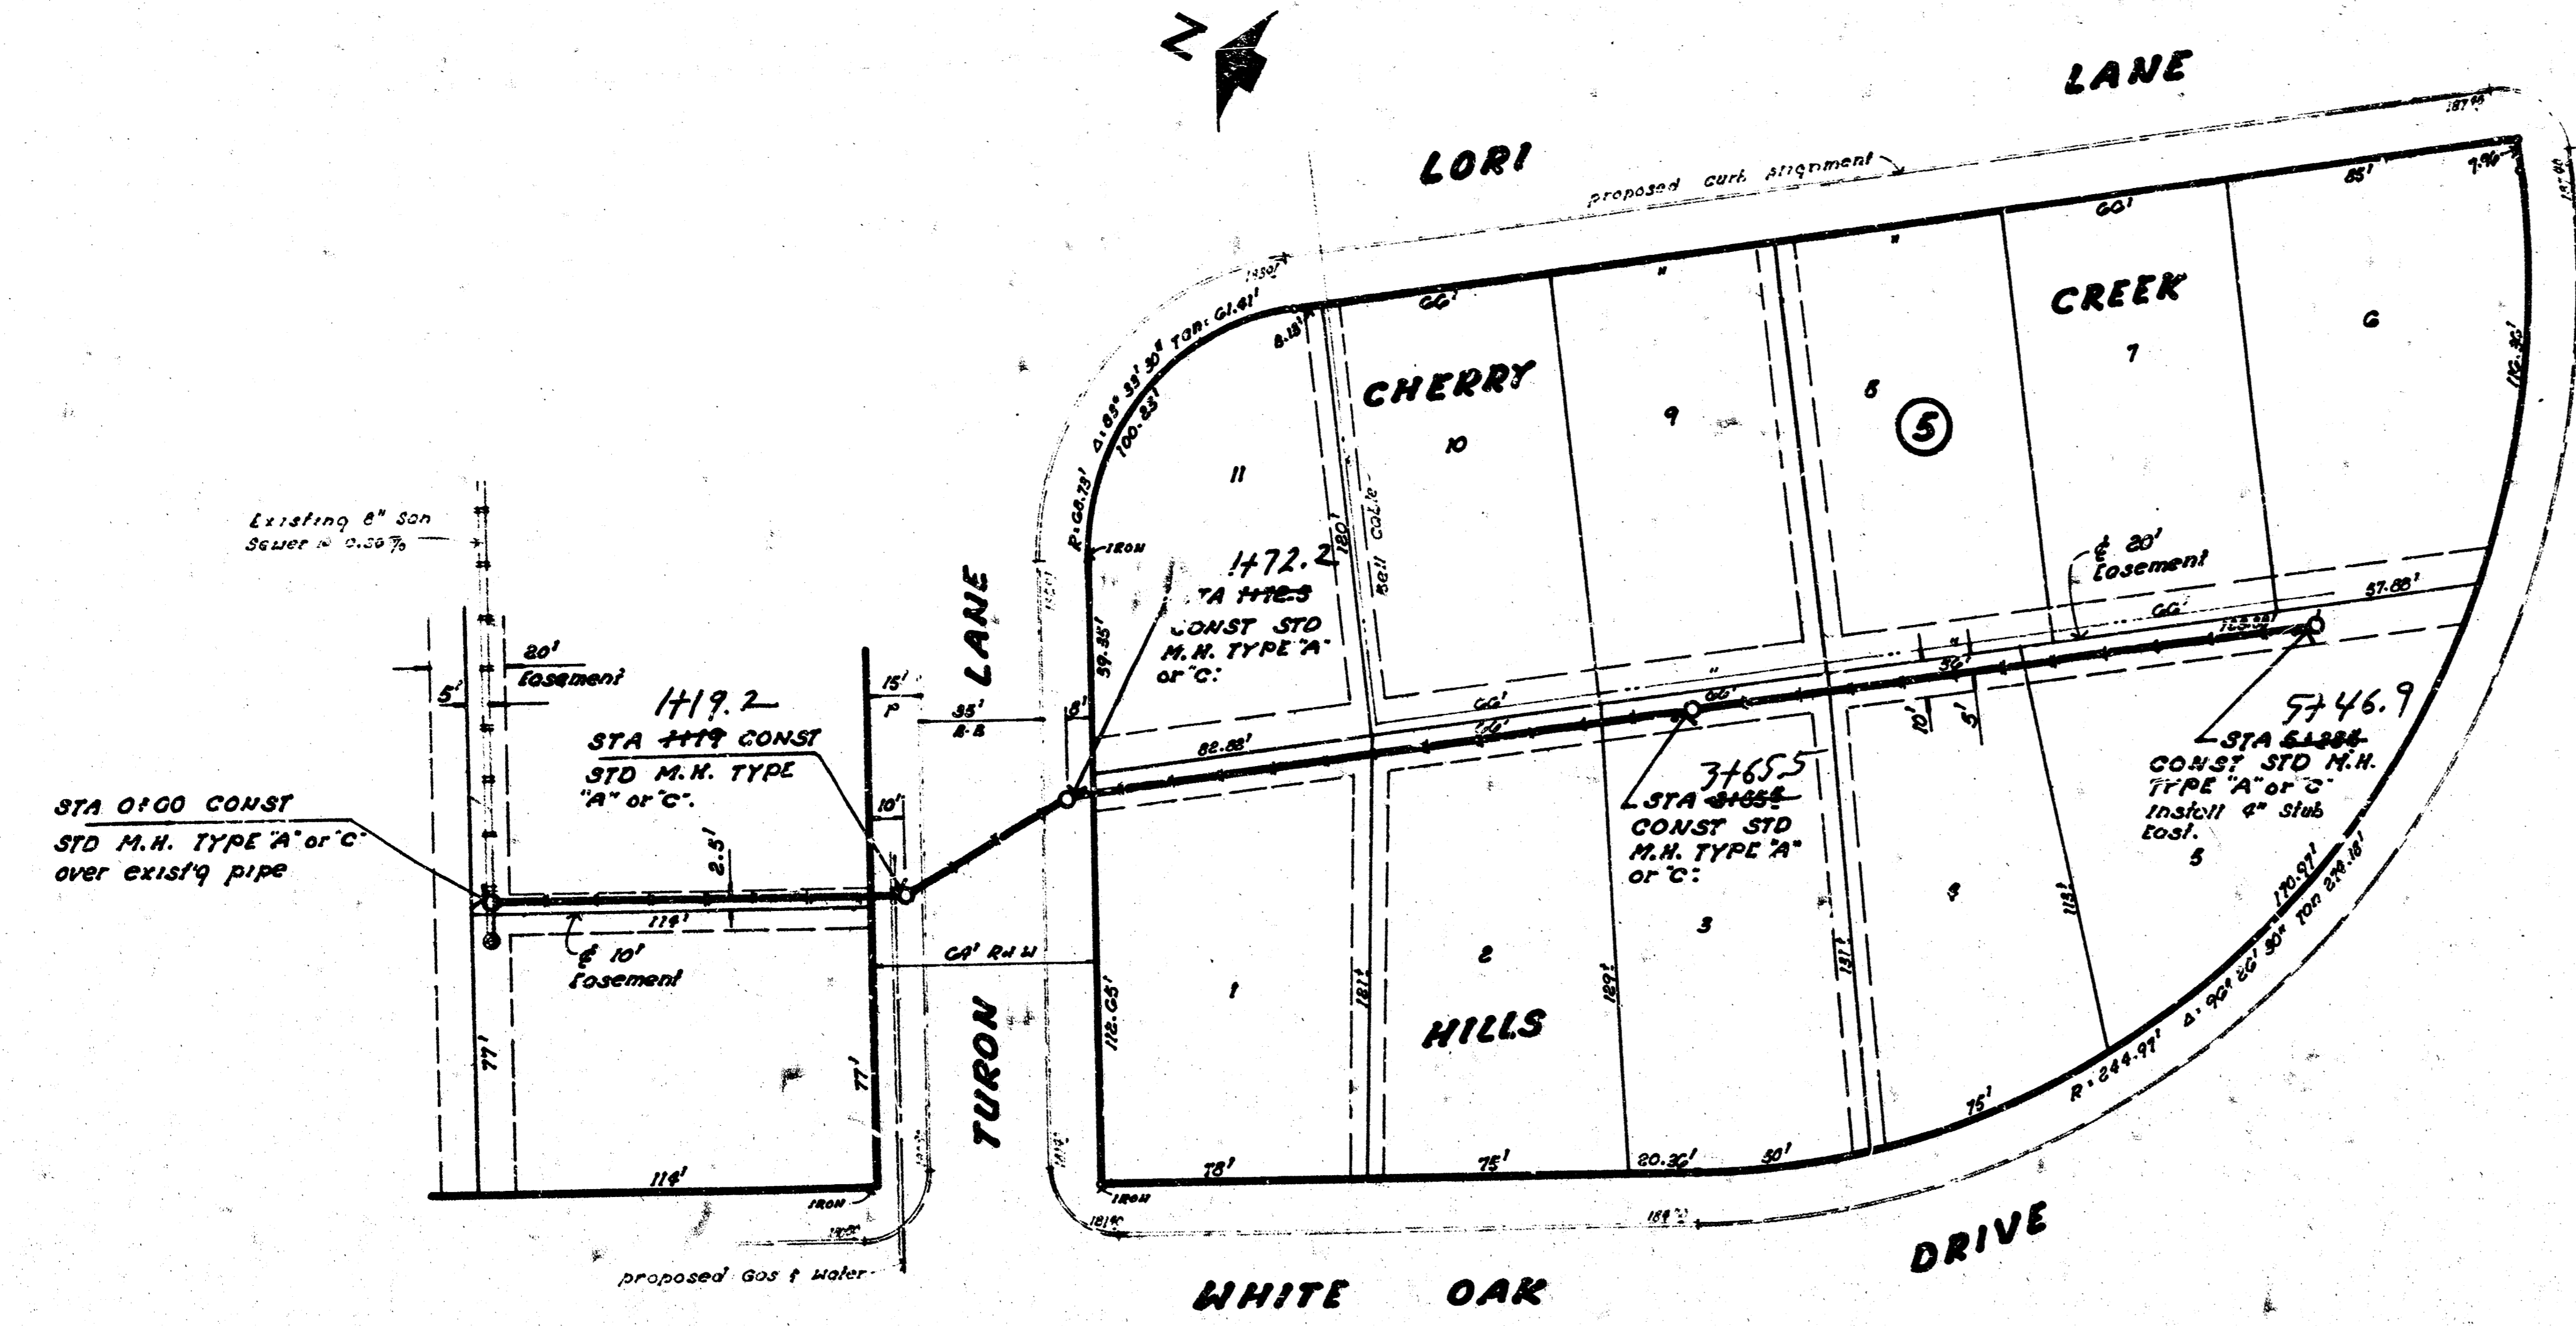


S.M. 1985 R.R. Spike E. Side 7. pole 30' N. of intersection of
 OAK KNOLL & Brog Co. Driveway.

CAUTION
 UNDERGROUND
 UTILITIES
 Please check with K.G. & E. or
 So. Division of
 Telephone Co. for location

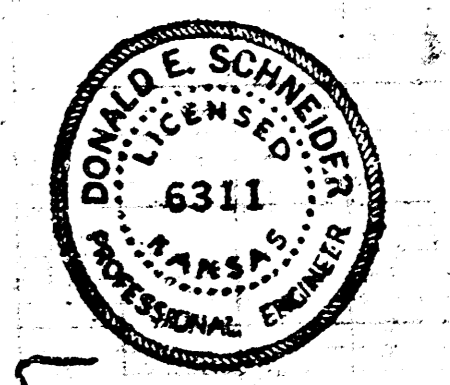

plan scale 1"=40'
 profile 1"=40' Horiz
 1"=5' Vert

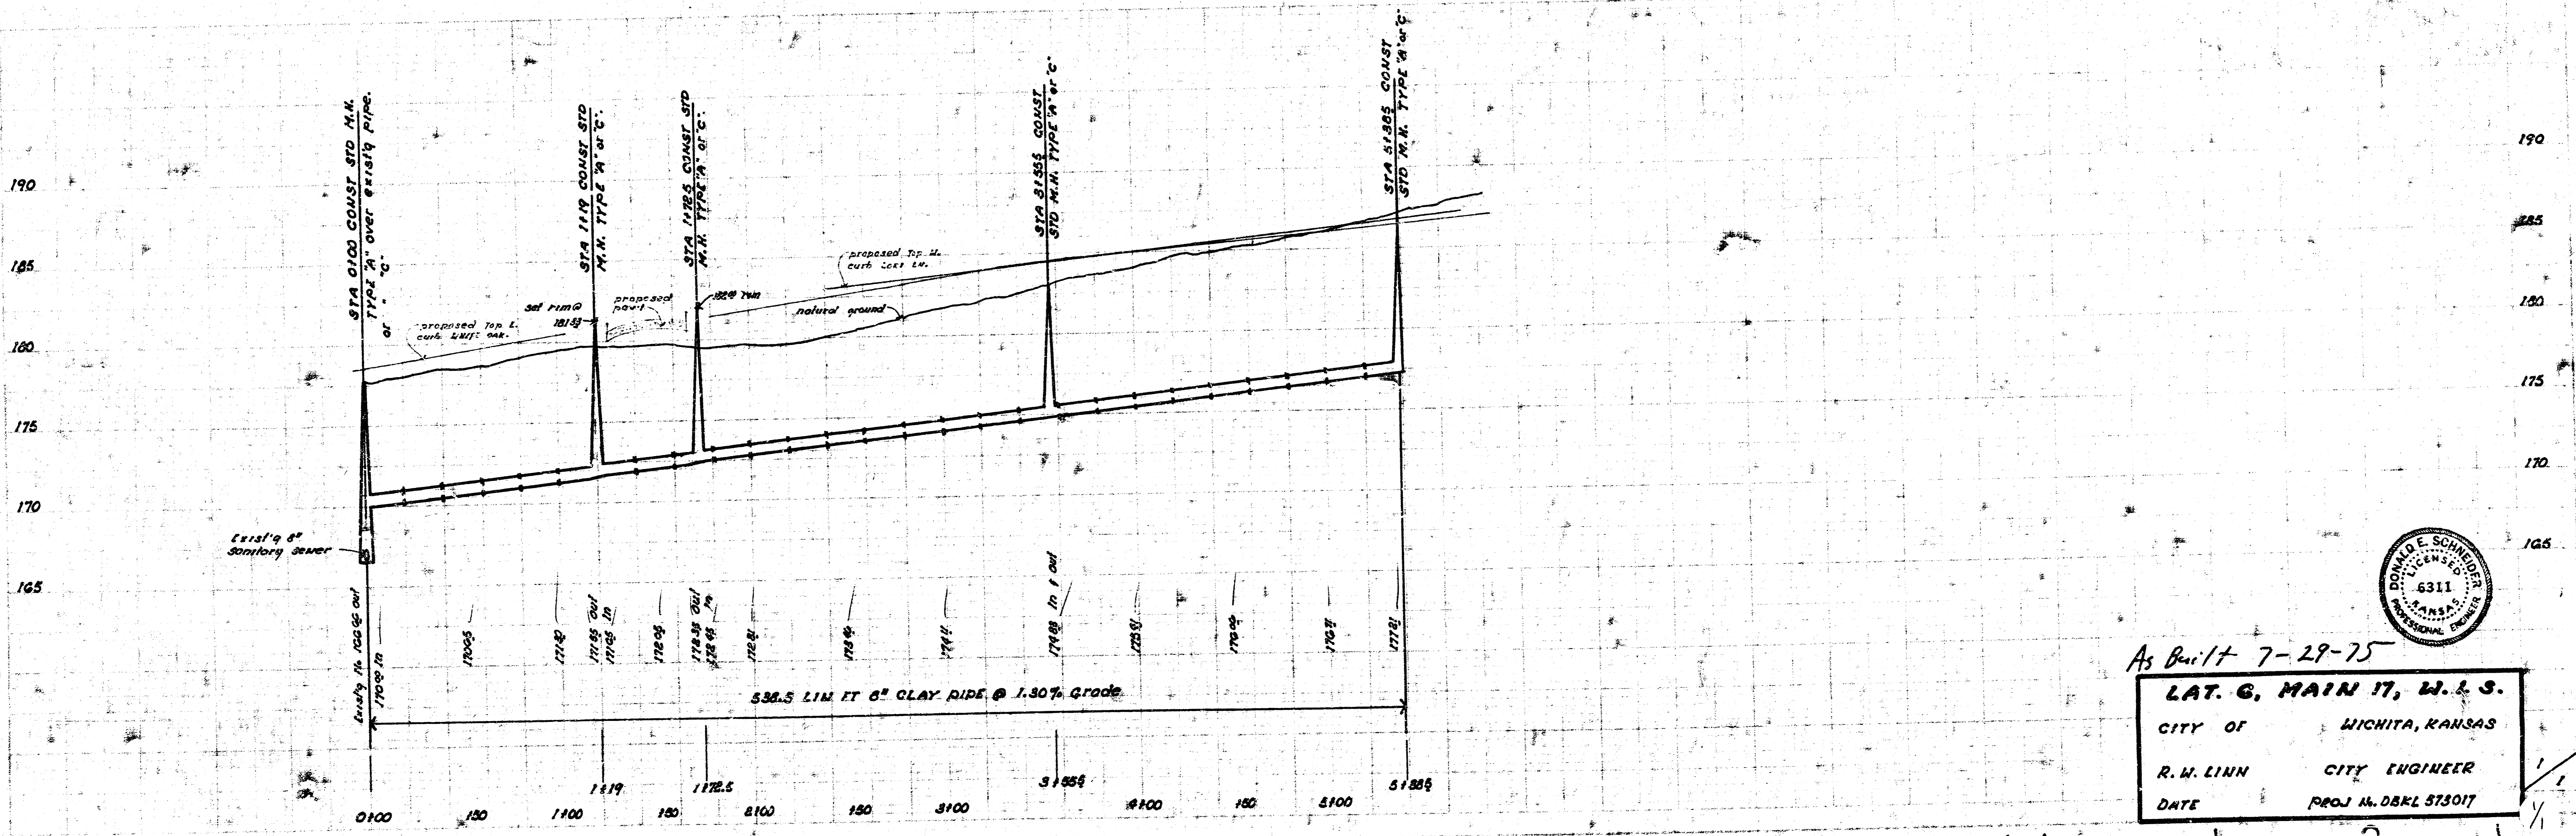

As Built 7-29-75
LAT. G, MAIN 17, W.L.S.
 CITY OF WICHITA, KANSAS
 R. W. LINN CITY ENGINEER
 DATE PROJ. NO. DBKL 573017

14 3 1