

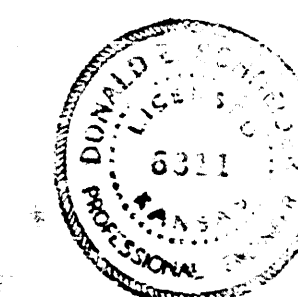


LAT. 10, MAIN 17, WAR INDUSTRIES SEWER  
 CITY OF WICHITA, KANSAS  
 R. W. LINN - CITY ENGINEER  
 SEPT. 1973, PROJECT NO. DBK M 573 043

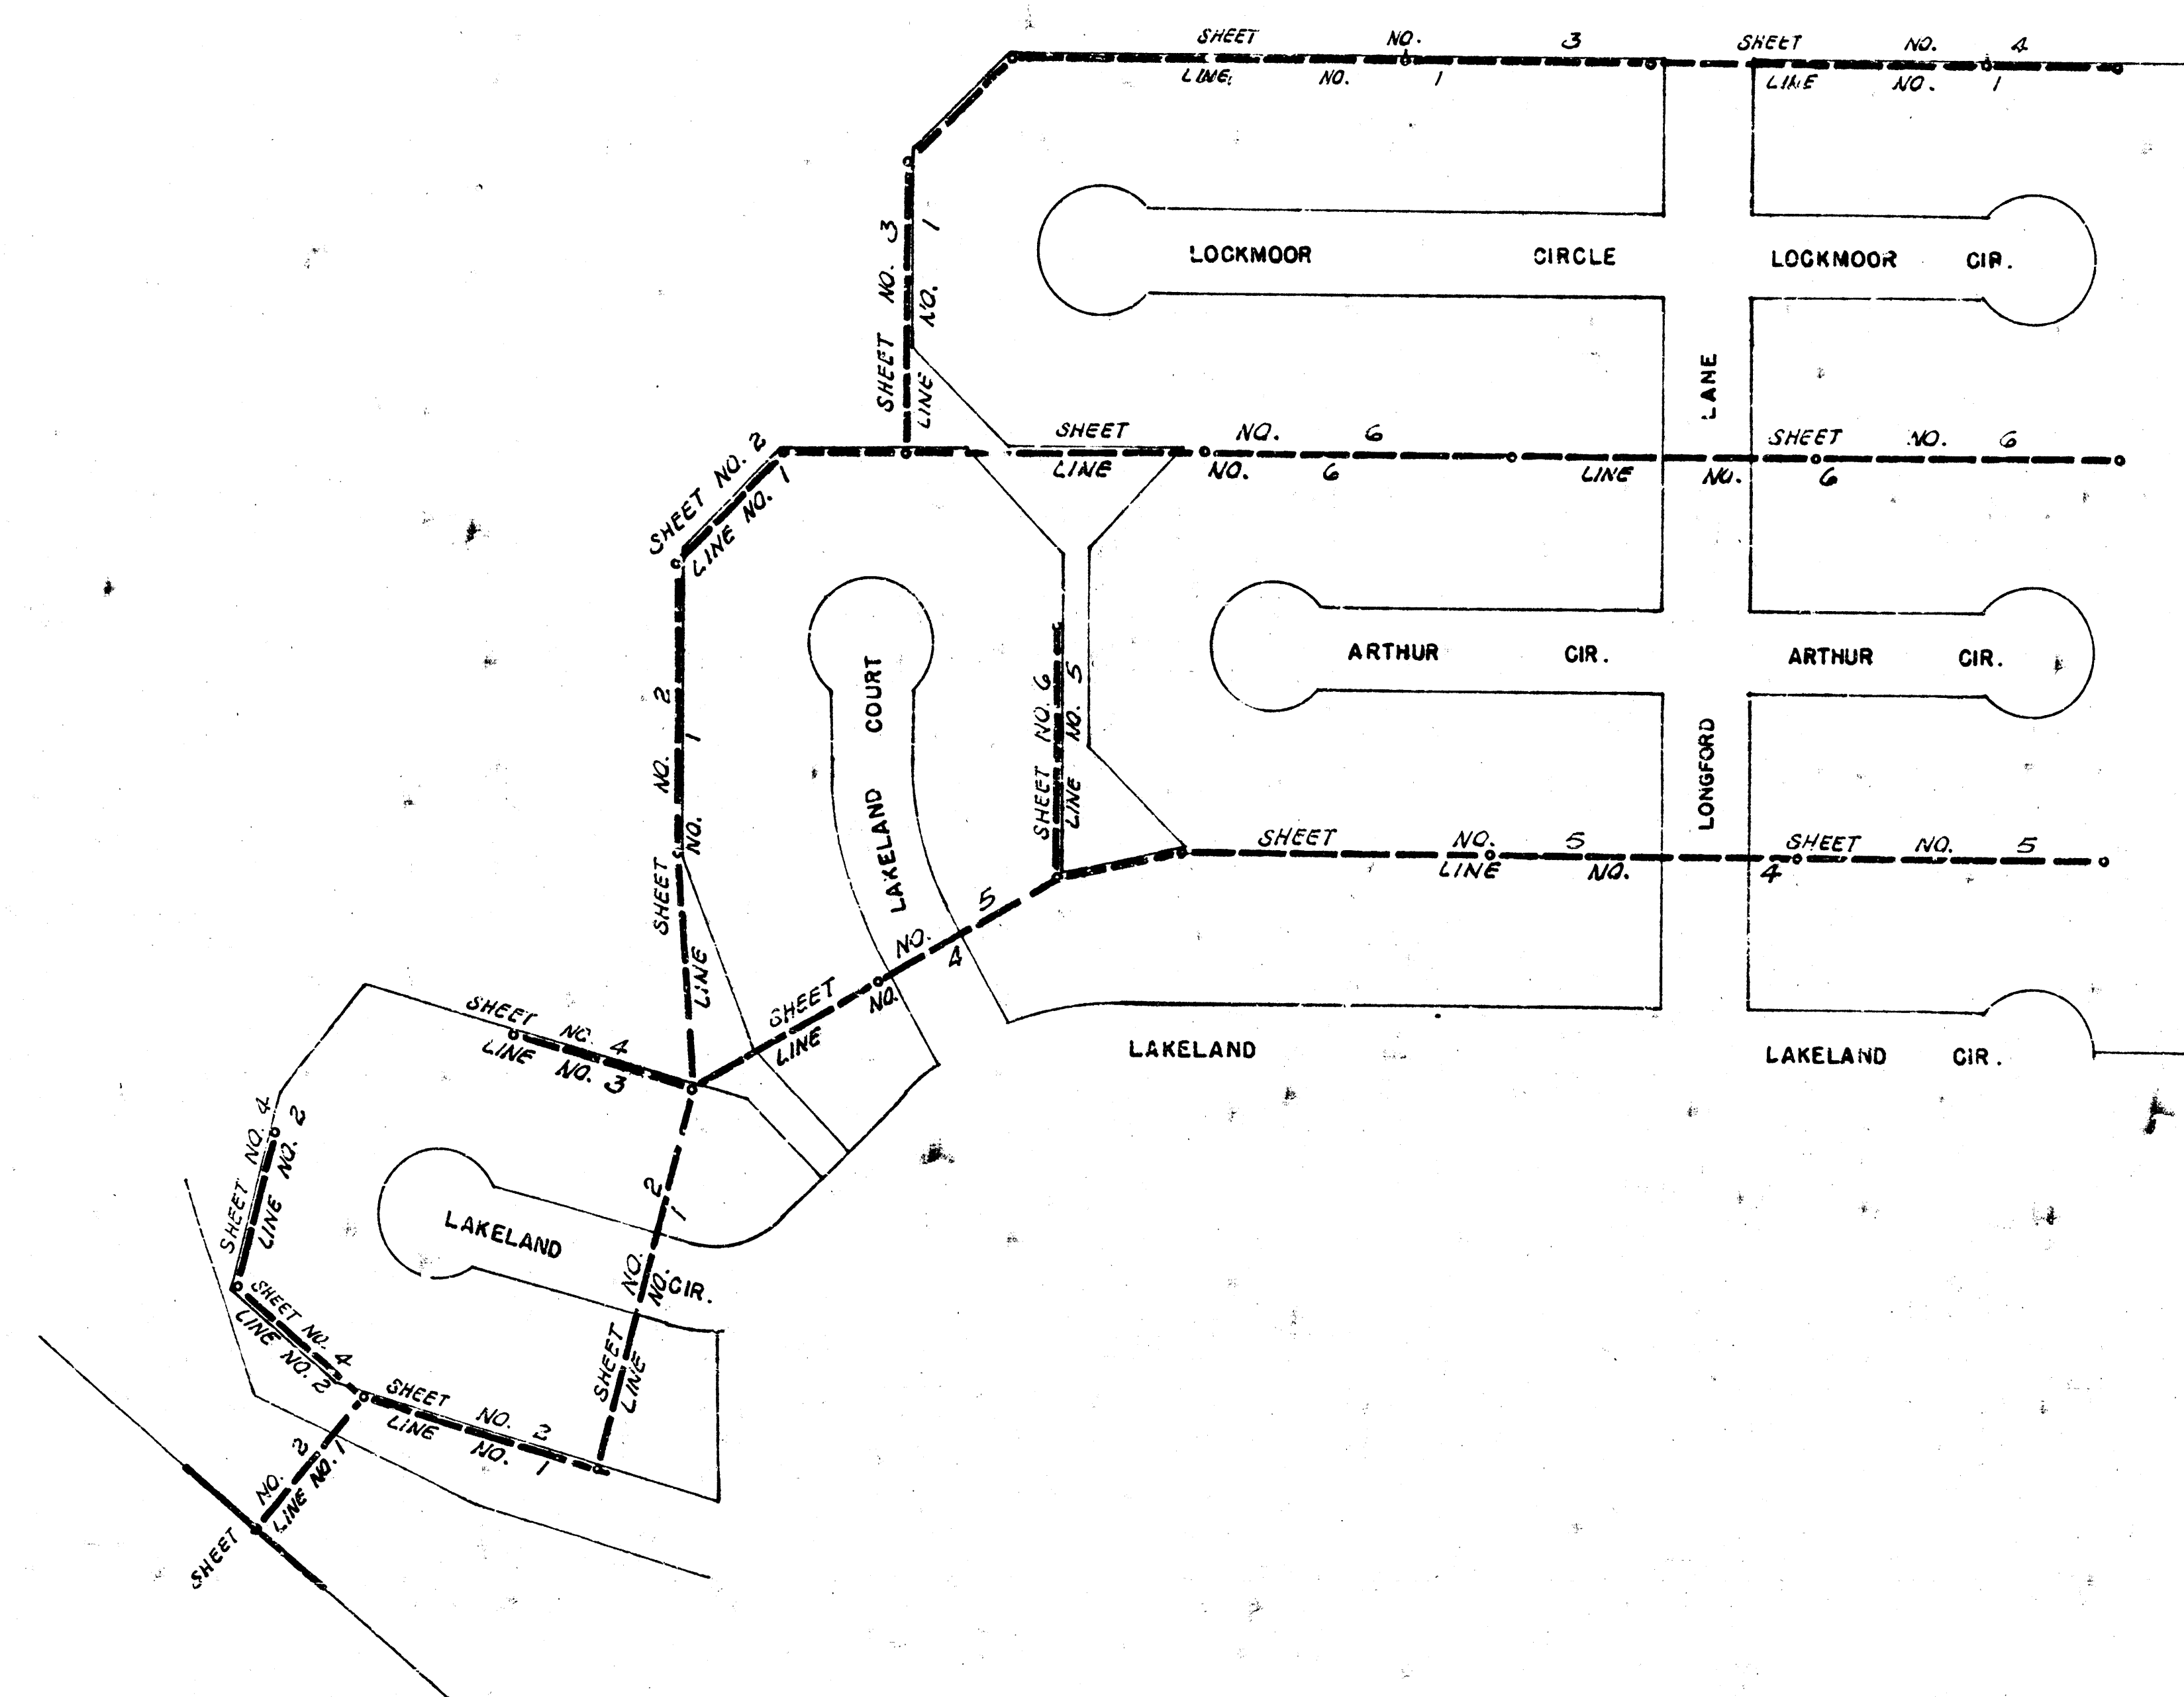

"As Built" final Meas. 279-Y

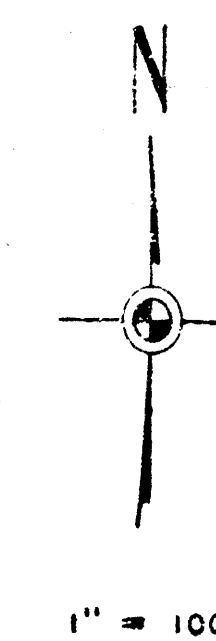


LAT. 10, MAIN 17, WAR INDUSTRIES SEWER  
 PROJECT NO. DBK L 573 043

A.R. R. W.




84

Plan scale 1" = 100'  
Profile scale 1" = 40' horiz  
1" = 5' vert.

- *irons set*




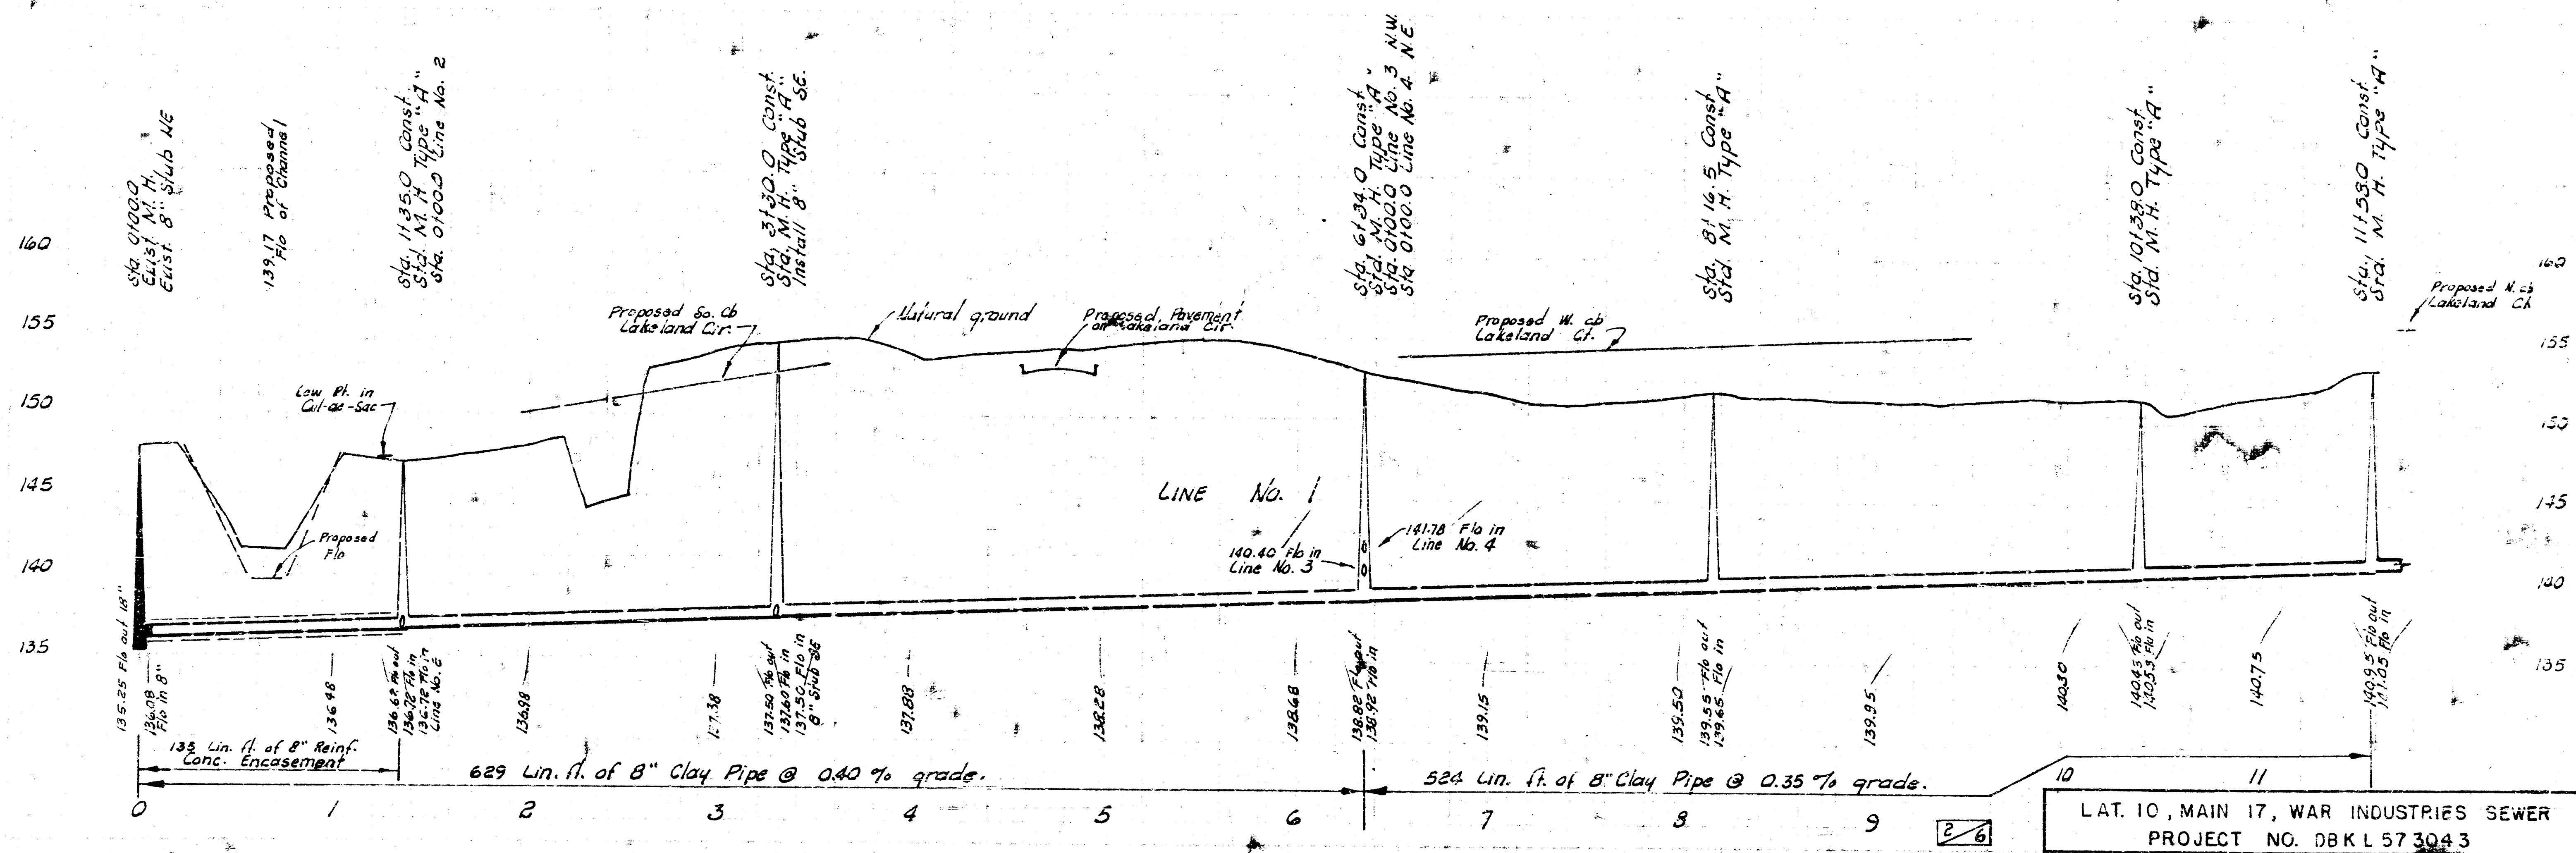


CEDAR LAKES VILLAGE  
FIRST ADDITION

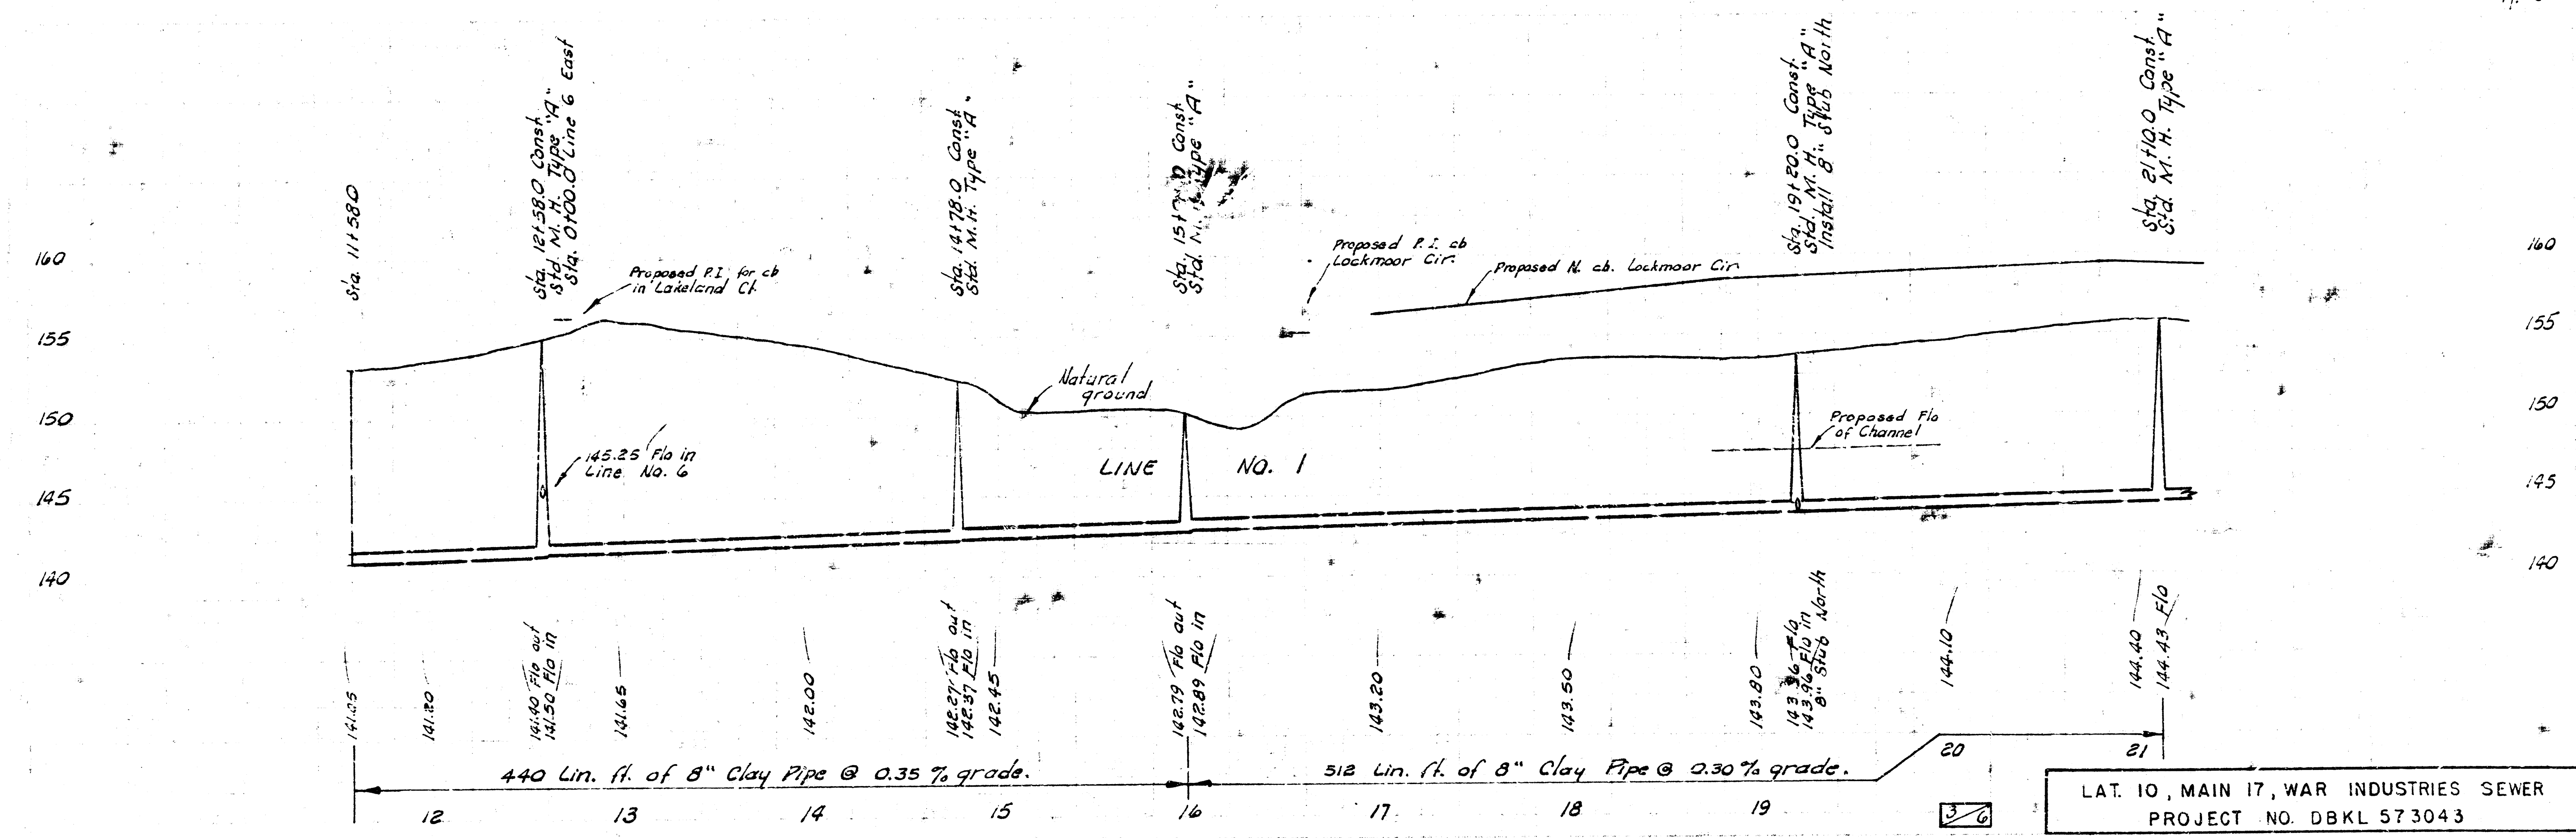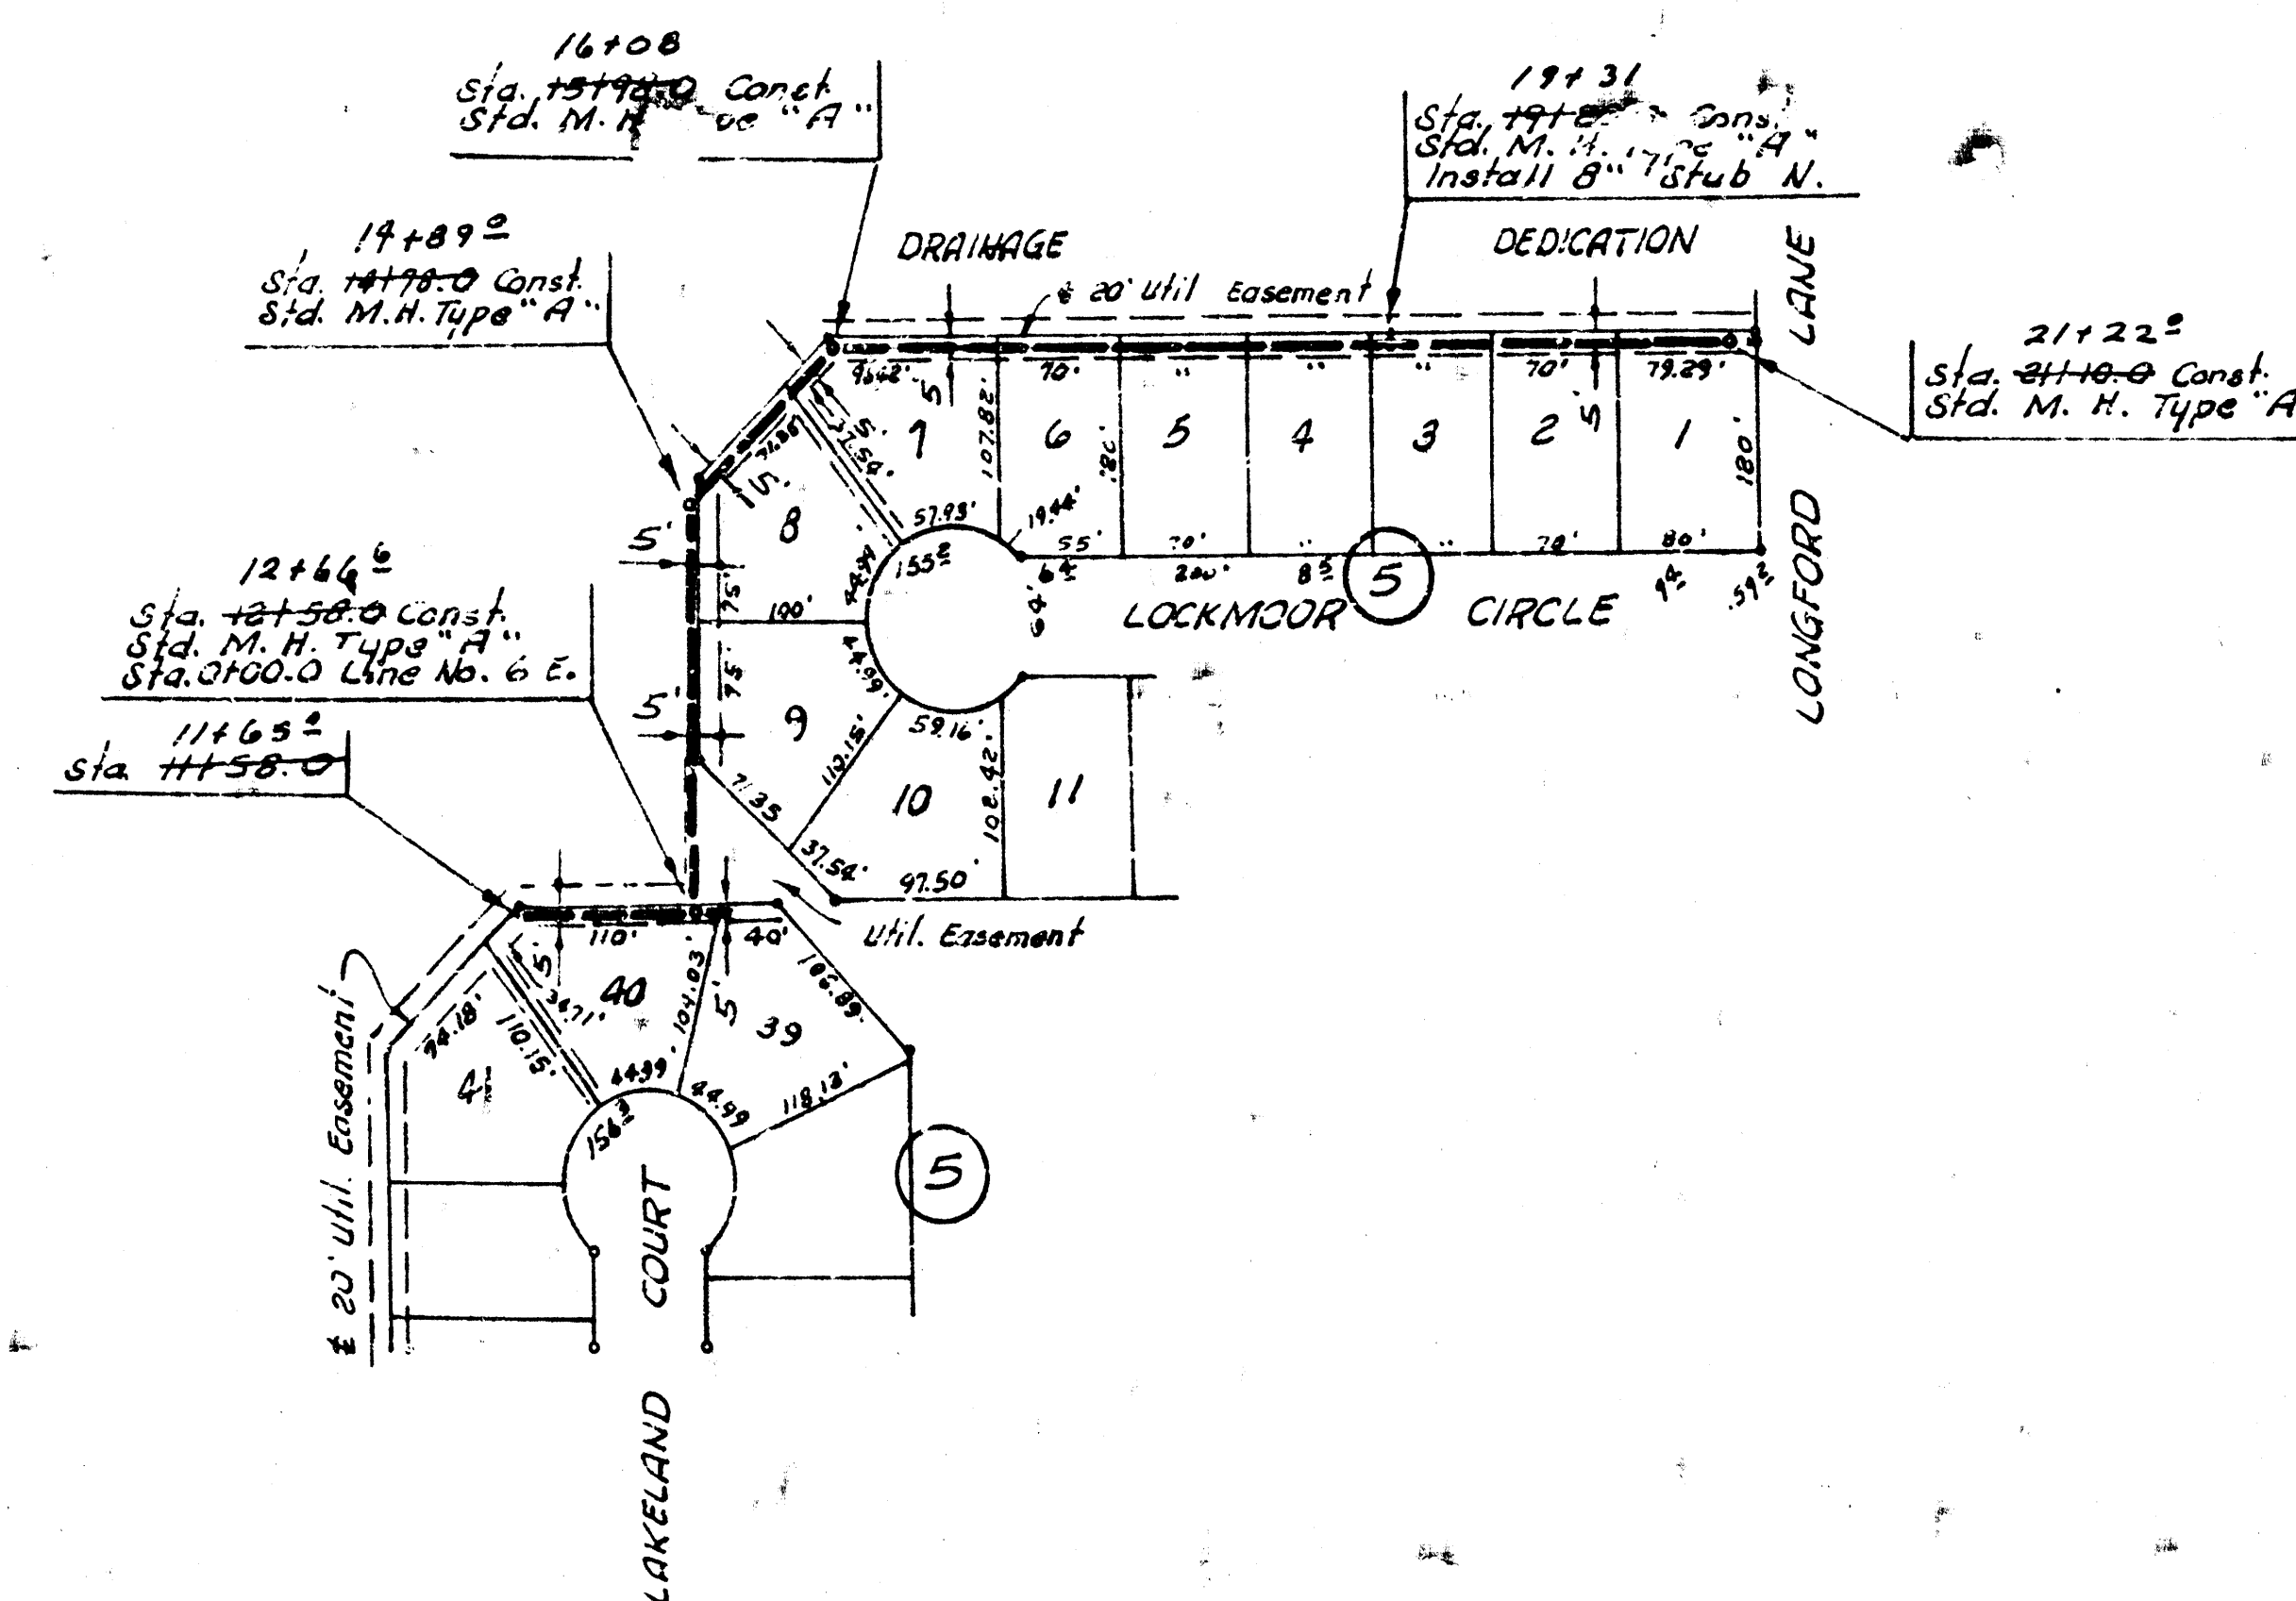
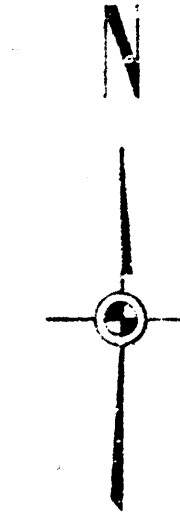


LAT. 10, MAIN 17, WAR INDUSTRIES SEWER  
PROJECT NO. DBKL 573043


CEDAR LAKE VILLAGE  
FIRST ADDITION

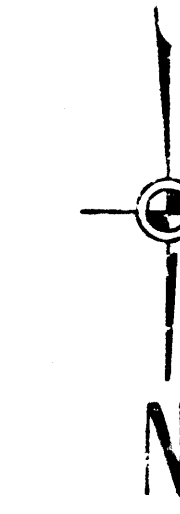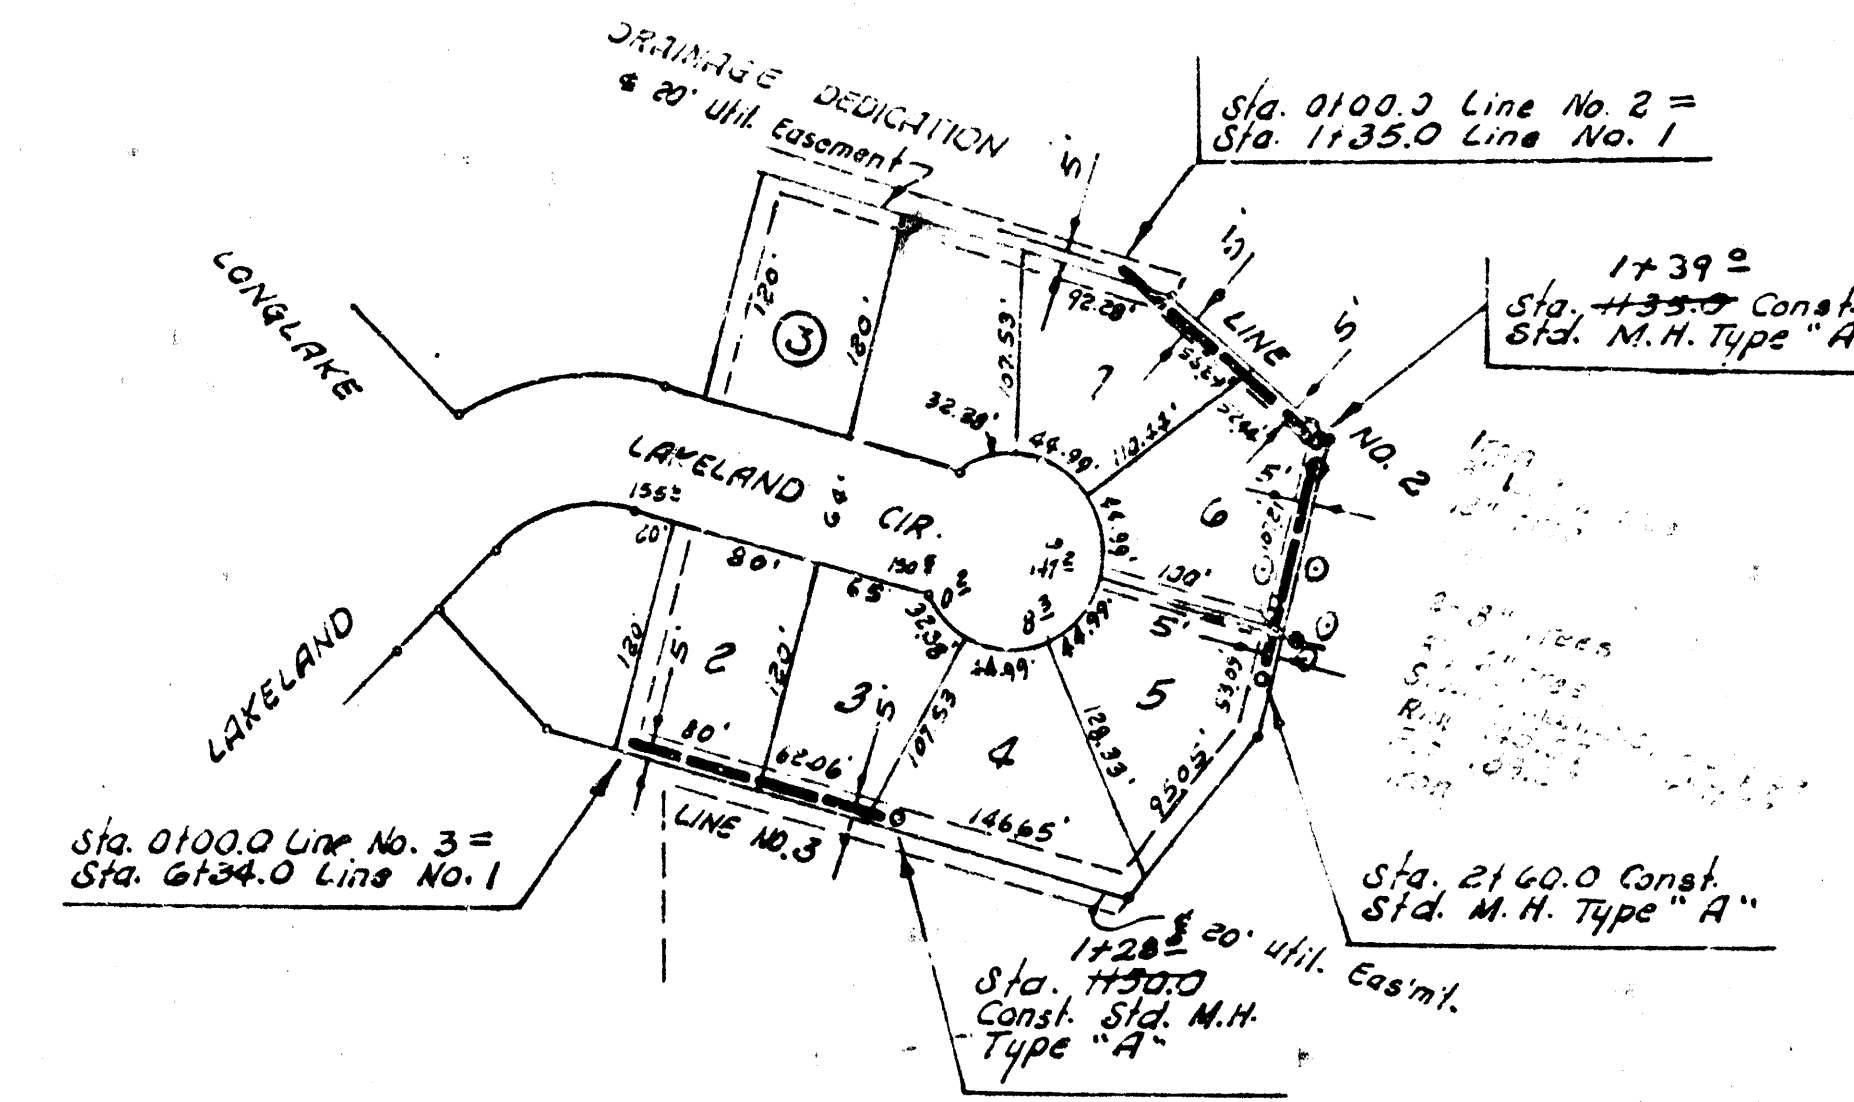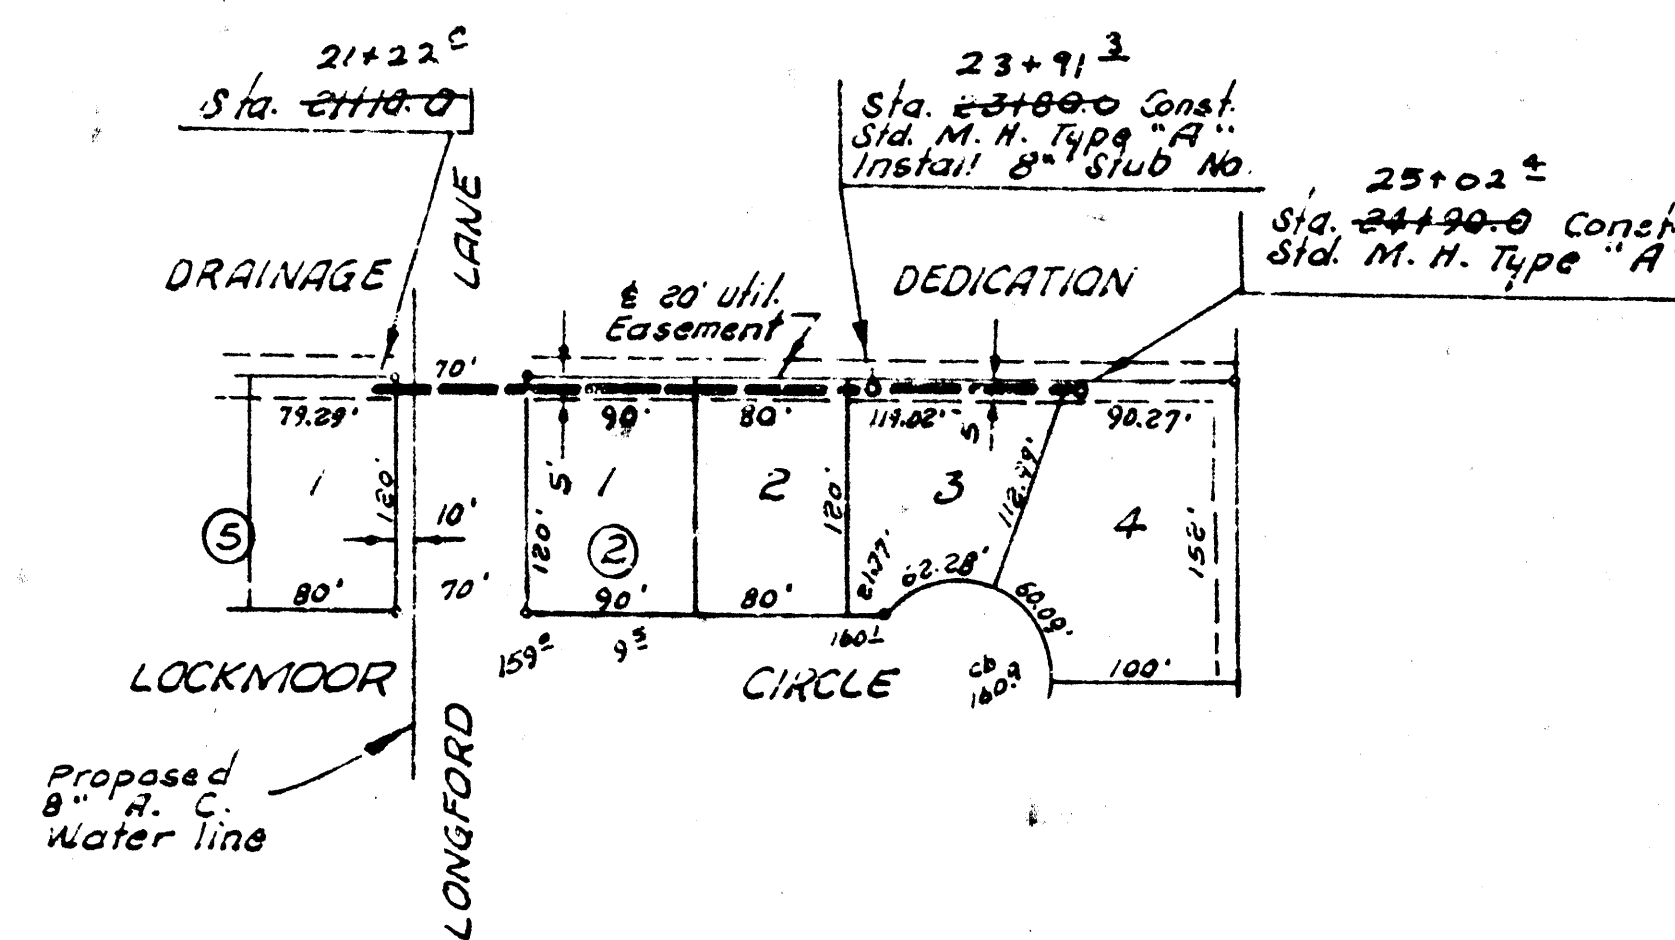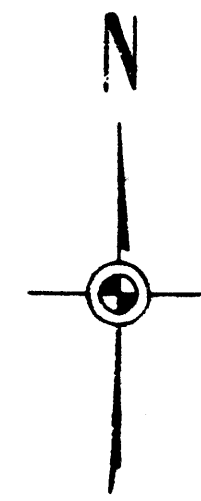

Pg. 11, 12

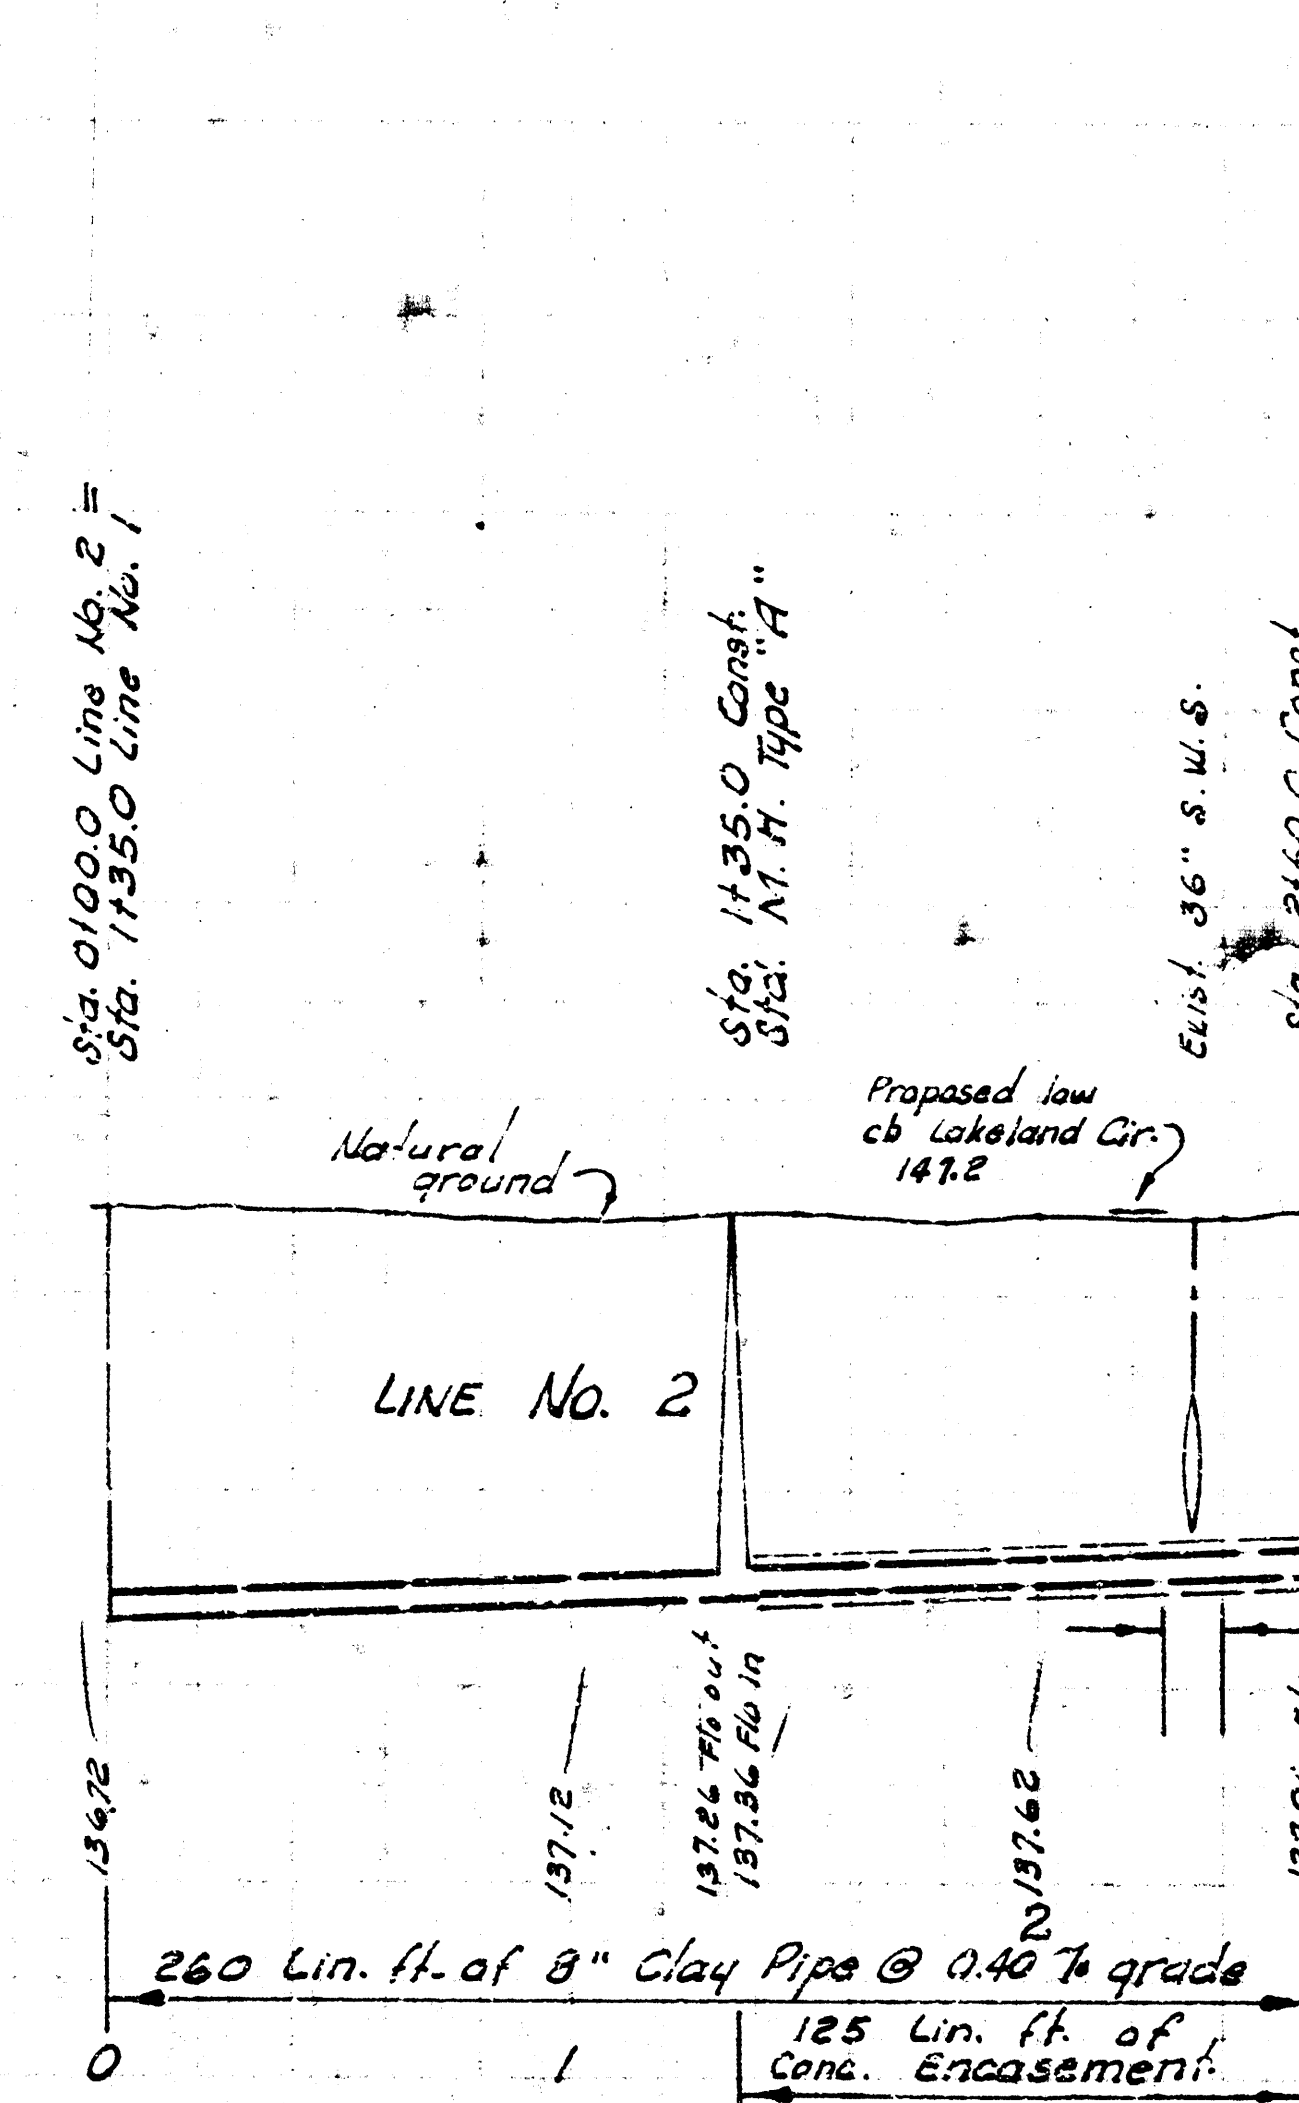
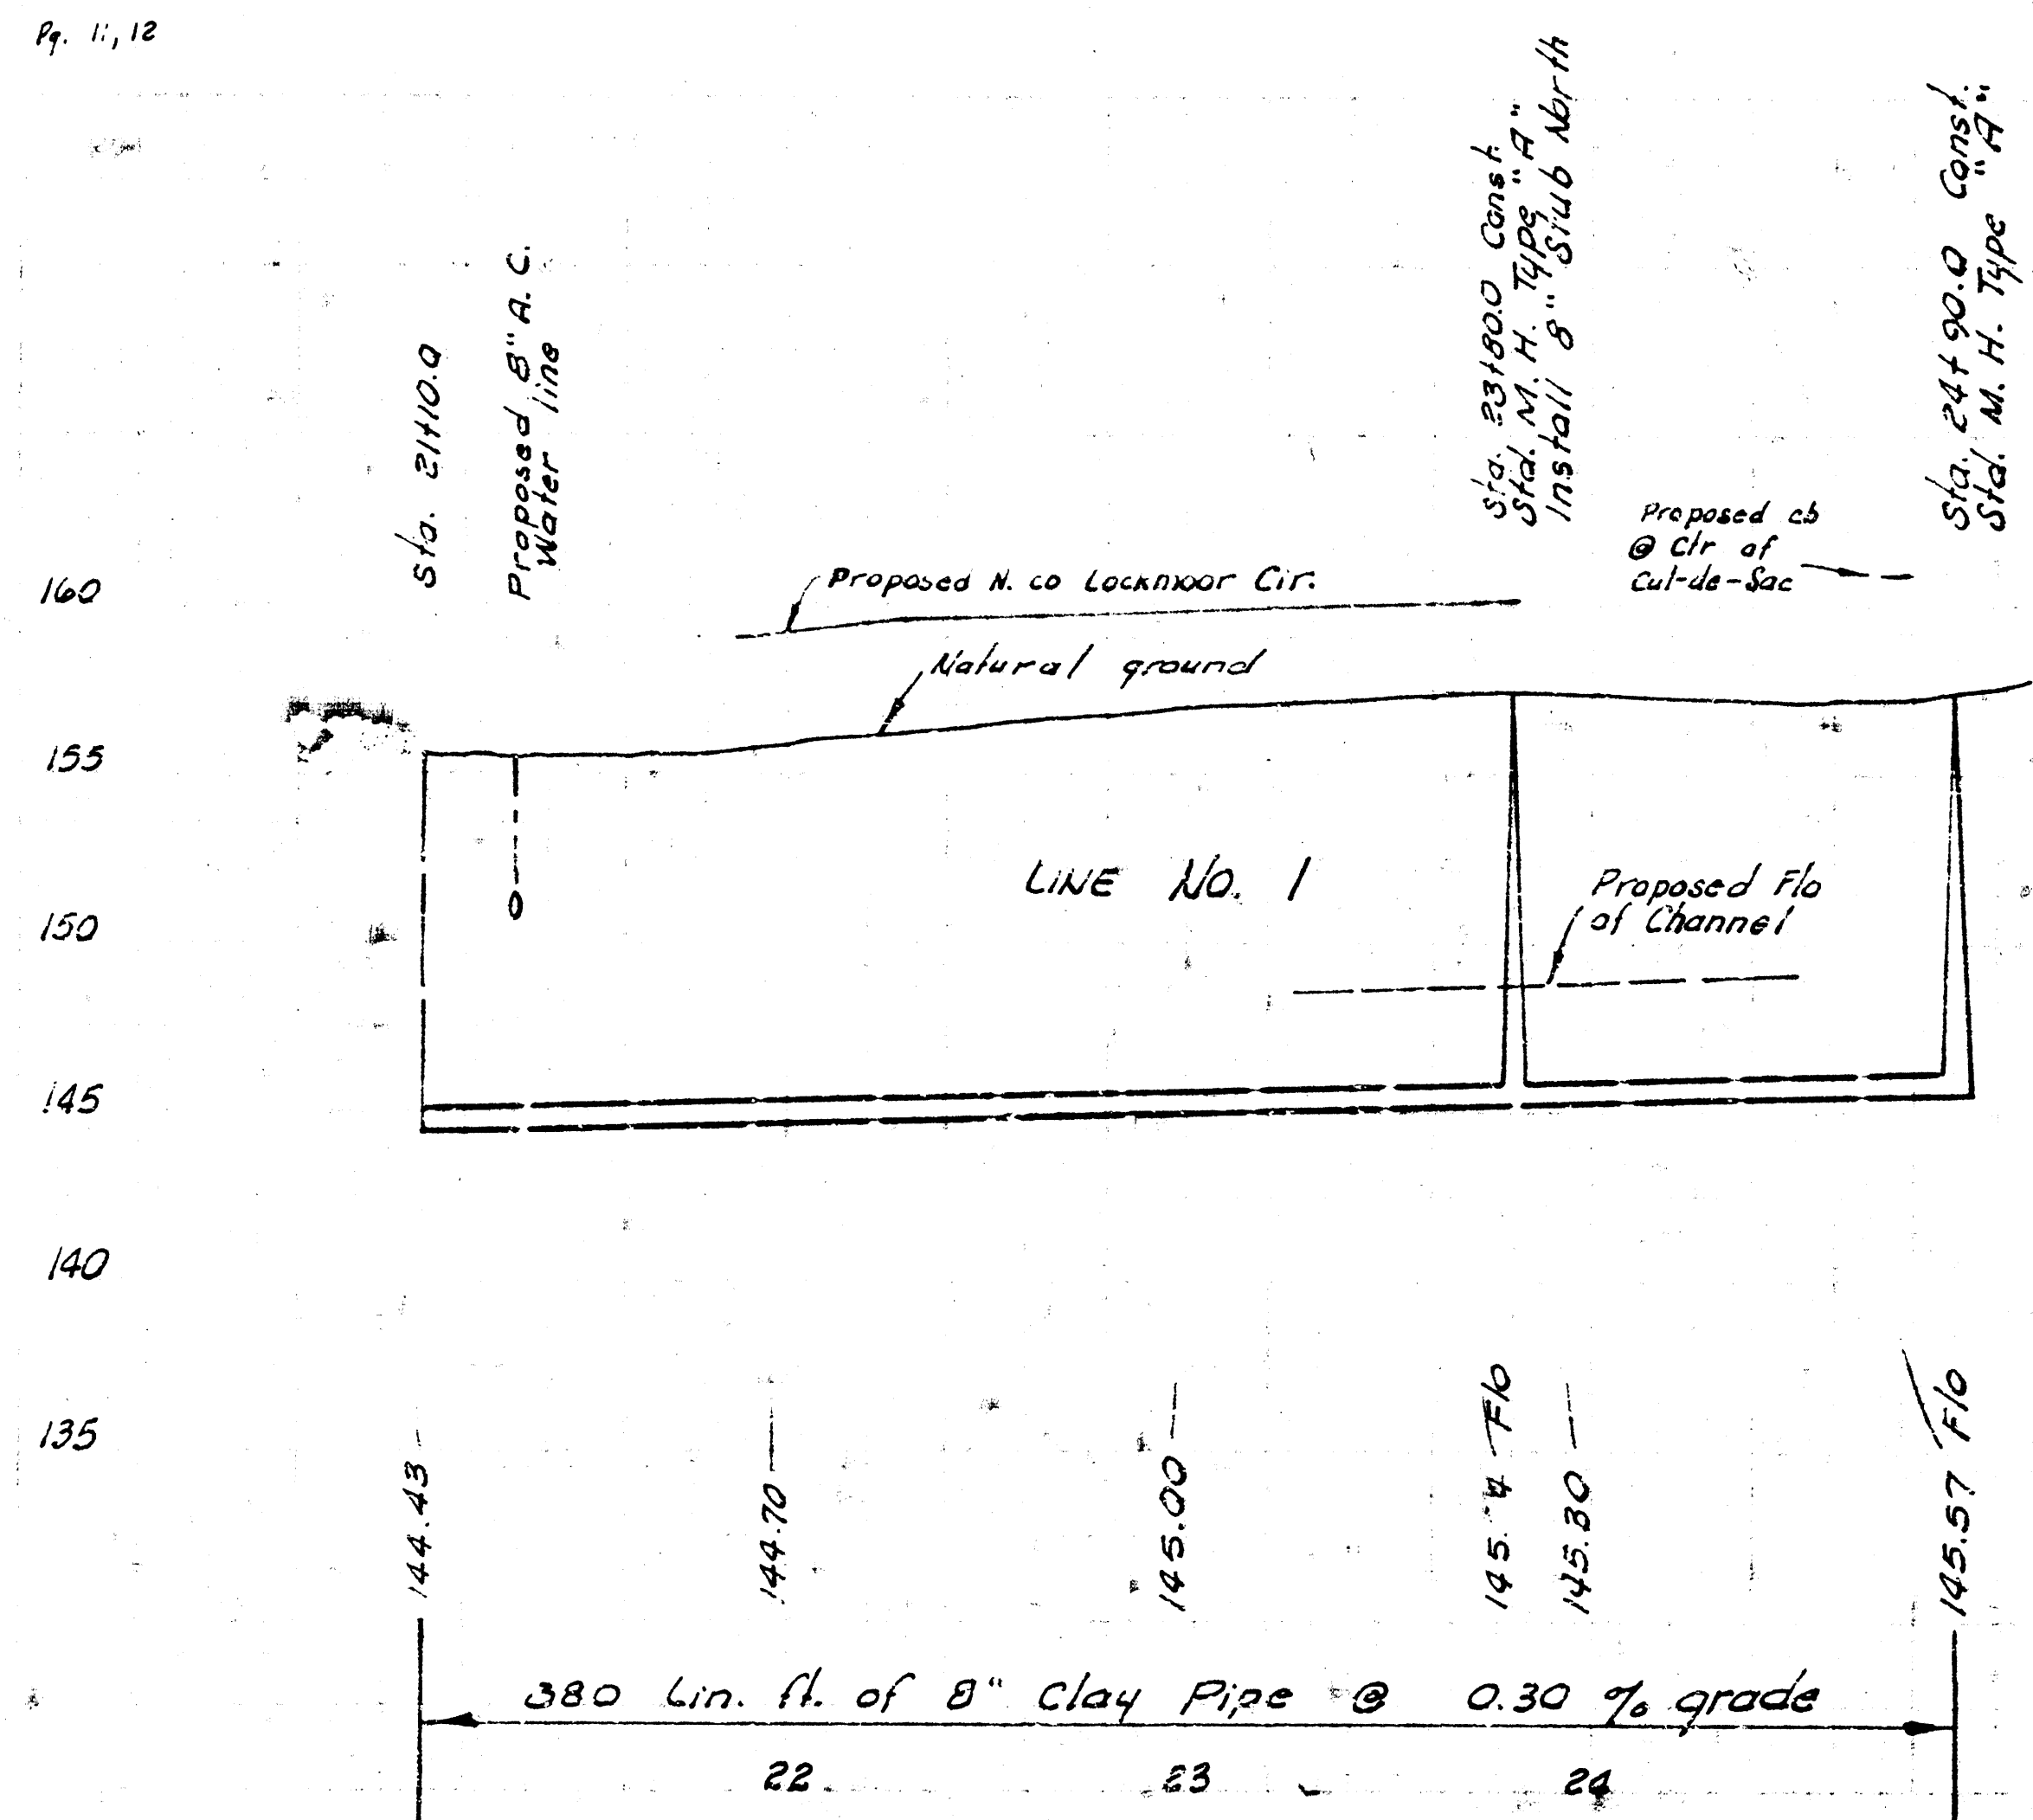


NOTE:  
Contractor is to  
tunnel under  
Exist. 36" Storm  
water sewer.



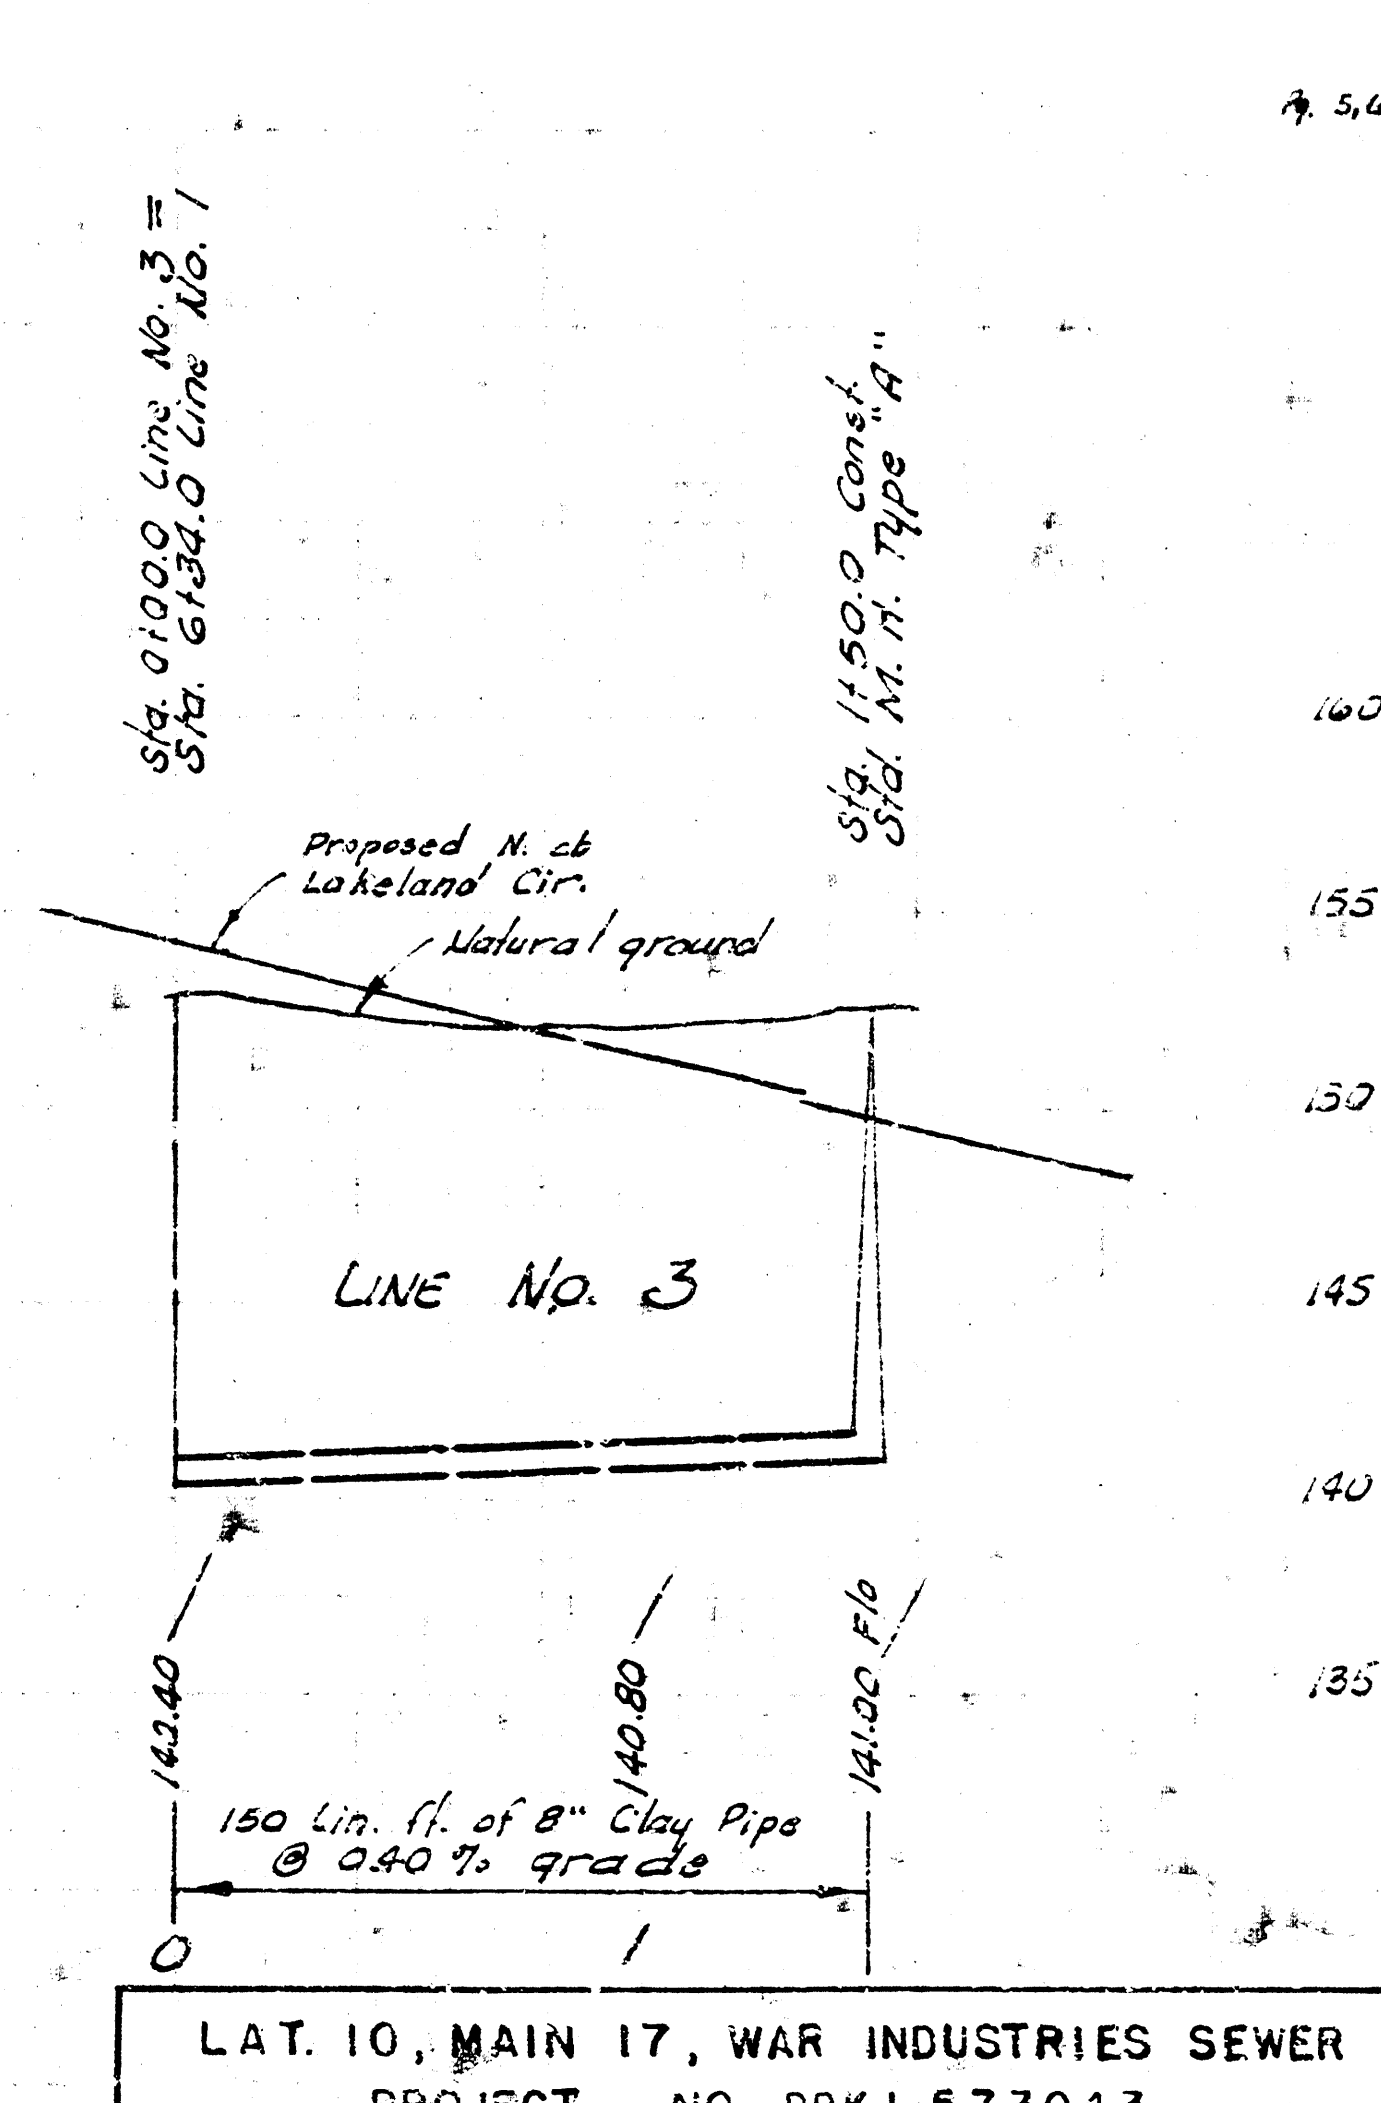


LAT. 10, MAIN 17, WAR INDUSTRIES SEWER  
PROJECT NO. DBKL573043

# CEDAR LAKES VILLAGE FIRST ADDITION

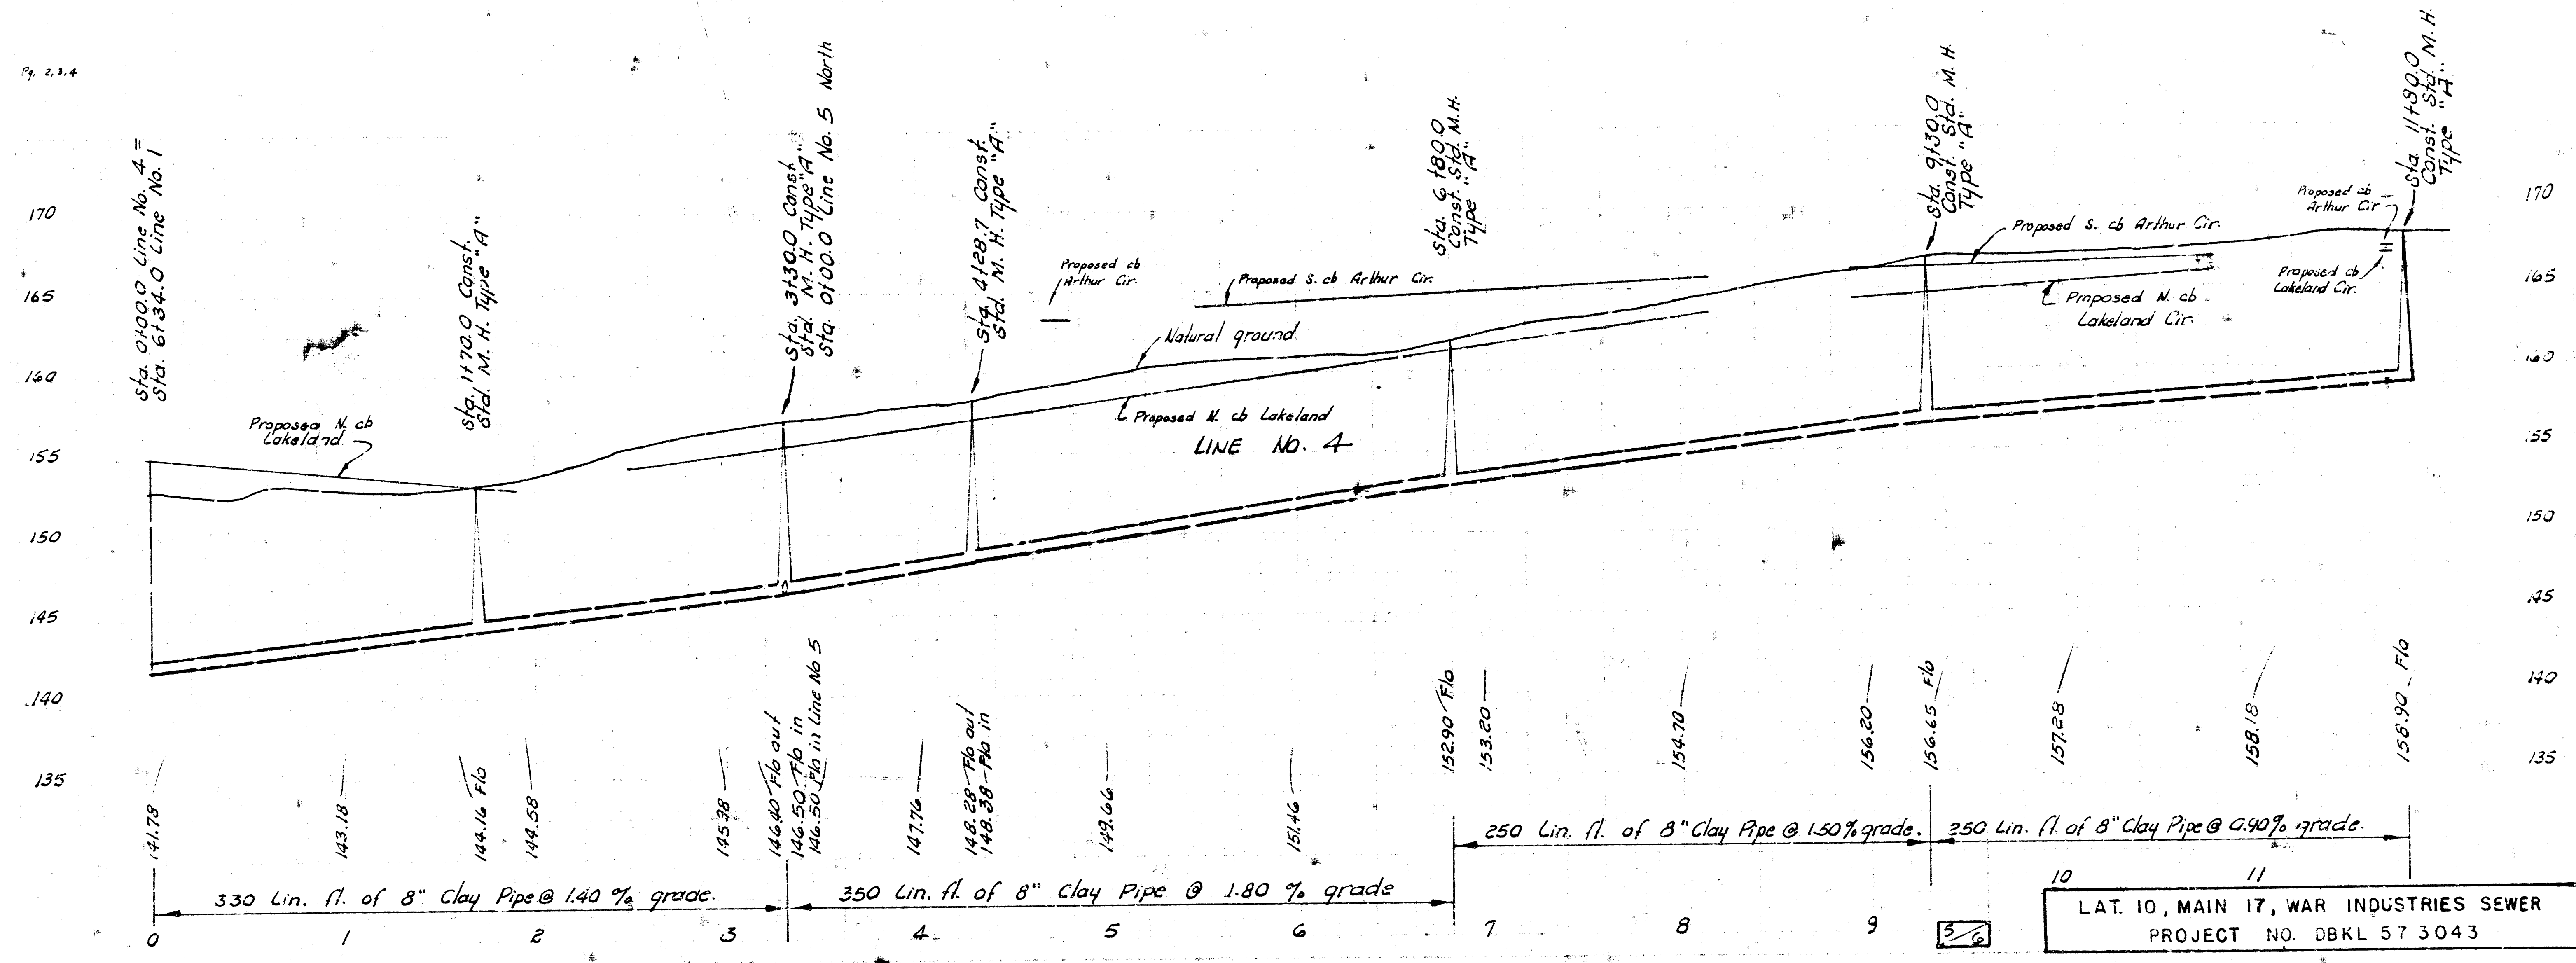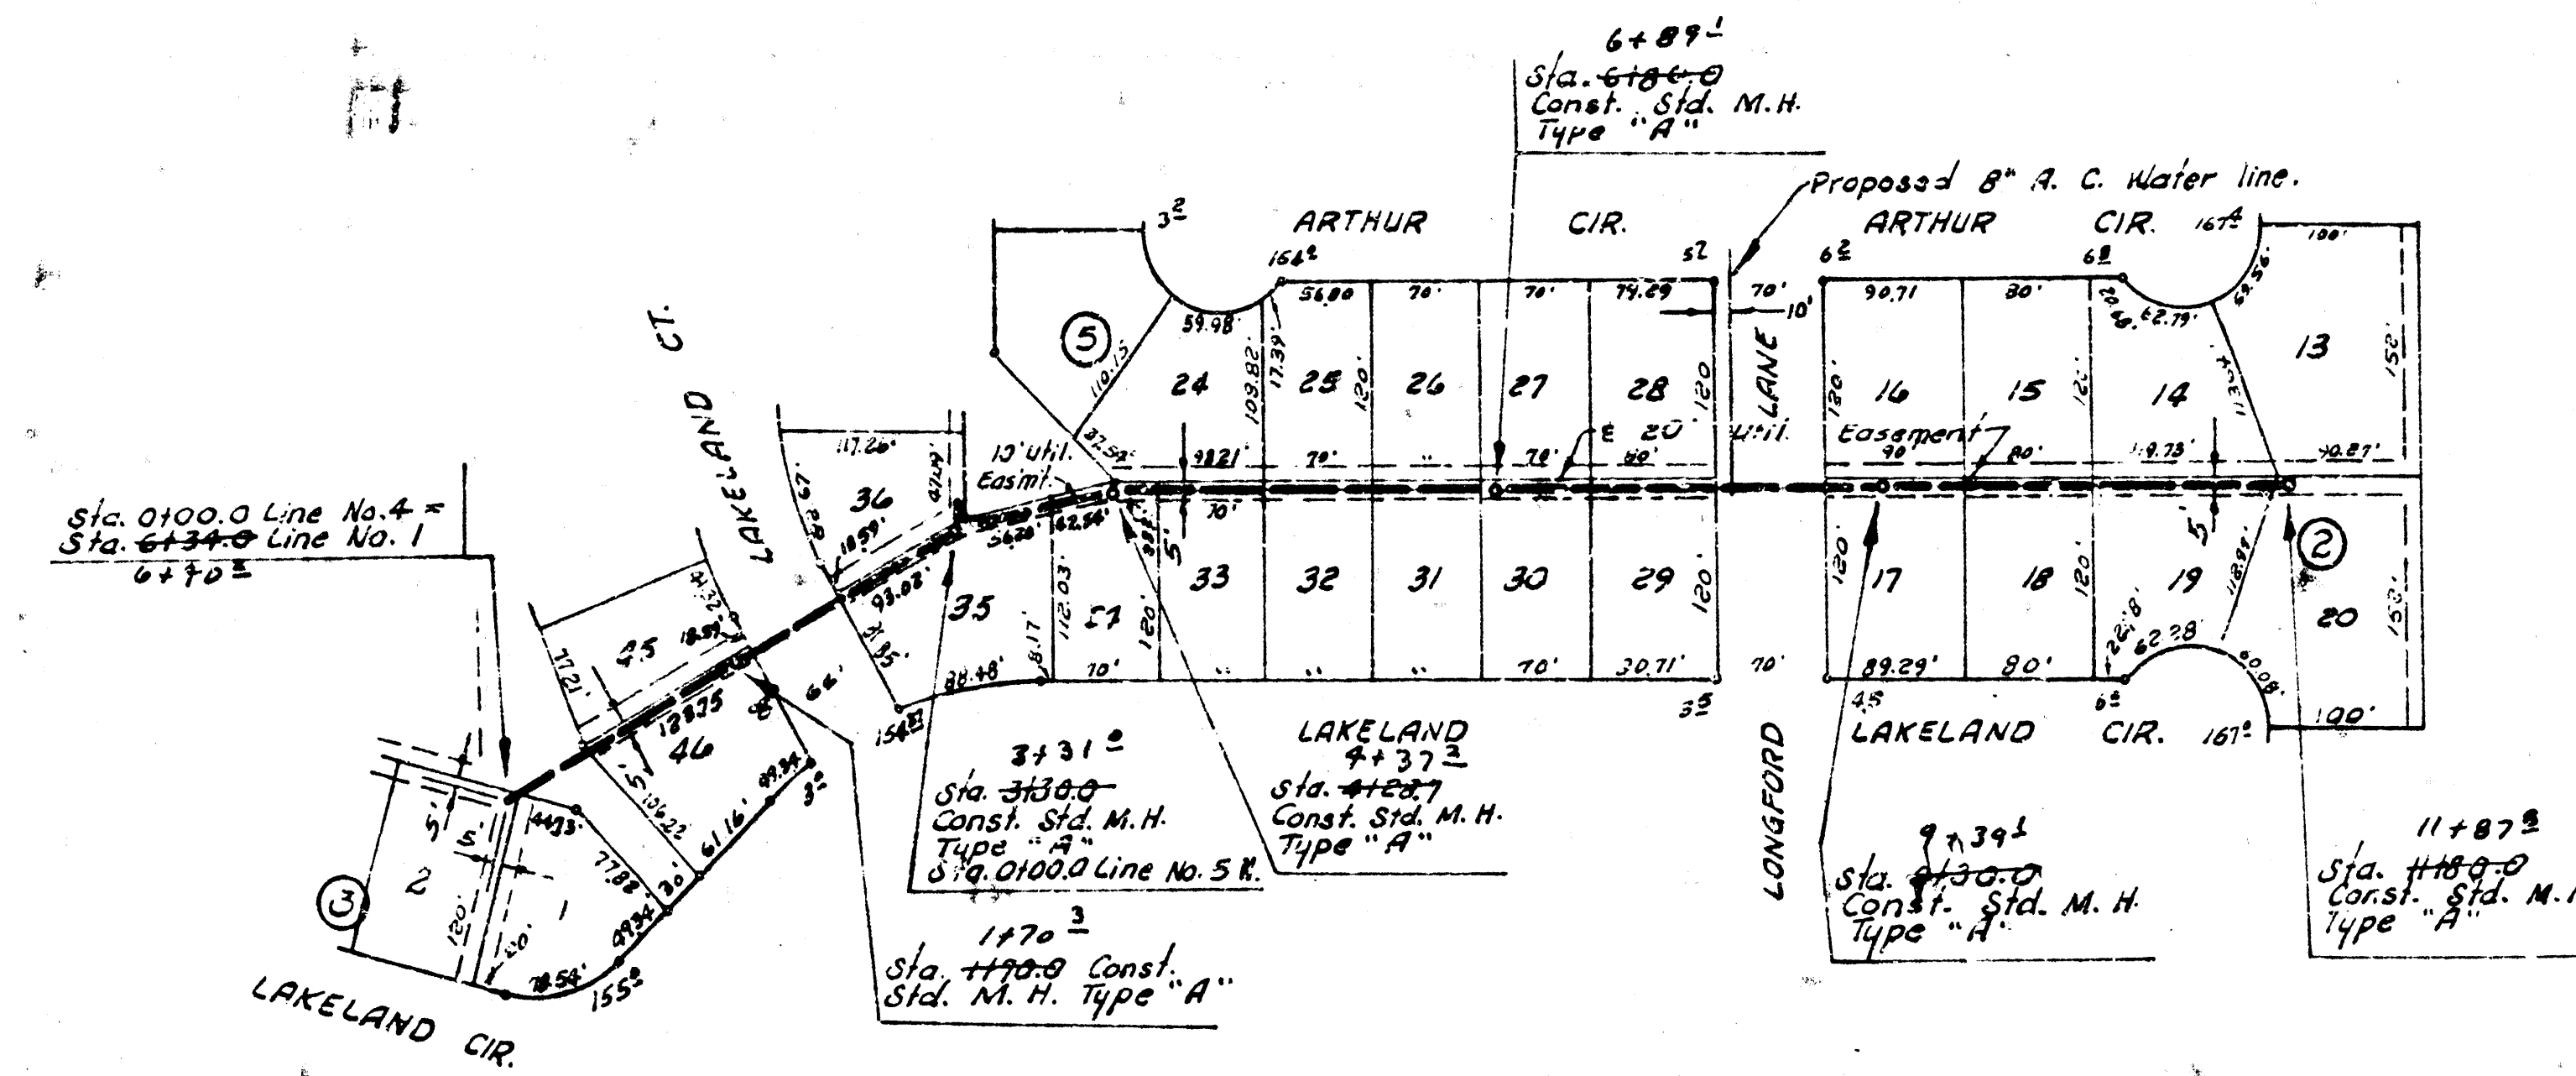

# CEDAR LAKES VILLAGE FIRST ADDITION

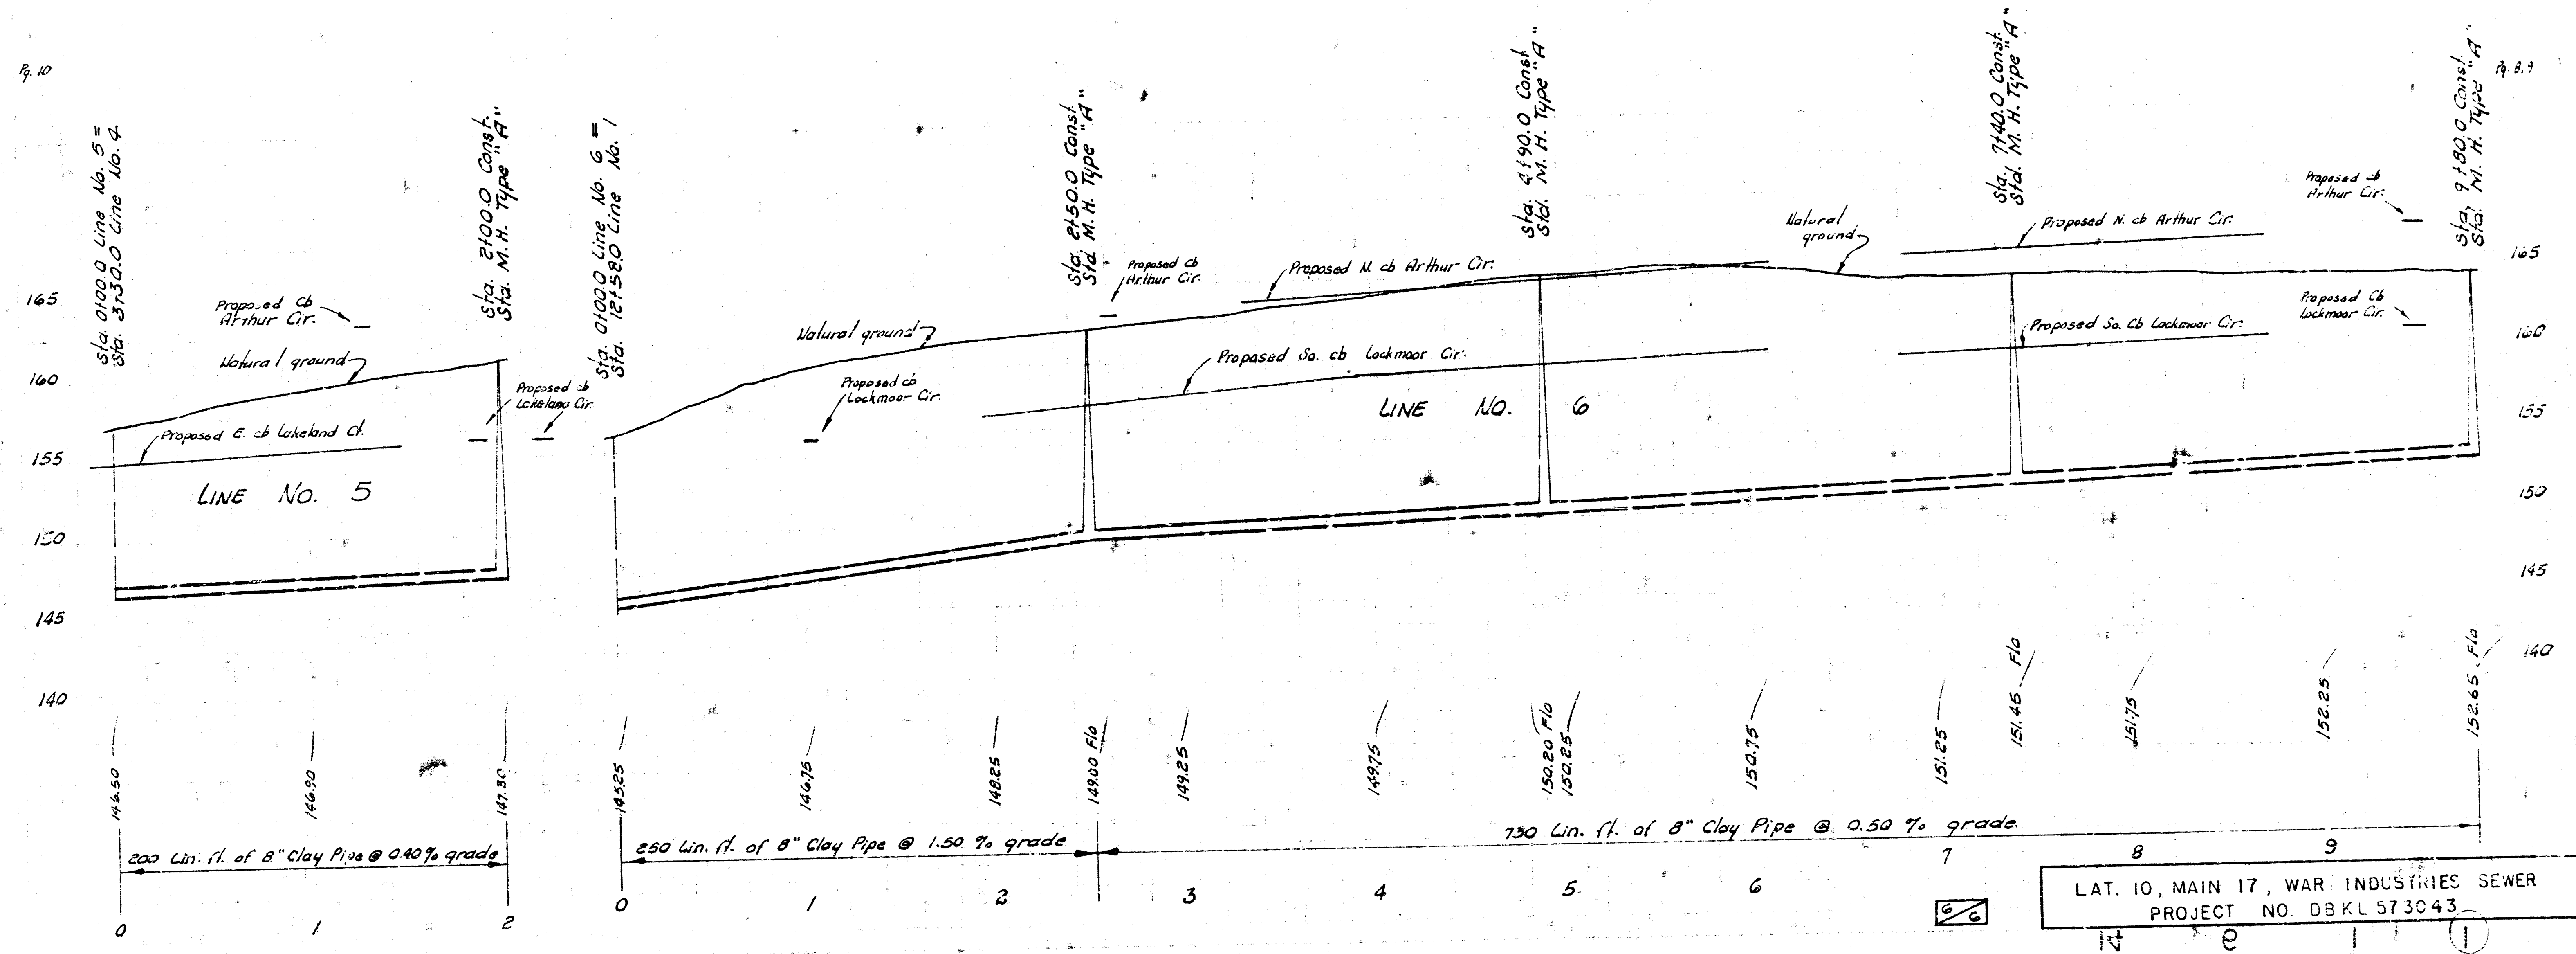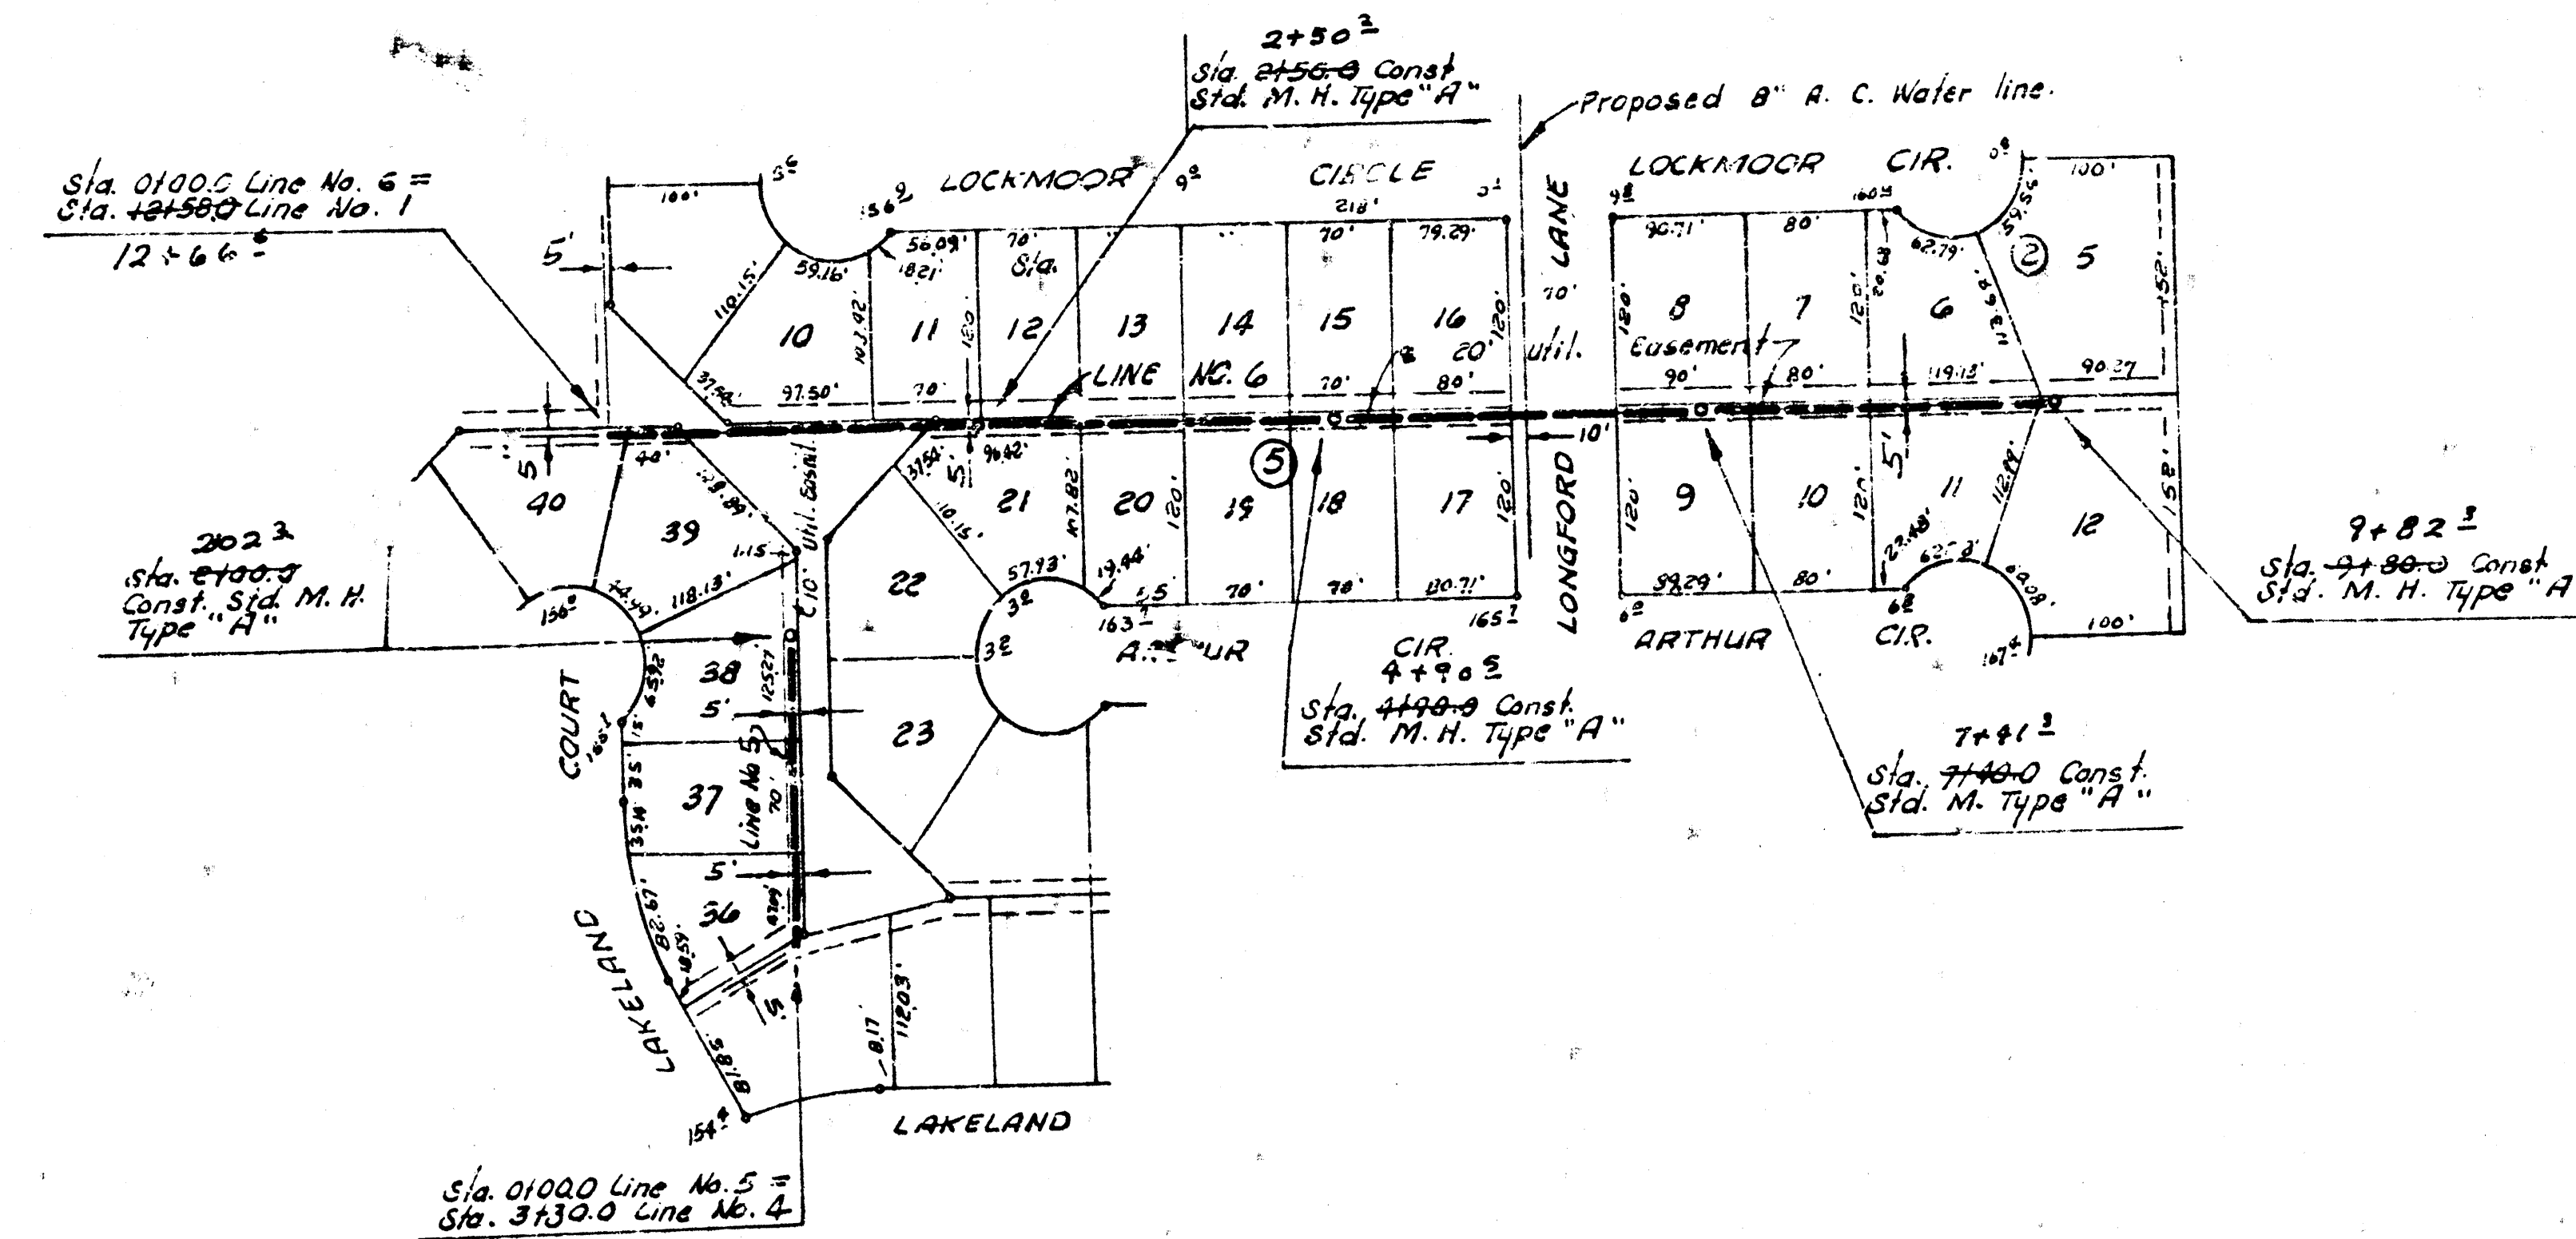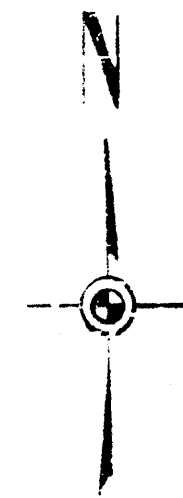

LAT. 10, MAIN 17, WAR INDUSTRIES SEWER  
PROJECT NO. DB KL 573043