

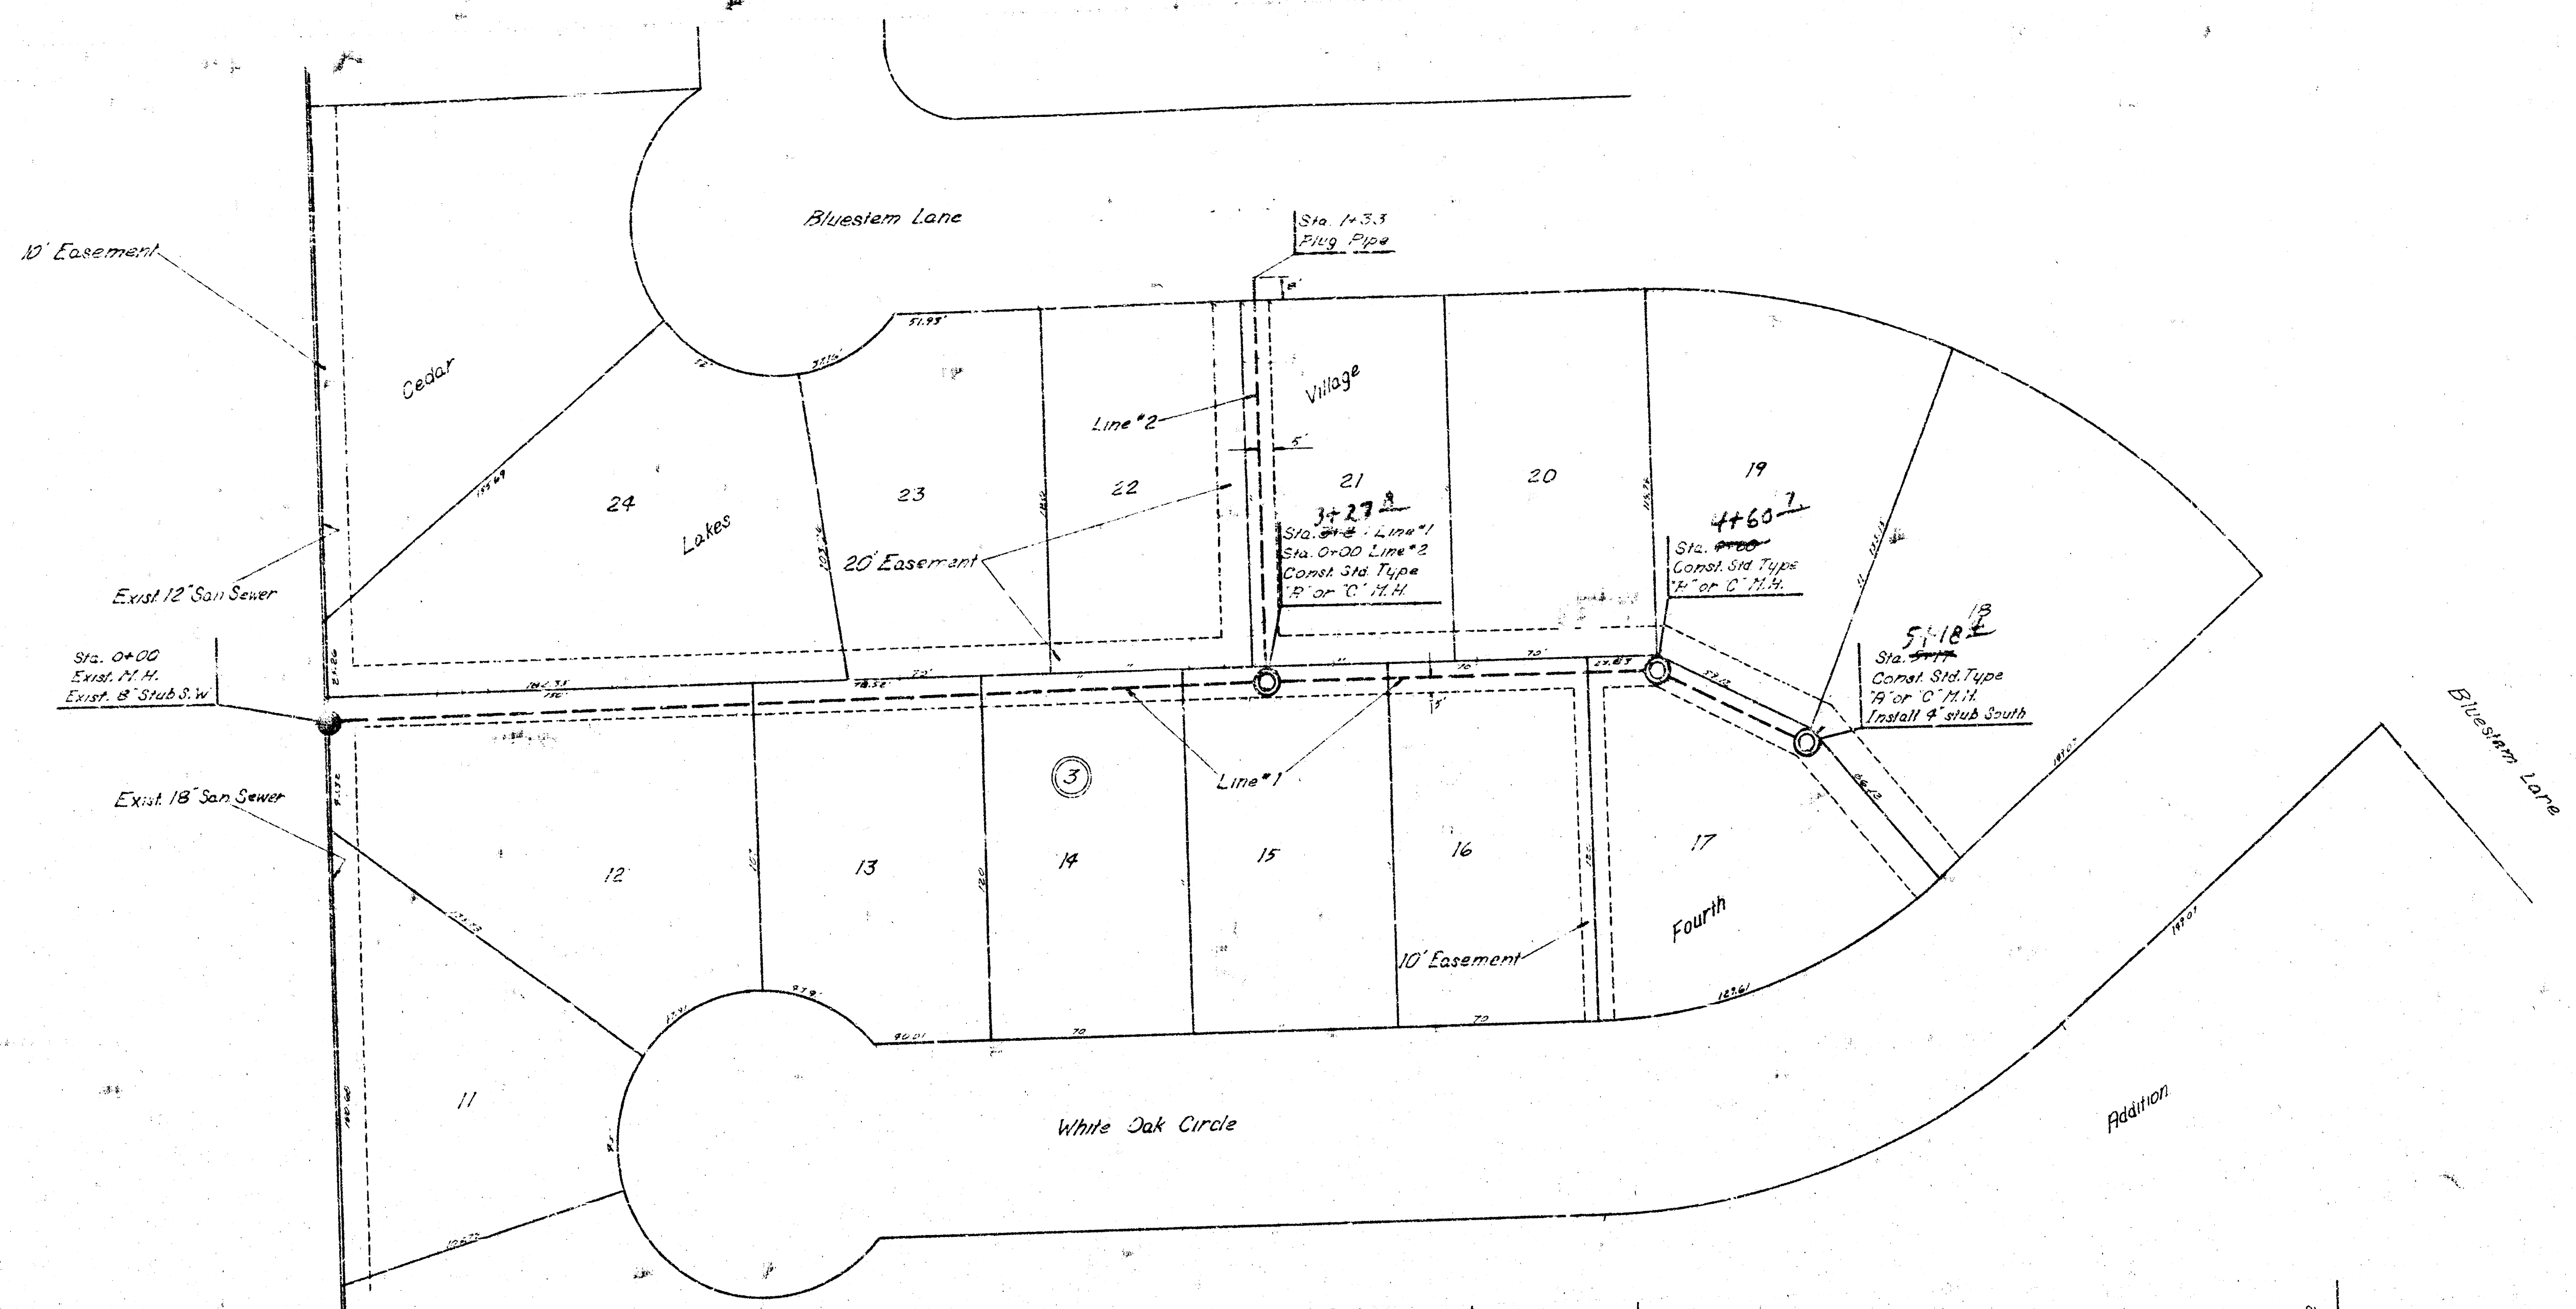


S.M. 153.10 P.R. Spike N. Face P.R. 7' E. of W.L.
 where Oak St. 126' S. of S.L. 174' Version

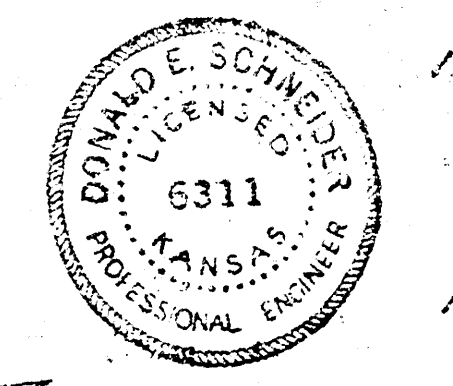

Flag of Sta. 1+33 Line 1 is under
 a temporary plug and is not
 incidental to project

Scale
 Plan: 1"=40'
 Profile: 1"=40'
 Horiz: 1"=40'
 Vert: 1"=5'

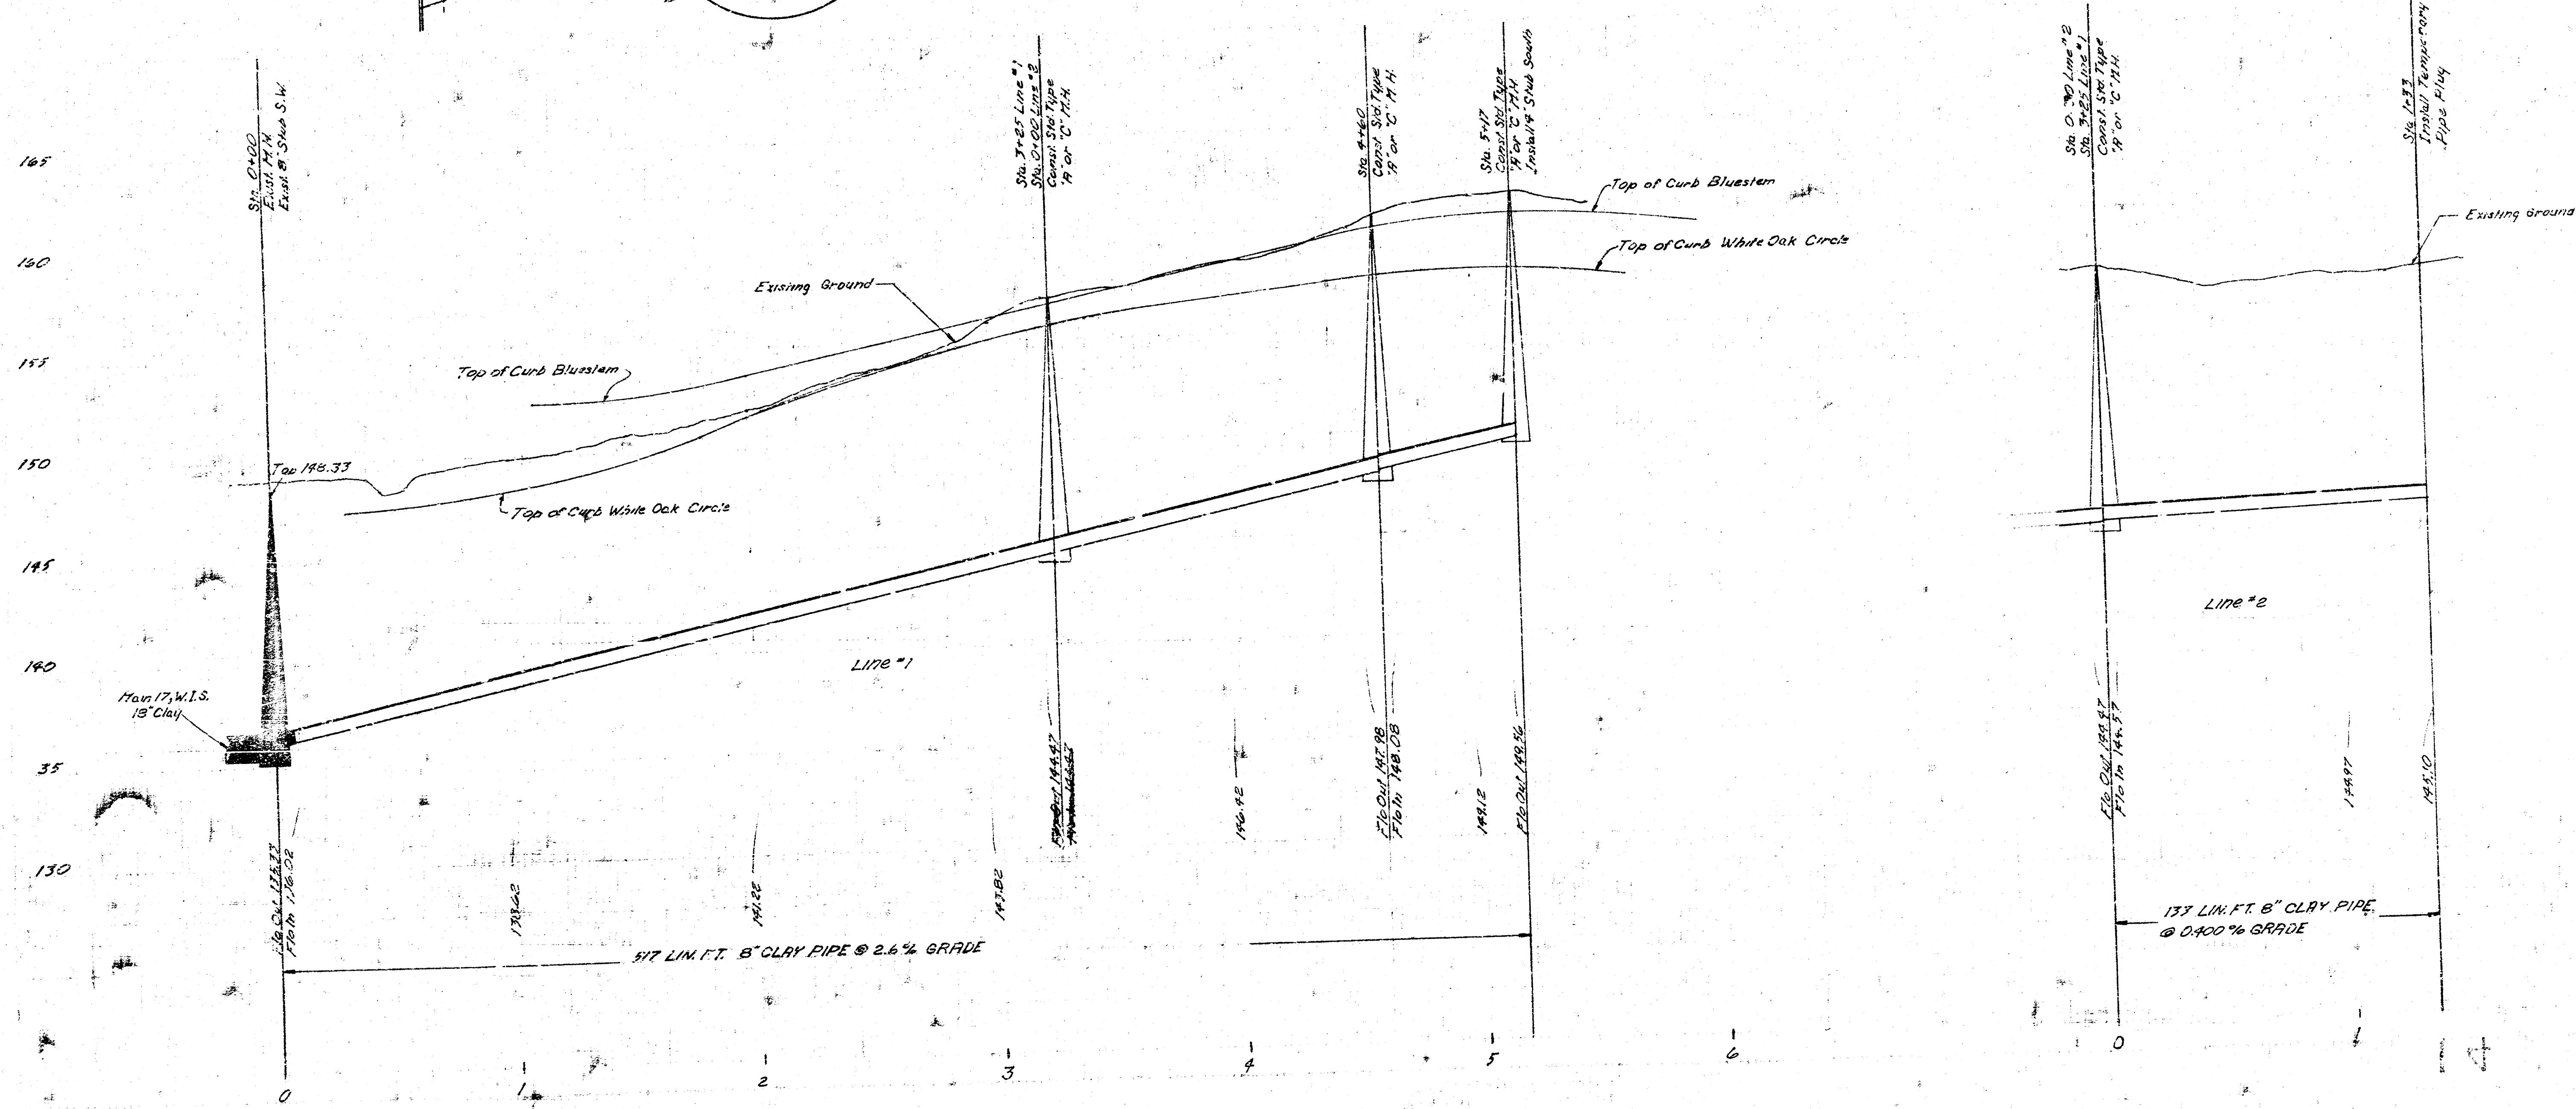

As Built 9-10-75
 Lot 21, Main St., War Industries Sewer
 City of Wichita, Kansas
 R.W. Linn, City Engineer
 Project No. D-4574104
 Date: Sheet 1 of 1