



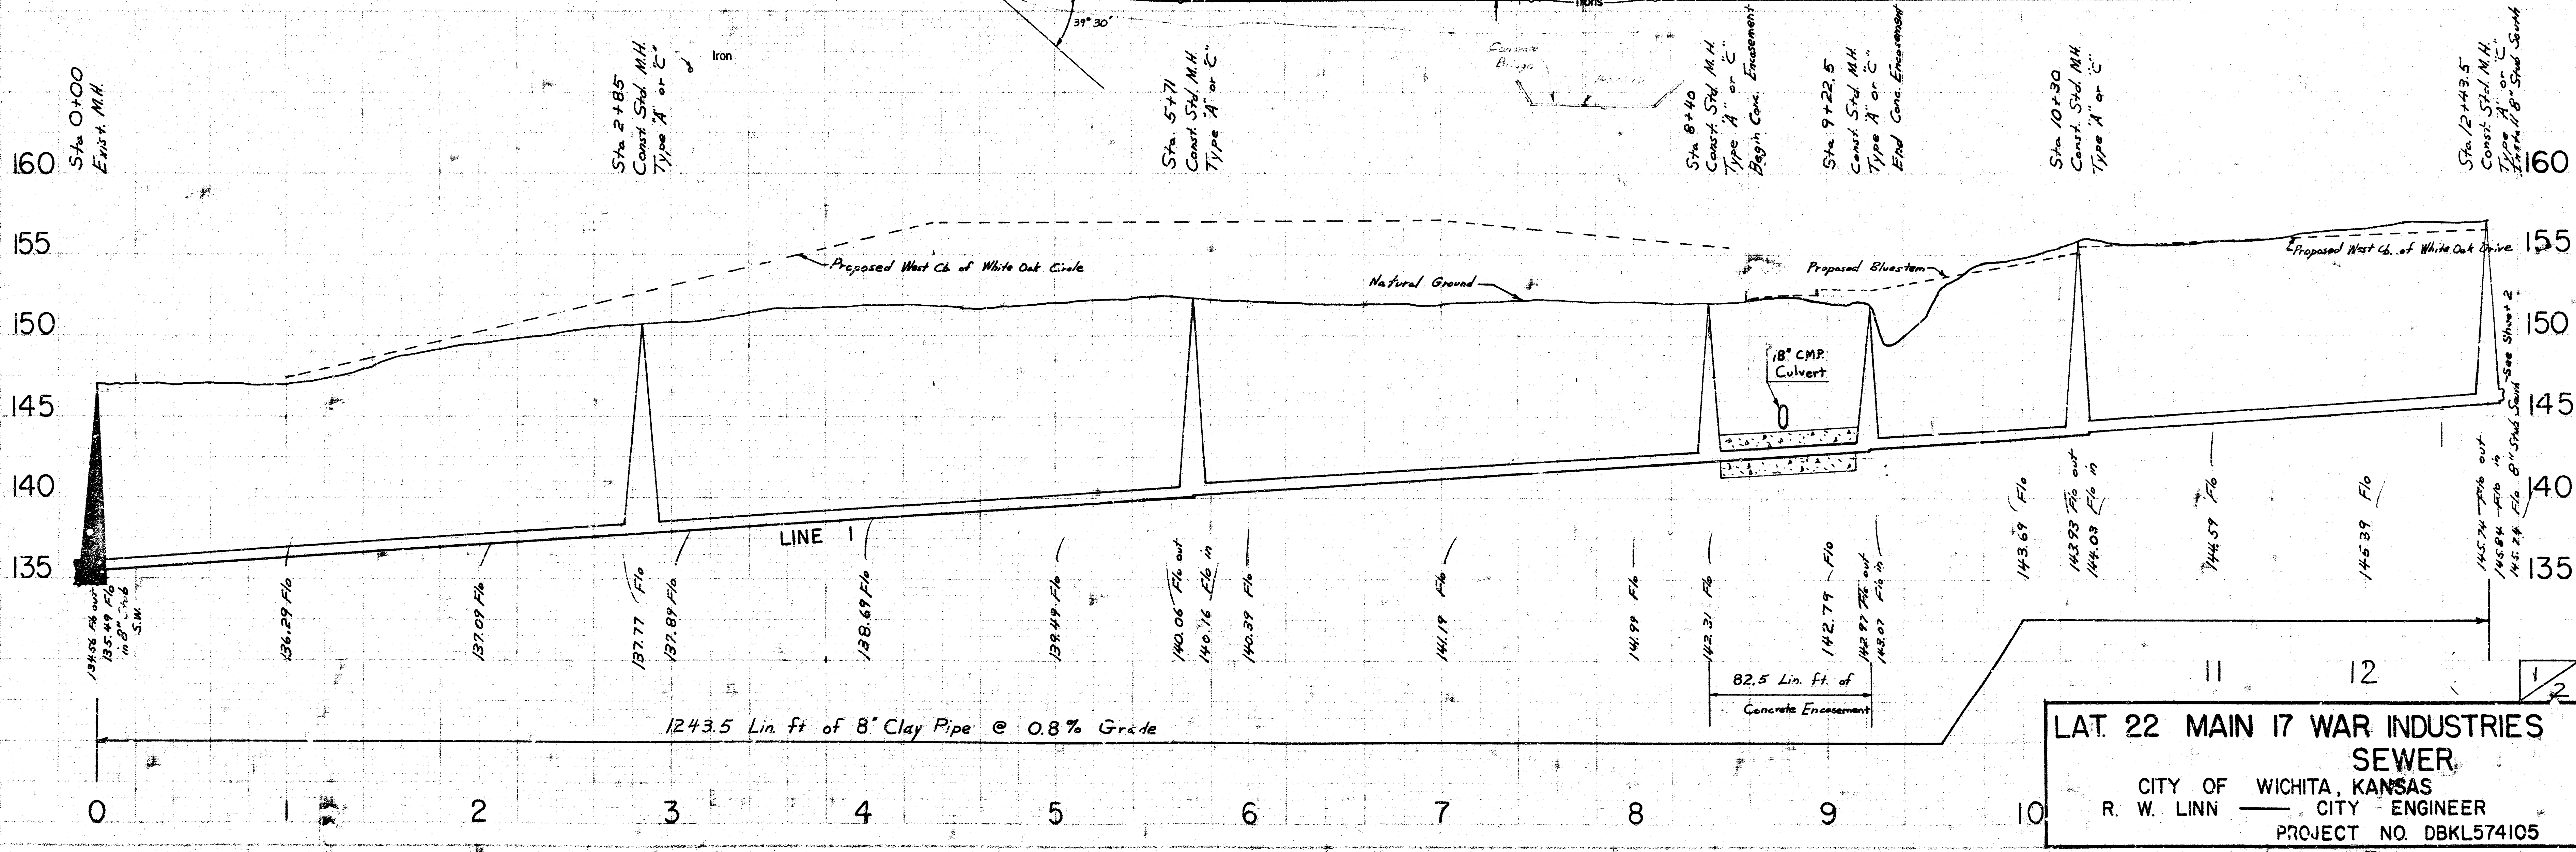

**LAT. 22 MAIN 17 WAR INDUSTRIES SEWER**  
 CITY OF WICHITA, KANSAS  
 R. W. LINN CITY ENGINEER  
 PROJECT NO. DBKL574105  
 As Built 1-28-76

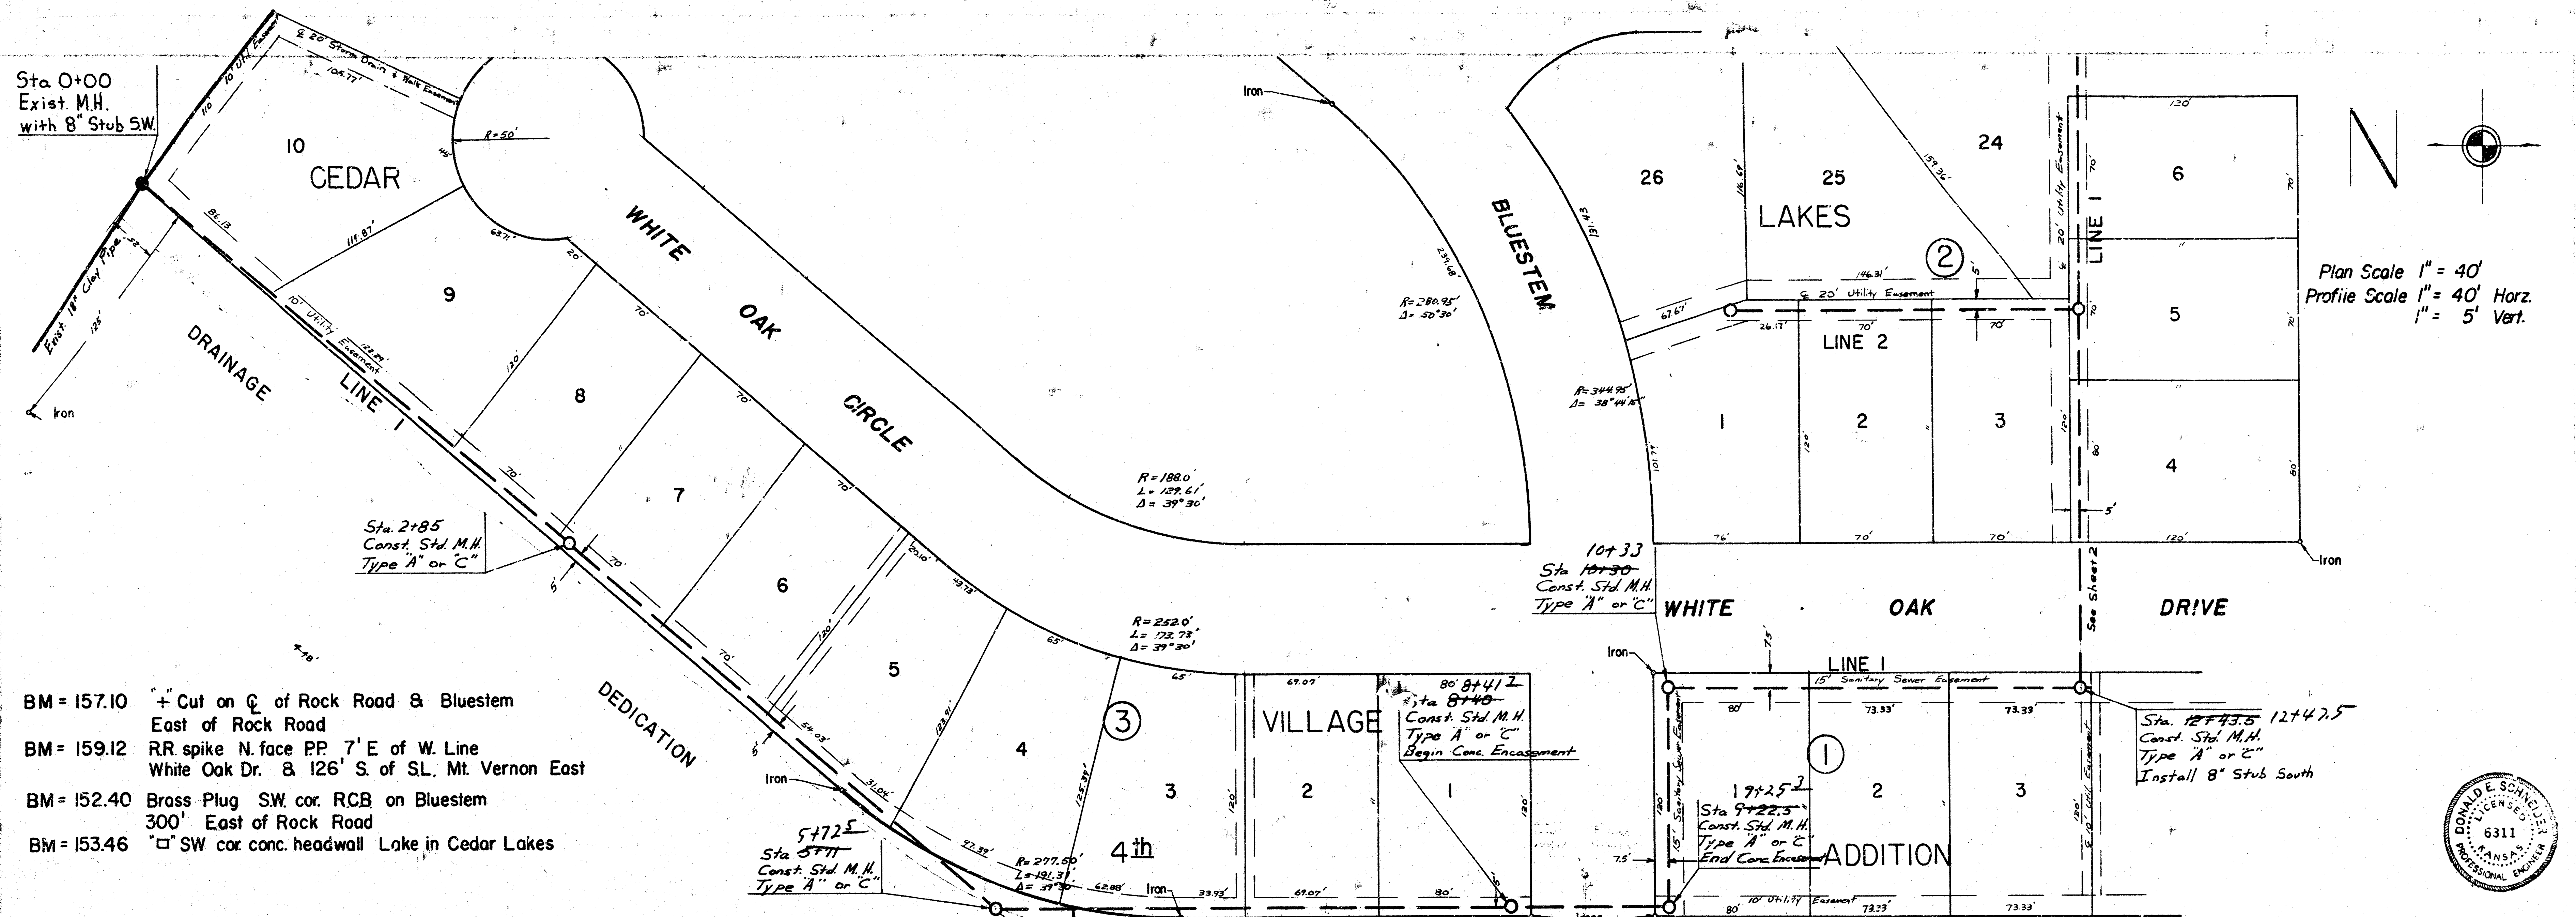