



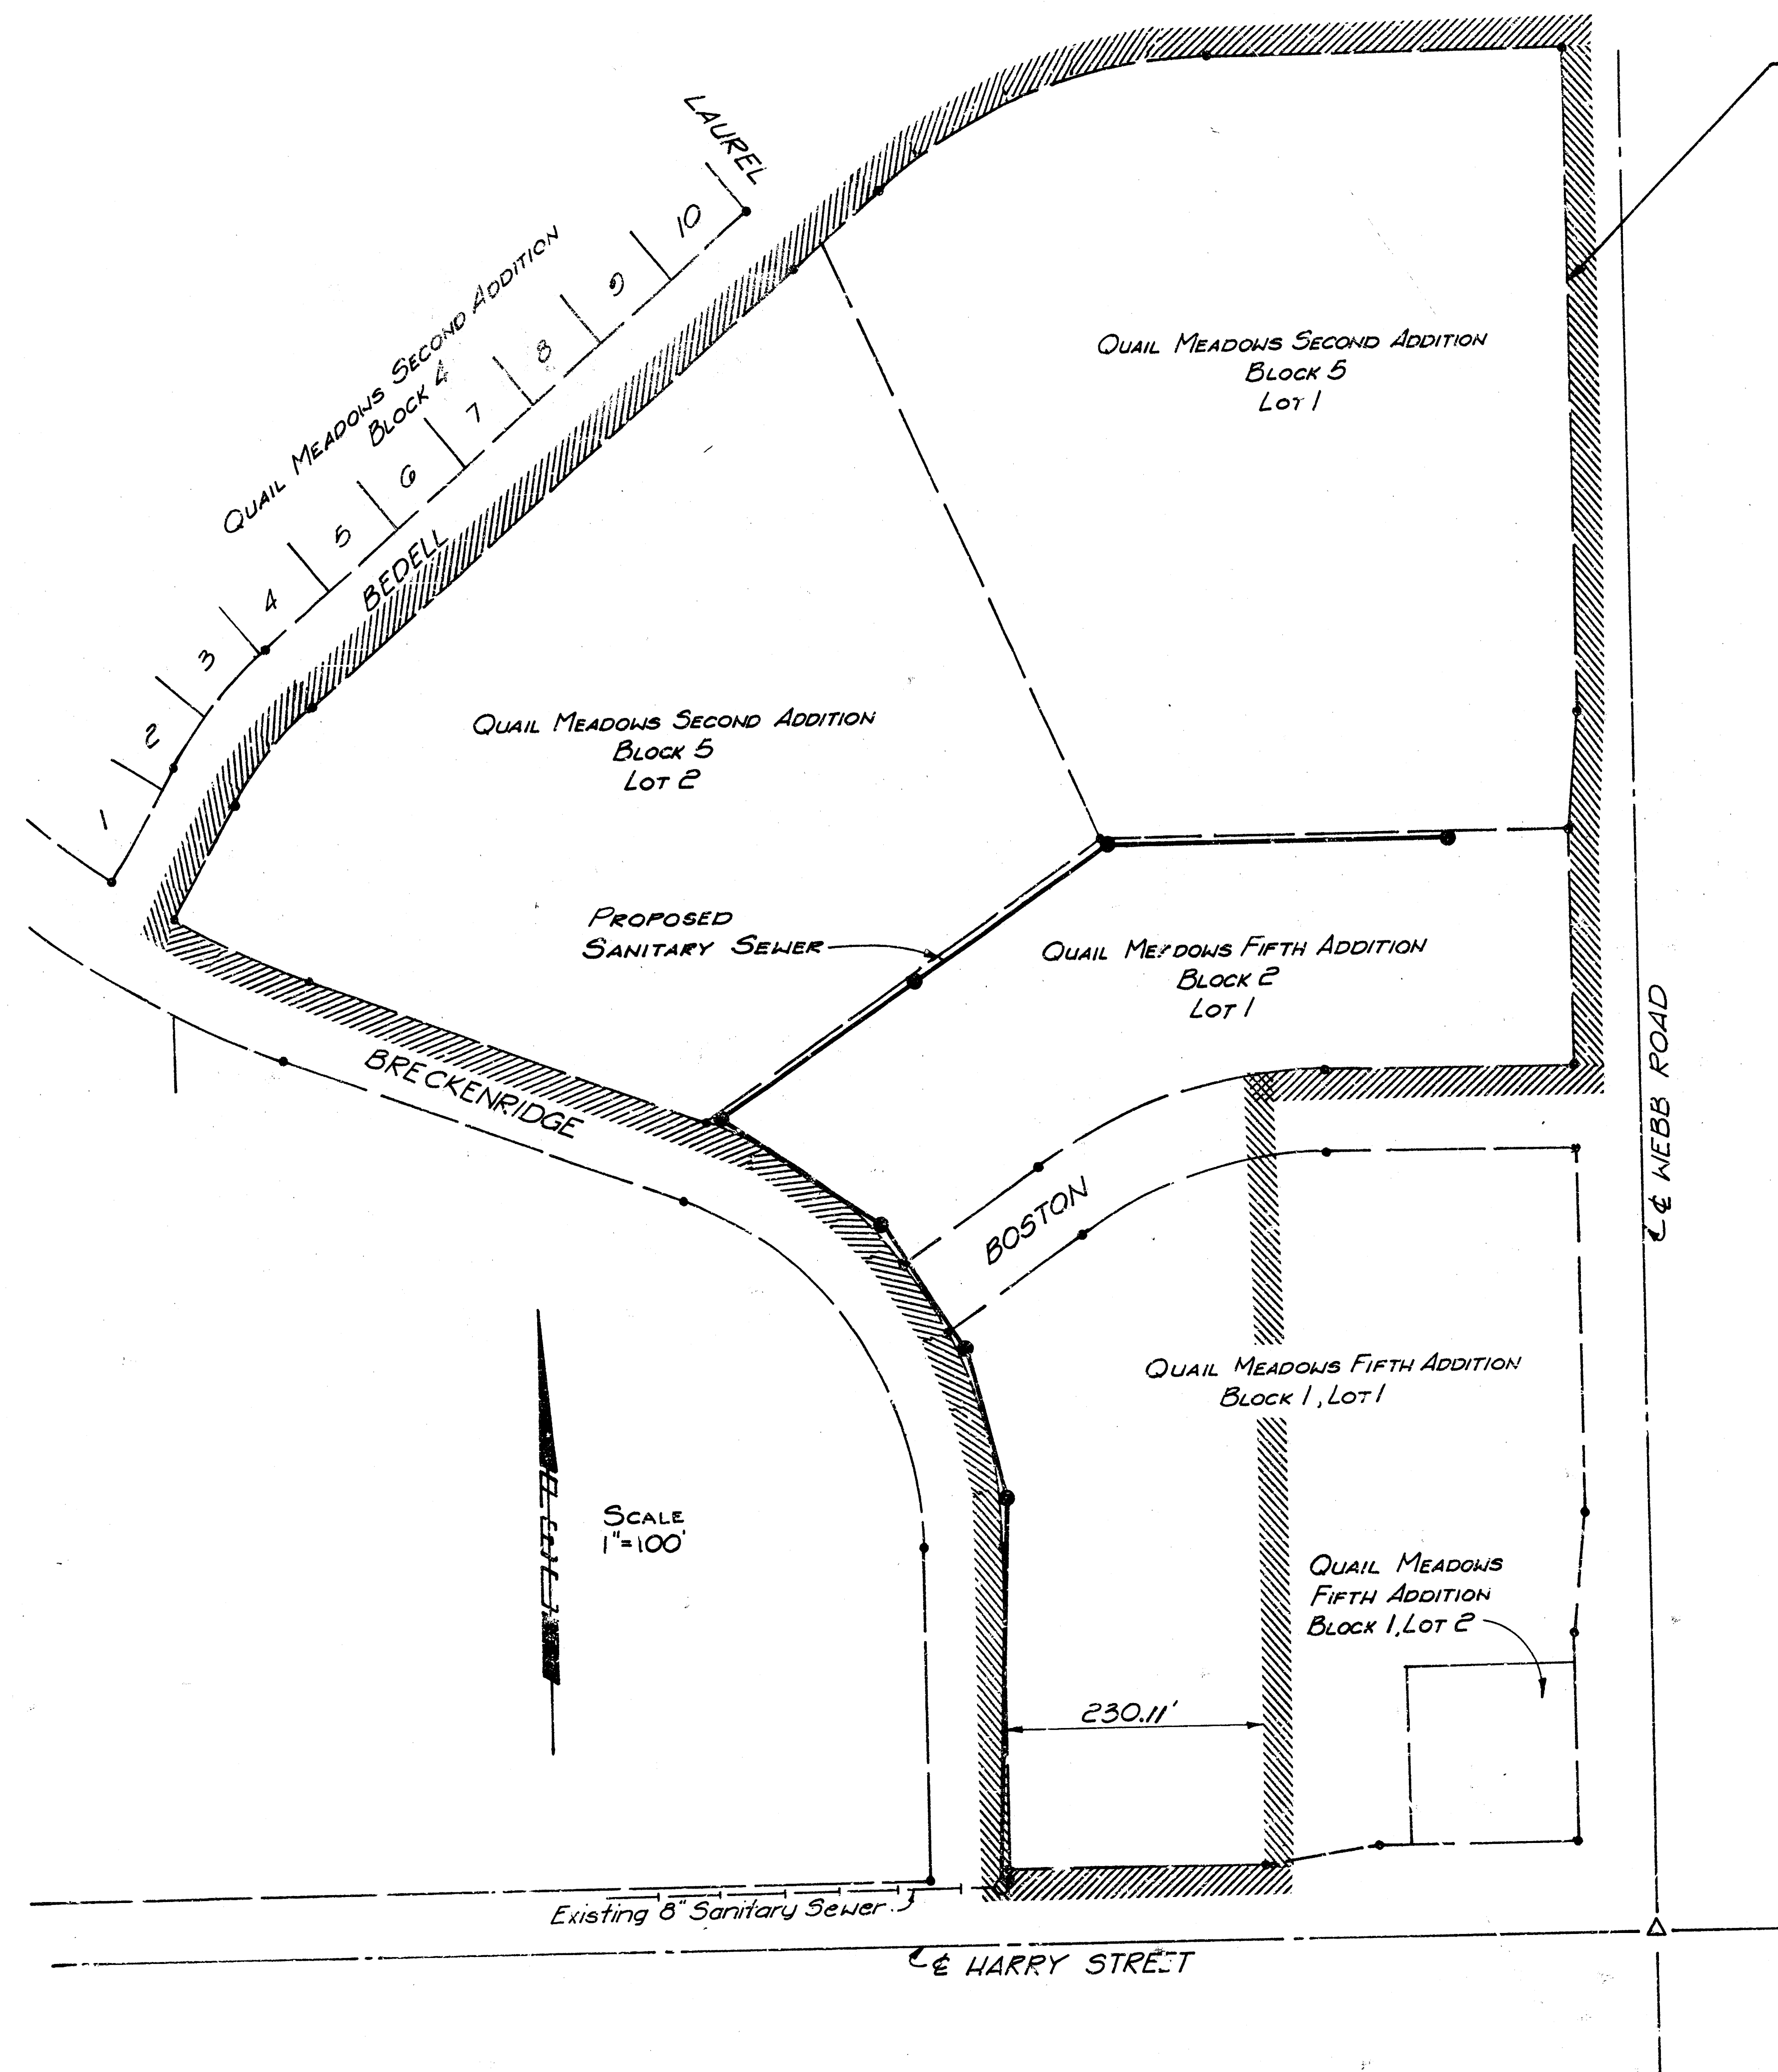


BENEFIT DISTRICT

CITY OF WICHITA
SEDGWICK COUNTY, KANSAS
PROJECT NO. DBKL 574040
PROJECT NUMBER: 468-76-245-80152-000-000-001

WAR INDUSTRY SEWER
LATERAL NO. 3, MAIN 19

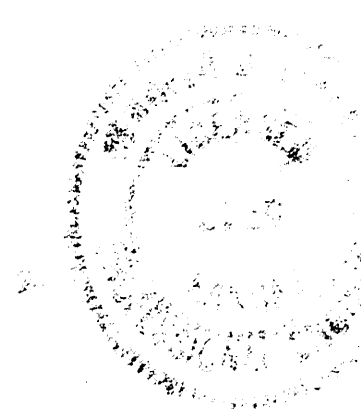

As built 11-6-78
PROFESSIONAL ENGINEERING CONSULTANTS, P.A.
ENGINEERS
 WICHITA, KANSAS

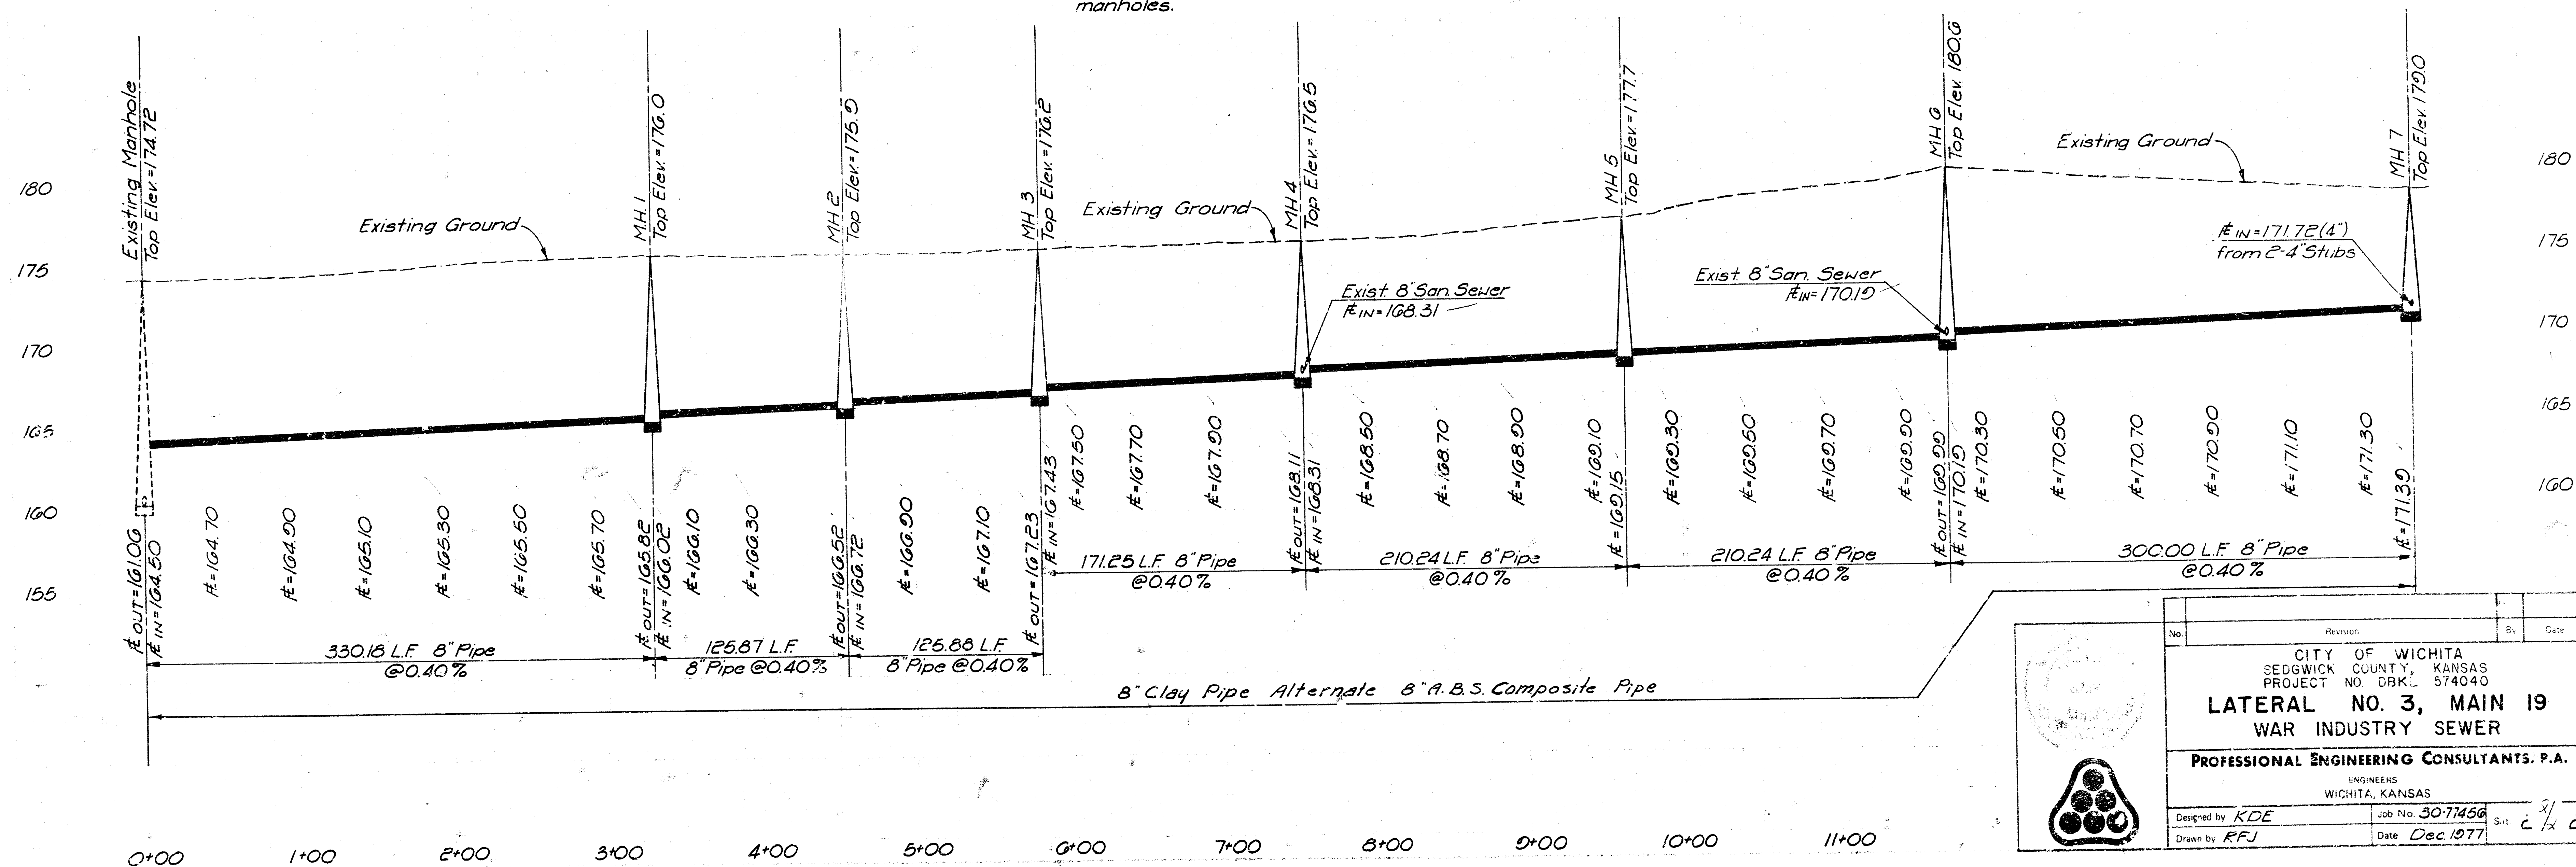[illegible]

No.	Revision	By	Date
CITY OF WICHITA SEDGWICK COUNTY, KANSAS PROJECT NO. DBK- 574040 LATERAL NO. 3, MAIN 19 WAR INDUSTRY SEWER PROFESSIONAL ENGINEERING CONSULTANTS. P.A. ENGINEERS WICHITA, KANSAS			
Designed by <i>KDE</i>		Job No. <i>30-77456</i>	Suit. <i>2/1</i>
Drawn by <i>RFJ</i>		Date <i>Dec 1977</i>	<i>1/2</i>