




E. Builders
R. Planners
1/80
3/80

D.R. 35

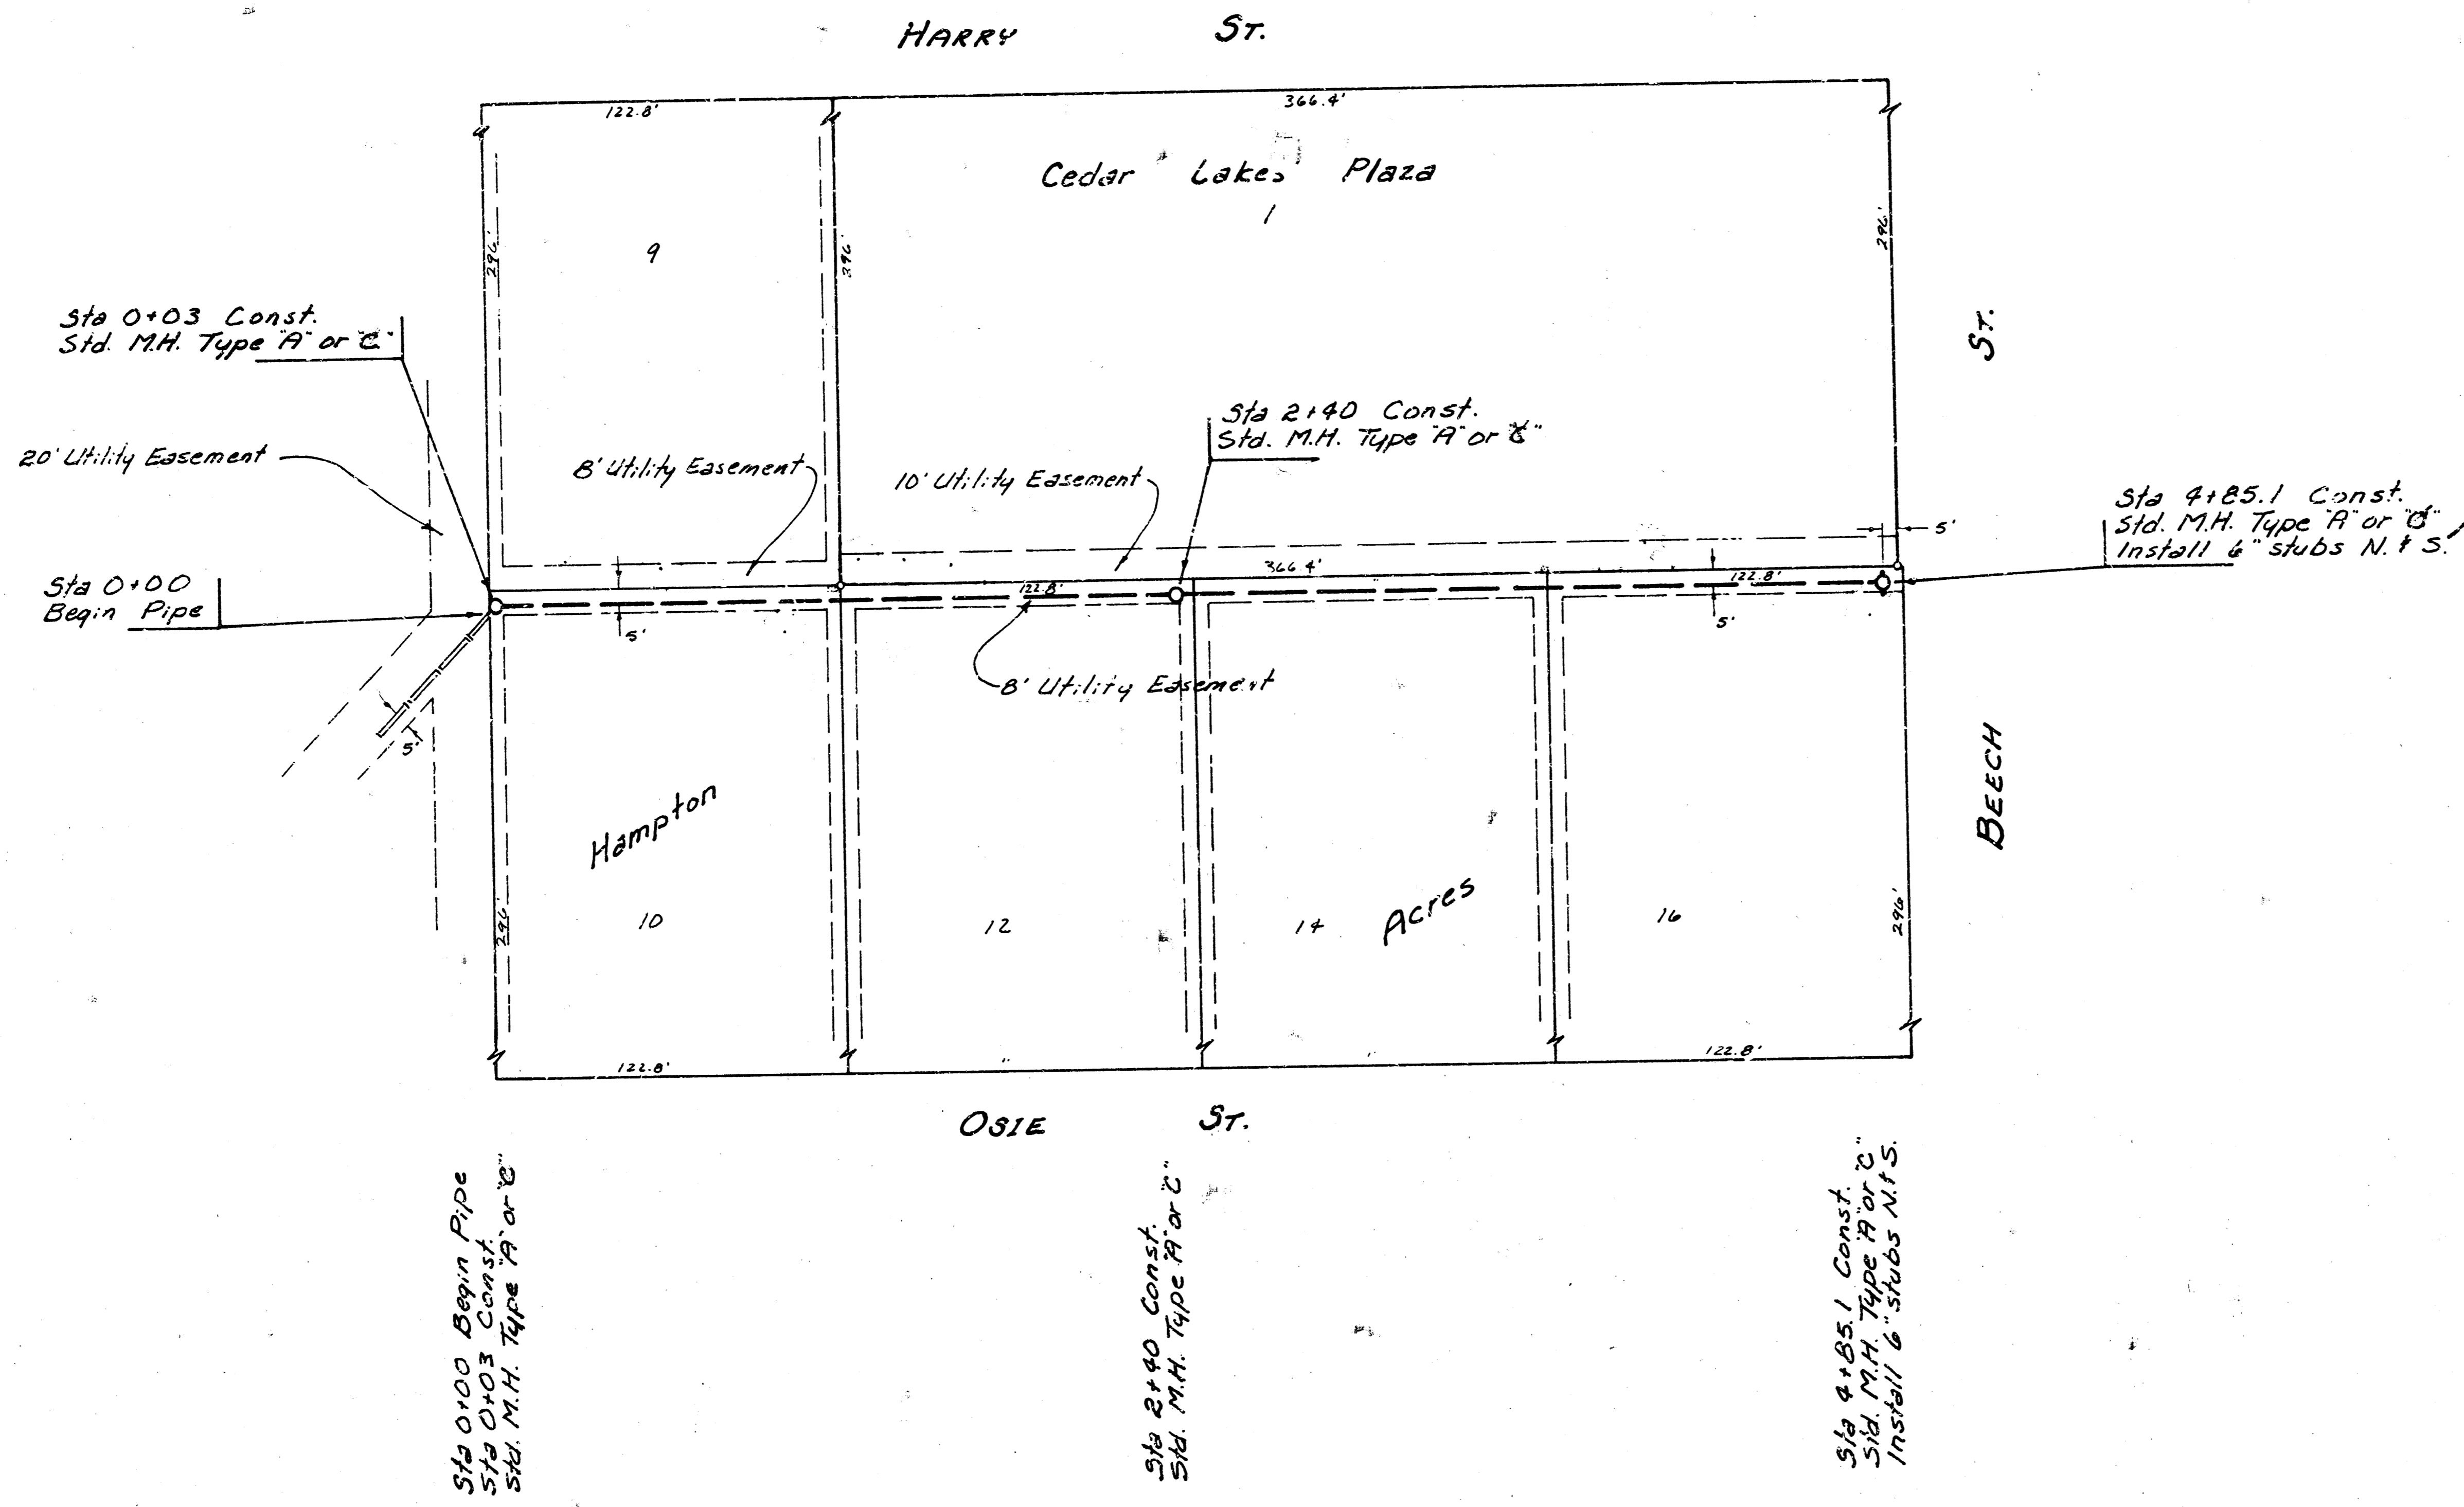

Scale Plan 1" = 40'
Profile 1" = 40' Horiz.
1" = 5' Vert.

B.M. 172.03 City Std. 48' S. & 46' W of E's
Webb Rd. & Harry.
B.M. 173.05 Bridge Spike, S Face of P.P.
≈ 295' S of SL Harry St. &
≈ 7' E. of WL of Beech.

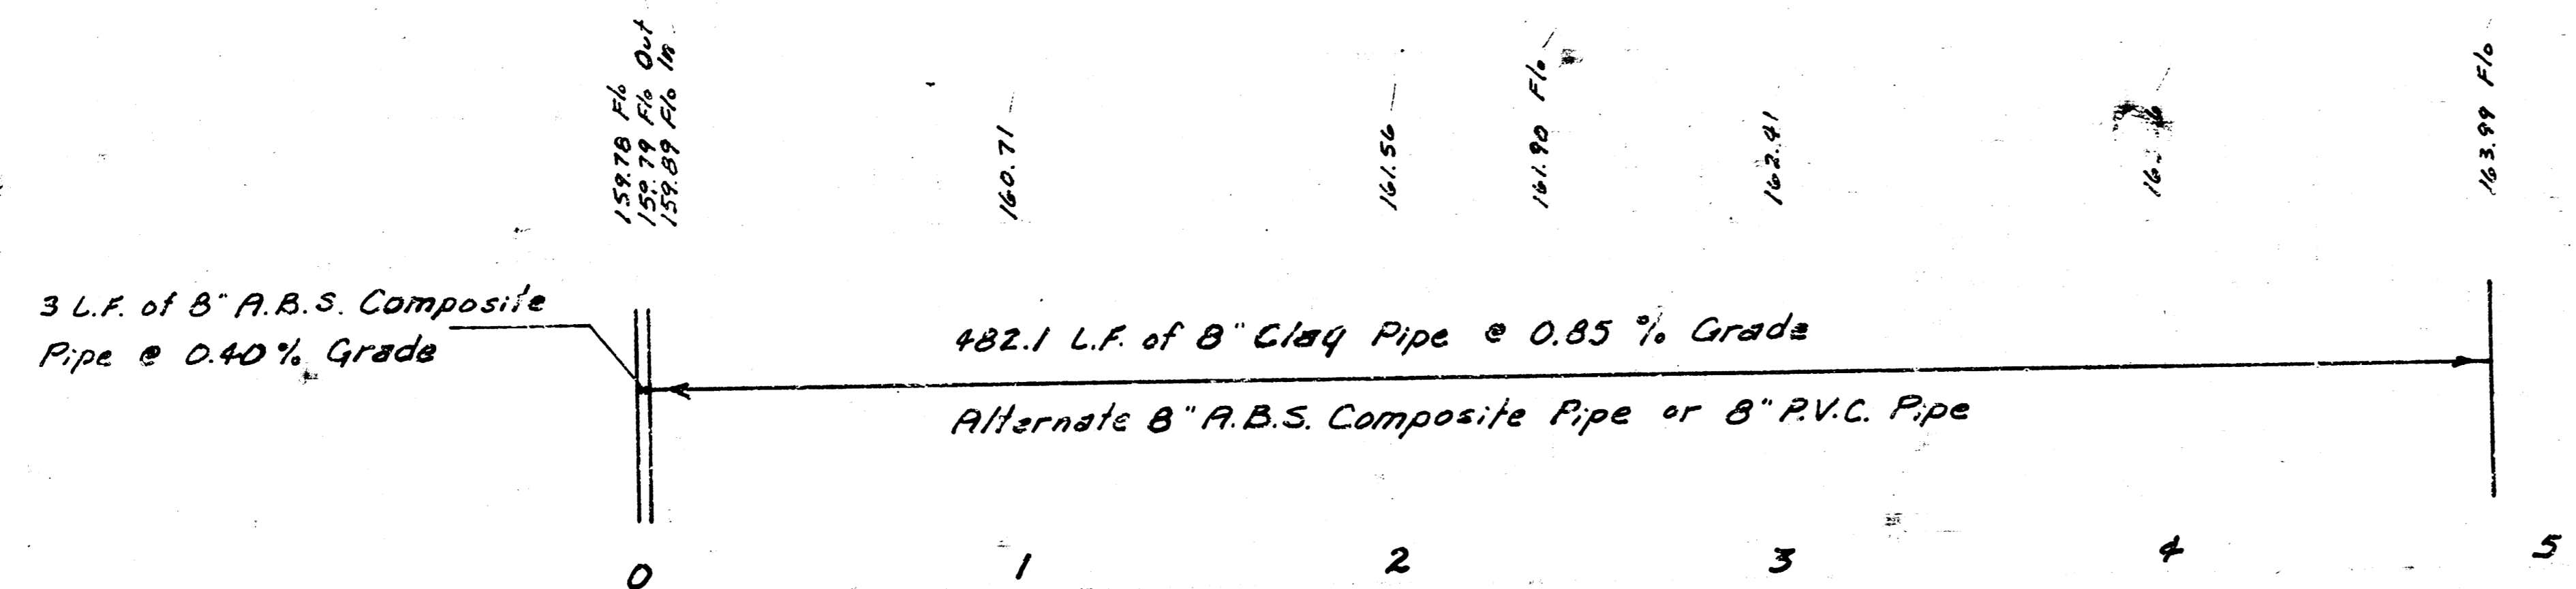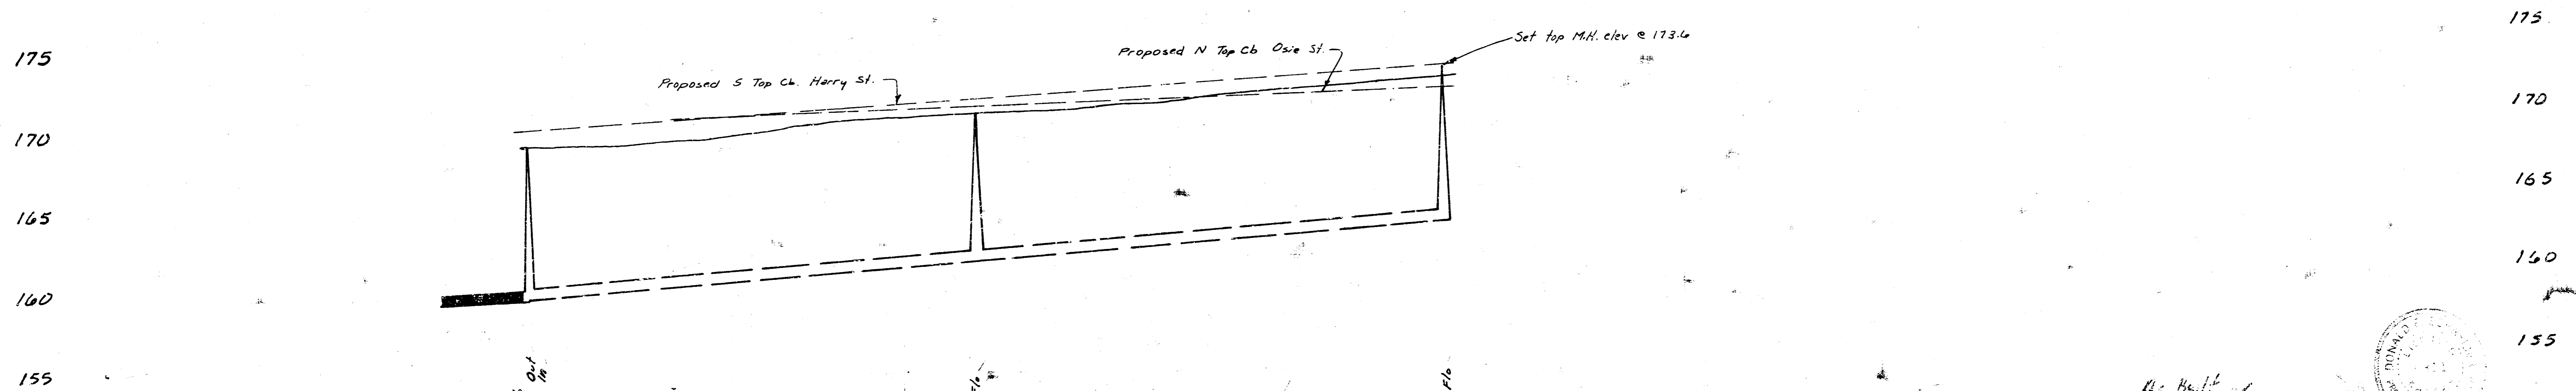

As Built
7-30-88
E231



LAT 10, MAIN 19, WAR INDUSTRIES SEWER
CITY OF WICHITA, KANSAS
DEAN SELLERS — CITY ENGINEER
PROJECT NO. 468-76-245-80900-000-001