

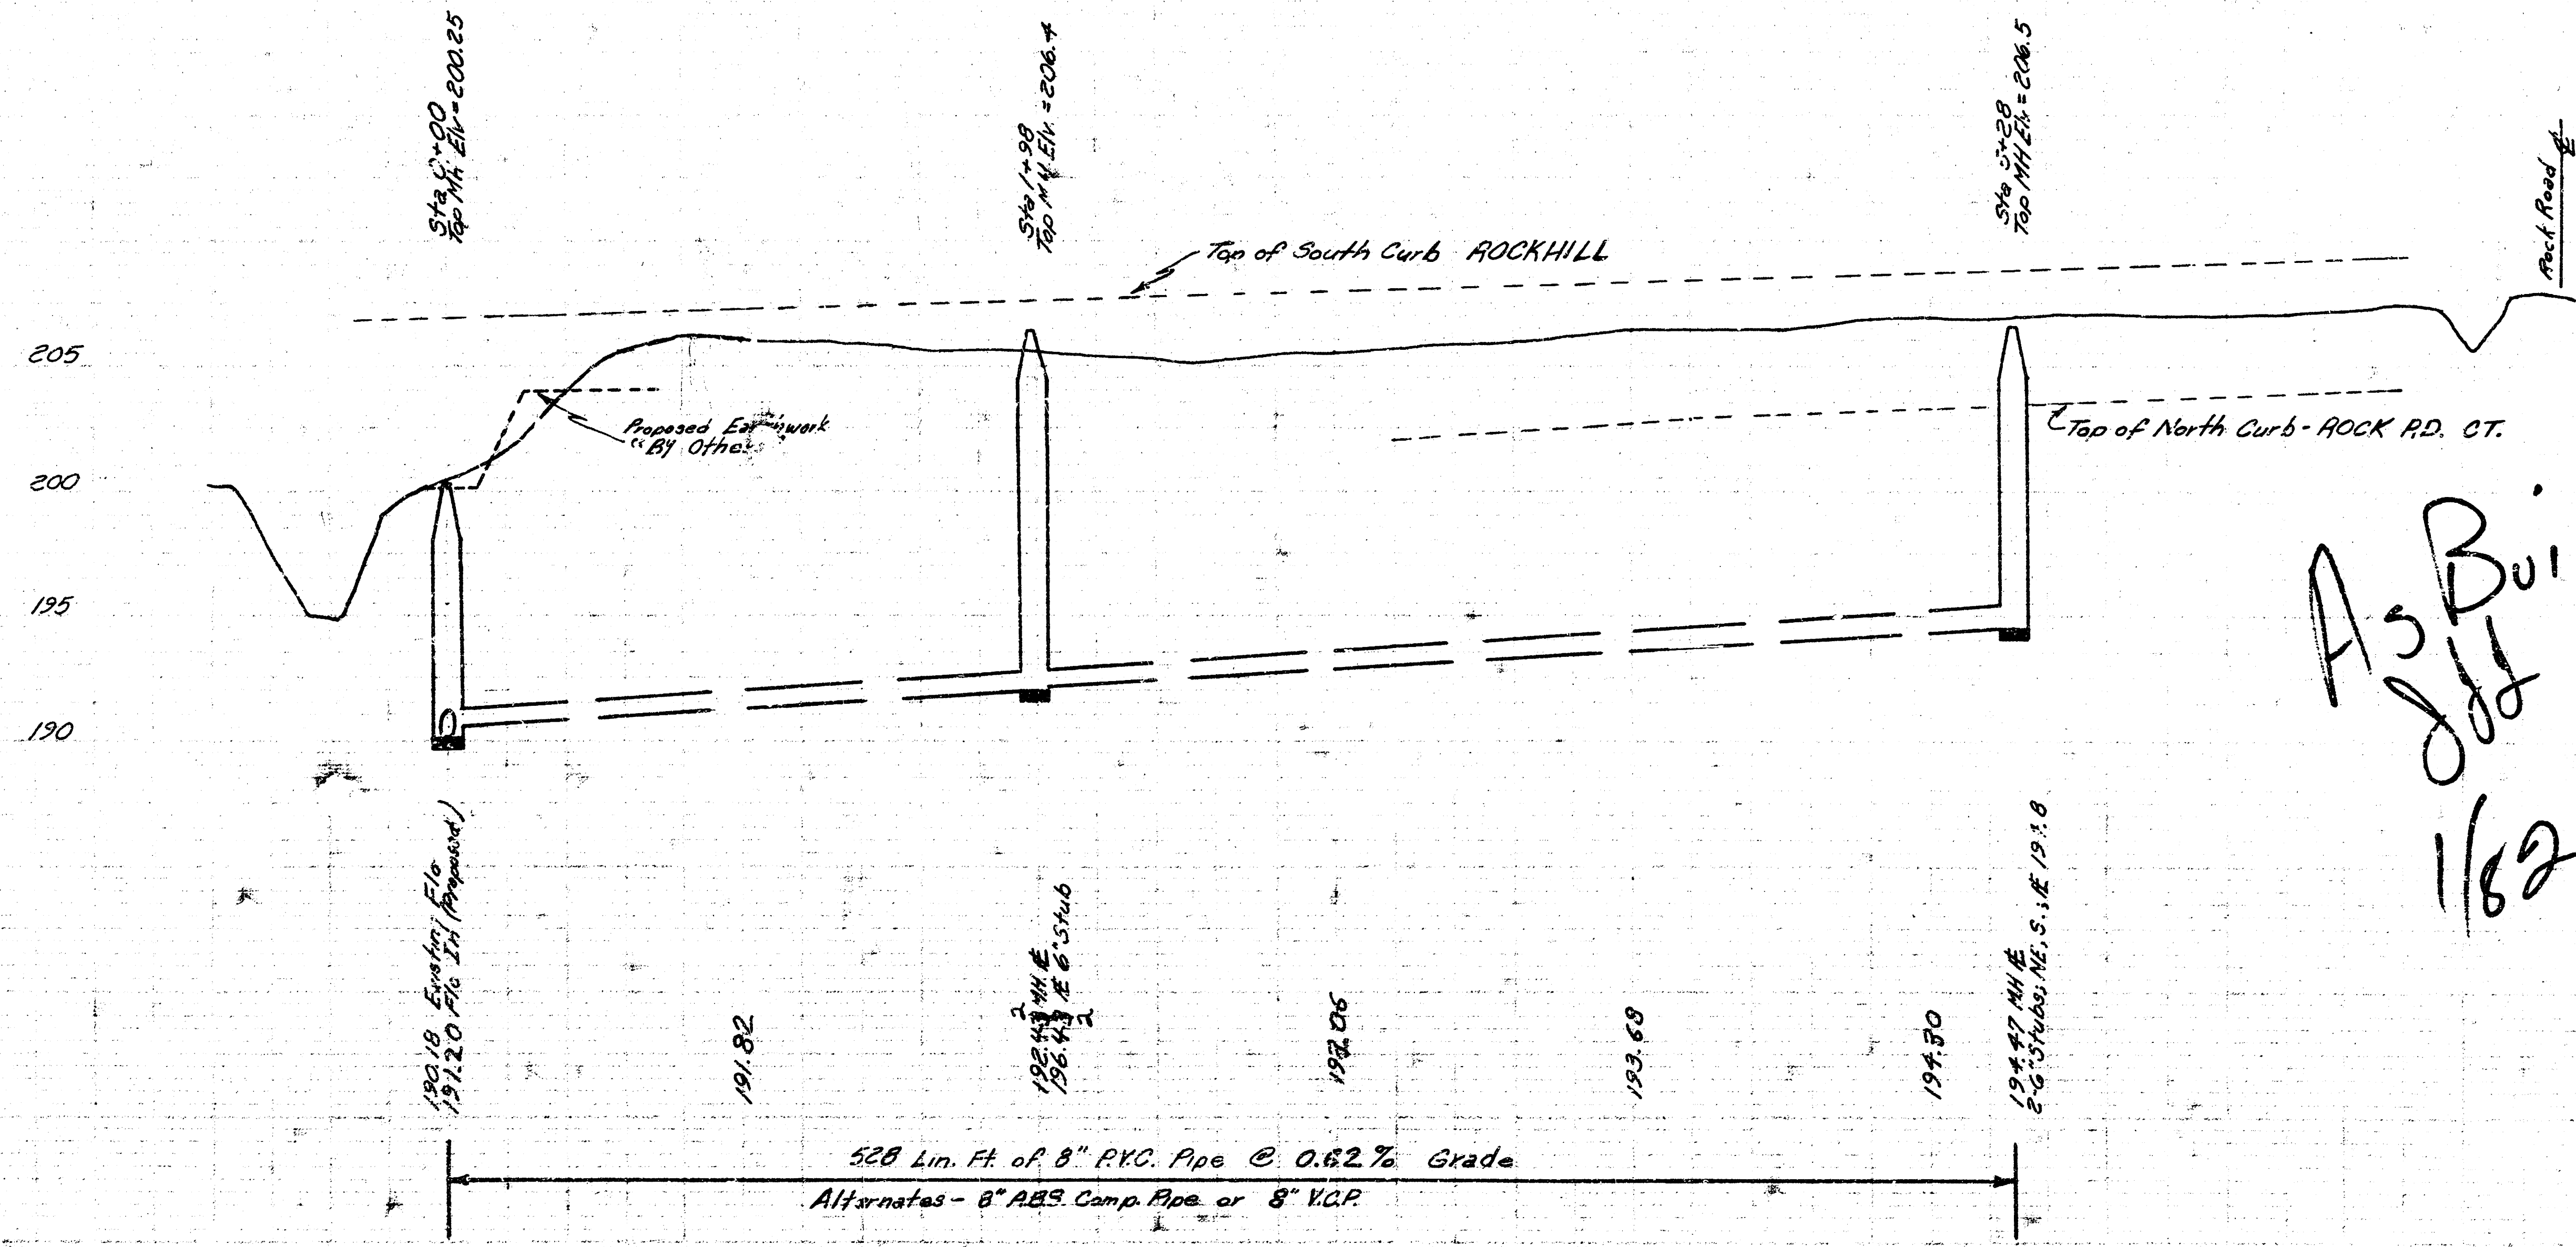
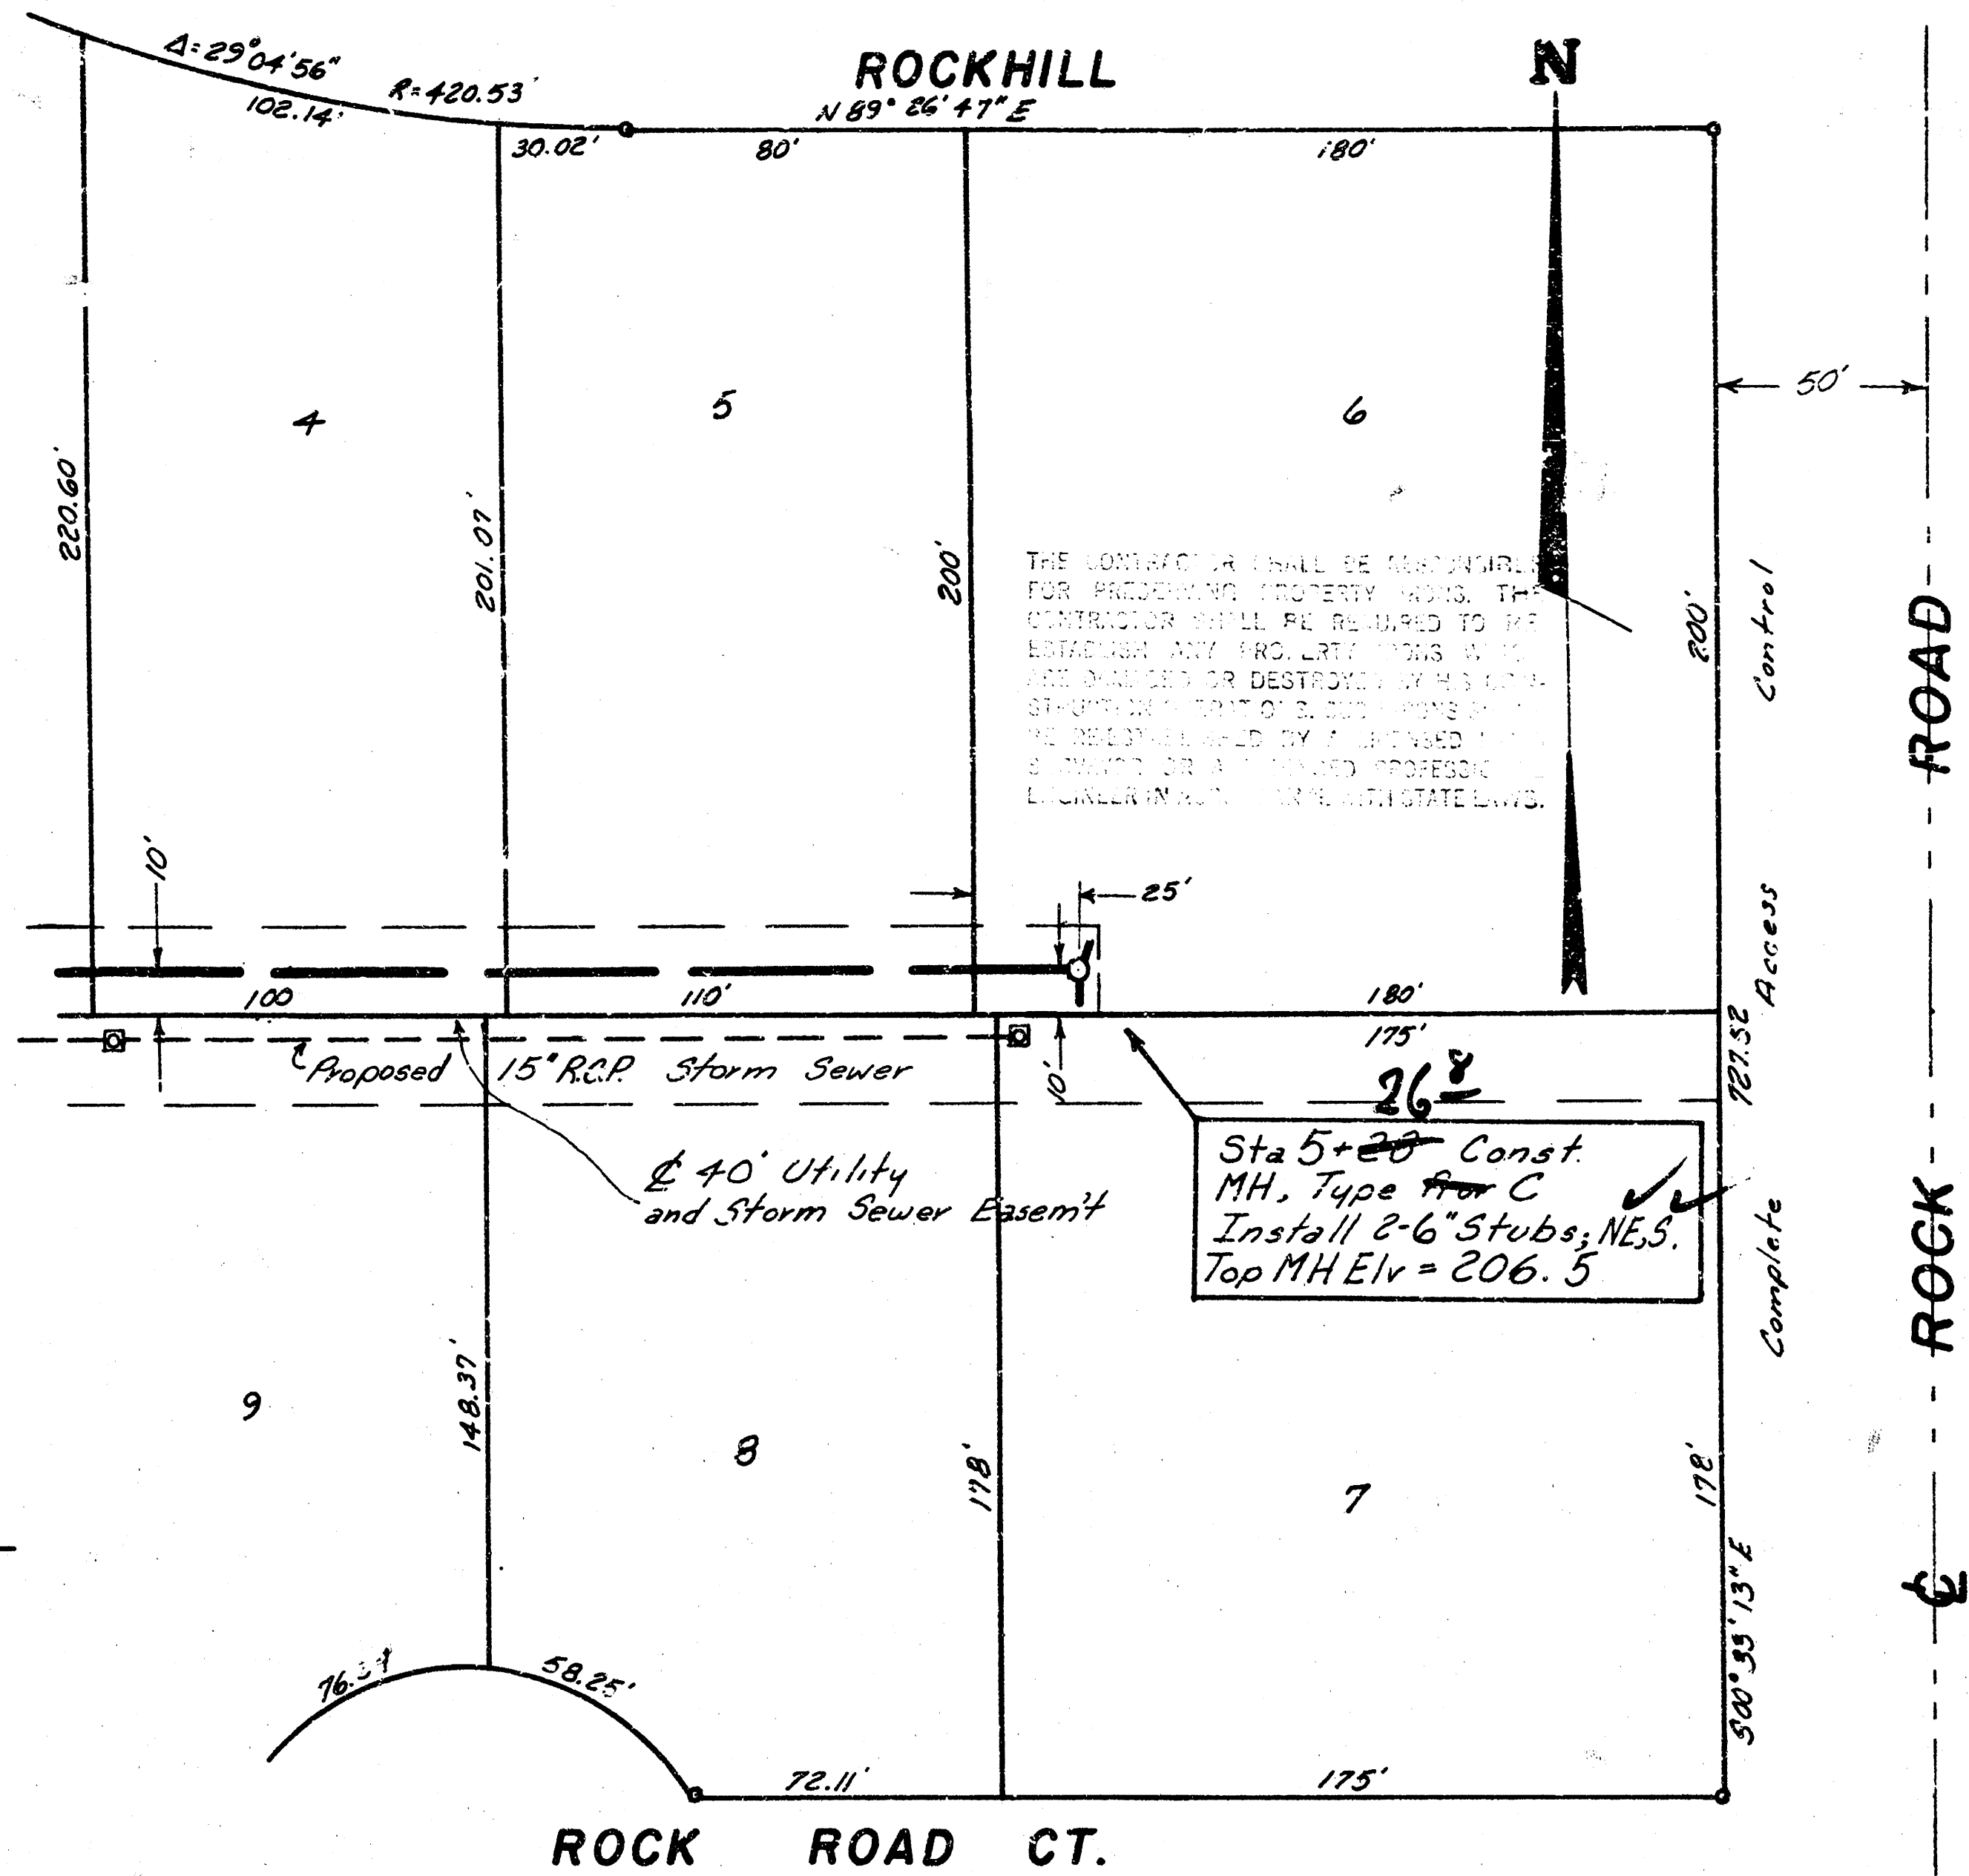


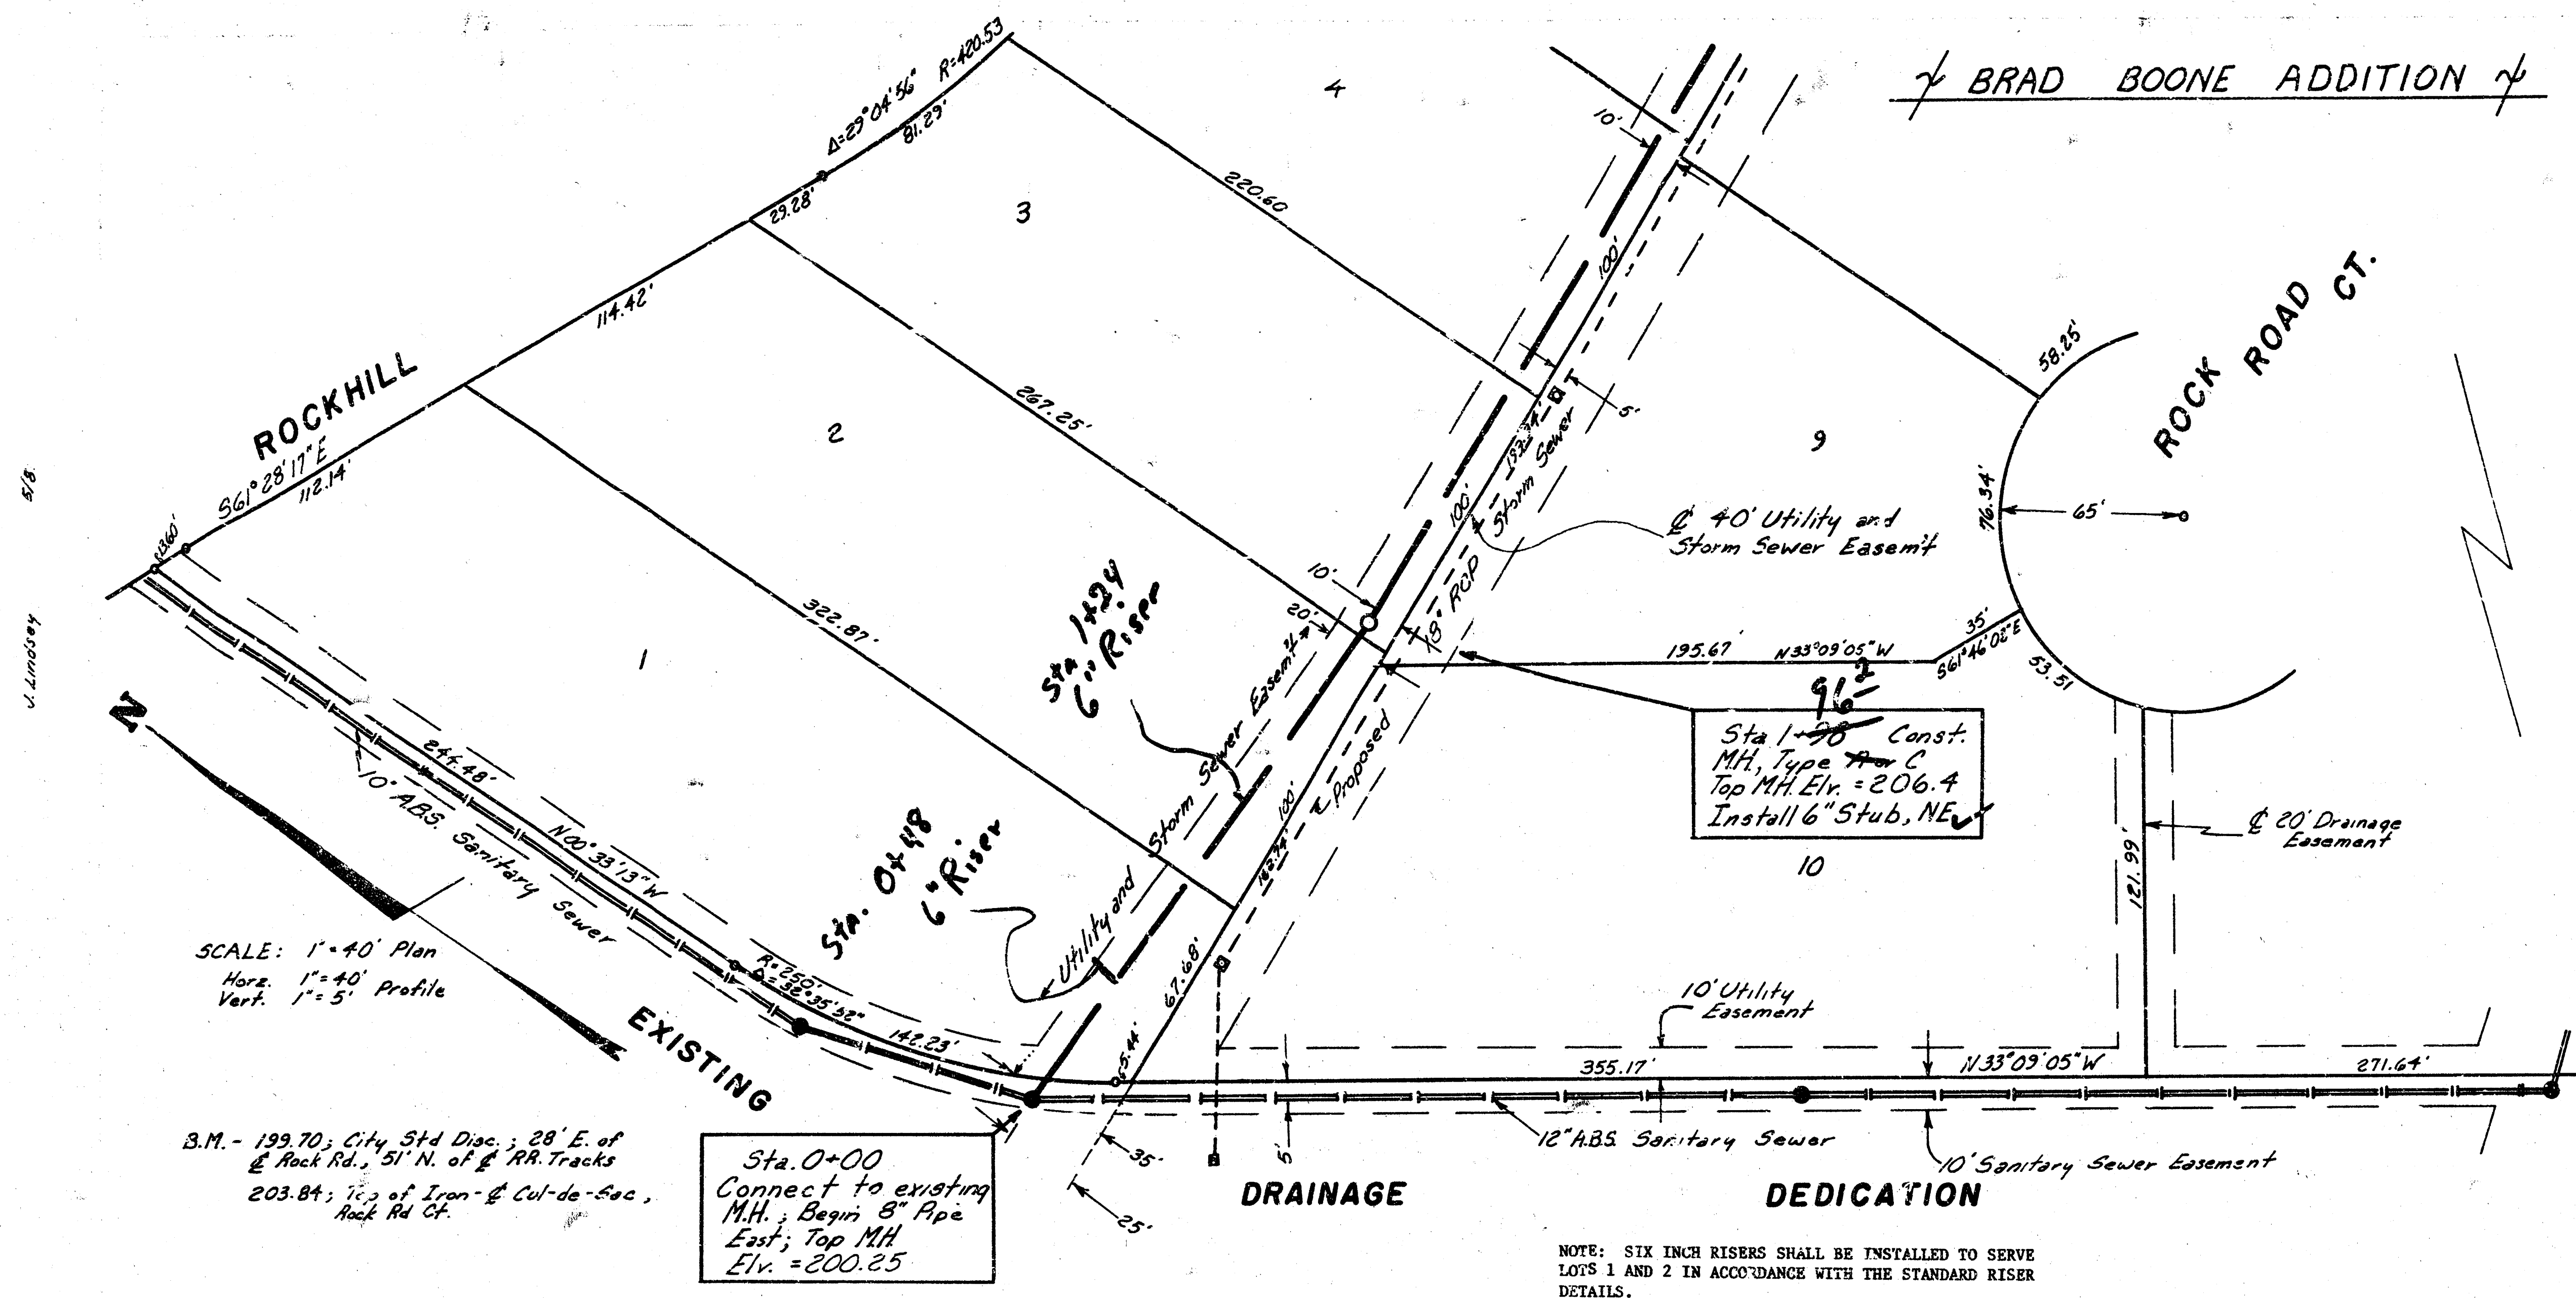

As Built
JH
1/82

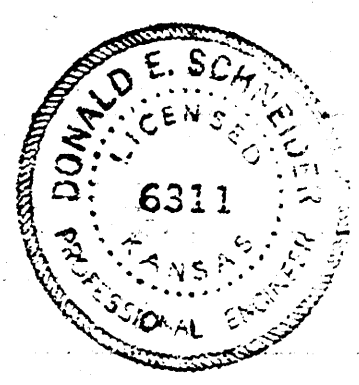

LAT. 16, MAIN 20, W.I.S.
CITY OF WICHITA, KANSAS
R.W. BRUGSEMAN
DIRECTOR OF ENGINEERING / CITY ENGINEER
PROJ. NO 468-76-245-81100-000-000-001

FILMED FROM THE BEST AVAILABLE COPY