


# CONSTRUCTION PLANS FOR LATERAL 13, MAIN 24 (PHASE 2) OF THE WAR INDUSTRIES SEWER IN

THE CITY OF WICHITA,  
SEDGWICK COUNTY, KANSAS  
MICHAEL E. LINDEBAK, P.E. - CITY ENGINEER

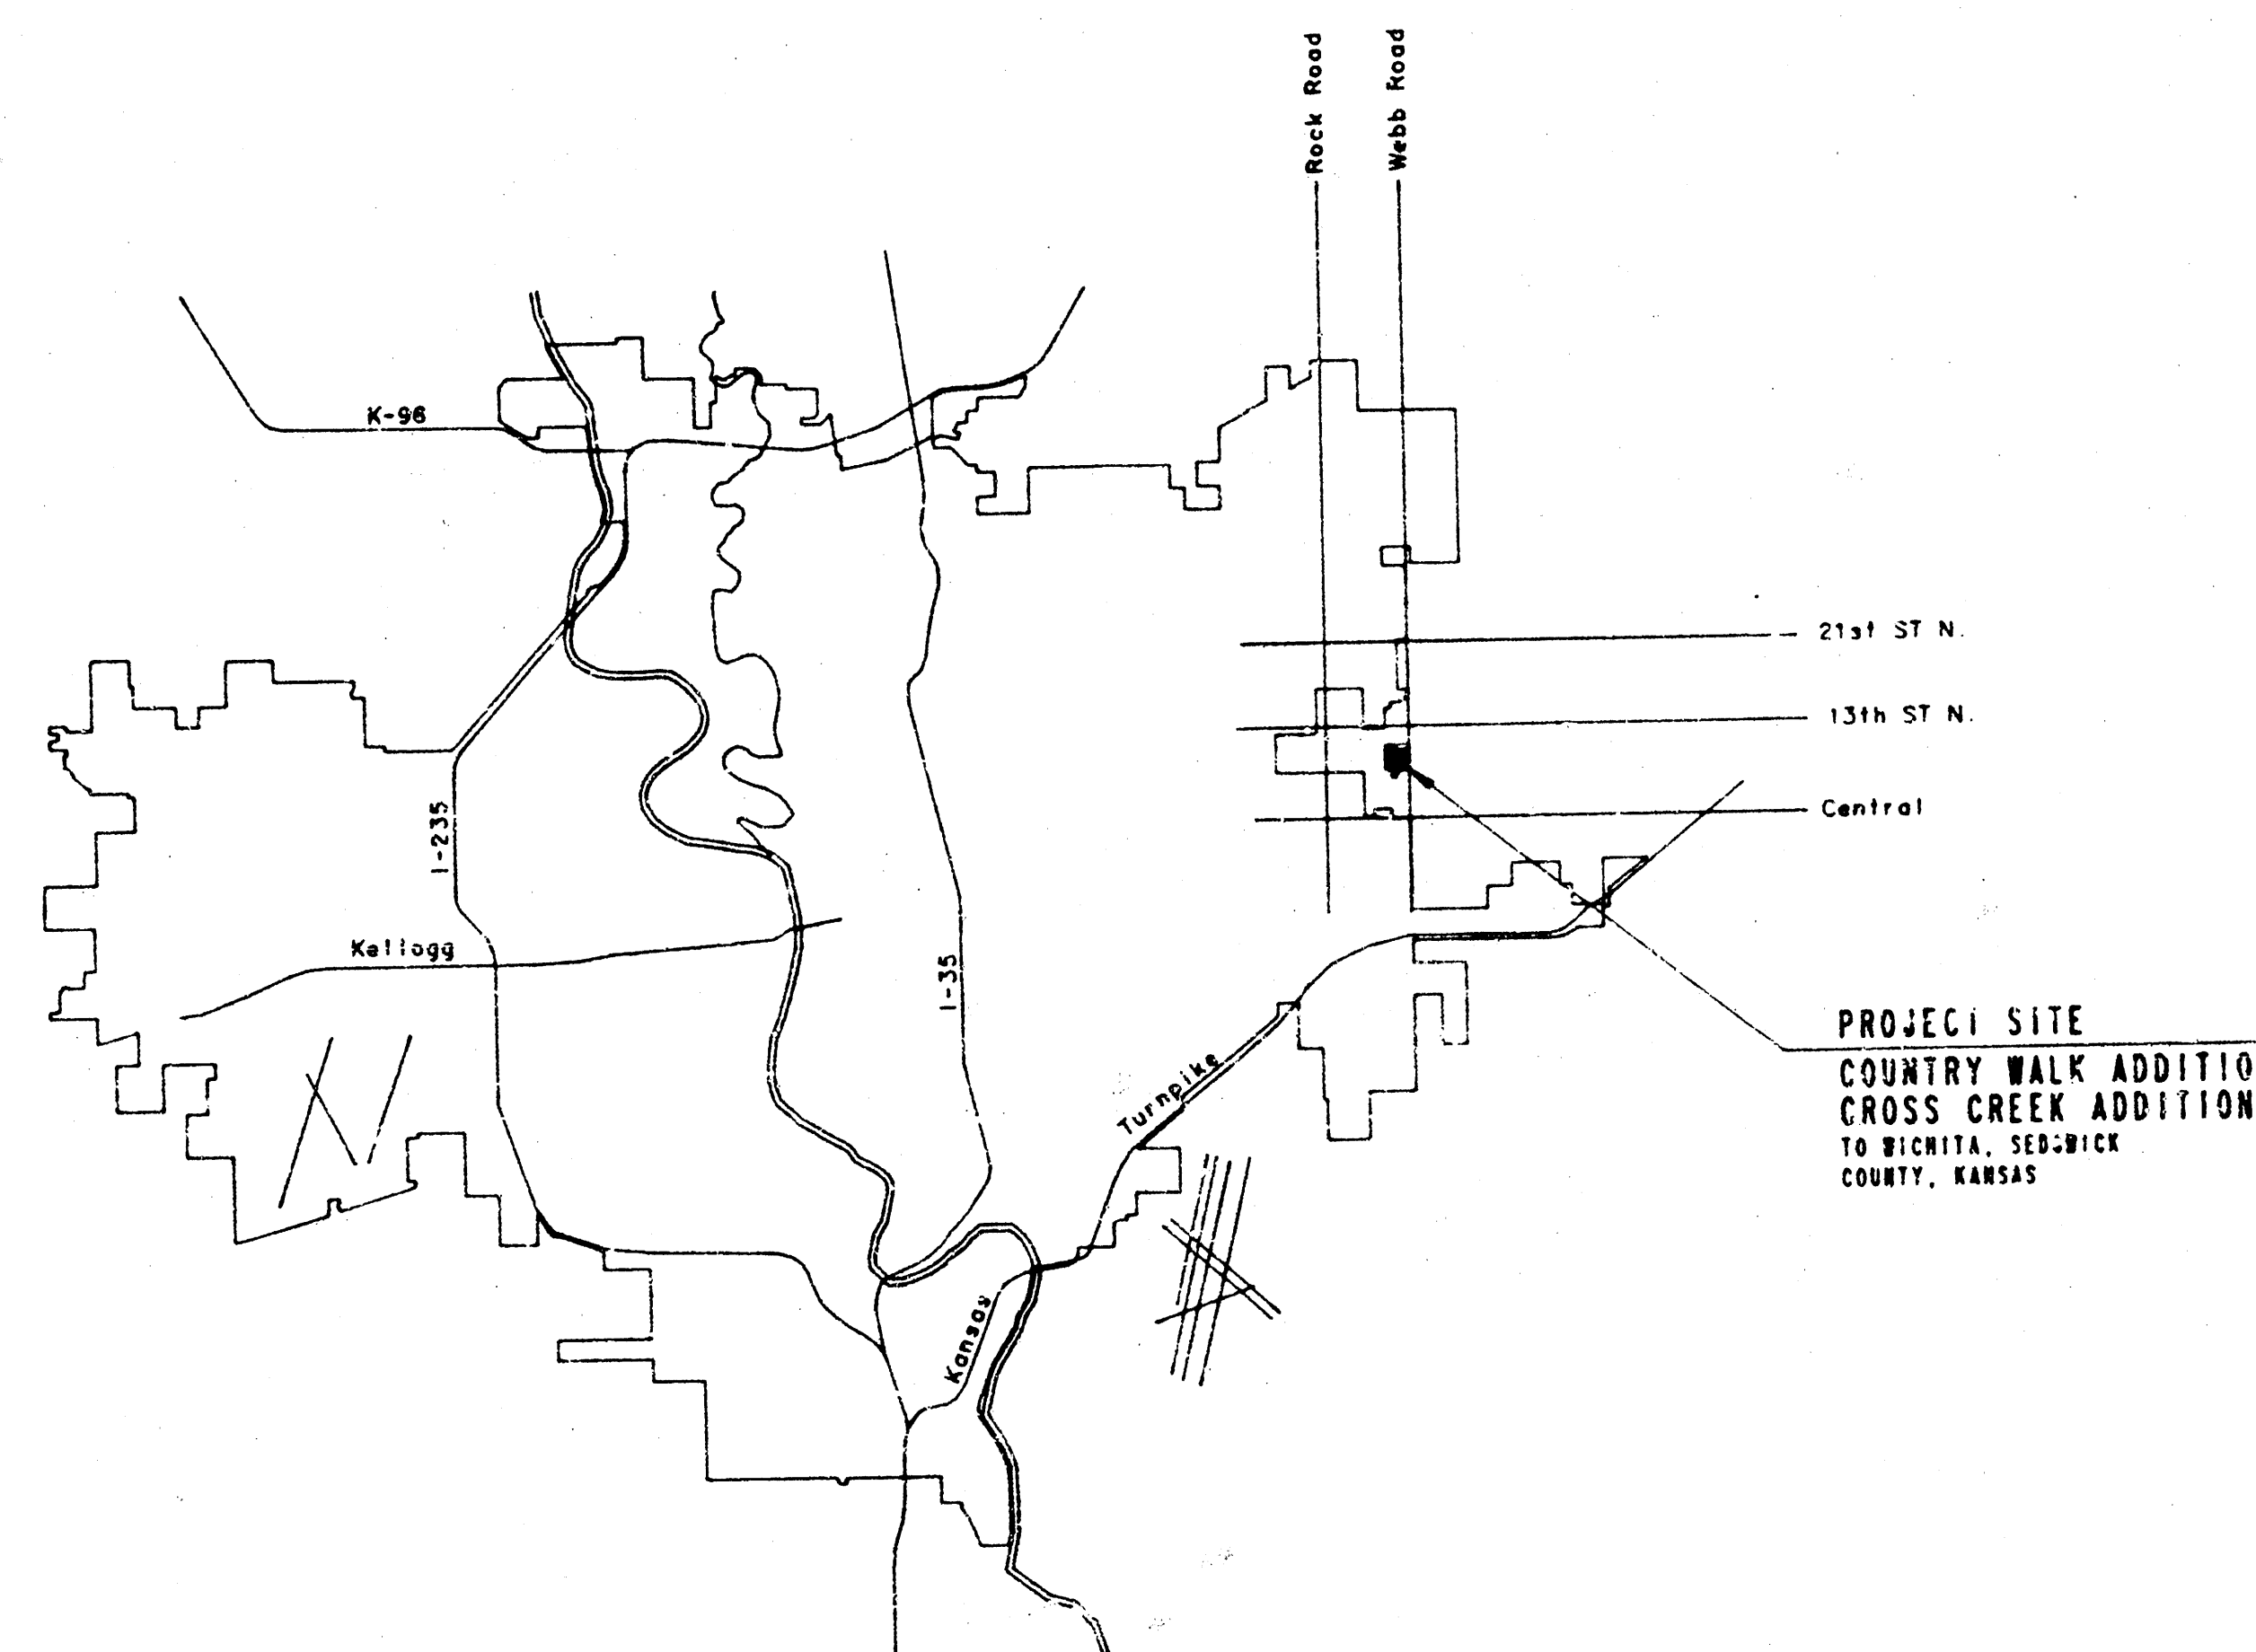

LOCATION MAP

## INDEX OF SHEETS


|                |                          |
|----------------|--------------------------|
| SHEET NO. 1    | TITLE SHEET              |
| SHEET NO. 2    | KEY MAP                  |
| SHEET NO. 3    | EASEMENT GRADING         |
| SHEET NO. 4-5  | PLAN                     |
| SHEET NO. 6-13 | PLAN/PROFILE             |
| SHEET NO. 14   | TYPE "P" MANHOLE DETAILS |
| SHEET NO. 15   | TYPE "D" MANHOLE DETAILS |
| SHEET NO. 16   | TYPE "C" MANHOLE DETAILS |
| SHEET NO. 17   | FRAME & COVER DETAIL     |
| SHEET NO. 18   | RISER DETAILS            |

CITY OF WICHITA PROJECT NO. 468-76-245-81807-000-000-001

**JANUARY, 1988**

PLANS PREPARED BY  
**PROFESSIONAL ENGINEERING CONSULTANTS, P.A.**  
ENGINEERS  
WICHITA, KANSAS

*BUILT AS PER PLAN  
12-88  
RCL*

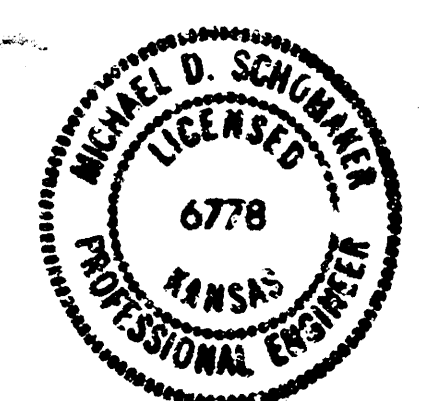


THESE PLANS REVISED  
APRIL 11, 1988 PER  
ADDENDUM NO. 1  
(SHEETS 1, 2, 3, 6, 7, 11,  
12 AND 13)







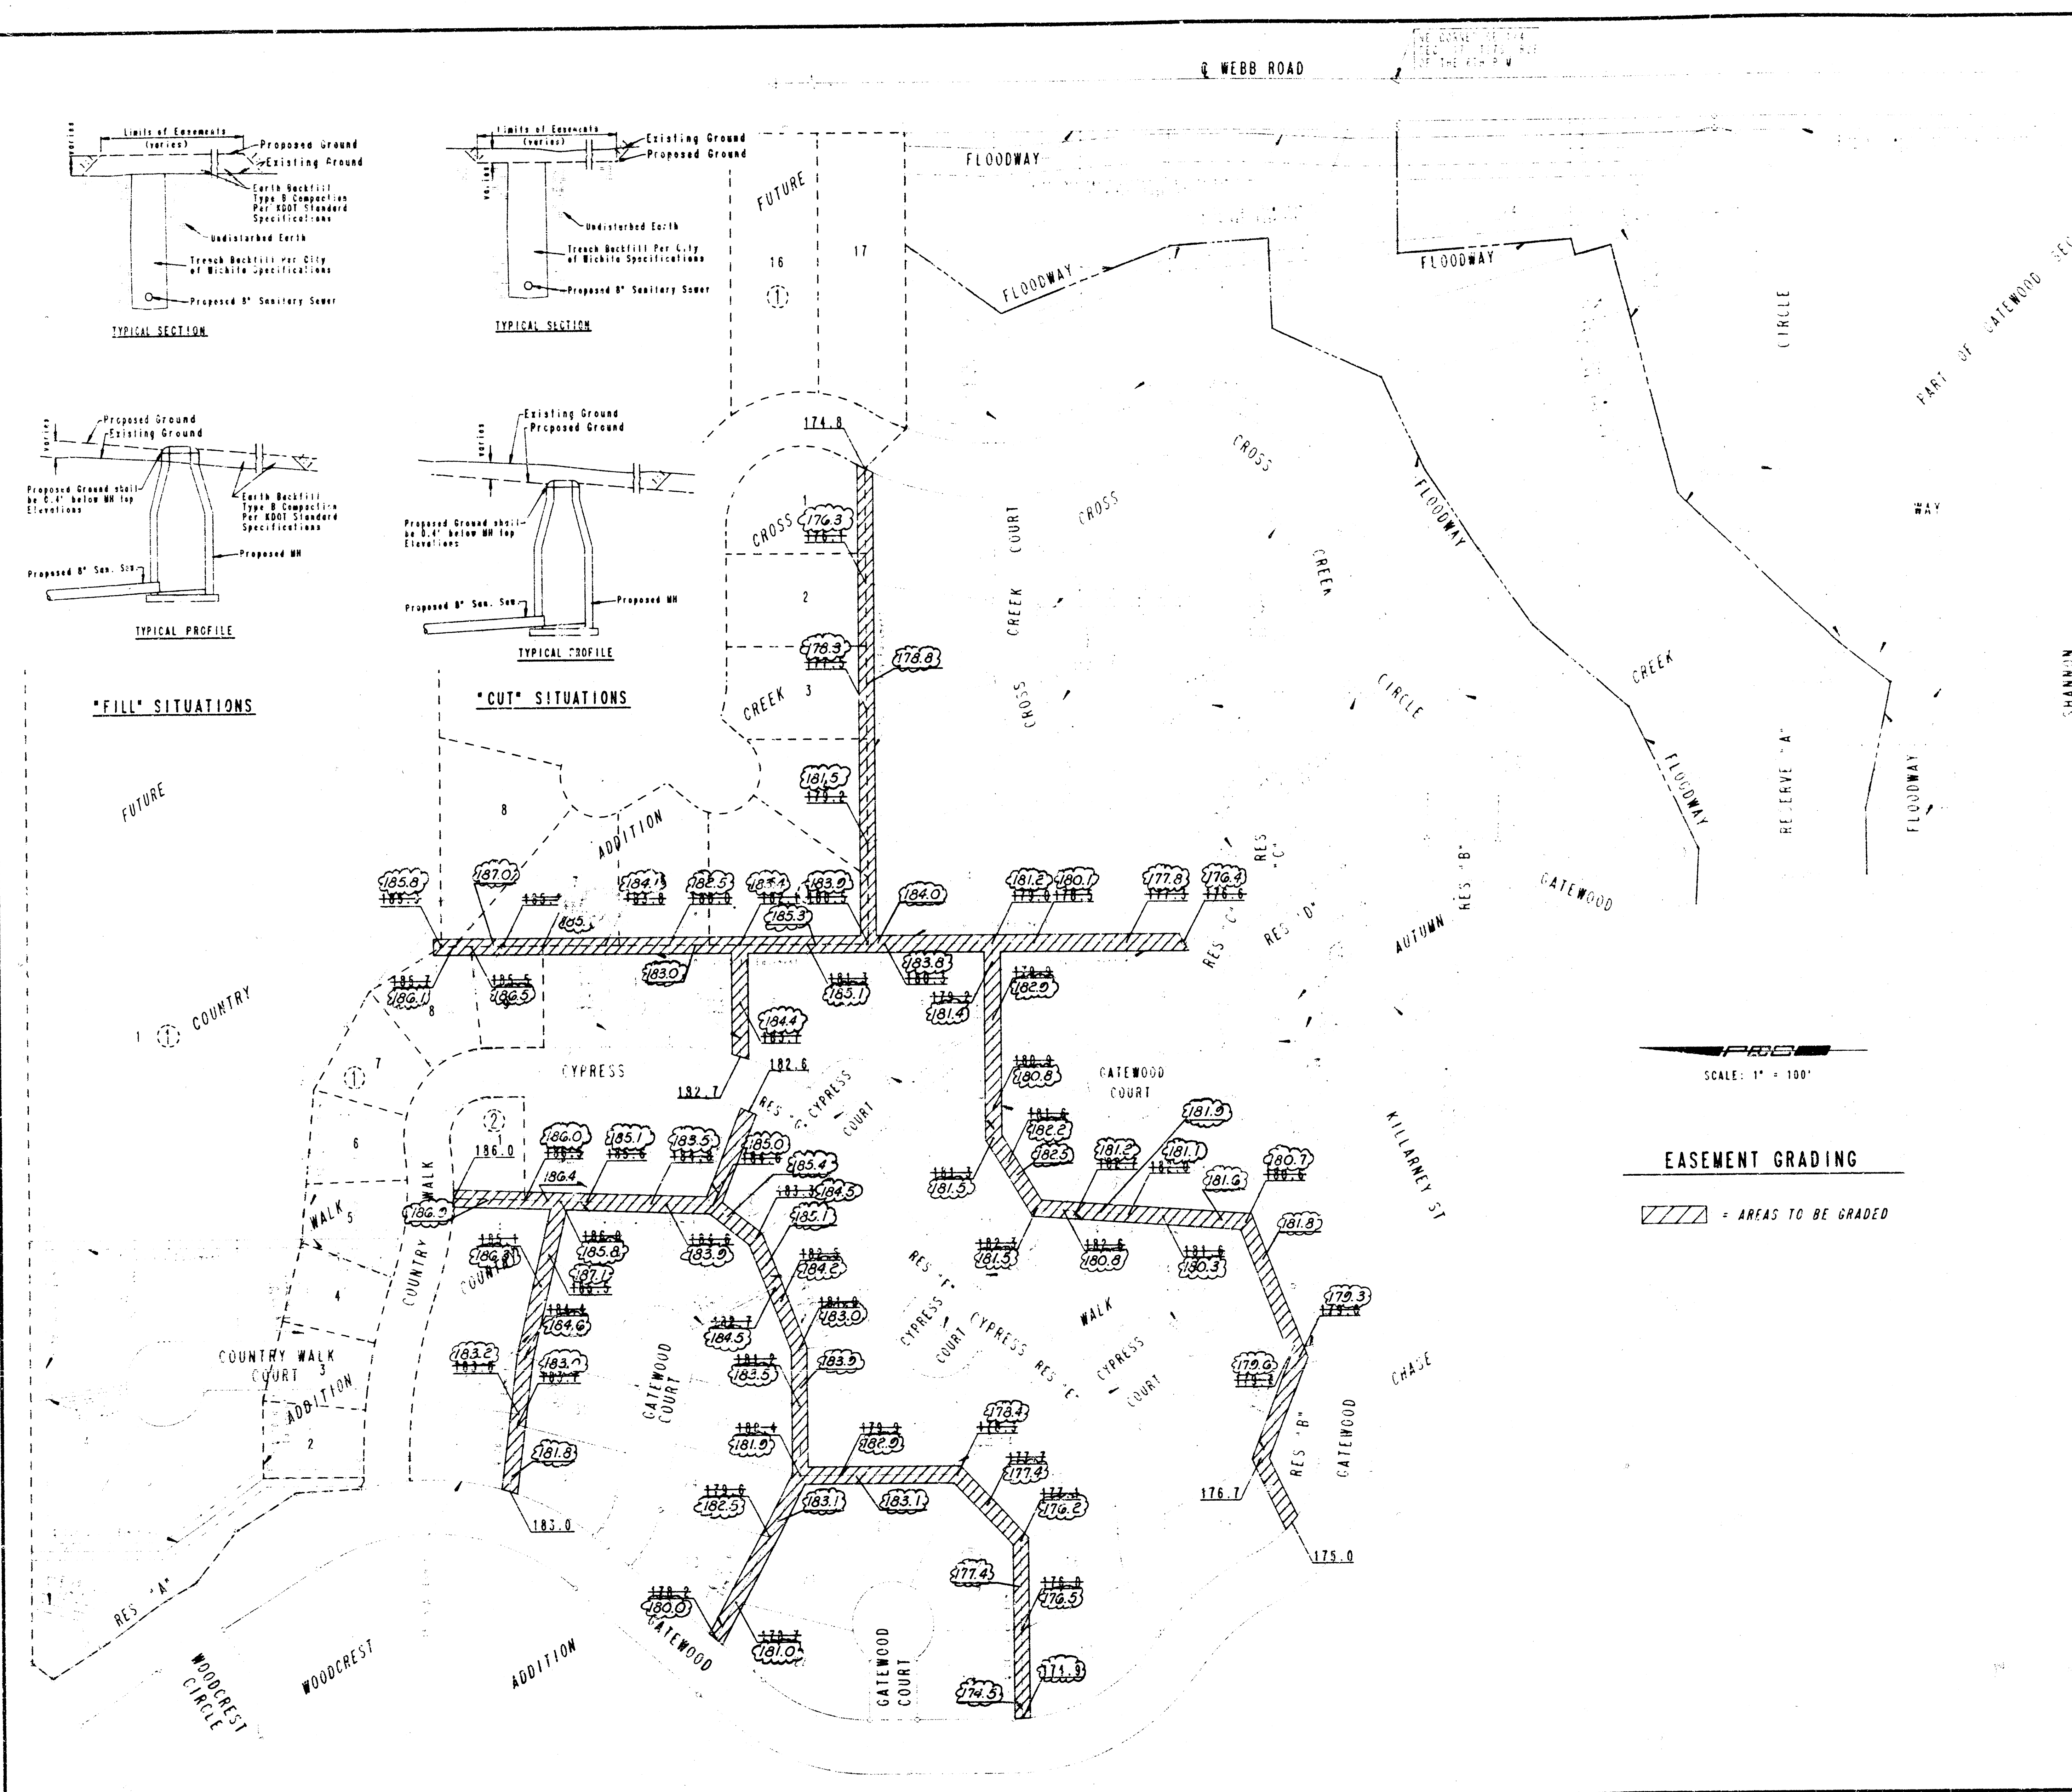

| M.H. # | Plan Elev. | Rev. Elev. | Raise | Lower |
|--------|------------|------------|-------|-------|
| 3      | 177.9      | 178.9      | 1.0'  |       |
| 4      | 180.8      | 184.4      | 3.6'  |       |
| 5      | 182.4      | 183.9      | 1.5'  |       |
| 7      | 184.4      | 185.4      | 1.0'  |       |
| 23     | 179.3      | 181.5      | 2.2'  |       |
| 26     | 182.8      | 181.8      |       | 1.0'  |
| 31     | 183.5      | 185.3      | 1.8'  |       |
| 32     | 182.2      | 183.5      | 1.3'  |       |
| 33     | 180.9      | 182.3      | 1.4'  |       |
| 34     | 179.0      | 181.2      | 2.2'  |       |
| 36     | 177.4      | 176.6      |       | 0.8'  |
| 39     | 184.0      | 183.2      |       | 0.8'  |

THIS SHEET REVISED  
APRIL 11, 1988 PER  
ADDENDUM NO. 1

|   |                                      |            |
|---|--------------------------------------|------------|
| 2 | Added Revised MH Top Elevation Table | GM 7-20-88 |
| 1 | Revised Easement Grading Elevations  | GM 7-20-88 |

LATERAL 13, MAIN 24 OF THE  
WAP INDUSTRIES SEWER

**EASEMENT GRADING**


MICHAEL E. LINDEMAN, P.E. - C.E. ENGINEER  
CITY OF WICHITA PROJECT NO. 468-76-245-81407-000-000-001

**PROFESSIONAL ENGINEERING CONSULTANTS, P.A.**  
ENGINEERS  
WICHITA, KANSAS

Designed by: MDS, CRJ      Job No. 34-87540-3      Sht. 3 of 18  
Drawn by: DMW, GM      Date: JANUARY, 1988

FILMED FROM THE BEST  
AVAILABLE COPY



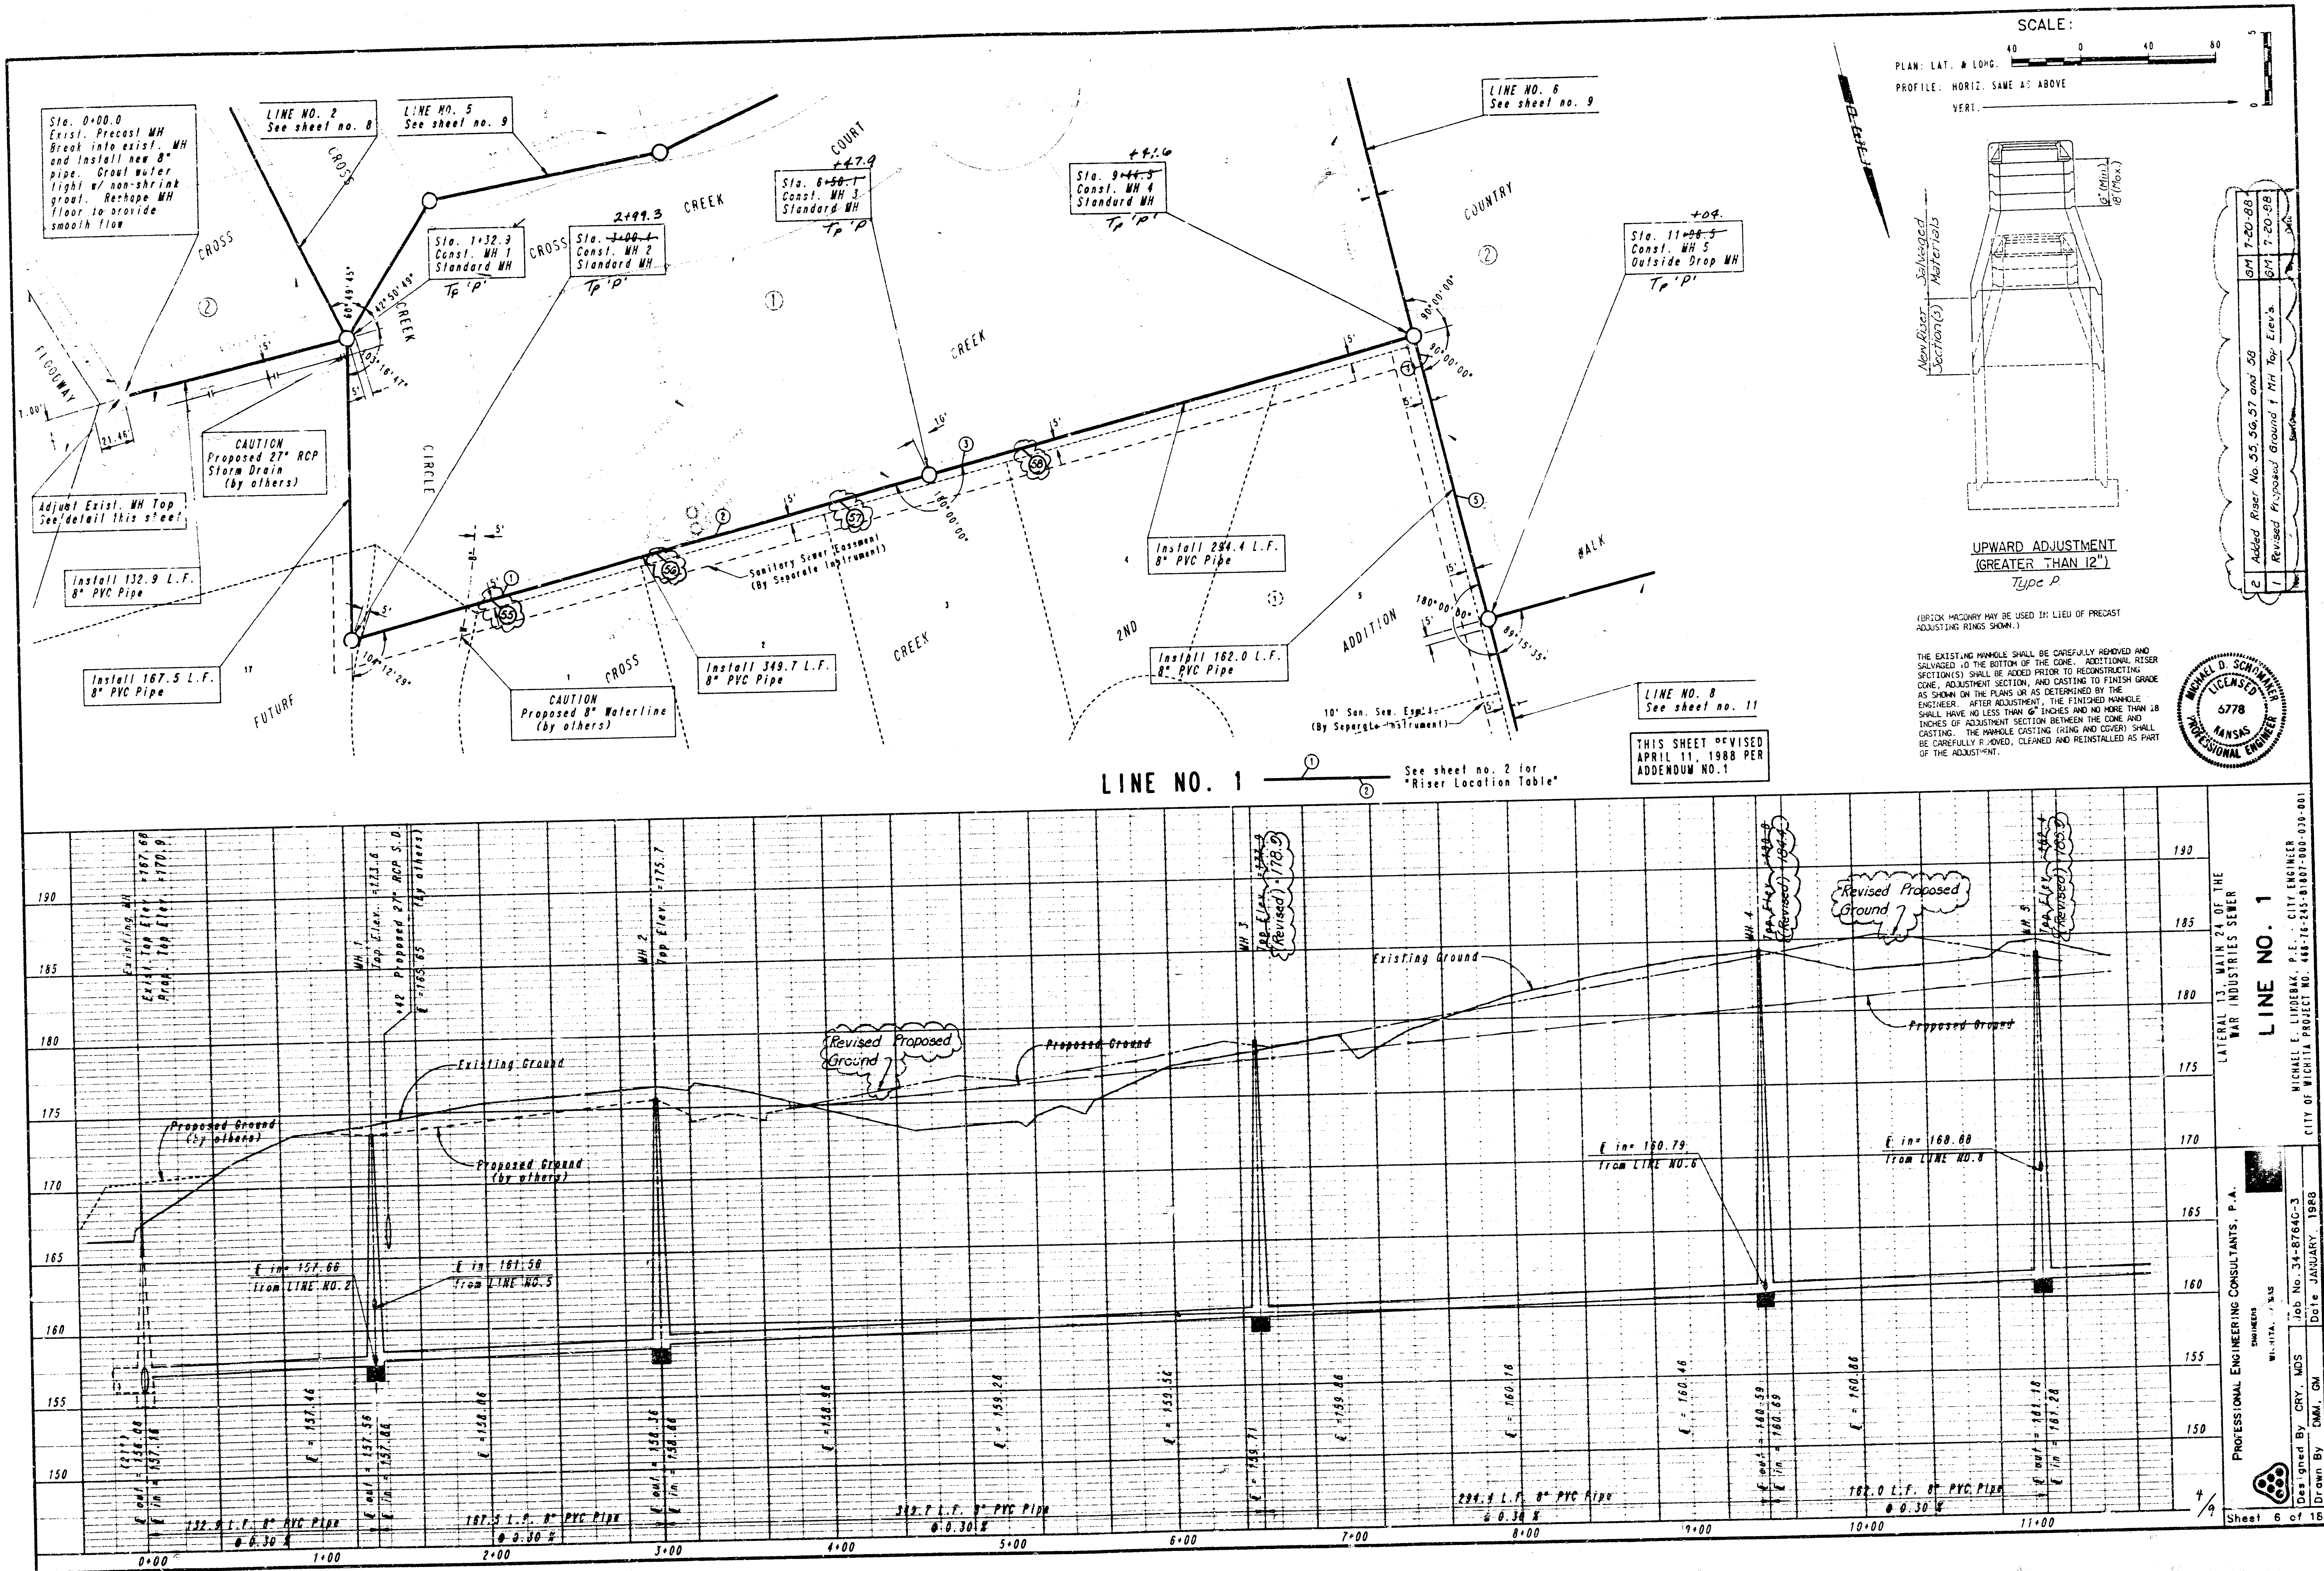

FILMED FROM THE BEST  
AVAILABLE COPY....












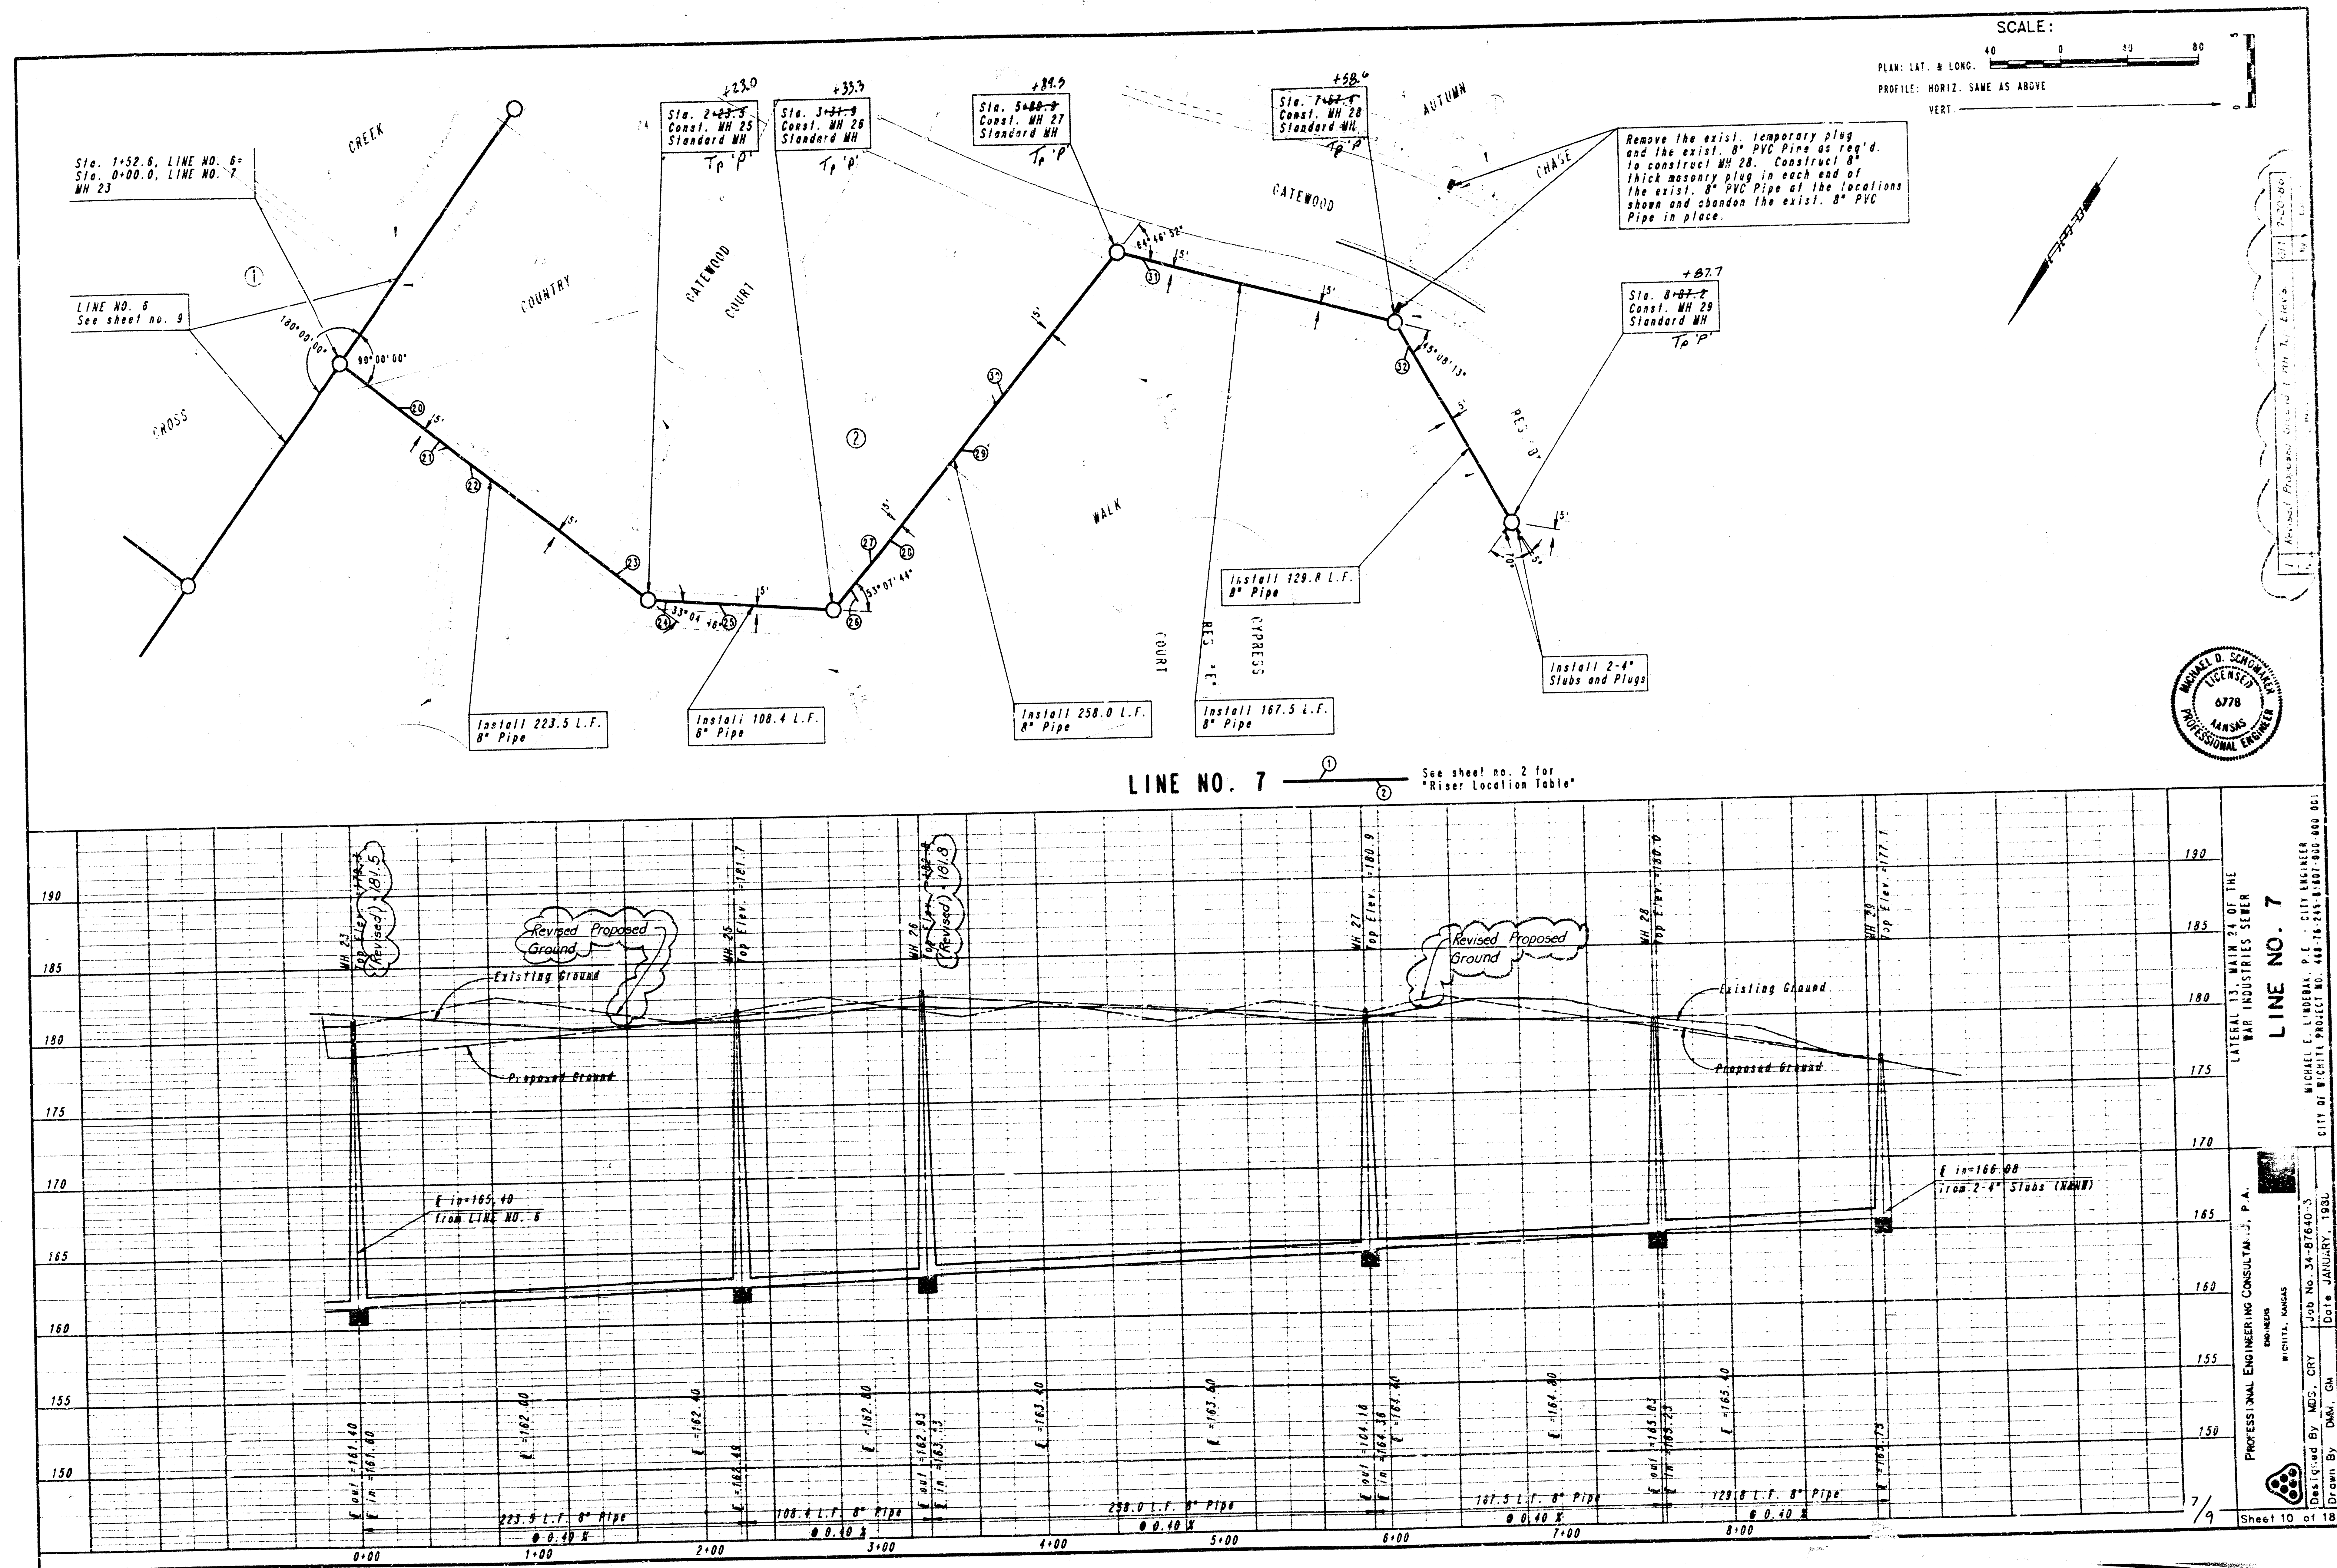


FILMED FROM THE BEST  
AVAILABLE COPY....







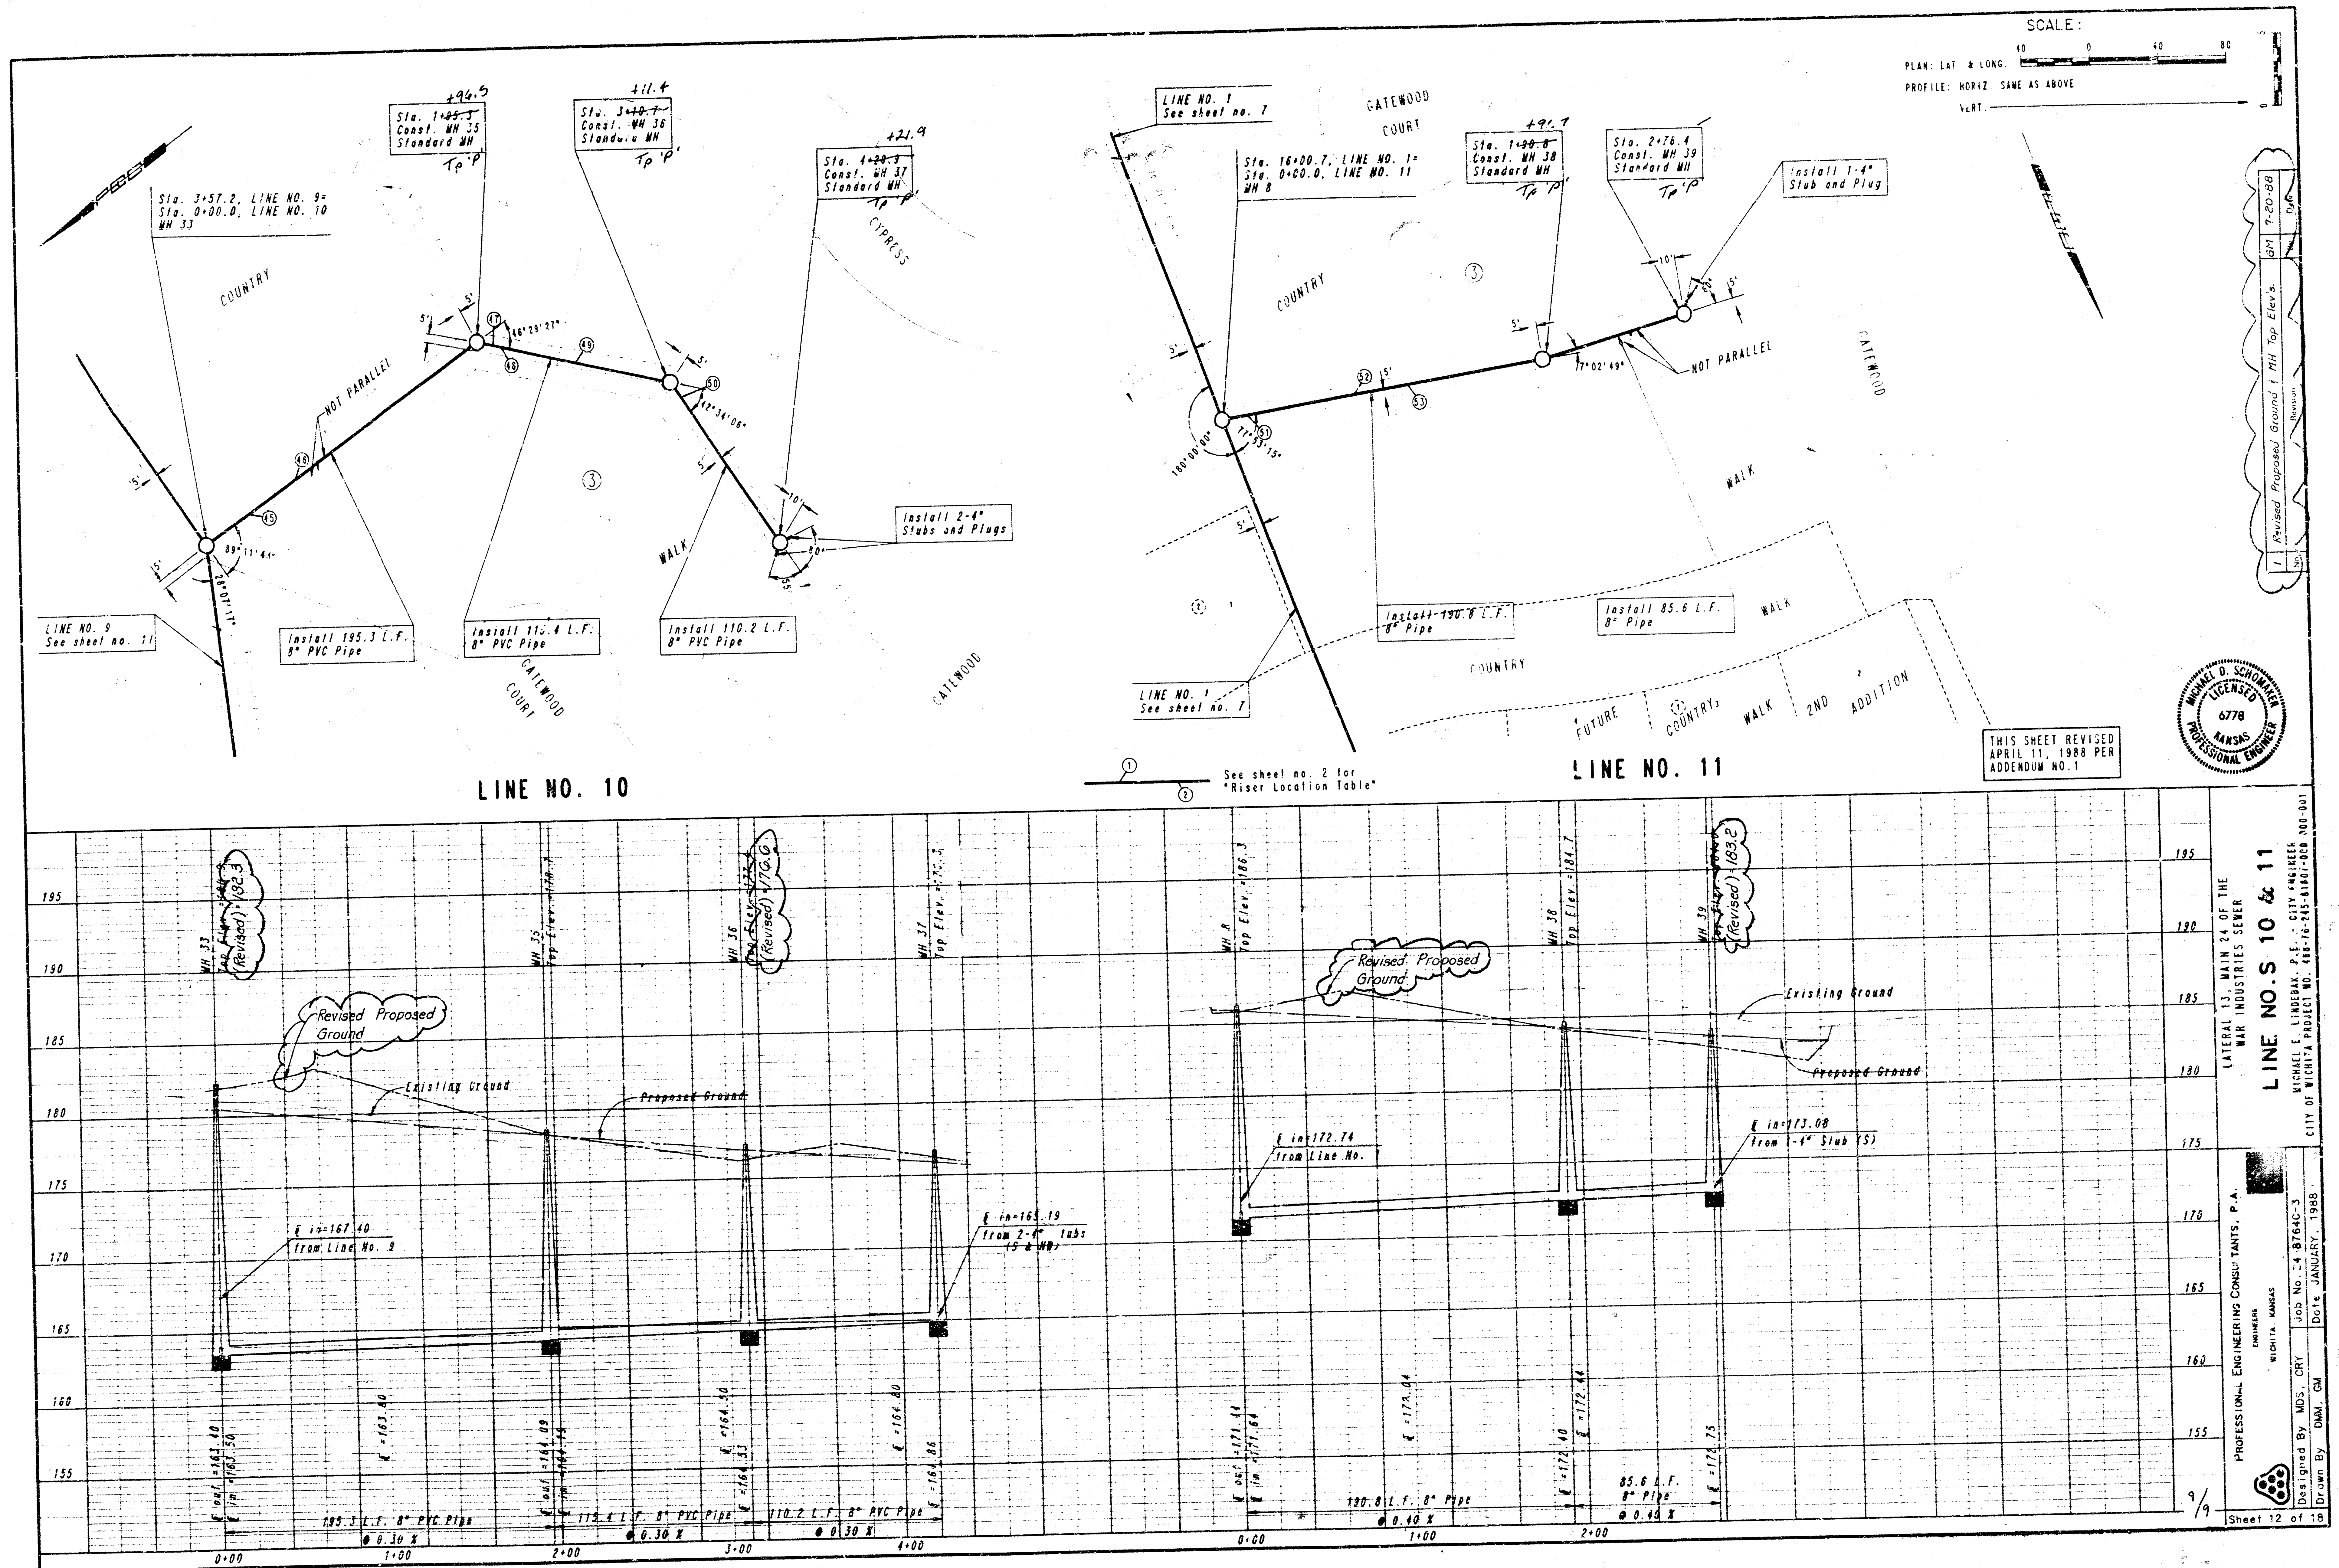

FILMED FROM THE BEST AVAILABLE COPY