



B.M. 172.47 R.R. Spike in West side of power pole approximately 200 ft. Northeast of corner of Lori Lane and Chalet Drive.
 B.M. 151.35 East side of manhole ring approximately 120 ft. East and 600 ft. North of the Property Iron on the Northeast corner
 of the intersection of Mt. Vernon and Lori Lane.

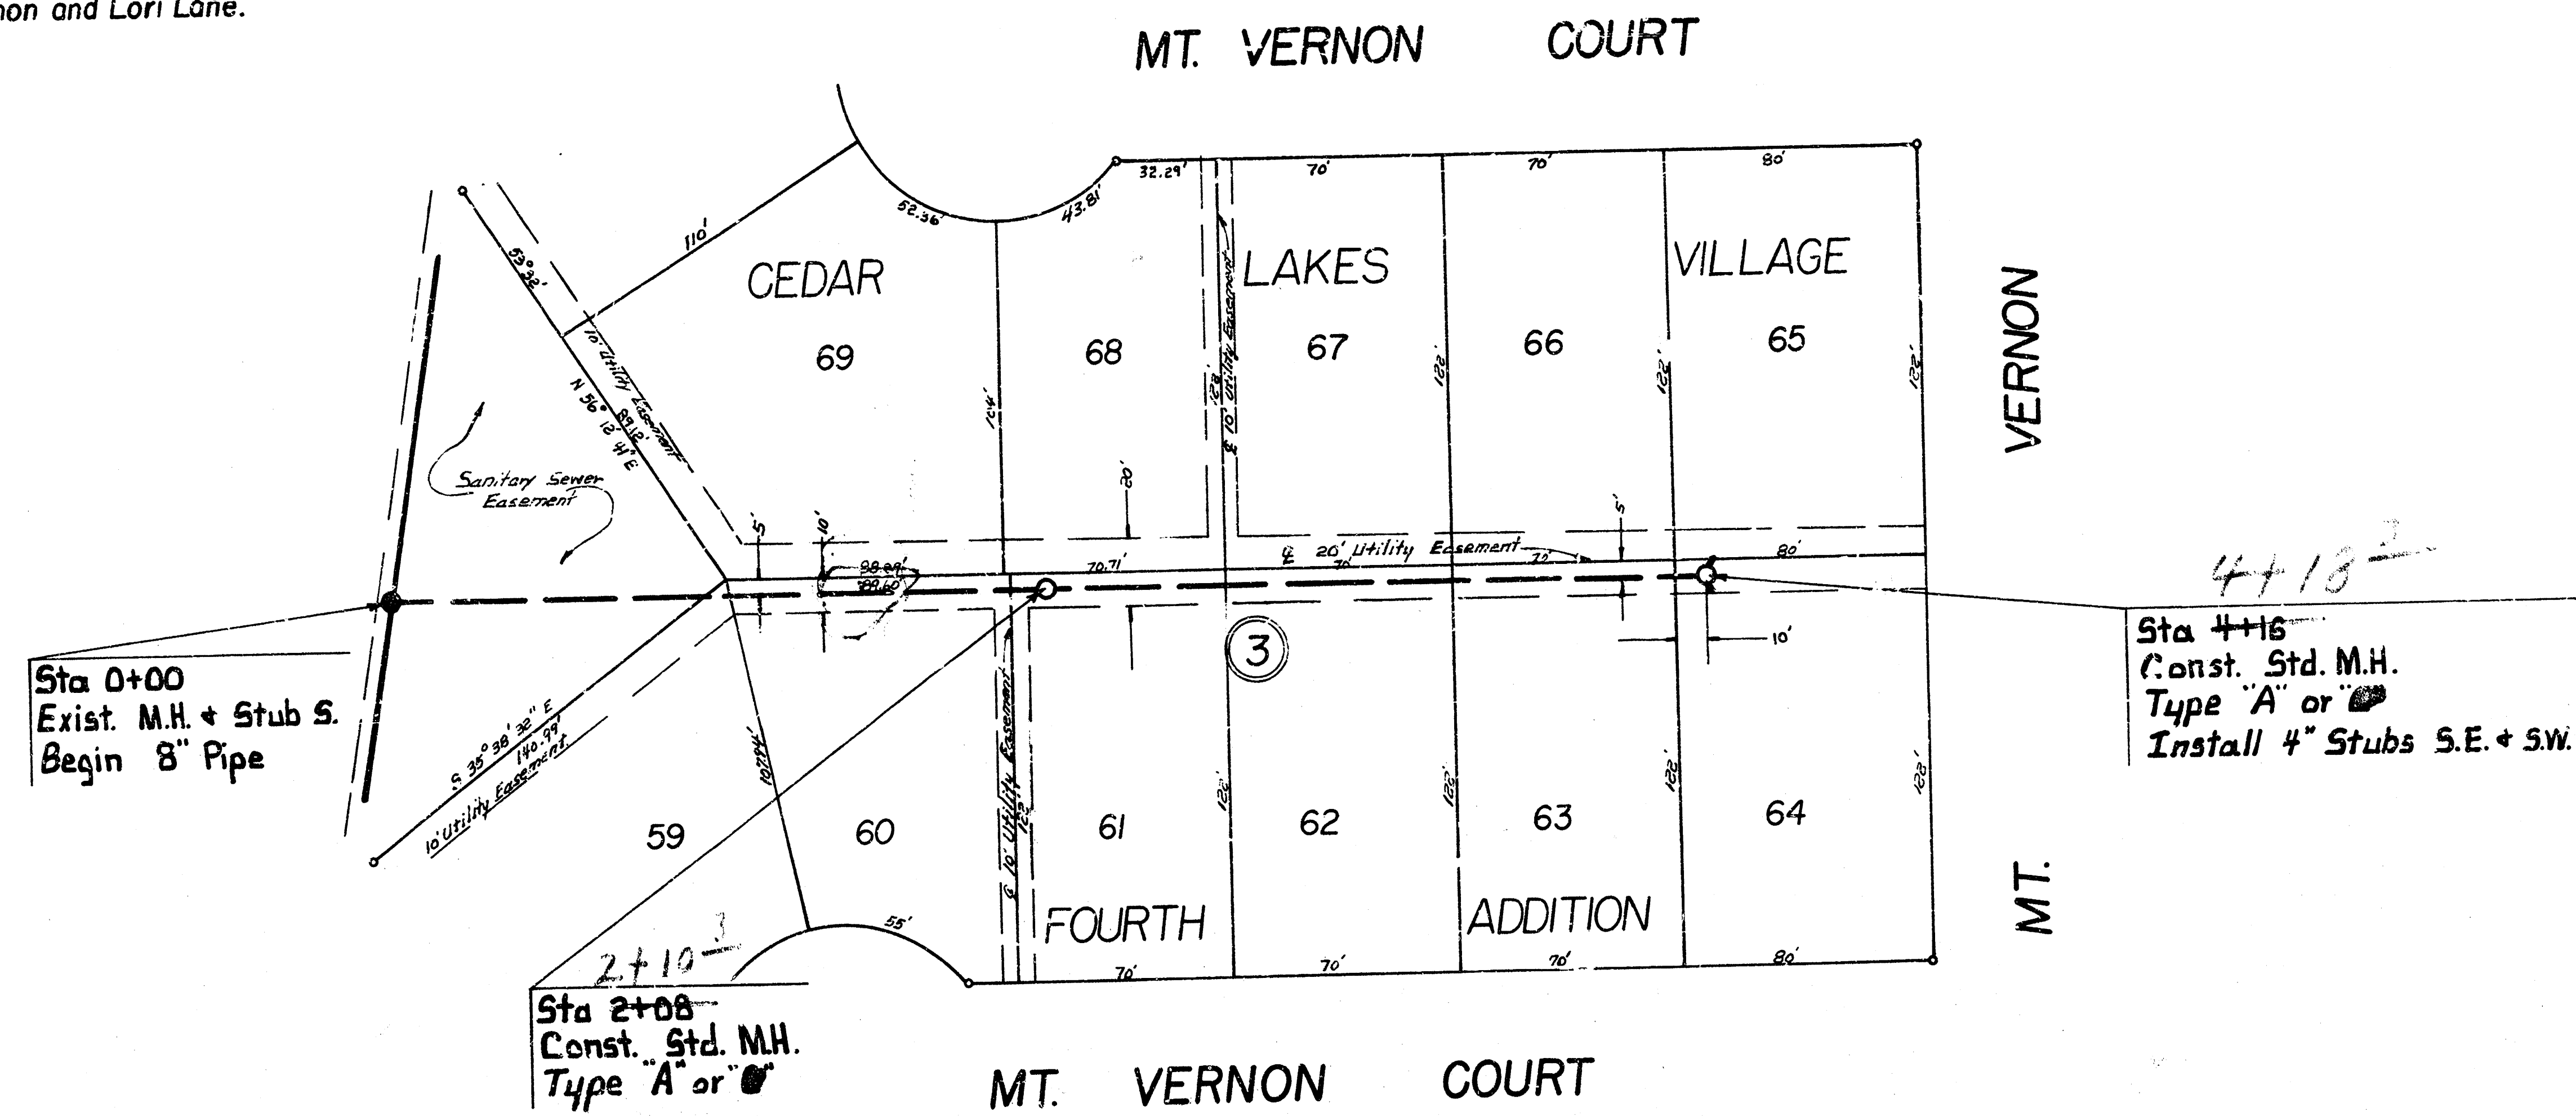

Plan Scale 1" = 40'
 Profile Scale 1" = 40' Horiz.
 1" = 5' Vert.

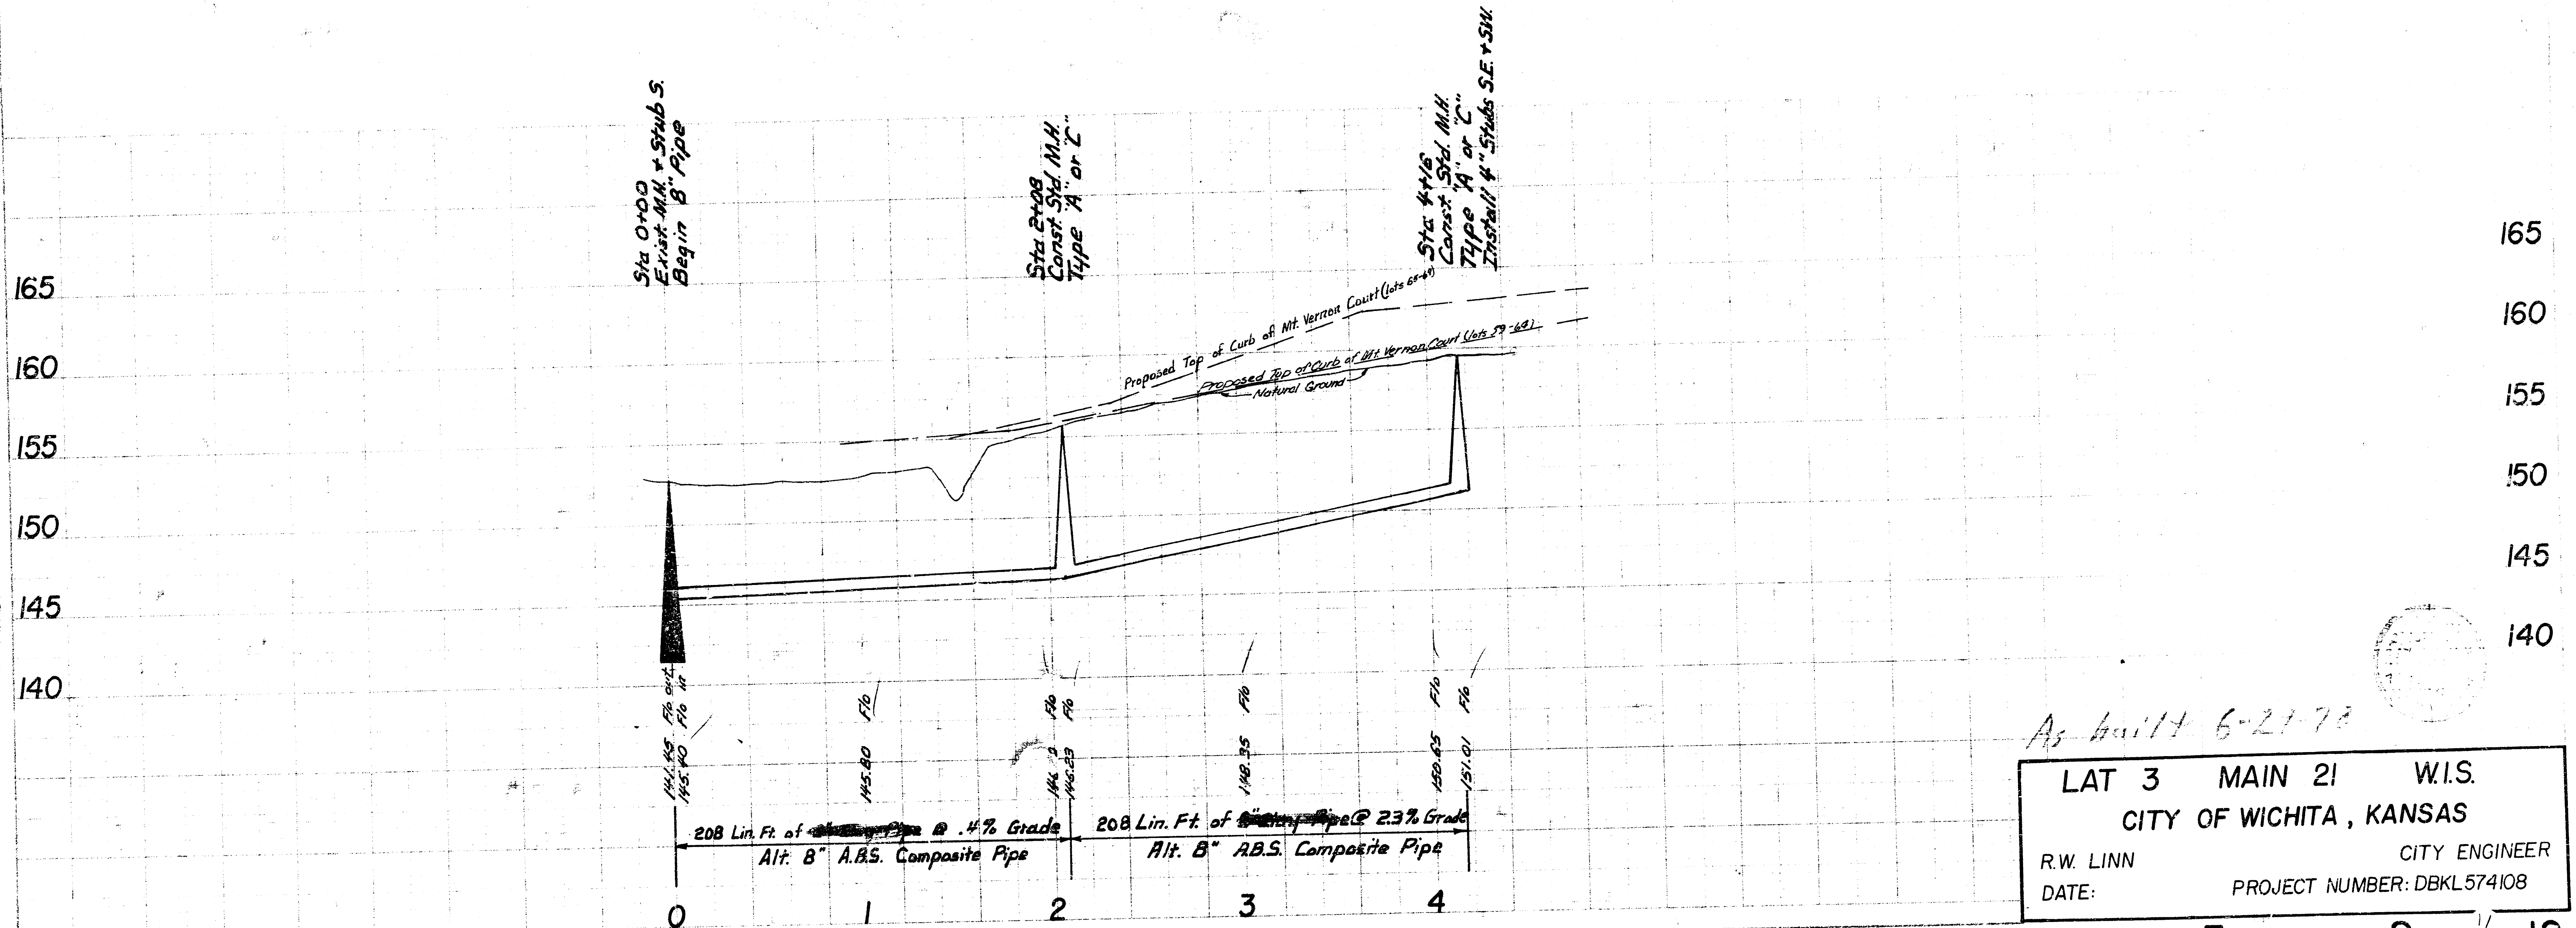

As built 6-21-78
 LAT 3 MAIN 21 W.I.S.
 CITY OF WICHITA, KANSAS
 R.W. LINN CITY ENGINEER
 DATE: PROJECT NUMBER: DBKL574108

Steve Palmer Sep 77
 Plate 1
 4878