


LATERAL 1, MAIN 13, S.W. INTERCEPTOR

PROJECT NO.

468-76-245-80941-000-000-001

CITY OF WICHITA, KANSAS

DEAN SELLERS, ACTING CITY ENGINEER

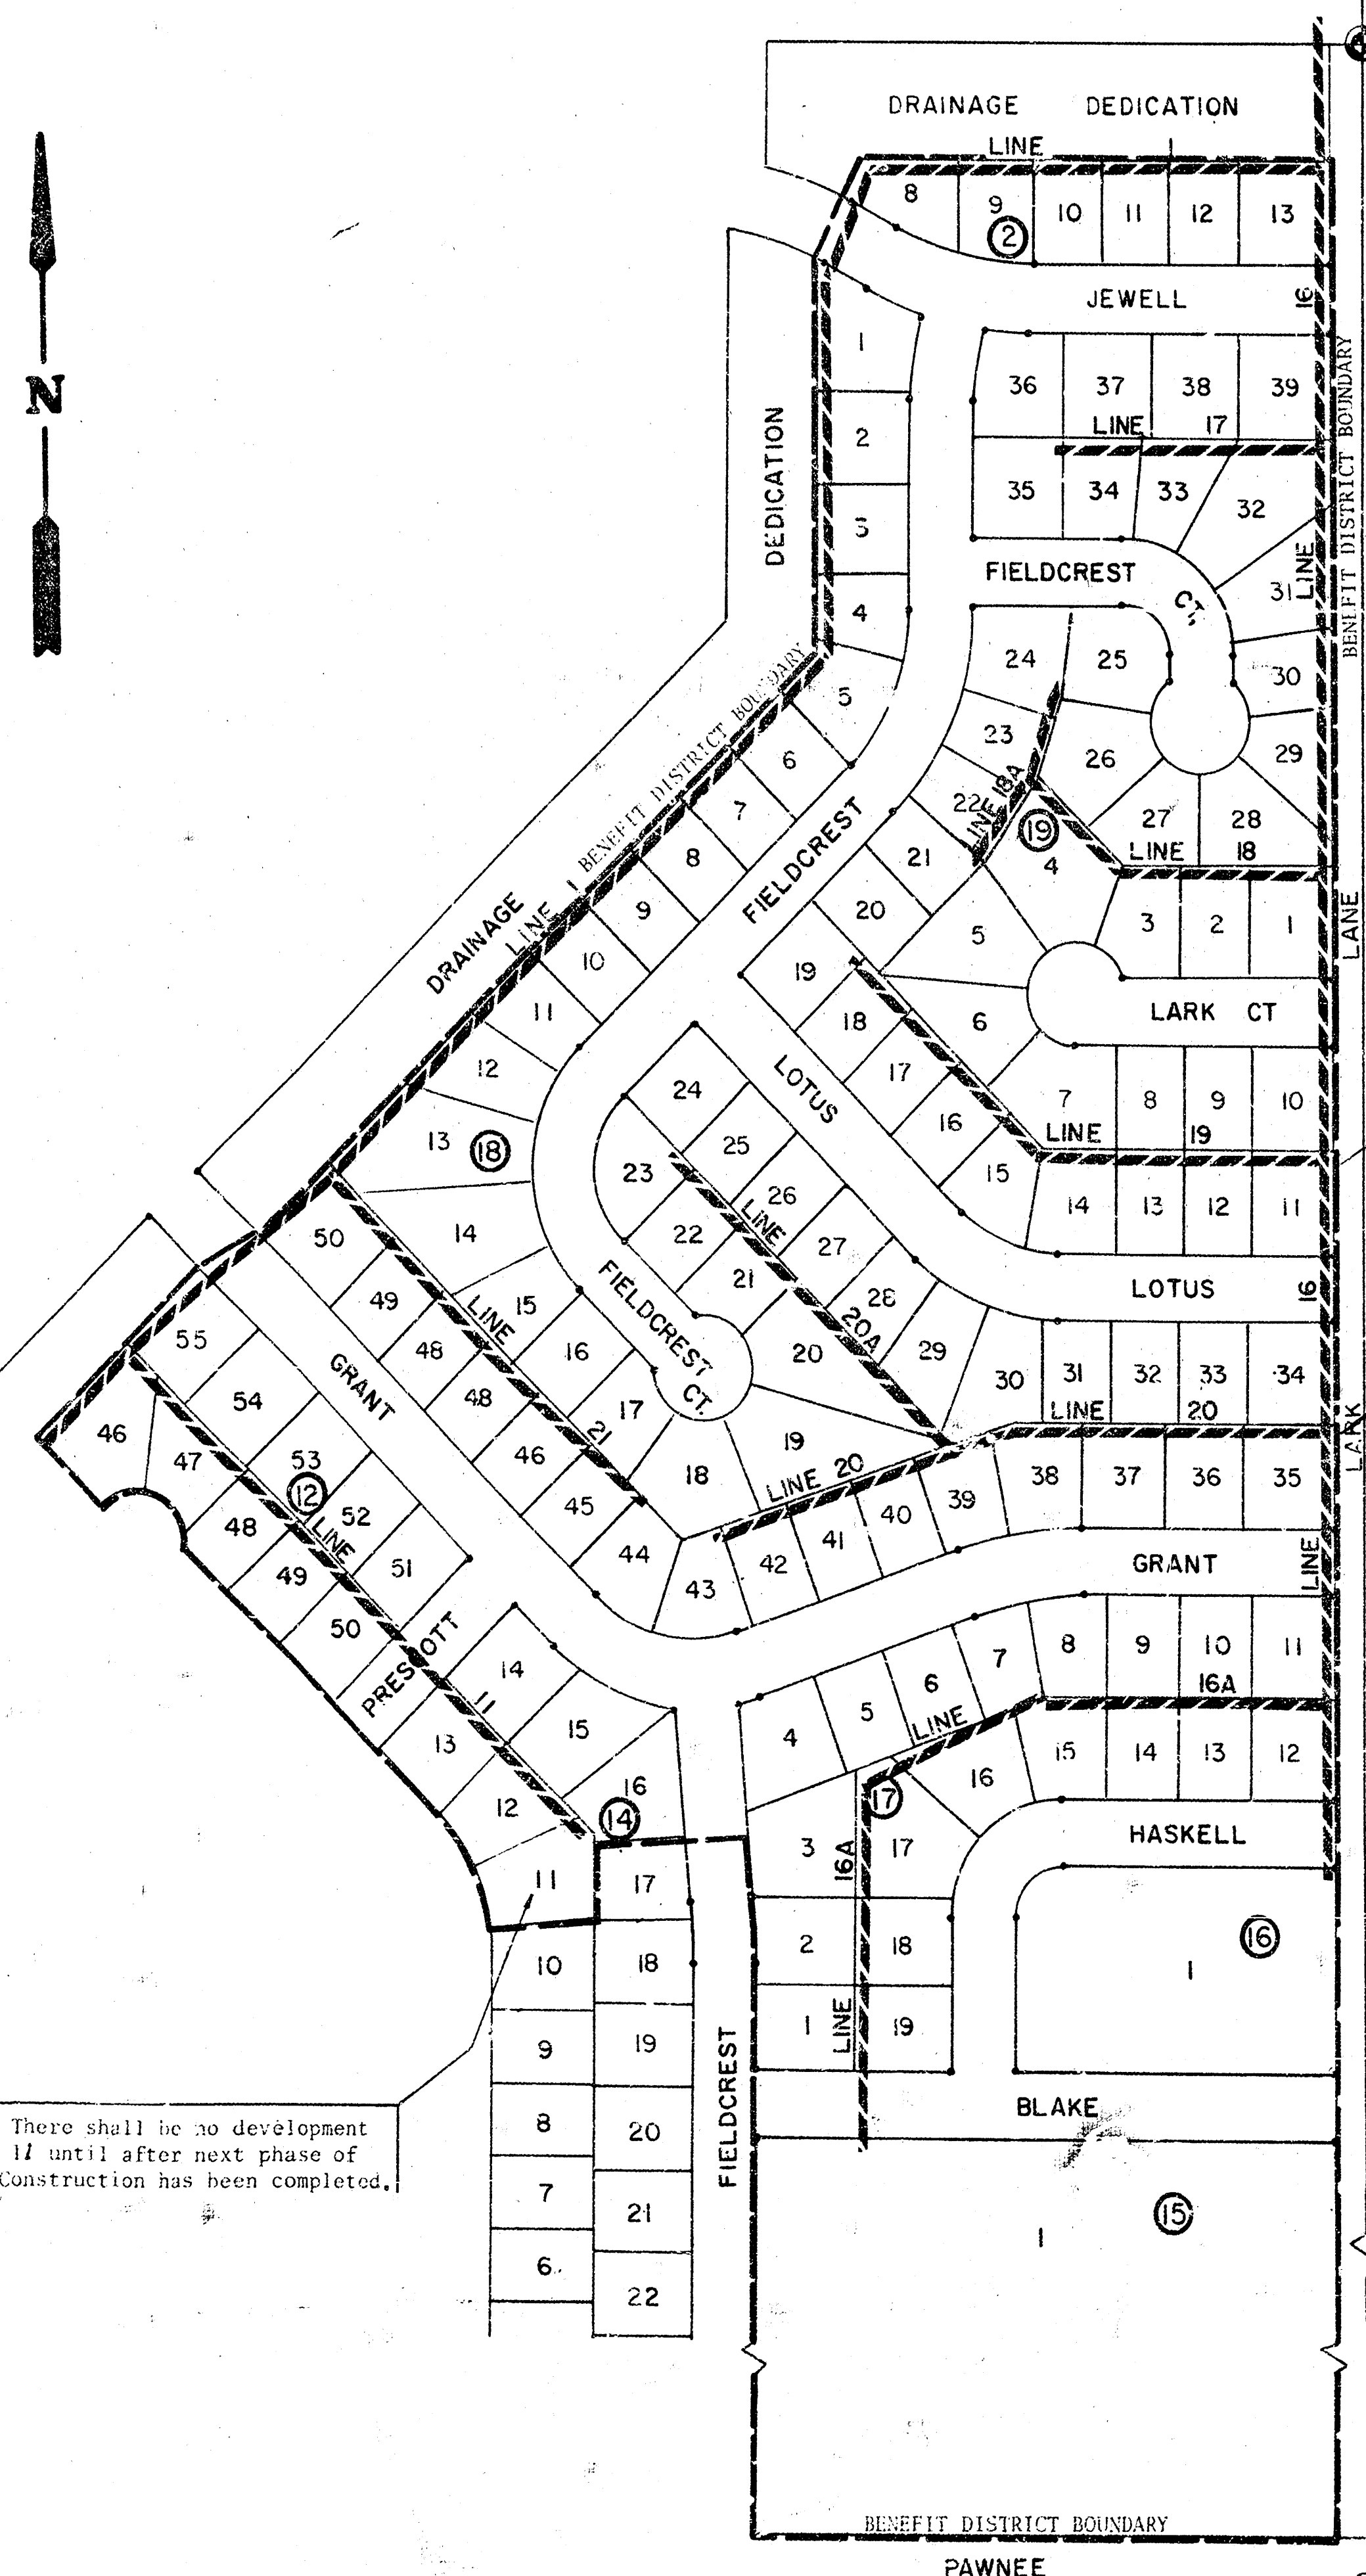

BENCH MARK - Railroad spike
in west face of power pole,
east side of Lark Lane,
1320 ± north of Pawnee,
Elev. 144.35'

NOTE: FIELD ENGINEER SHALL SET TOPS OF MANHOLES TO MATCH PROPOSED FINISHED GRADE AS DETERMINED BY THE DEVELOPER. RISERS AND ADDITIONAL STUBS SHALL BE INSTALLED ON THIS PROJECT TO SERVE INDIVIDUAL LOTS WHEN ORDERED BY THE FIELD ENGINEER. RISER CONSTRUCTION SHALL CONFORM TO THE REQUIREMENTS AS SHOWN ON STANDARD RISER DETAIL SHEET. LOCATIONS OF THE ENDS OF THE RISERS SHALL BE MARKED BY FASTENING GREEN PLASTIC COLORED TAPE TO THE END OF THE RISER AND BROUGHT TO THE GROUND SURFACE AS THE EXCAVATION IS BACKFILLED SUCH THAT THE COLORED TAPE WILL BE VISIBLE WHEN THE PROJECT IS COMPLETED. ALL RISERS SHALL BE CONSTRUCTED USING S.D.R. 35.5 A.B.S. OR P.V.C. PIPE. ELEVATIONS OF STUBS AND TOPS OF RISERS SHALL BE SUCH THAT WILL FACILITATE CONNECTION OF BASEMENT DRAINS WHEN THESE LOTS ARE DEVELOPED.

NOTE: PIPE USED ON THIS PROJECT MAY BE EITHER A.B.S. COMPOSITE, P.V.C., OR CLAY, EXCEPT THAT ONLY ONE OF THESE TYPES MAY BE USED.

*As Built
3-81
JSS*

INDEX TO DRAWINGS

SHEET NO.	DESCRIPTION
1	TITLE SHEET
2-10	PLAN & PROFILE
11-12	DETAILS
13-14	PLATS



Van Doren - Hazard - Stallings

Architects • Engineers • Planners
Topeka Wichita Minneapolis



Sheet 1
of 14

PROJECT NO.

468-76-245-80941-000-000-001


BENCH MARK - Railroad spike
in west face of power pole,
east side of Lark Lane,
1320' north of Pawnee,
Elev. 144.35'

SCALE: 1" = 40' HORIZ.
1" = 5' VERT.

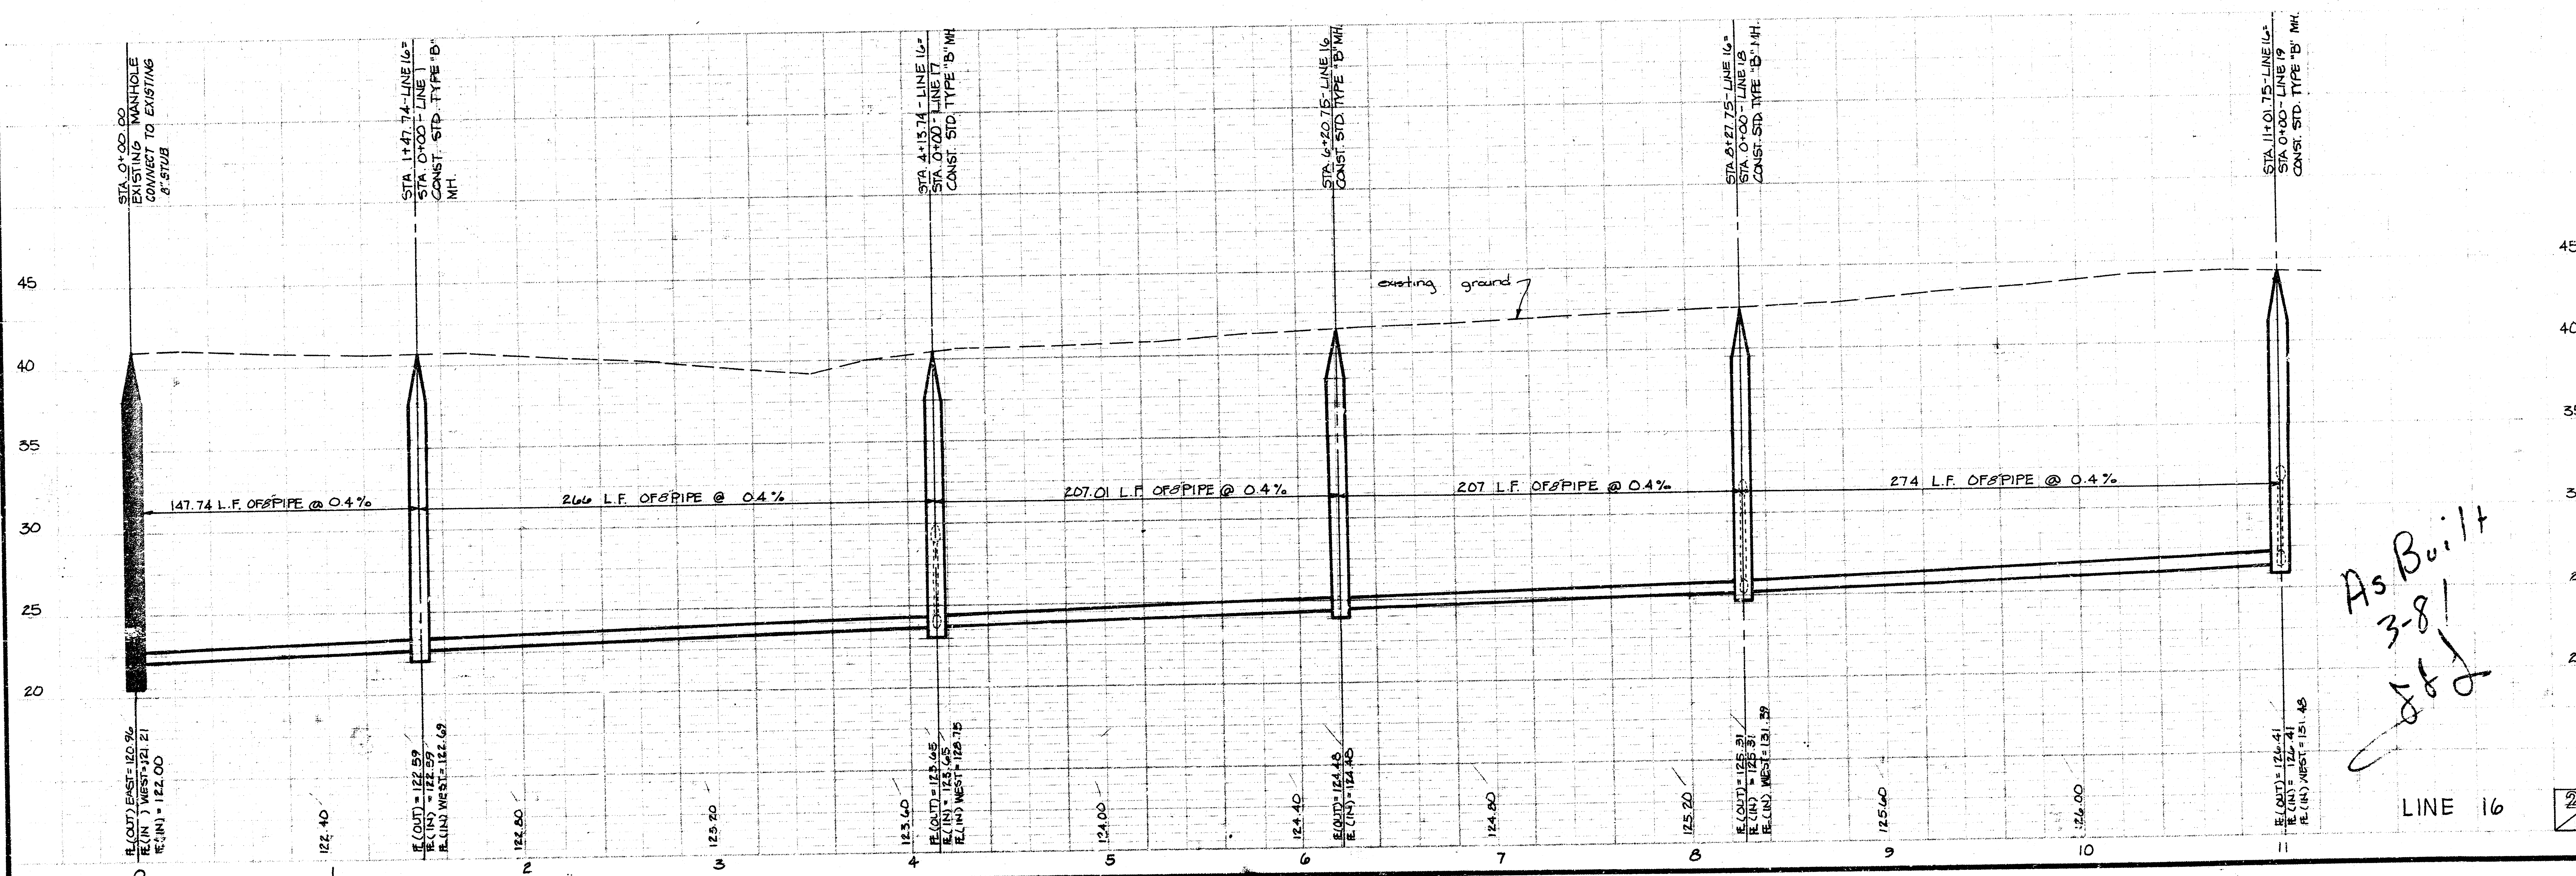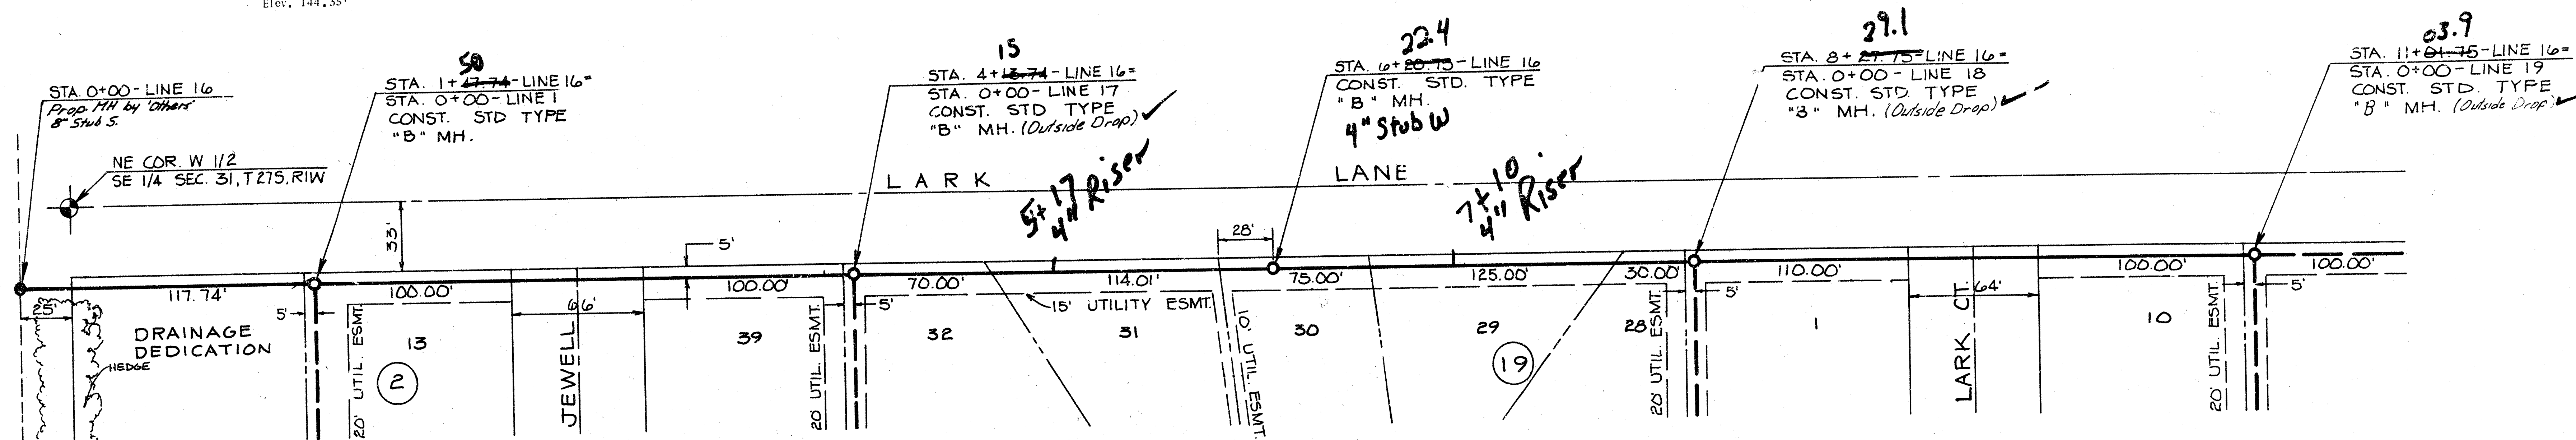


PROJECT NO.

468-76-245-80941-000-000-001

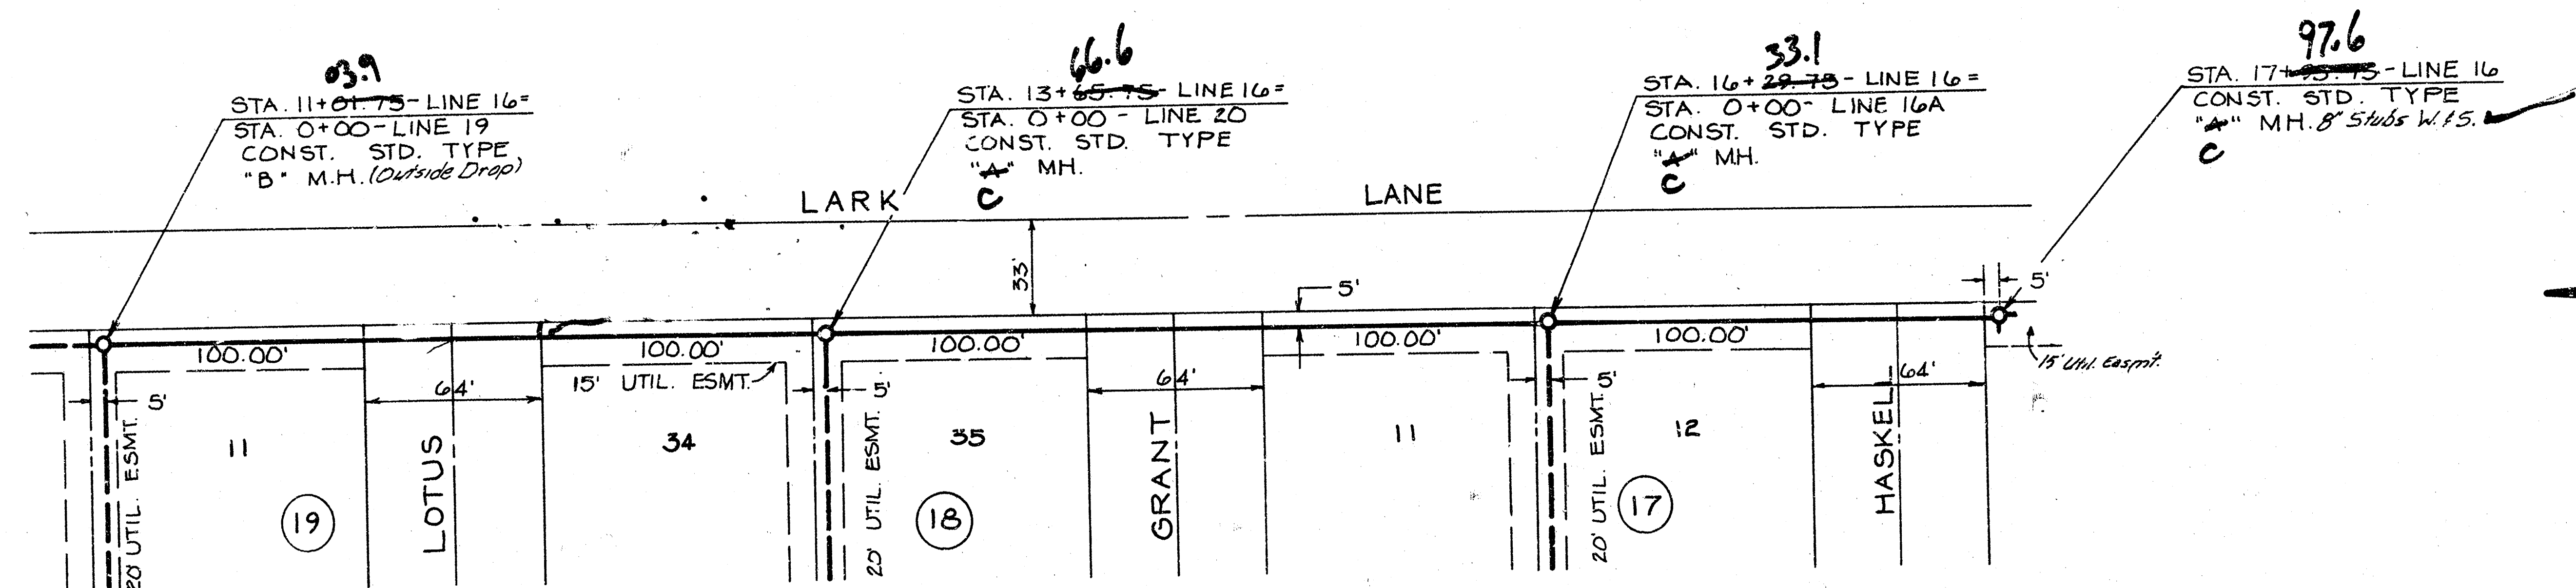

N
SCALE: 1" = 40' HORZ.
1" = 5' VERT.

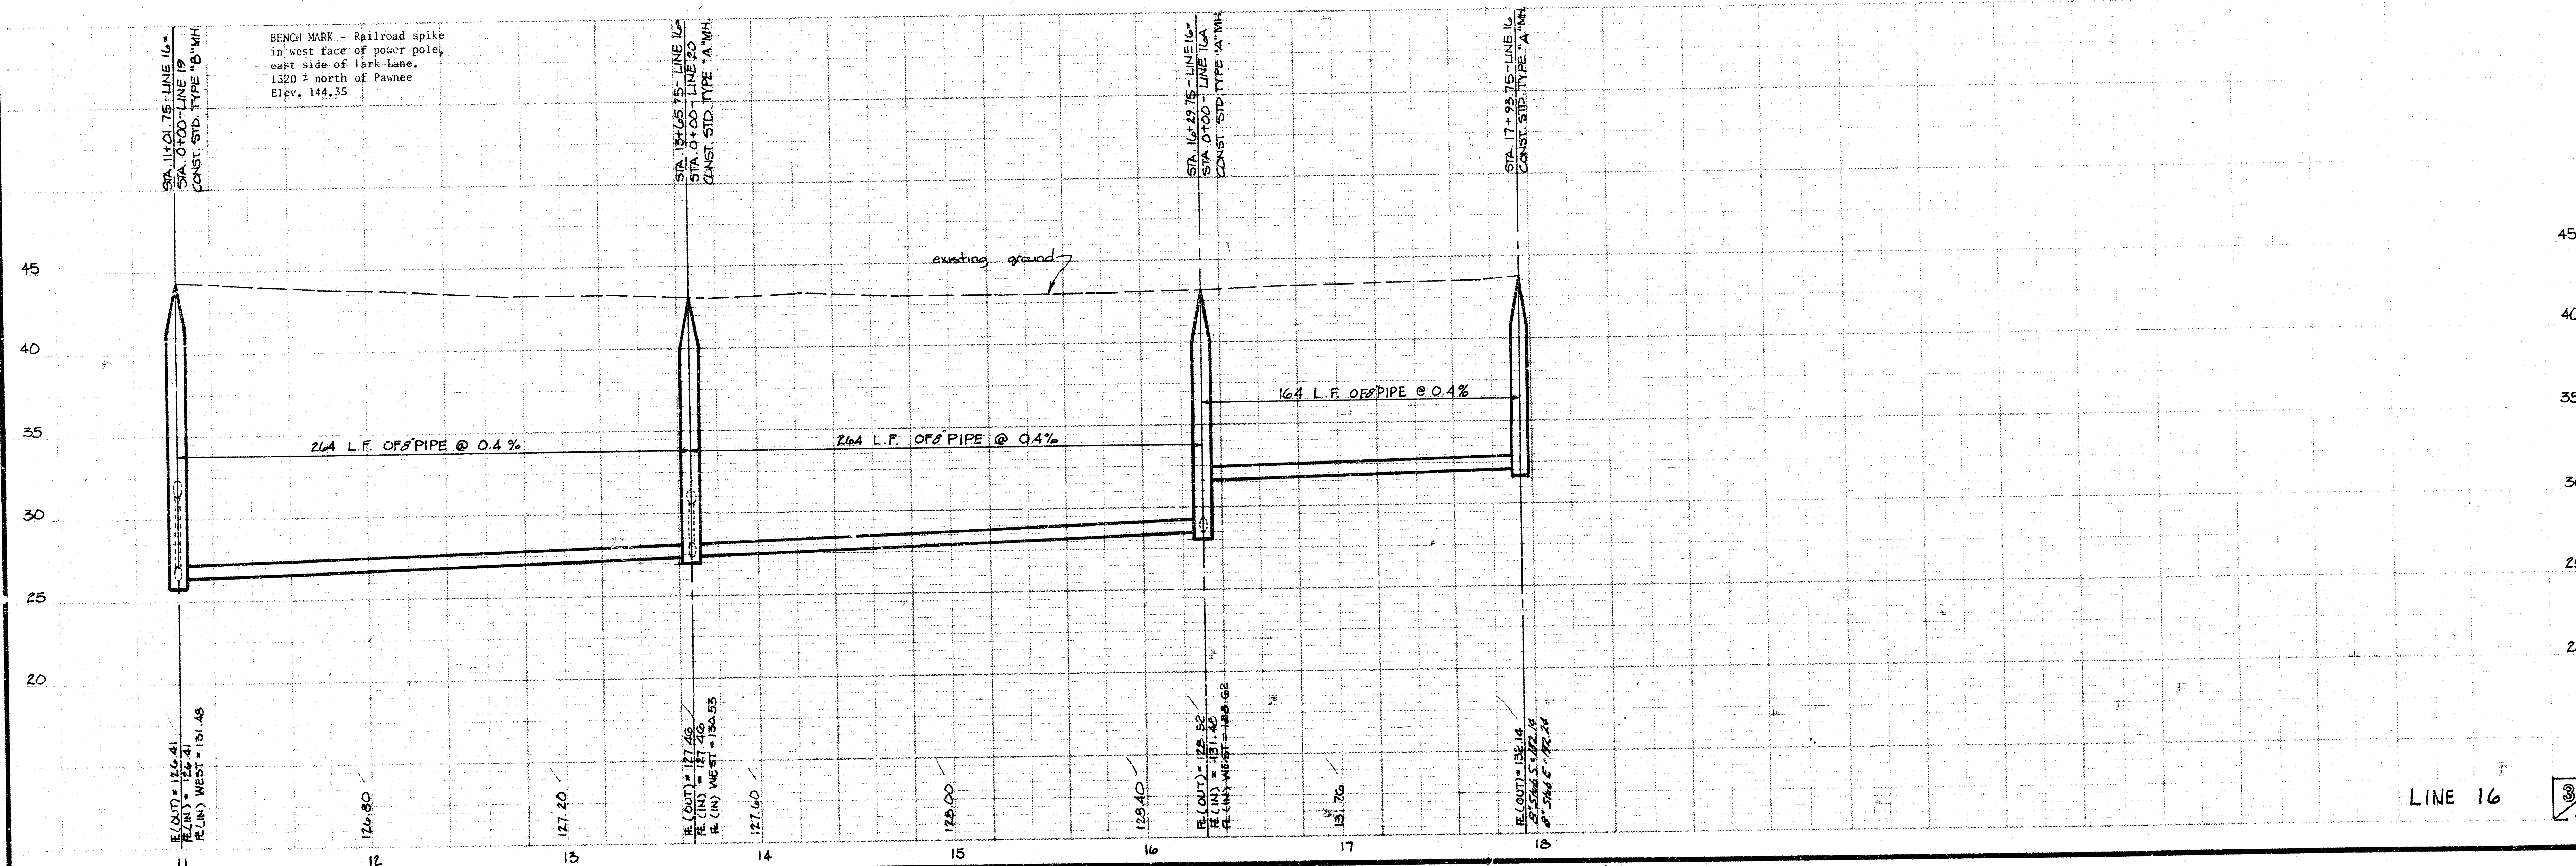


LINE 16


PROJECT NO.

468-76-245-80941-000-000-001

STA. 0+00 - LINE 19
STA. 11+01.75 - LINE 16
CONST. STD. TYPE
"B" OUTSIDE DROP
M.H.


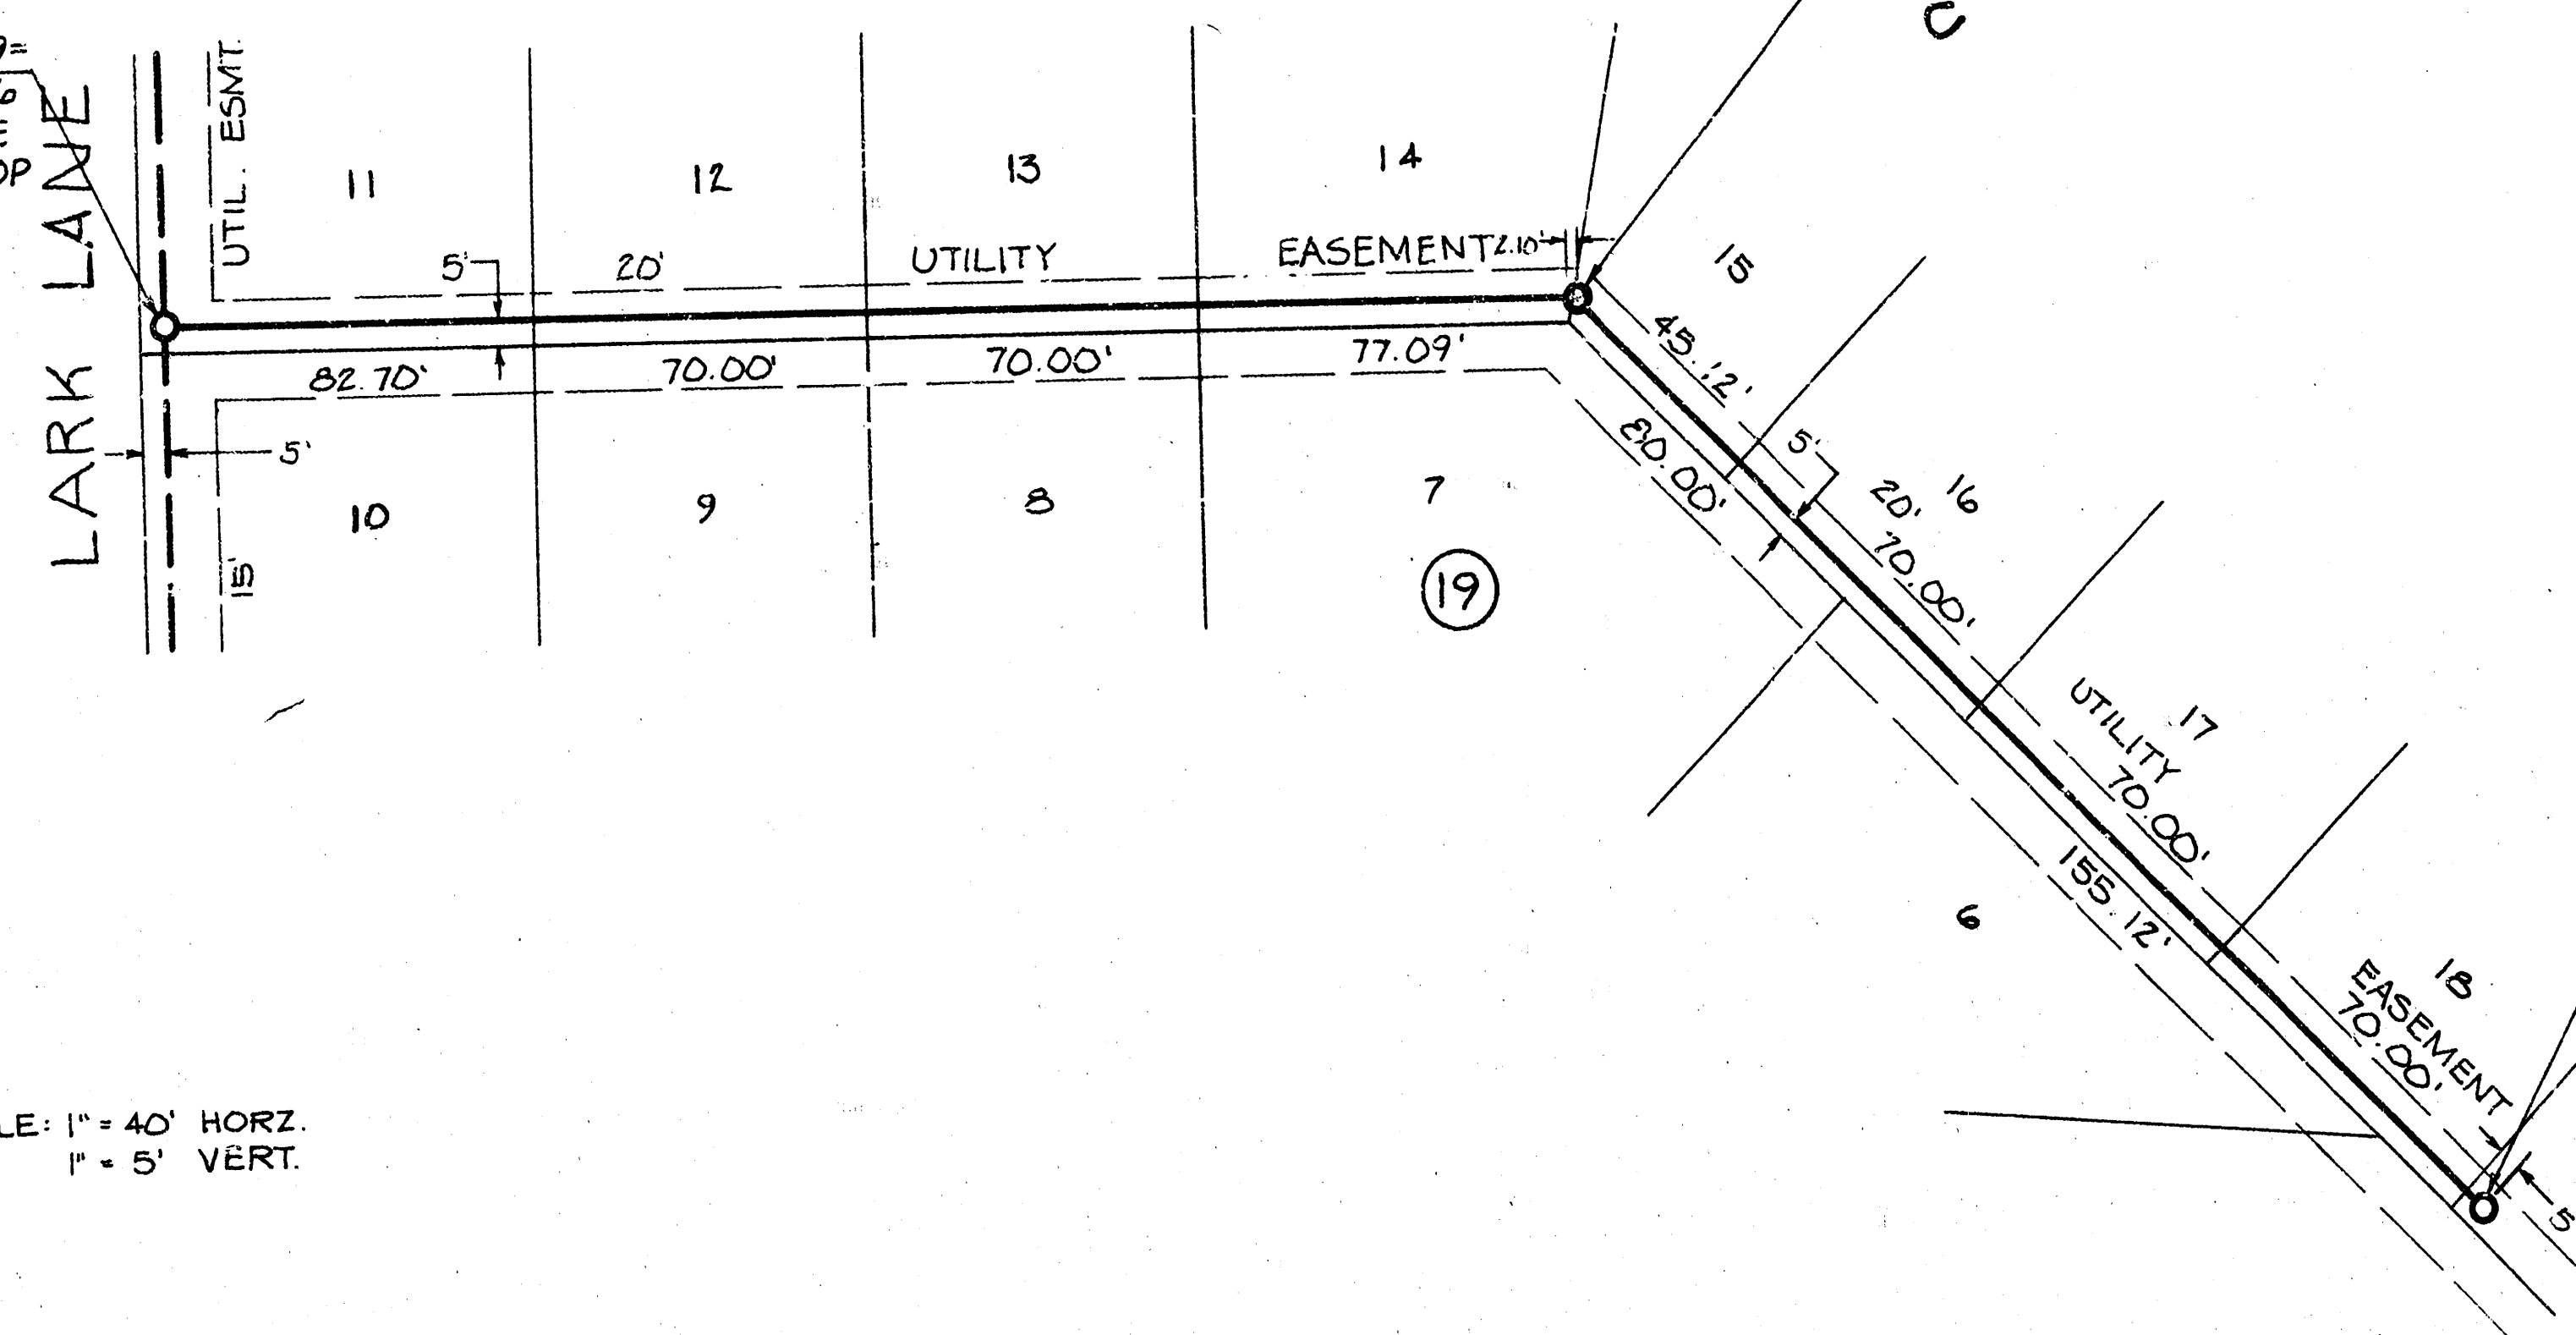


SCALE: 1" = 40' HORIZ.
1" = 5' VERT.




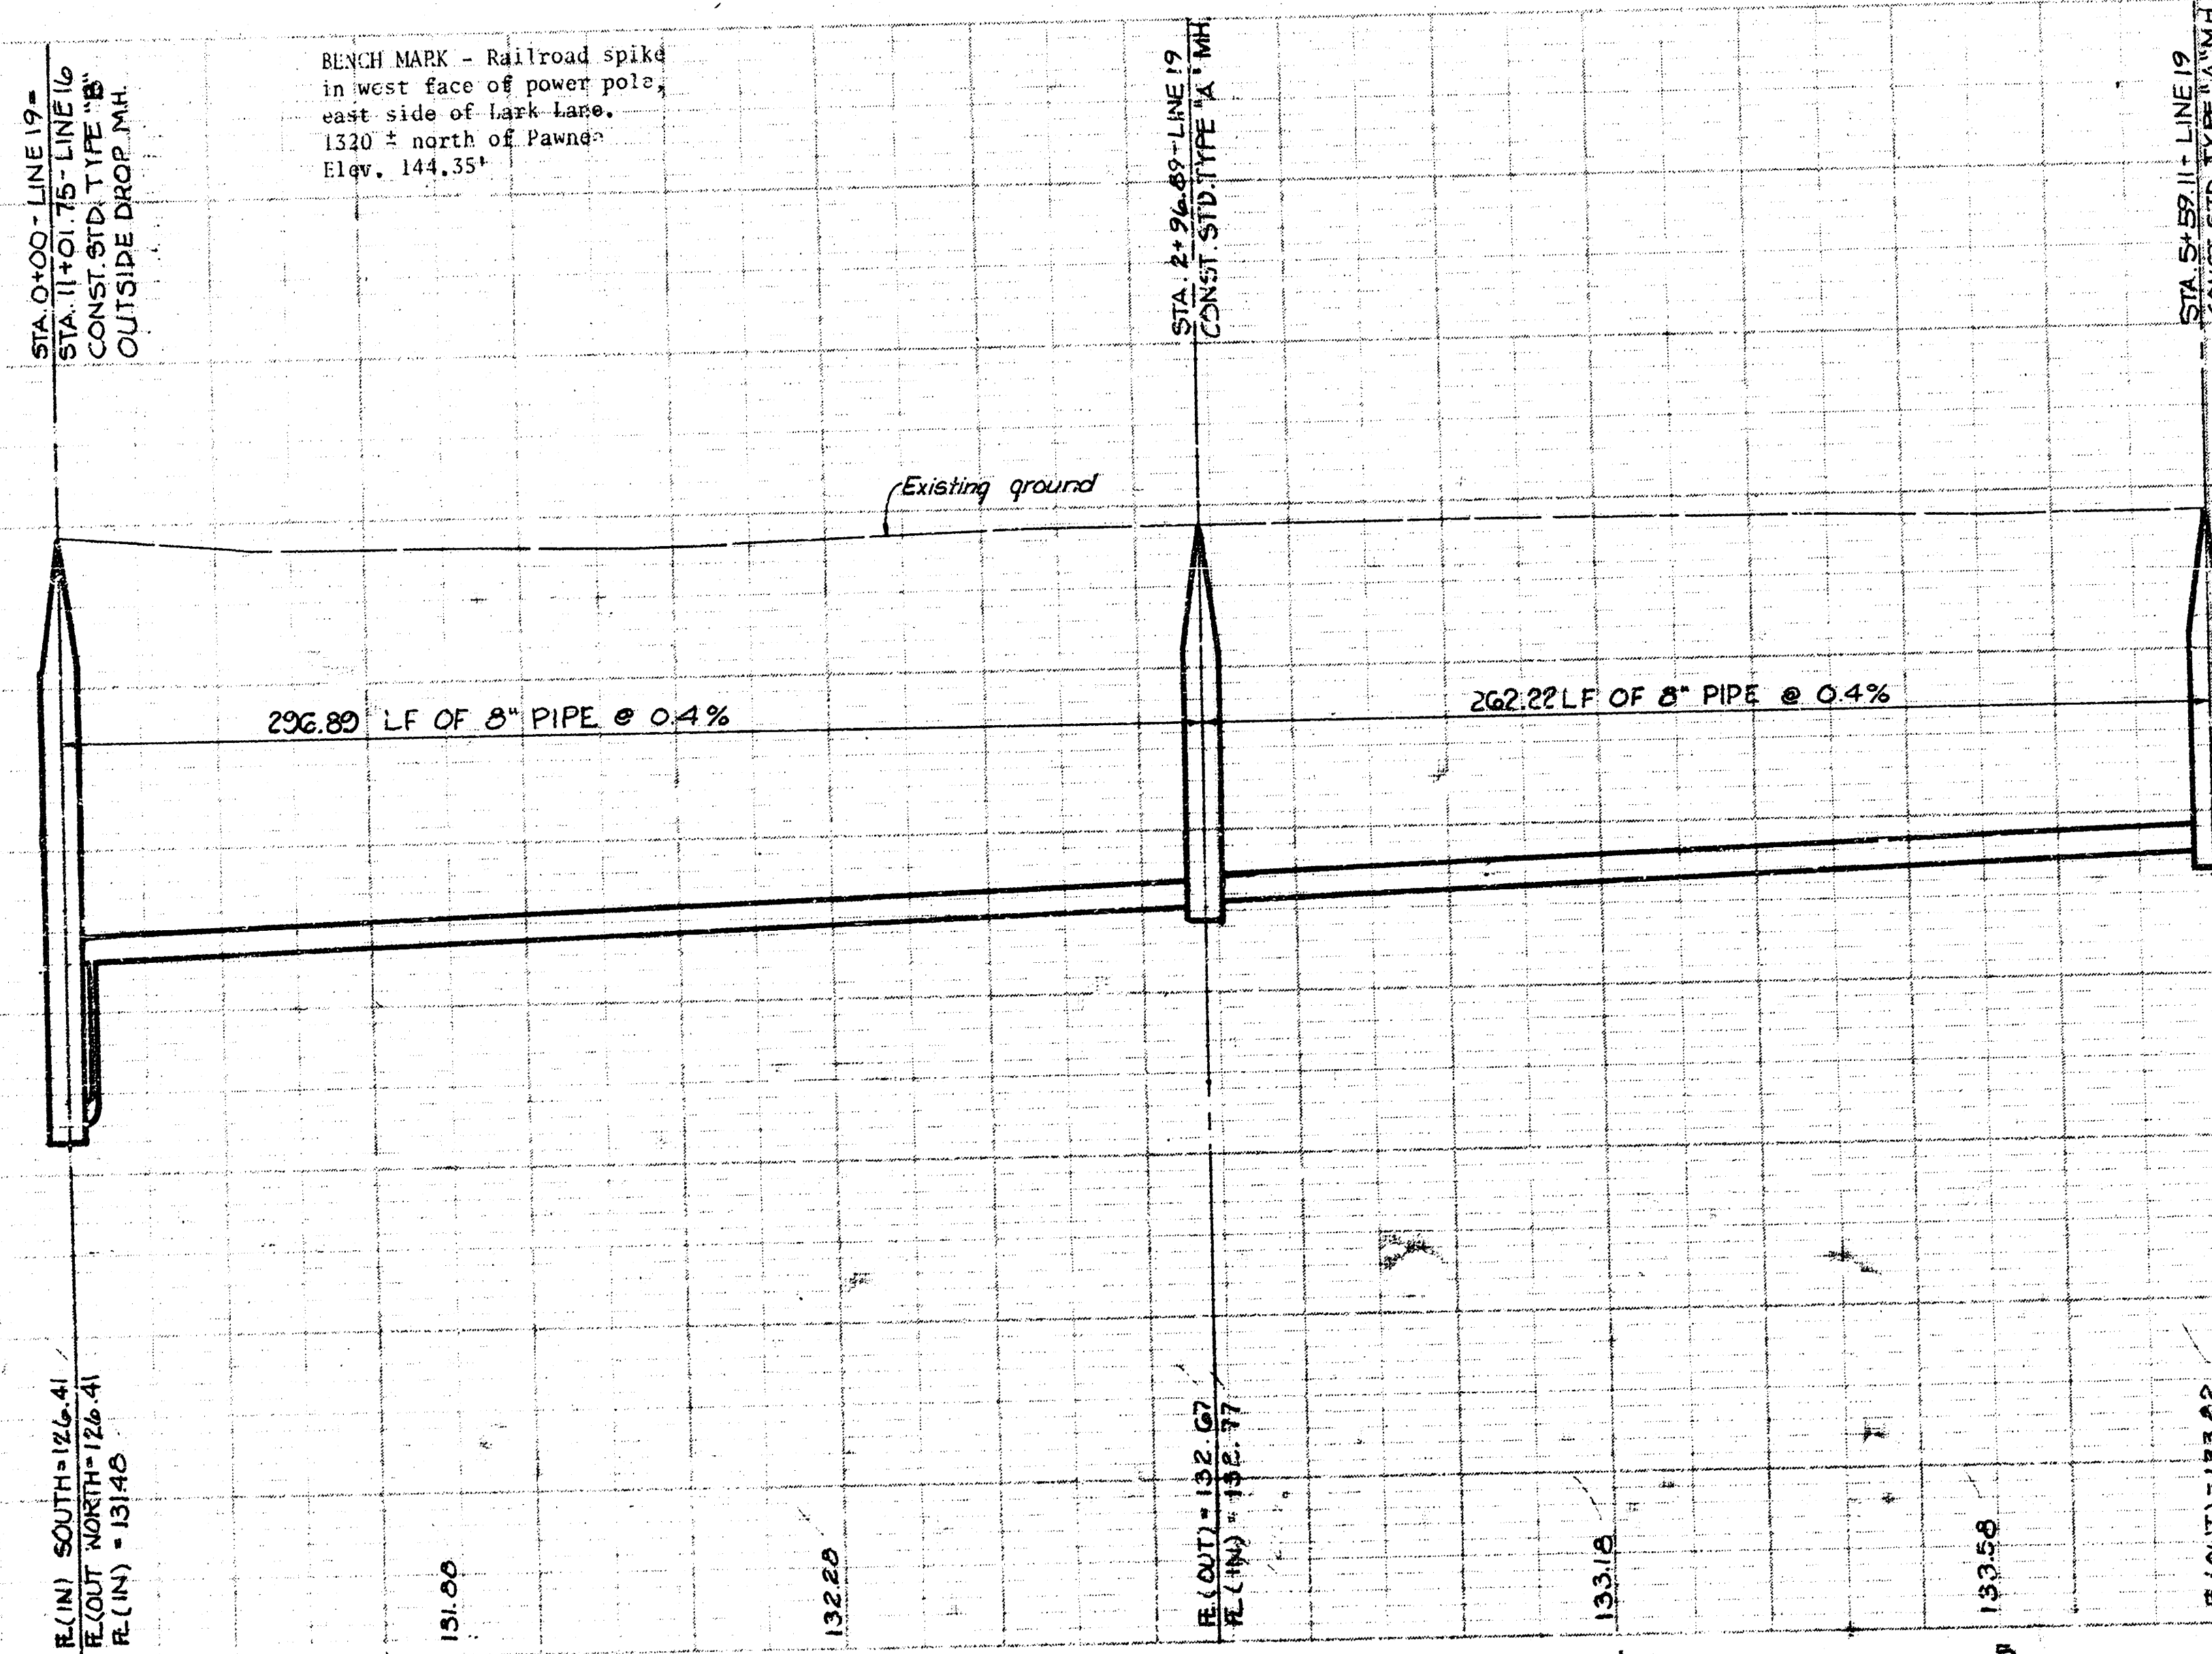


LINE 19



PROJECT NO.
468-76-245-80941-000-000-001

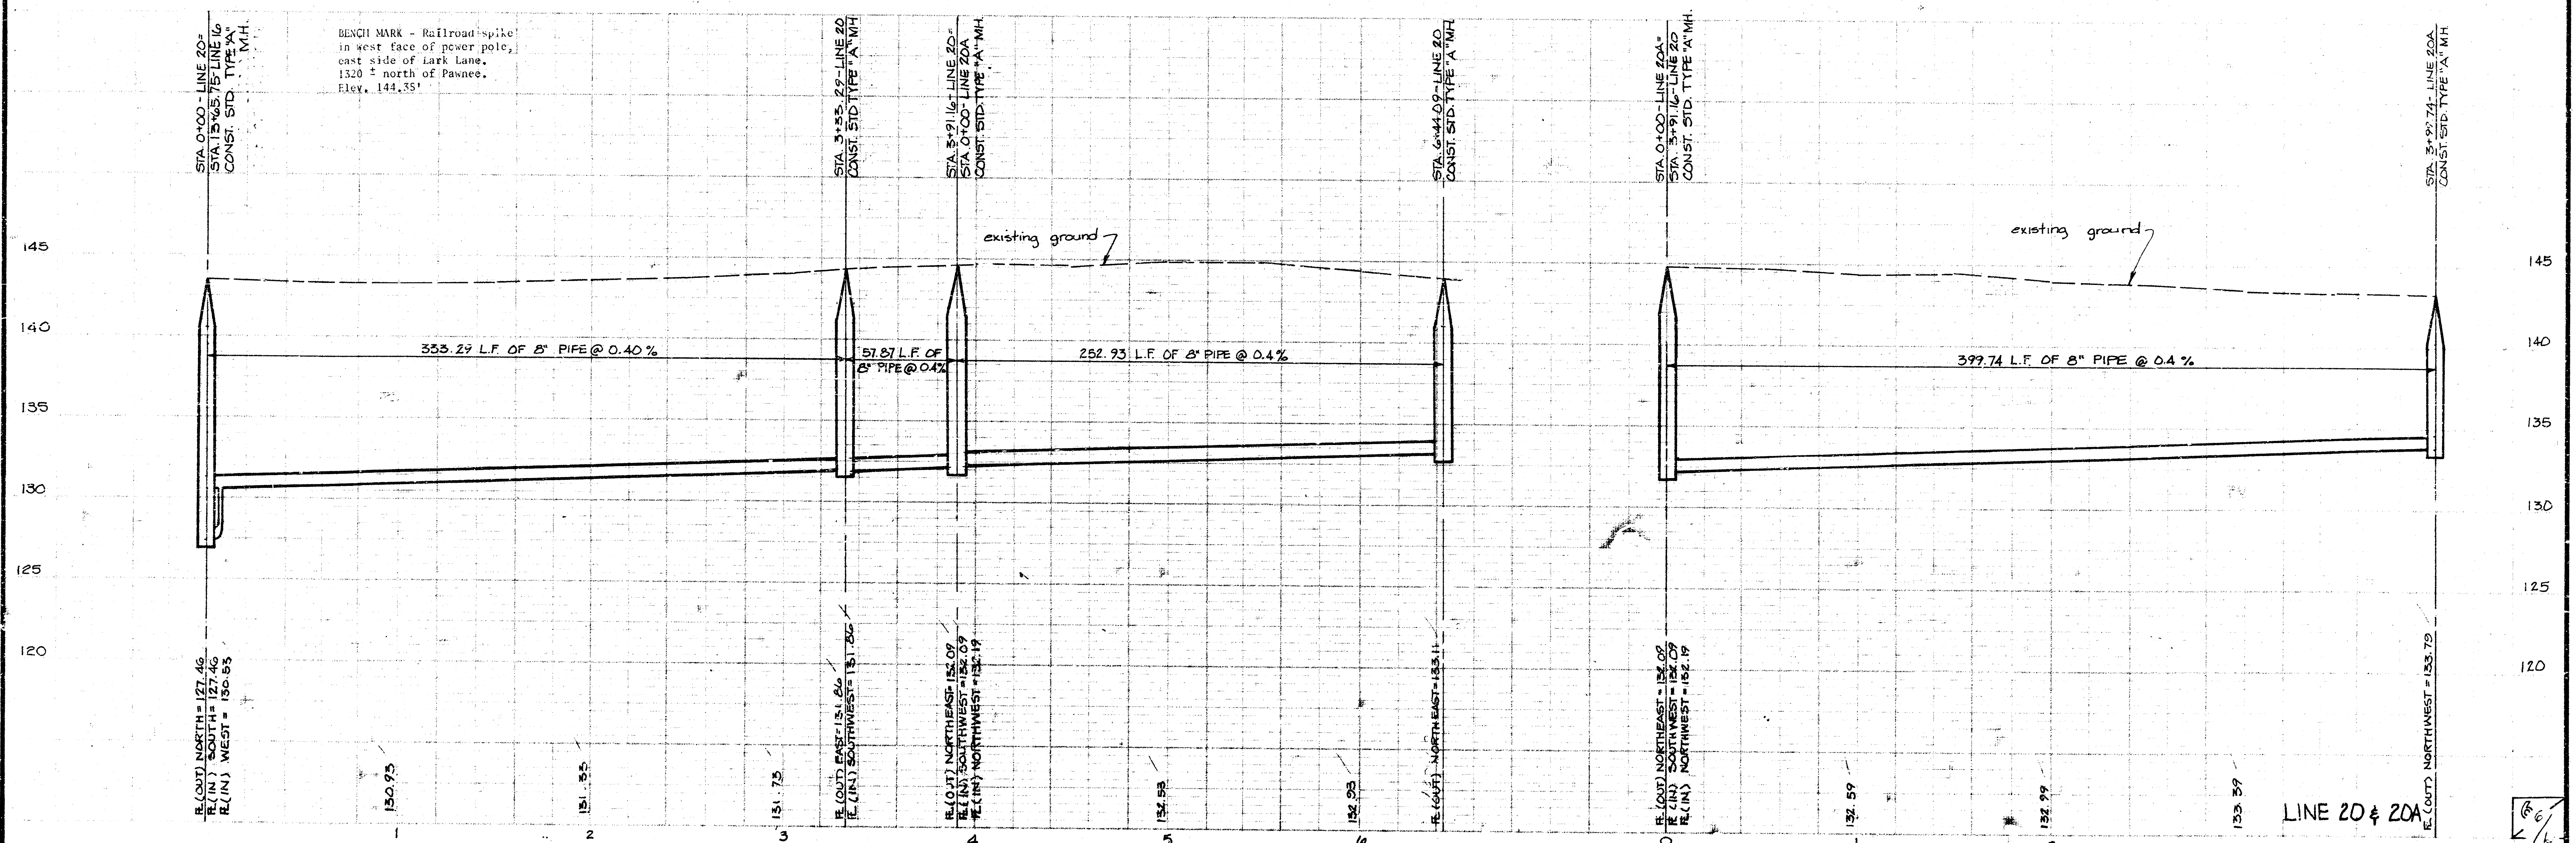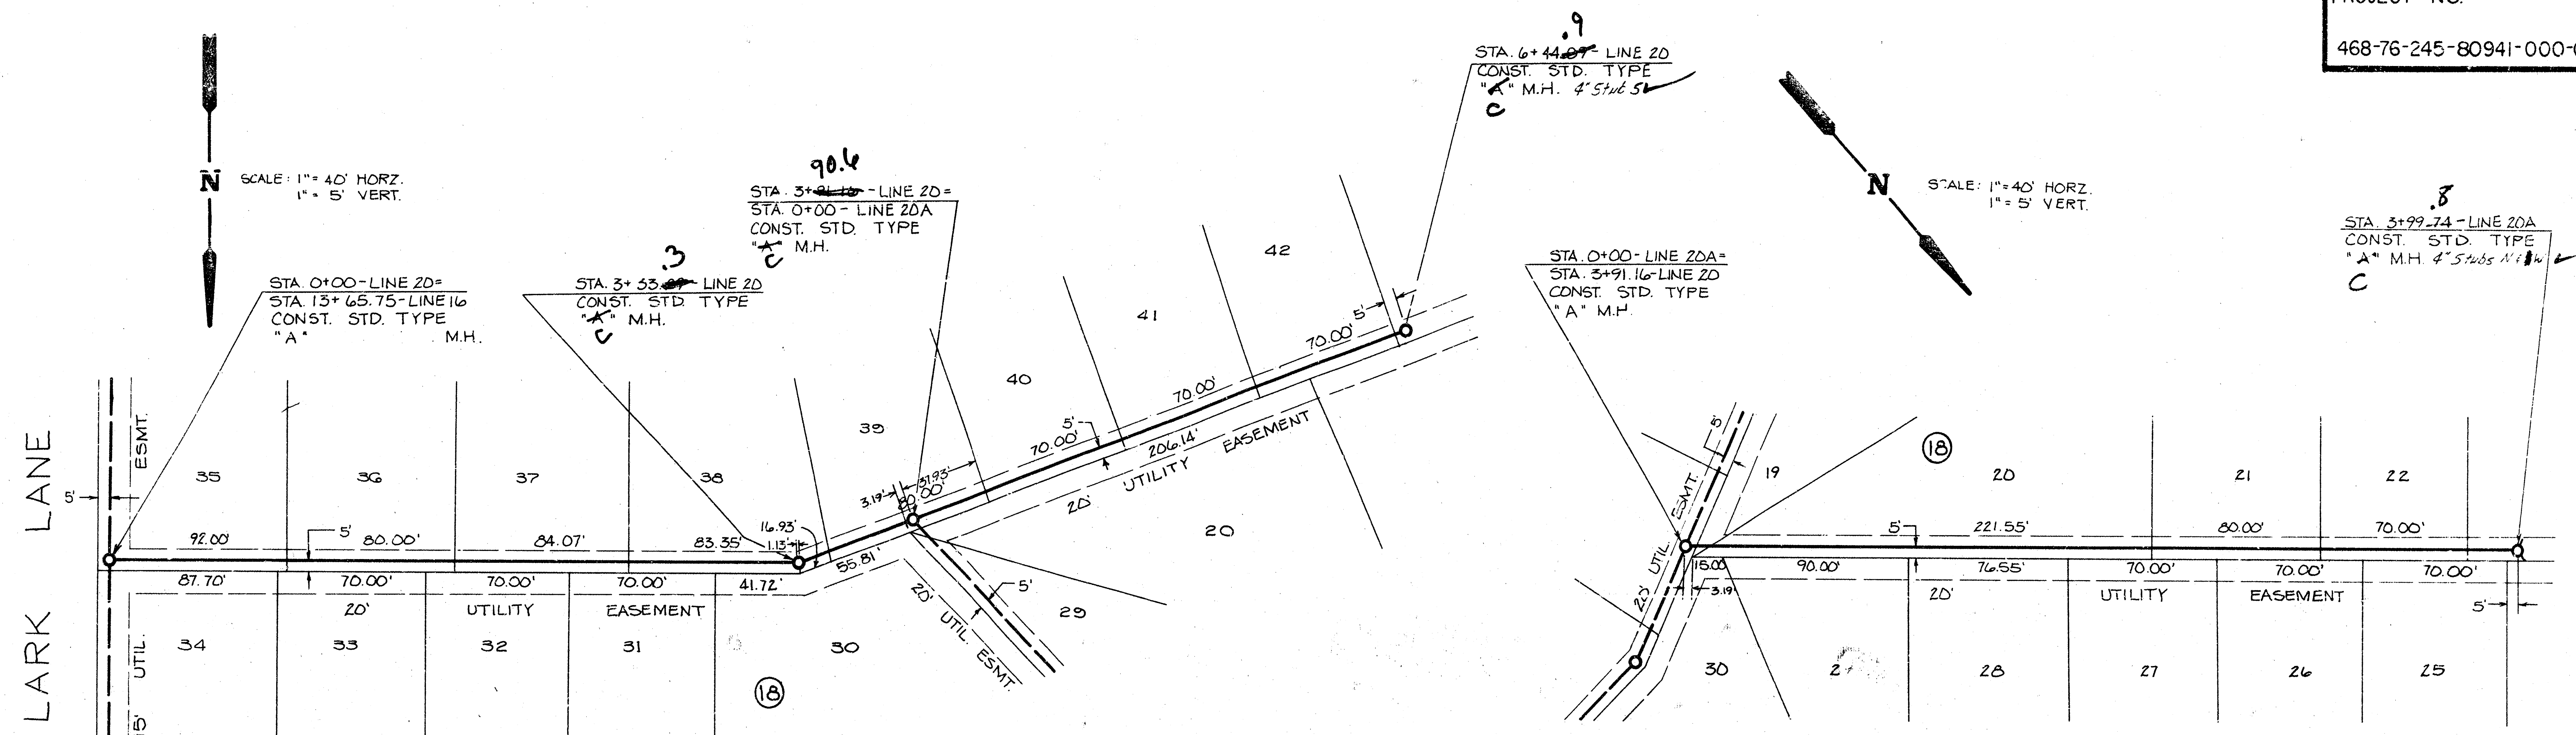



PROJECT NO.
468-76-245-80941-000-000-001

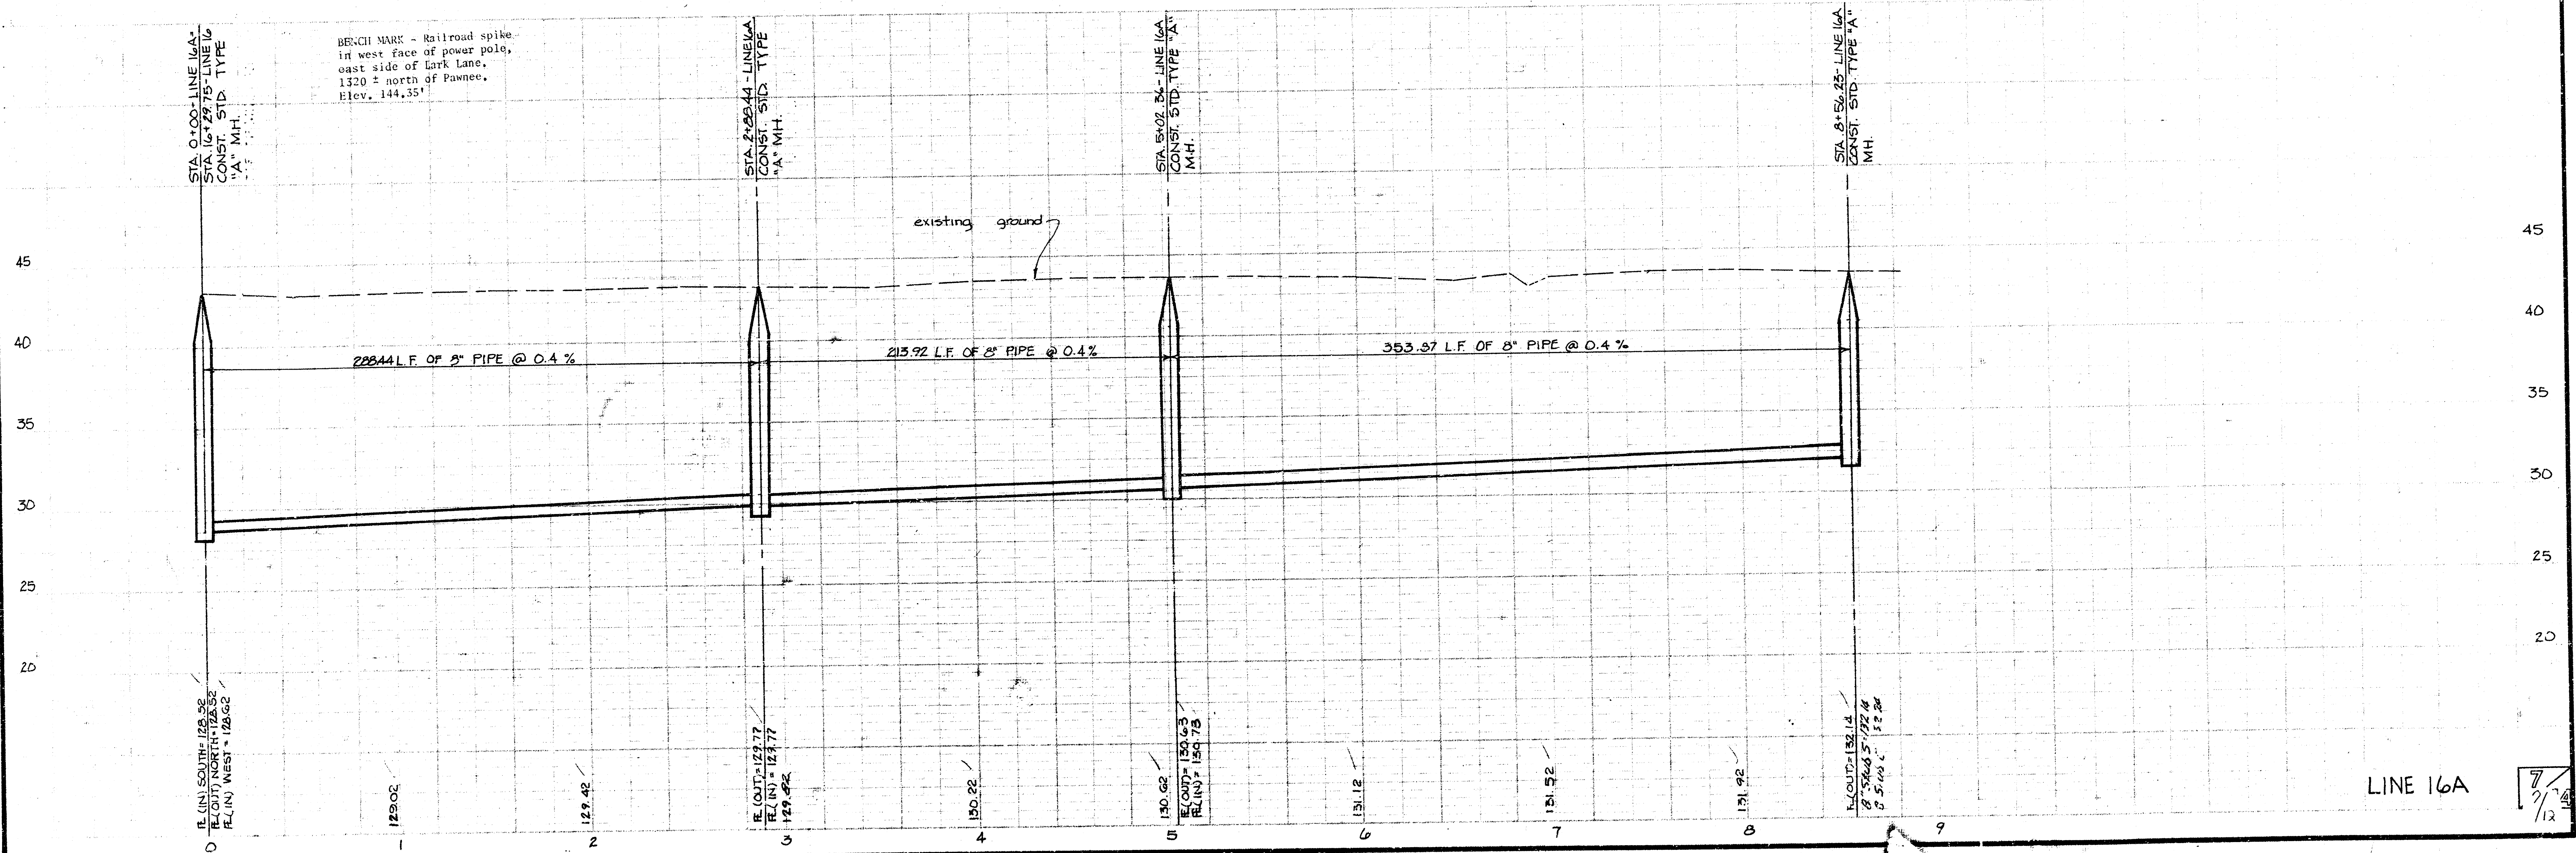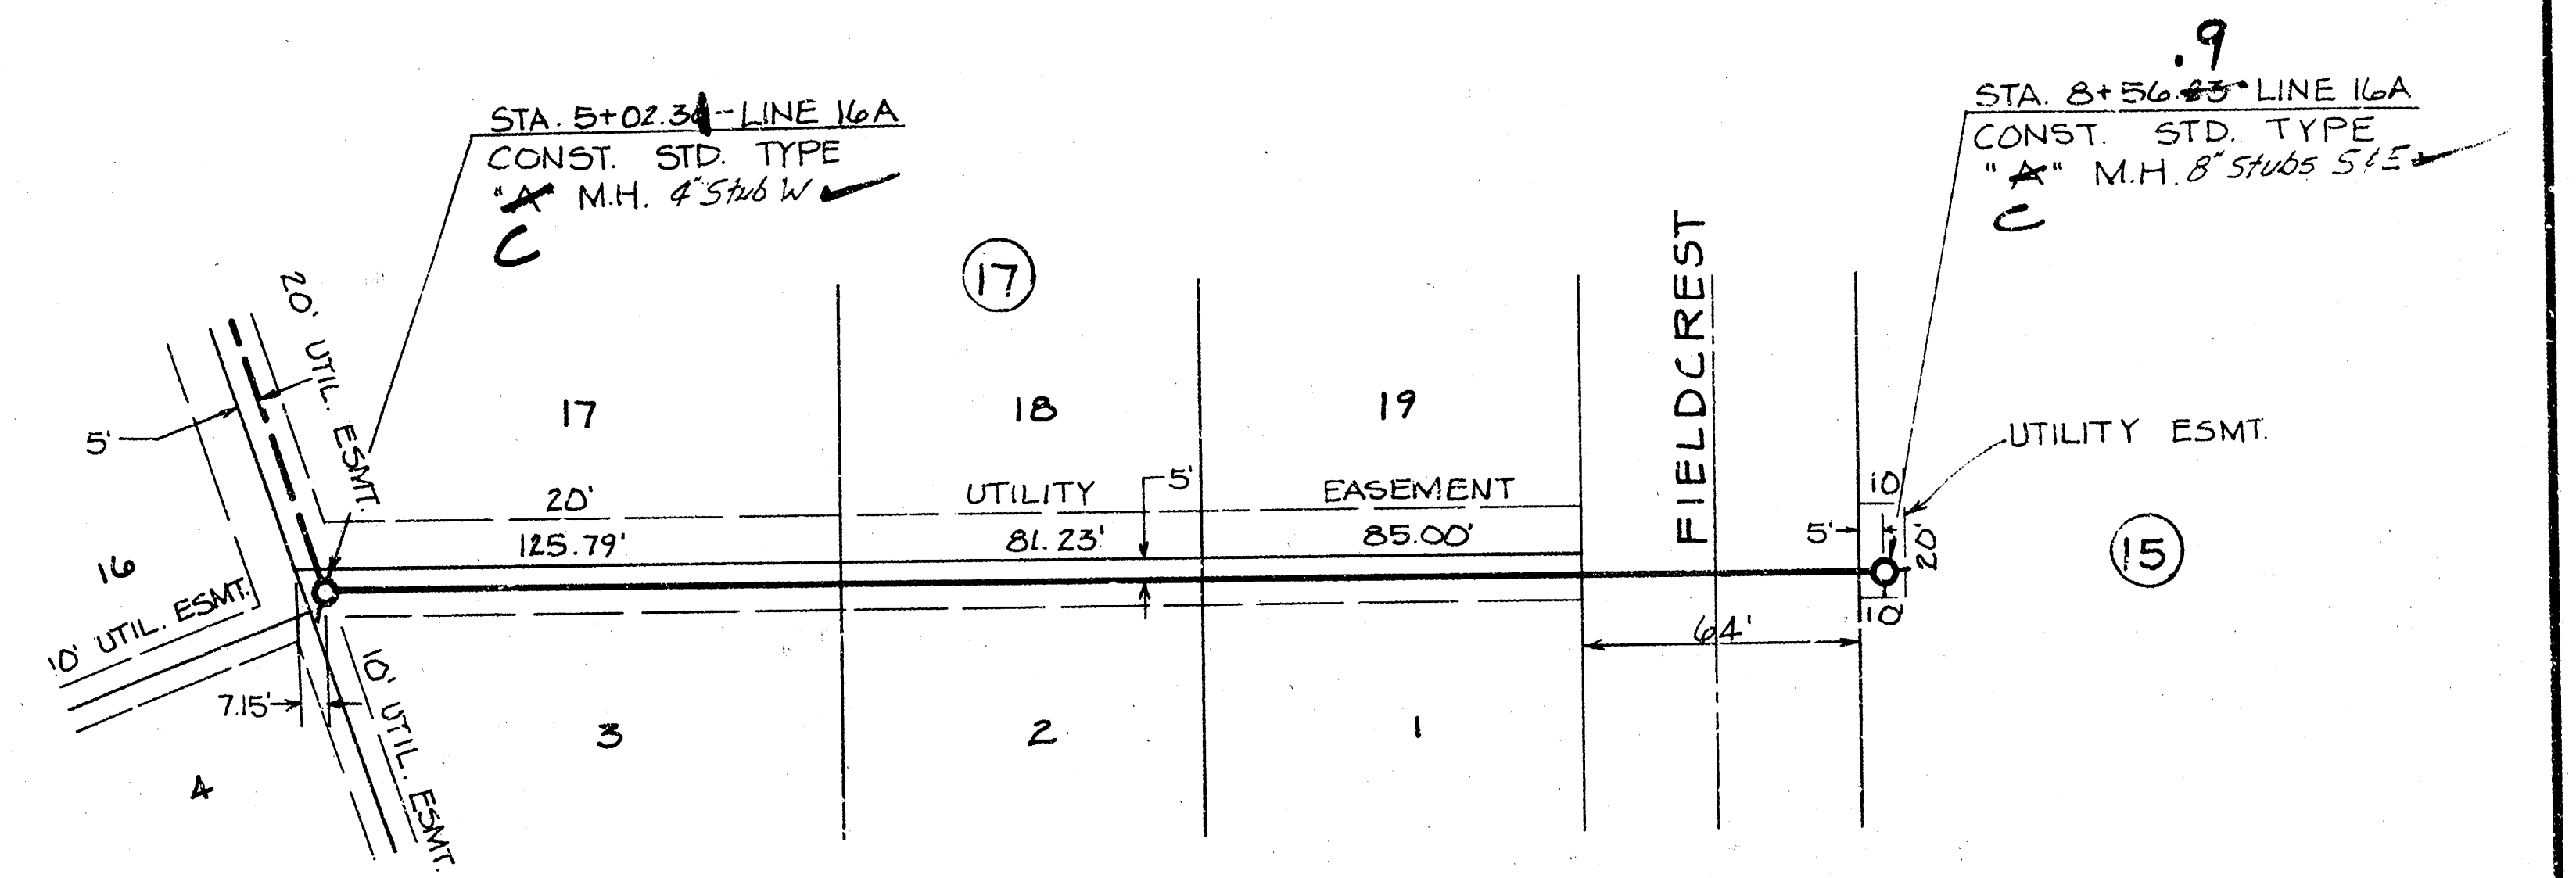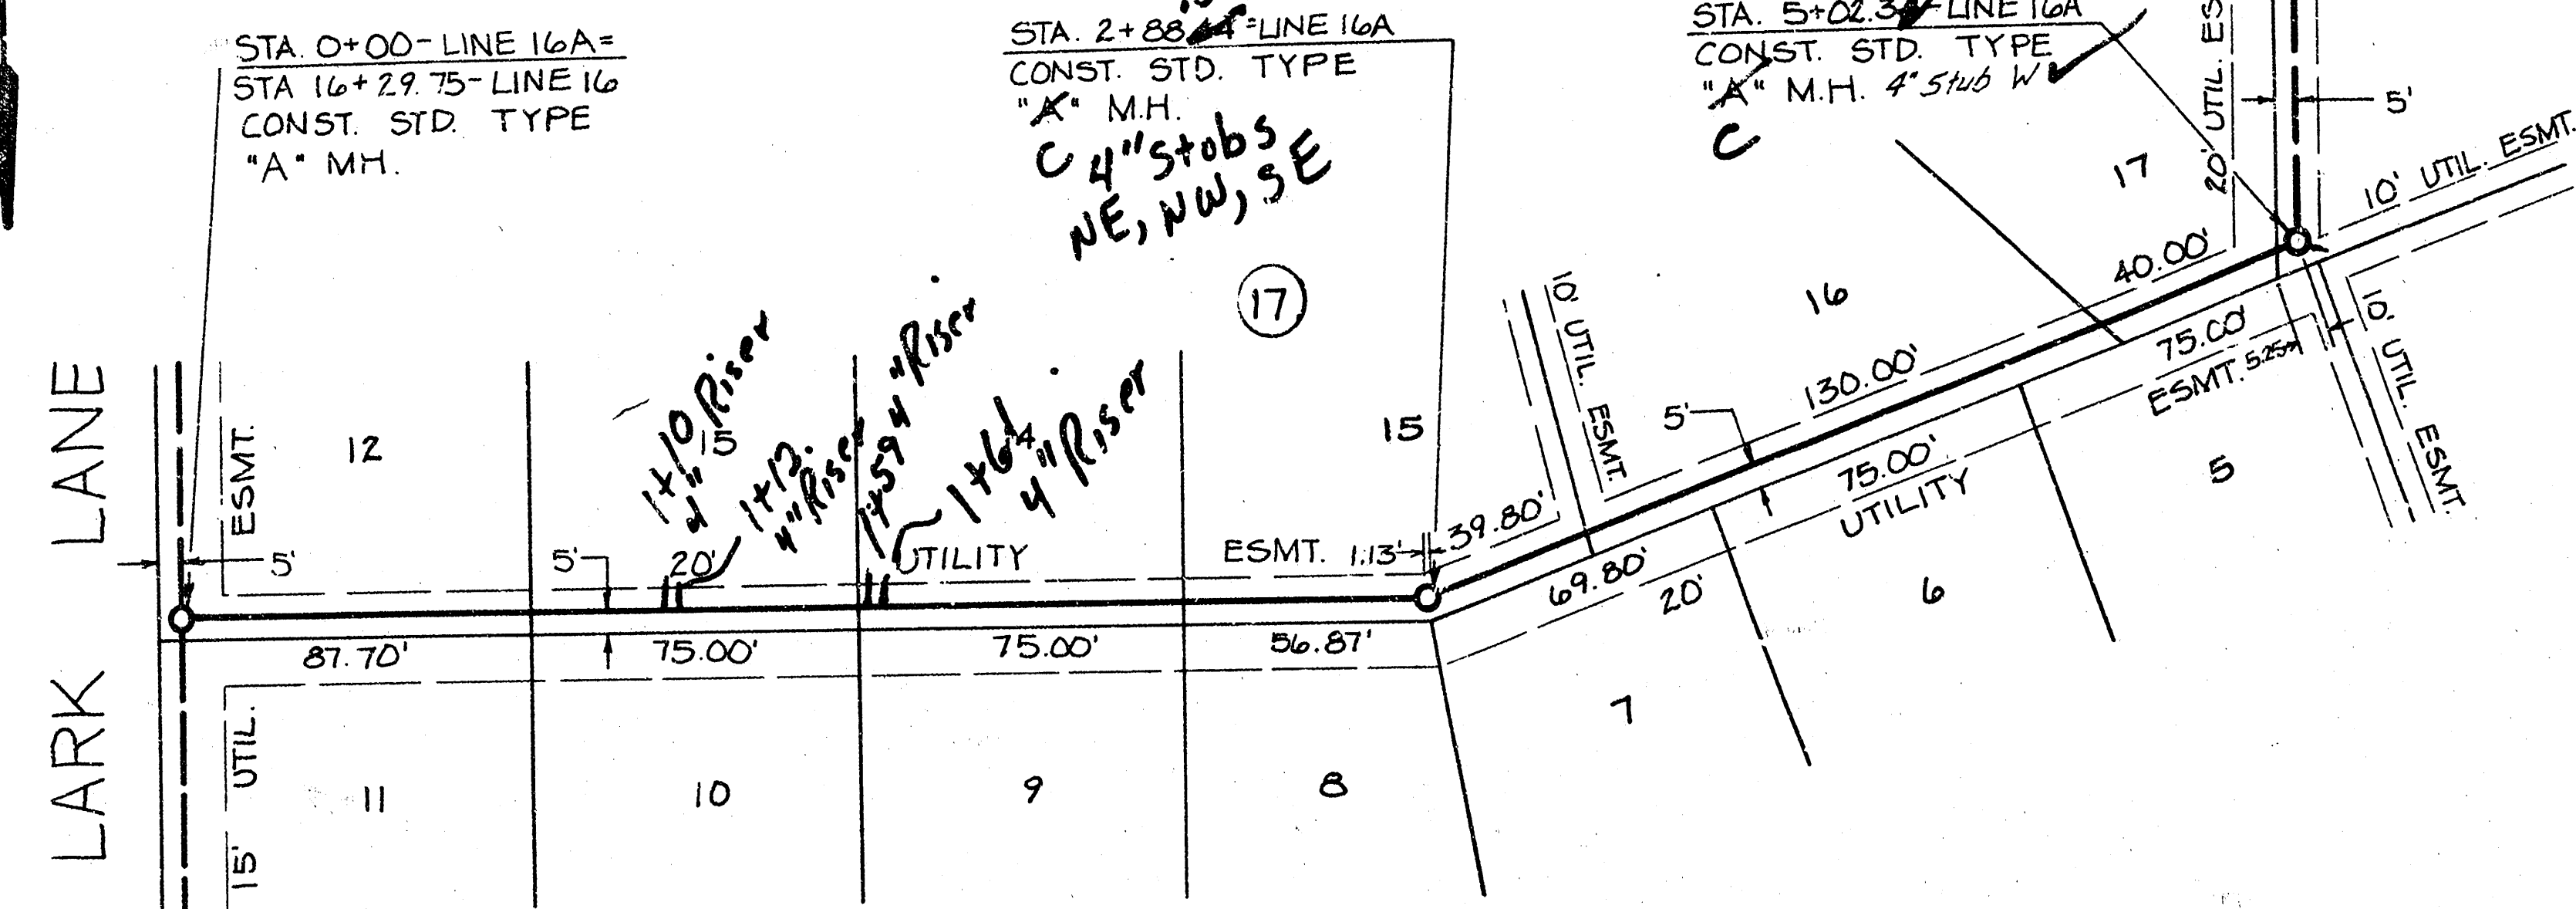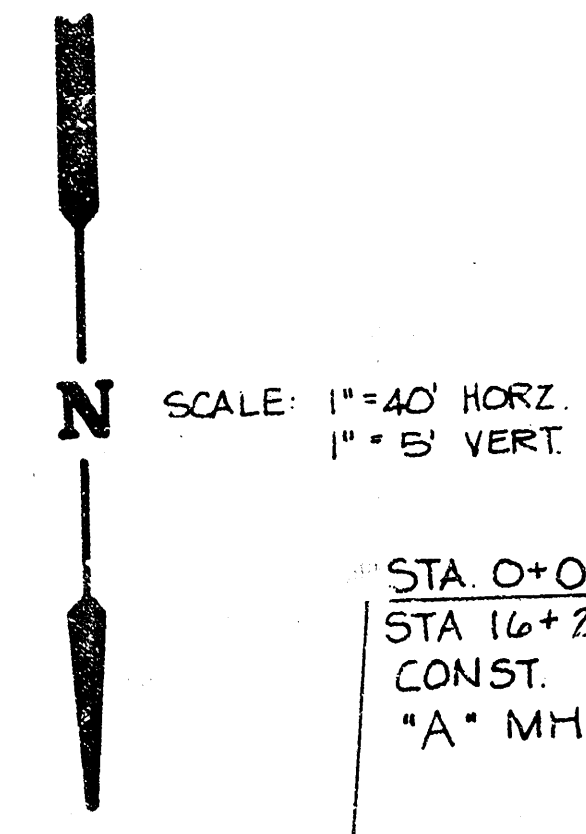


PROJECT NO.
468-76-245-80941-000-000-001

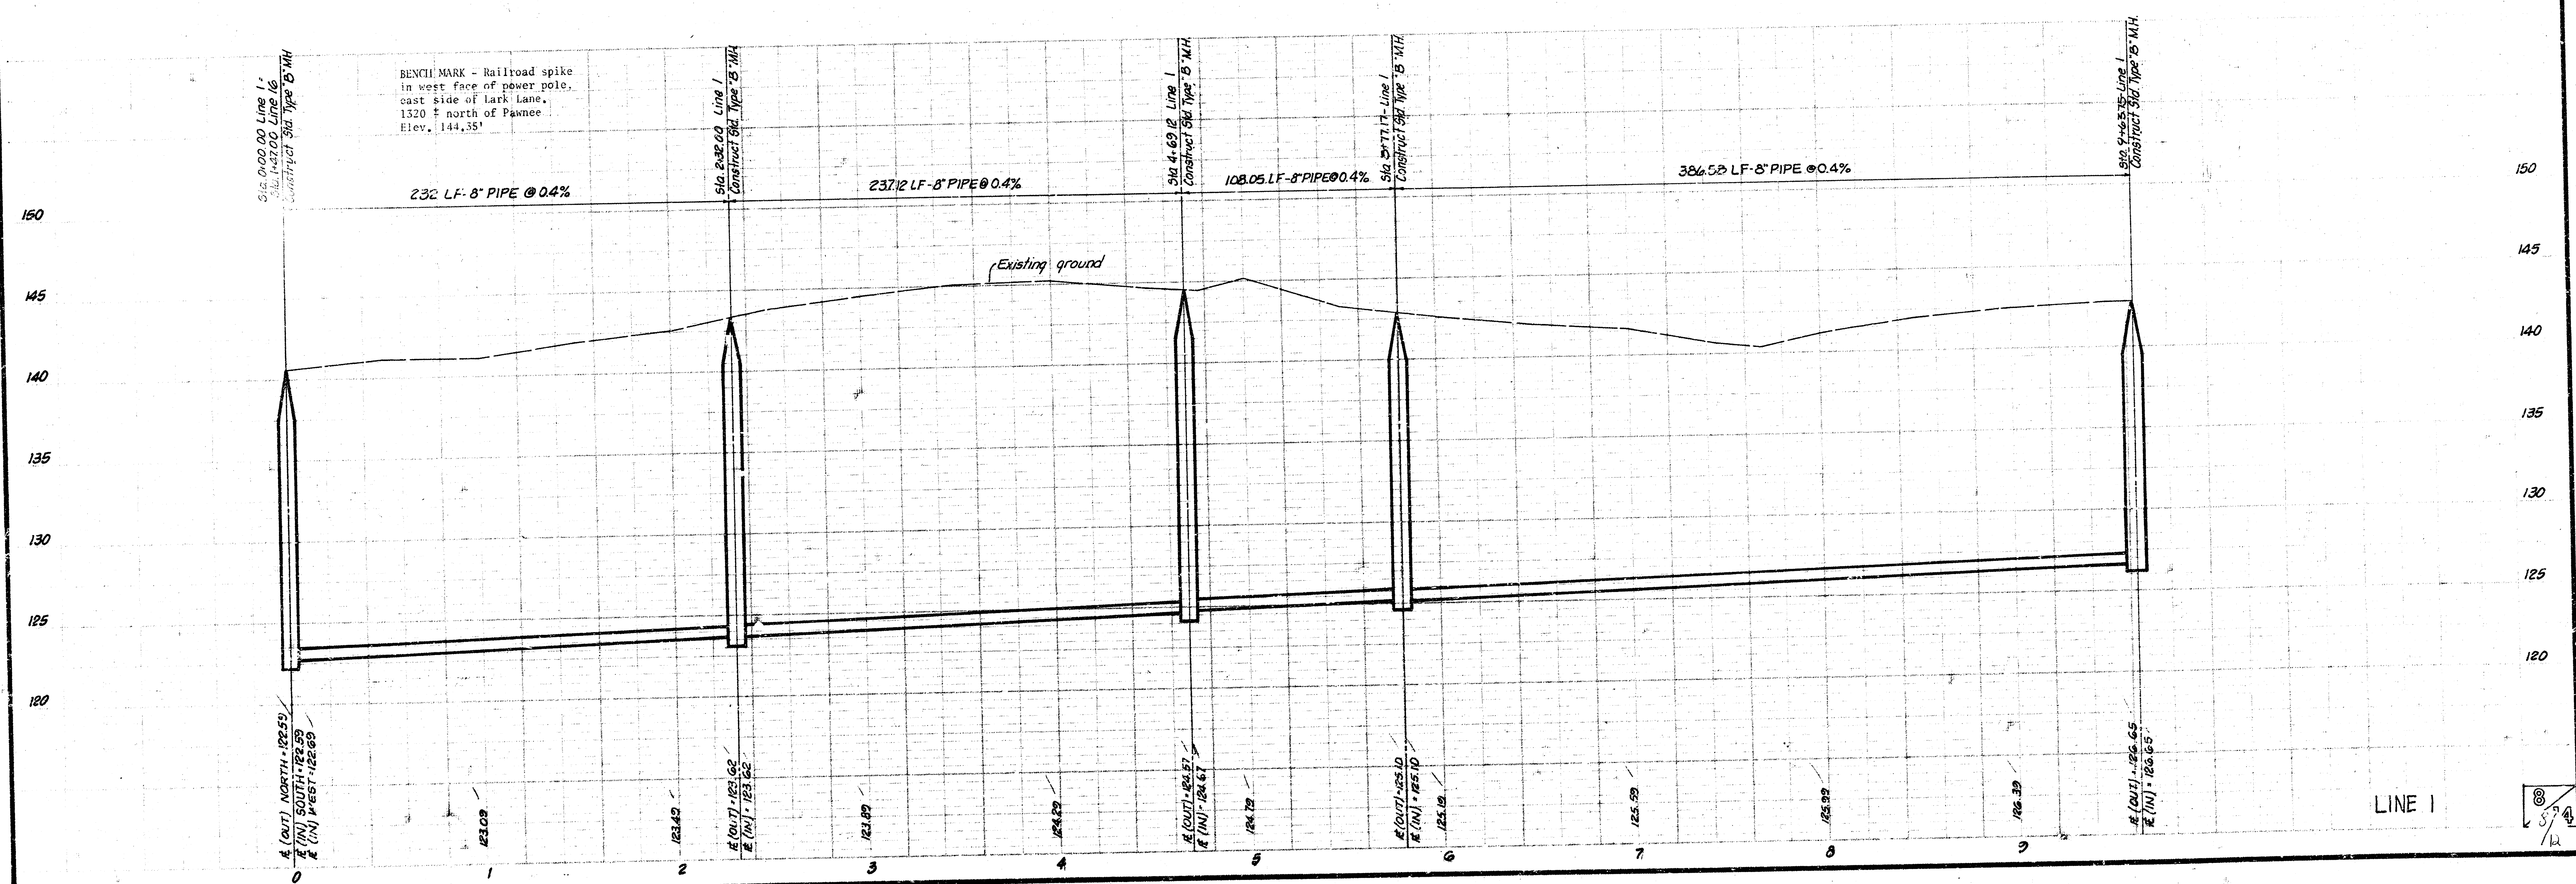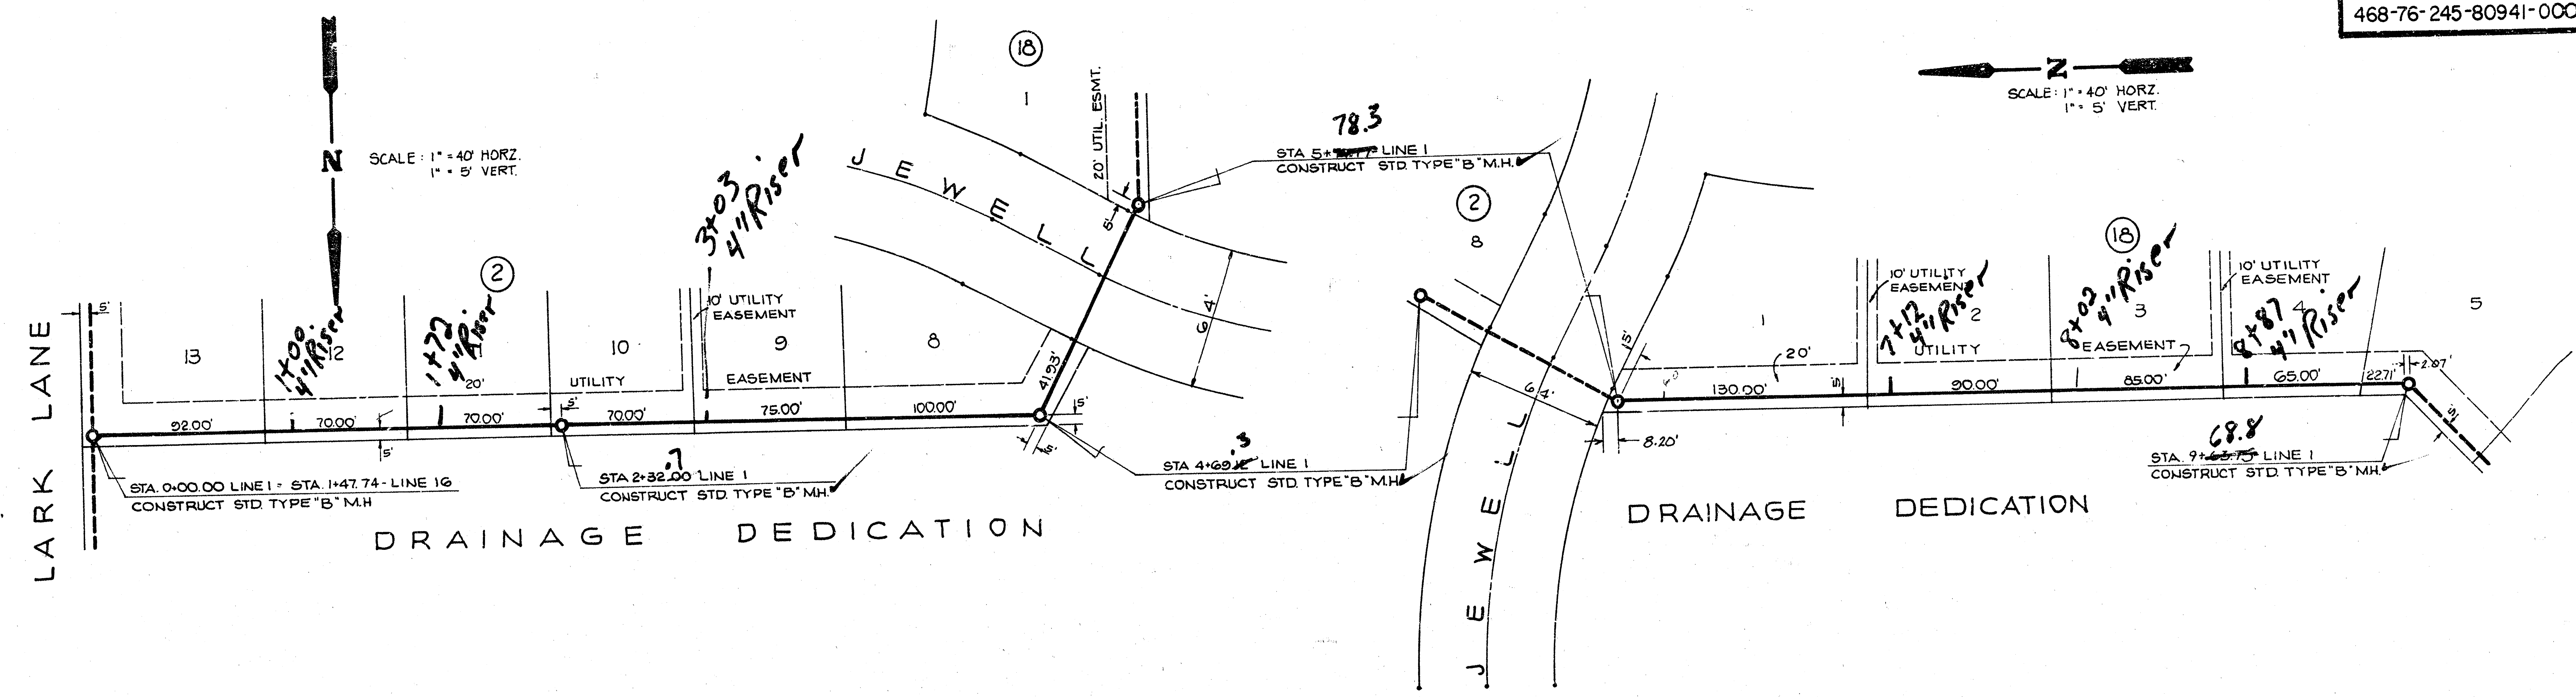




PROJECT NO.
468-76-245-80941-000-000-001

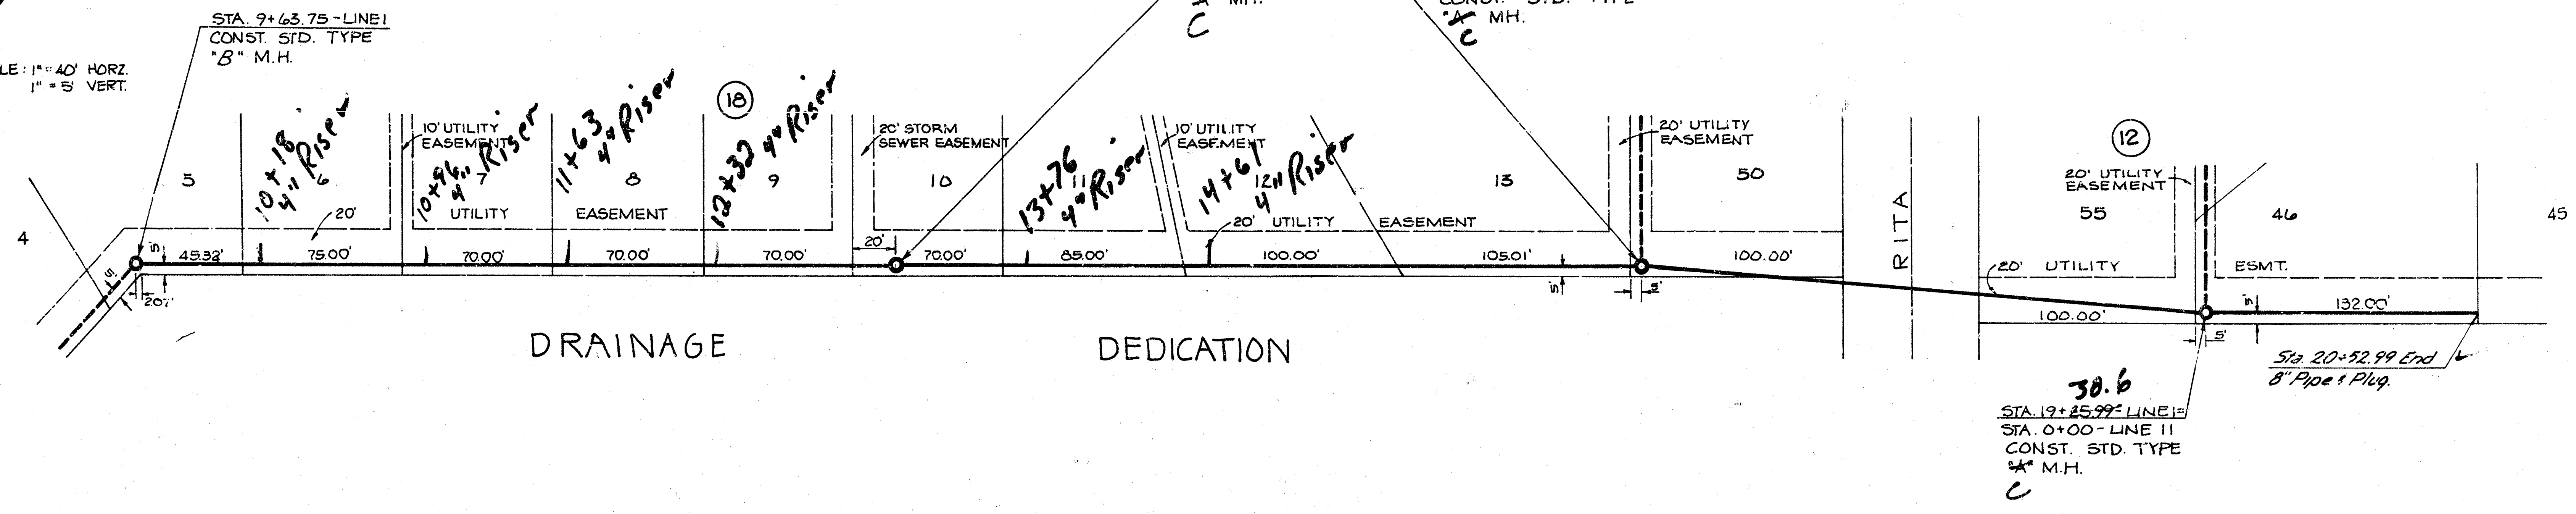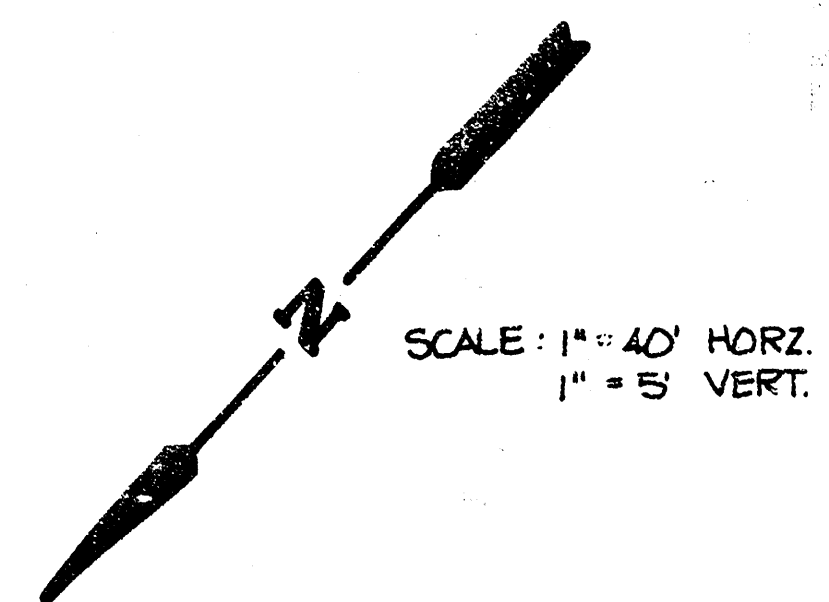

BENCH MARK - Railroad spike in west face of power pole, east side of Park Lane, 1320' north of Pawnee, Elev. 144.35'

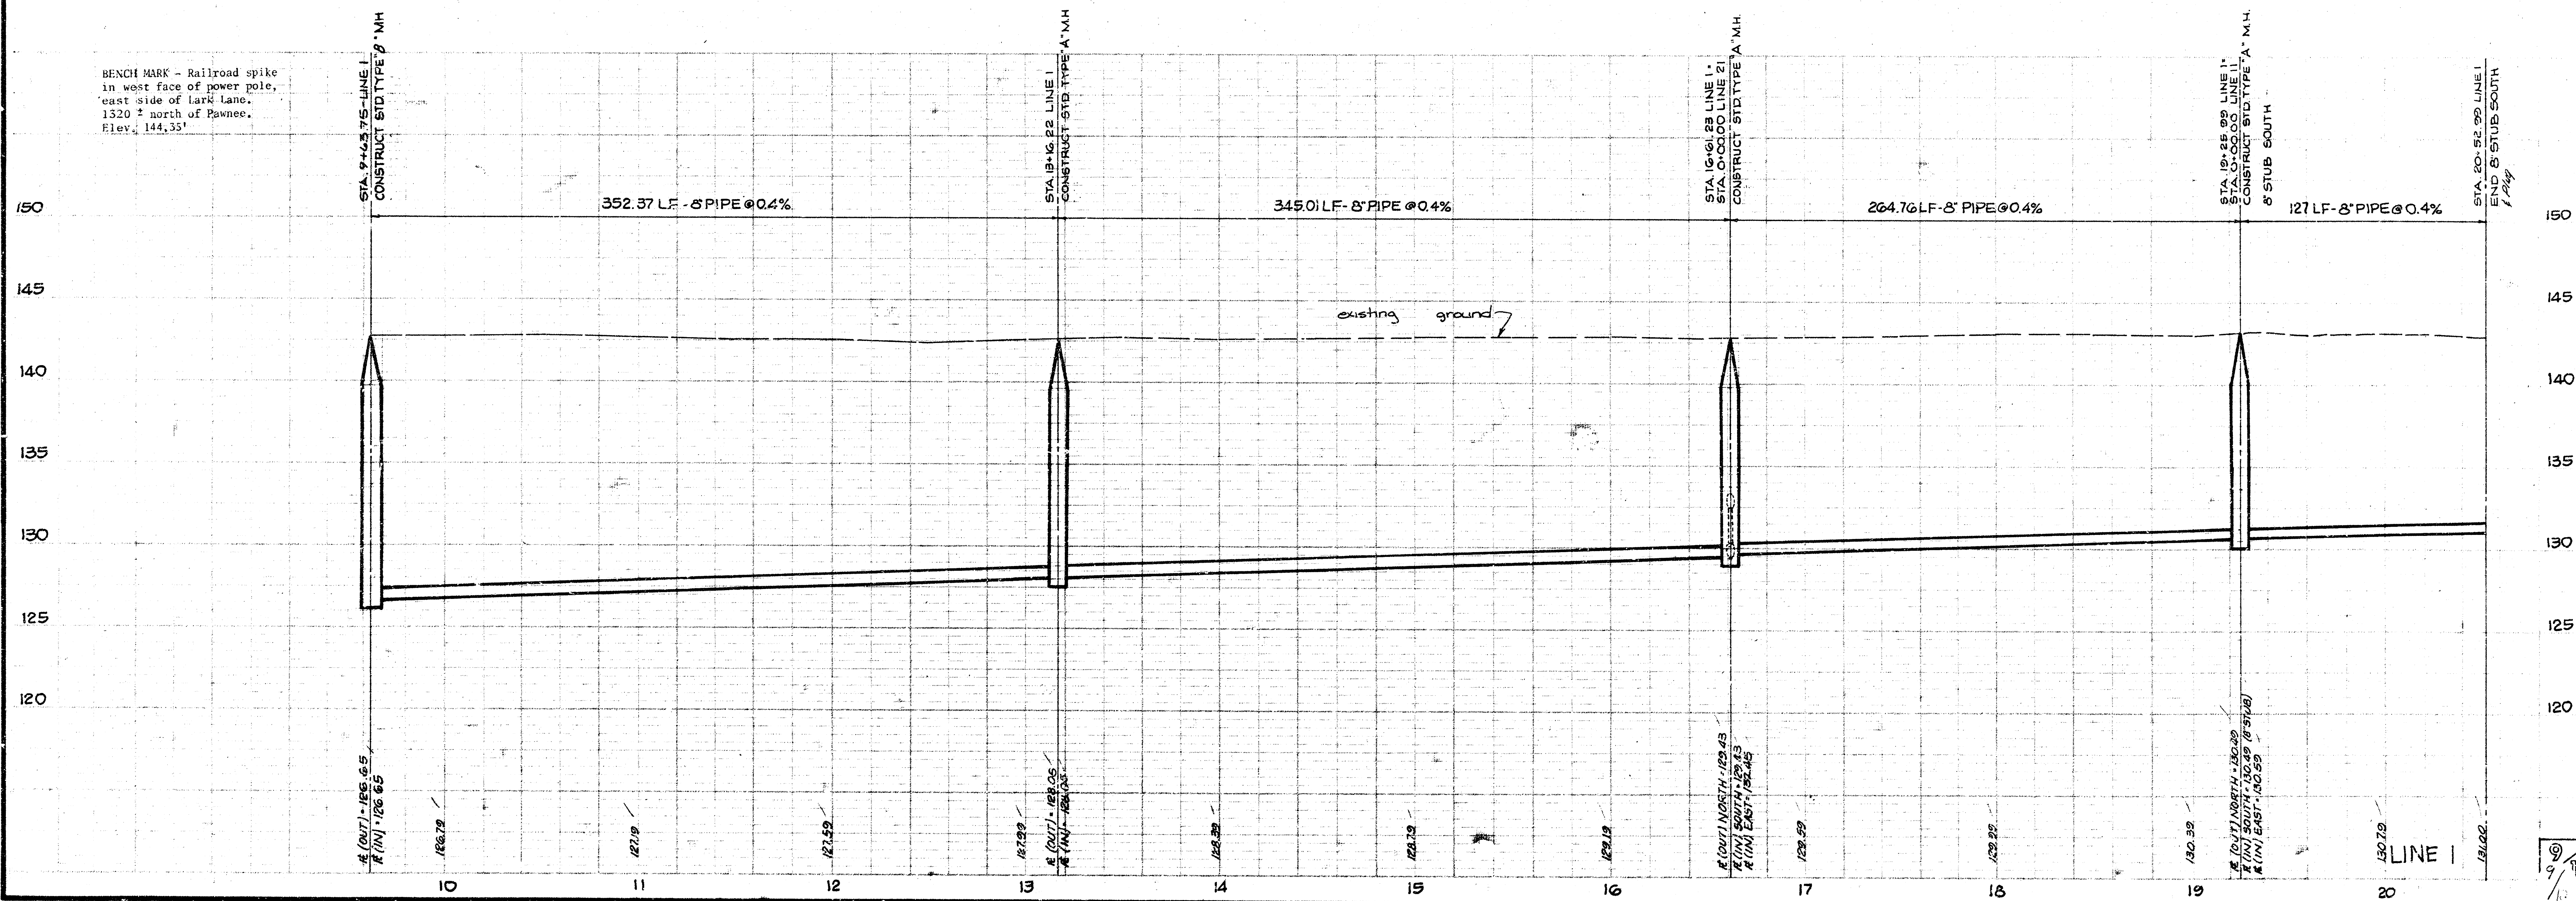


PROJECT NO.
468-76-245-80941-000-000-001

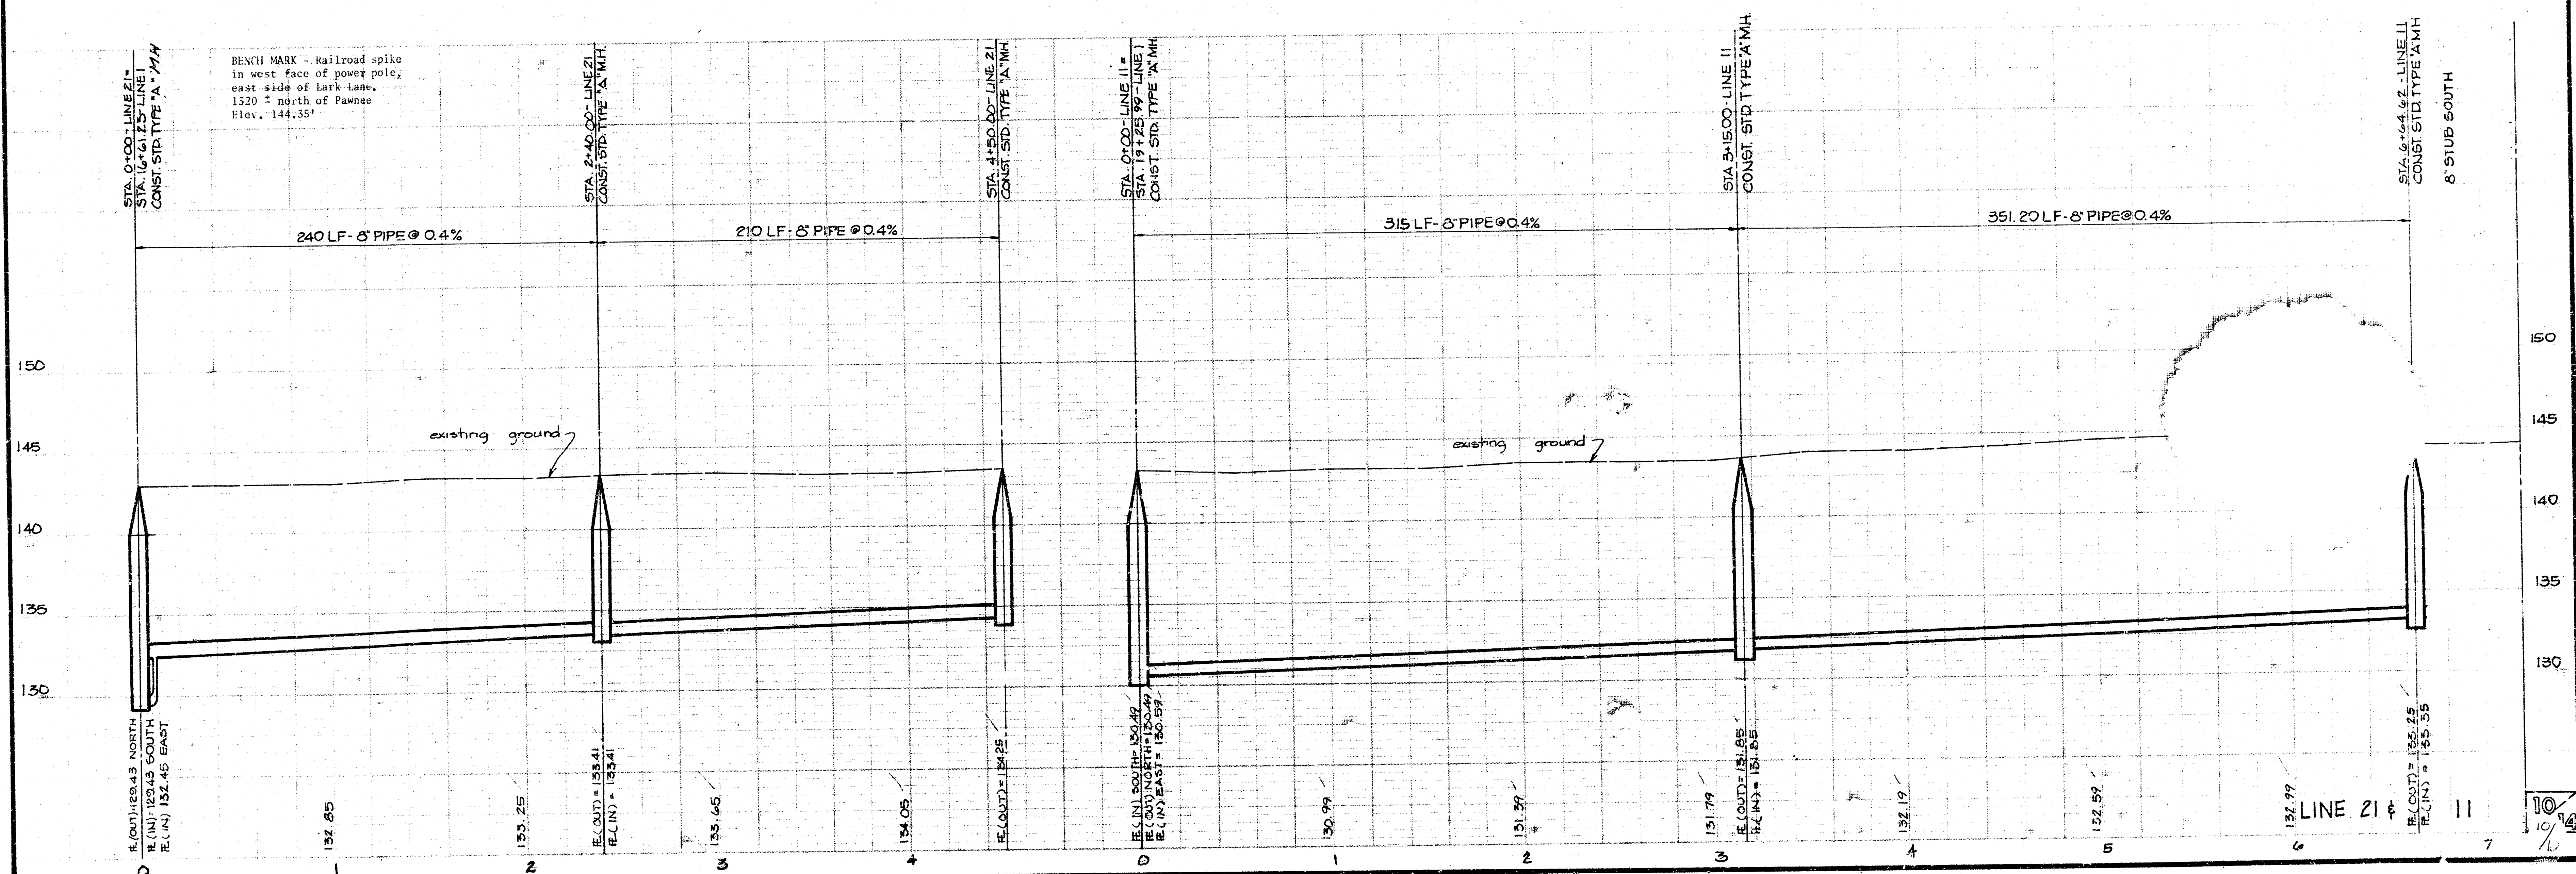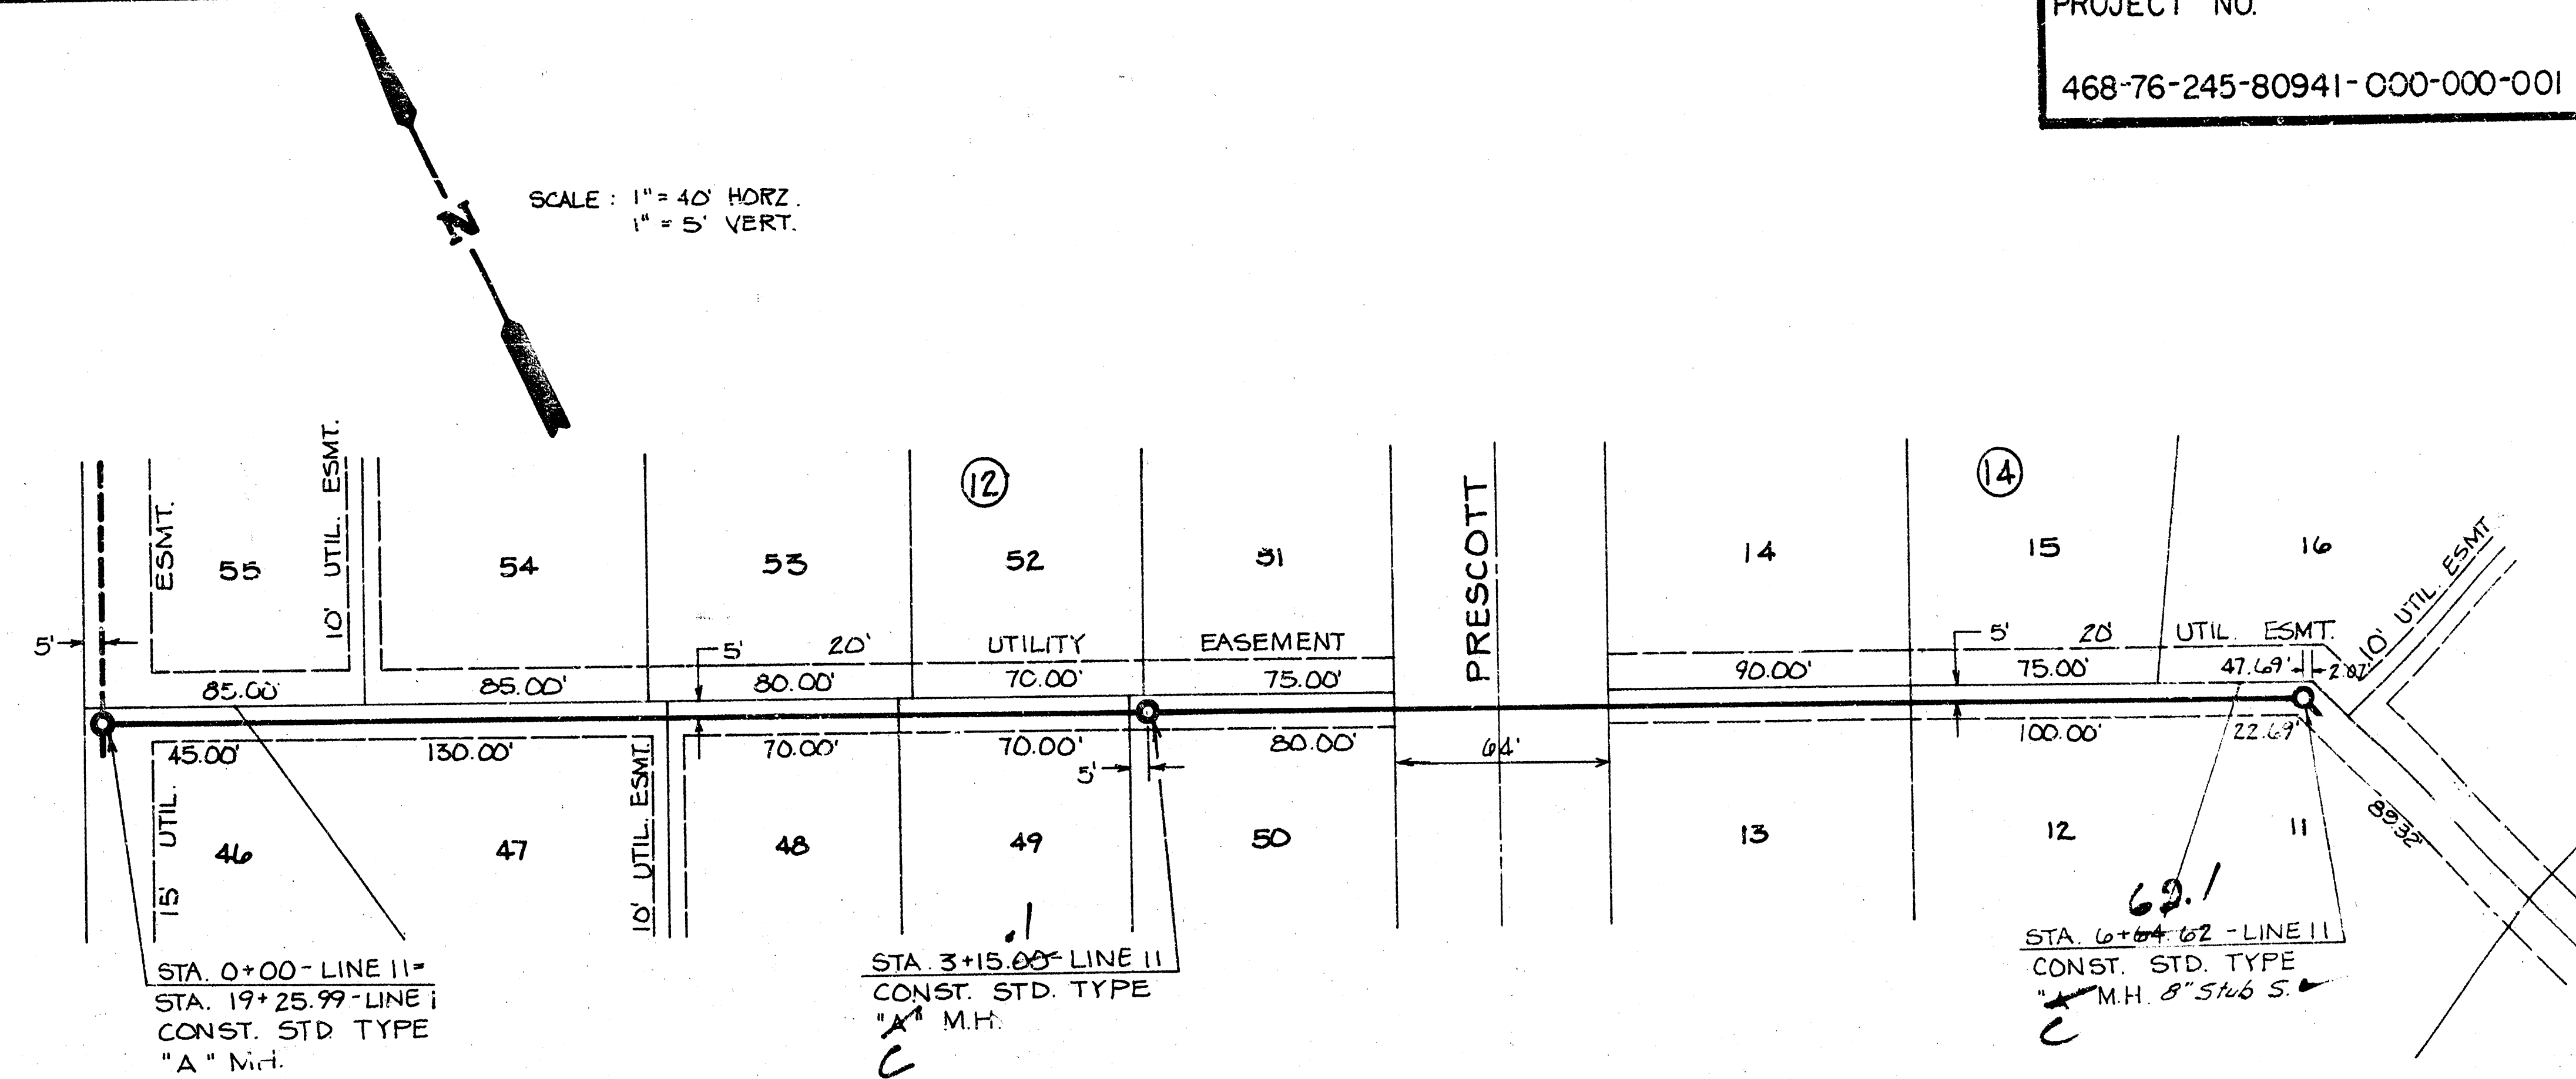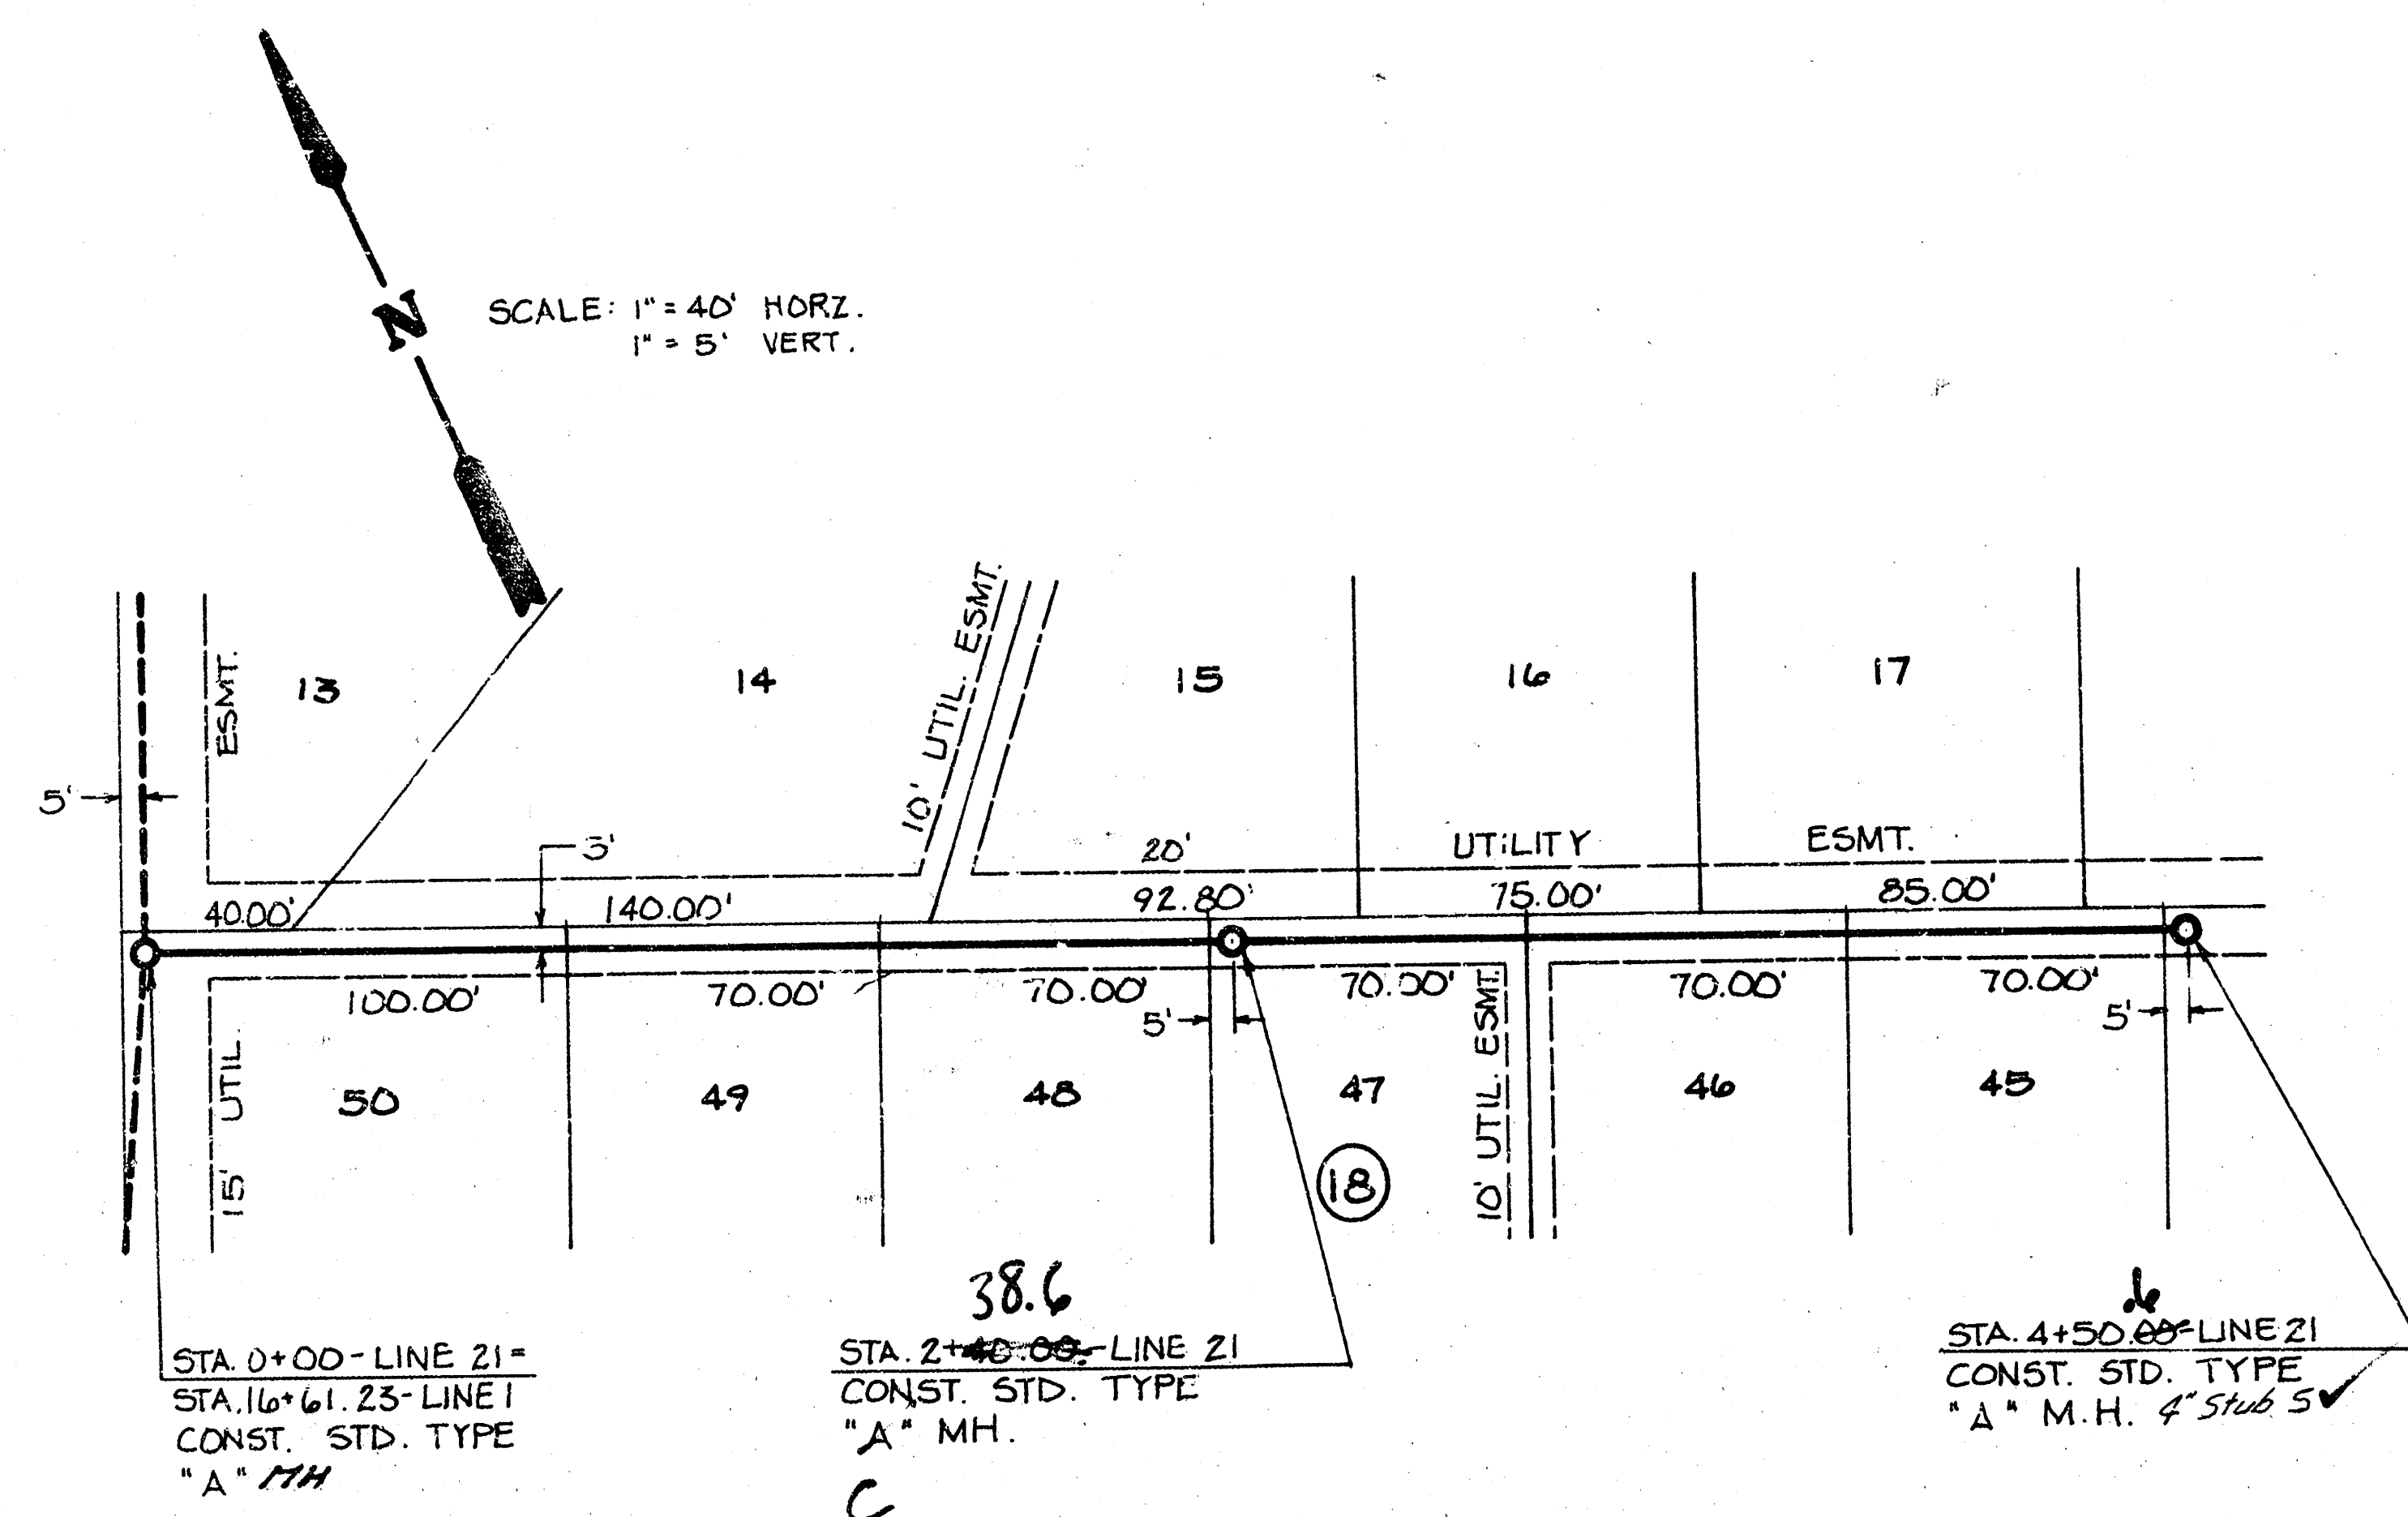

FINAL PLAT OF
PAWNEE MESA ADDITION

AN ADDITION TO SEDGWICK COUNTY, KANSAS

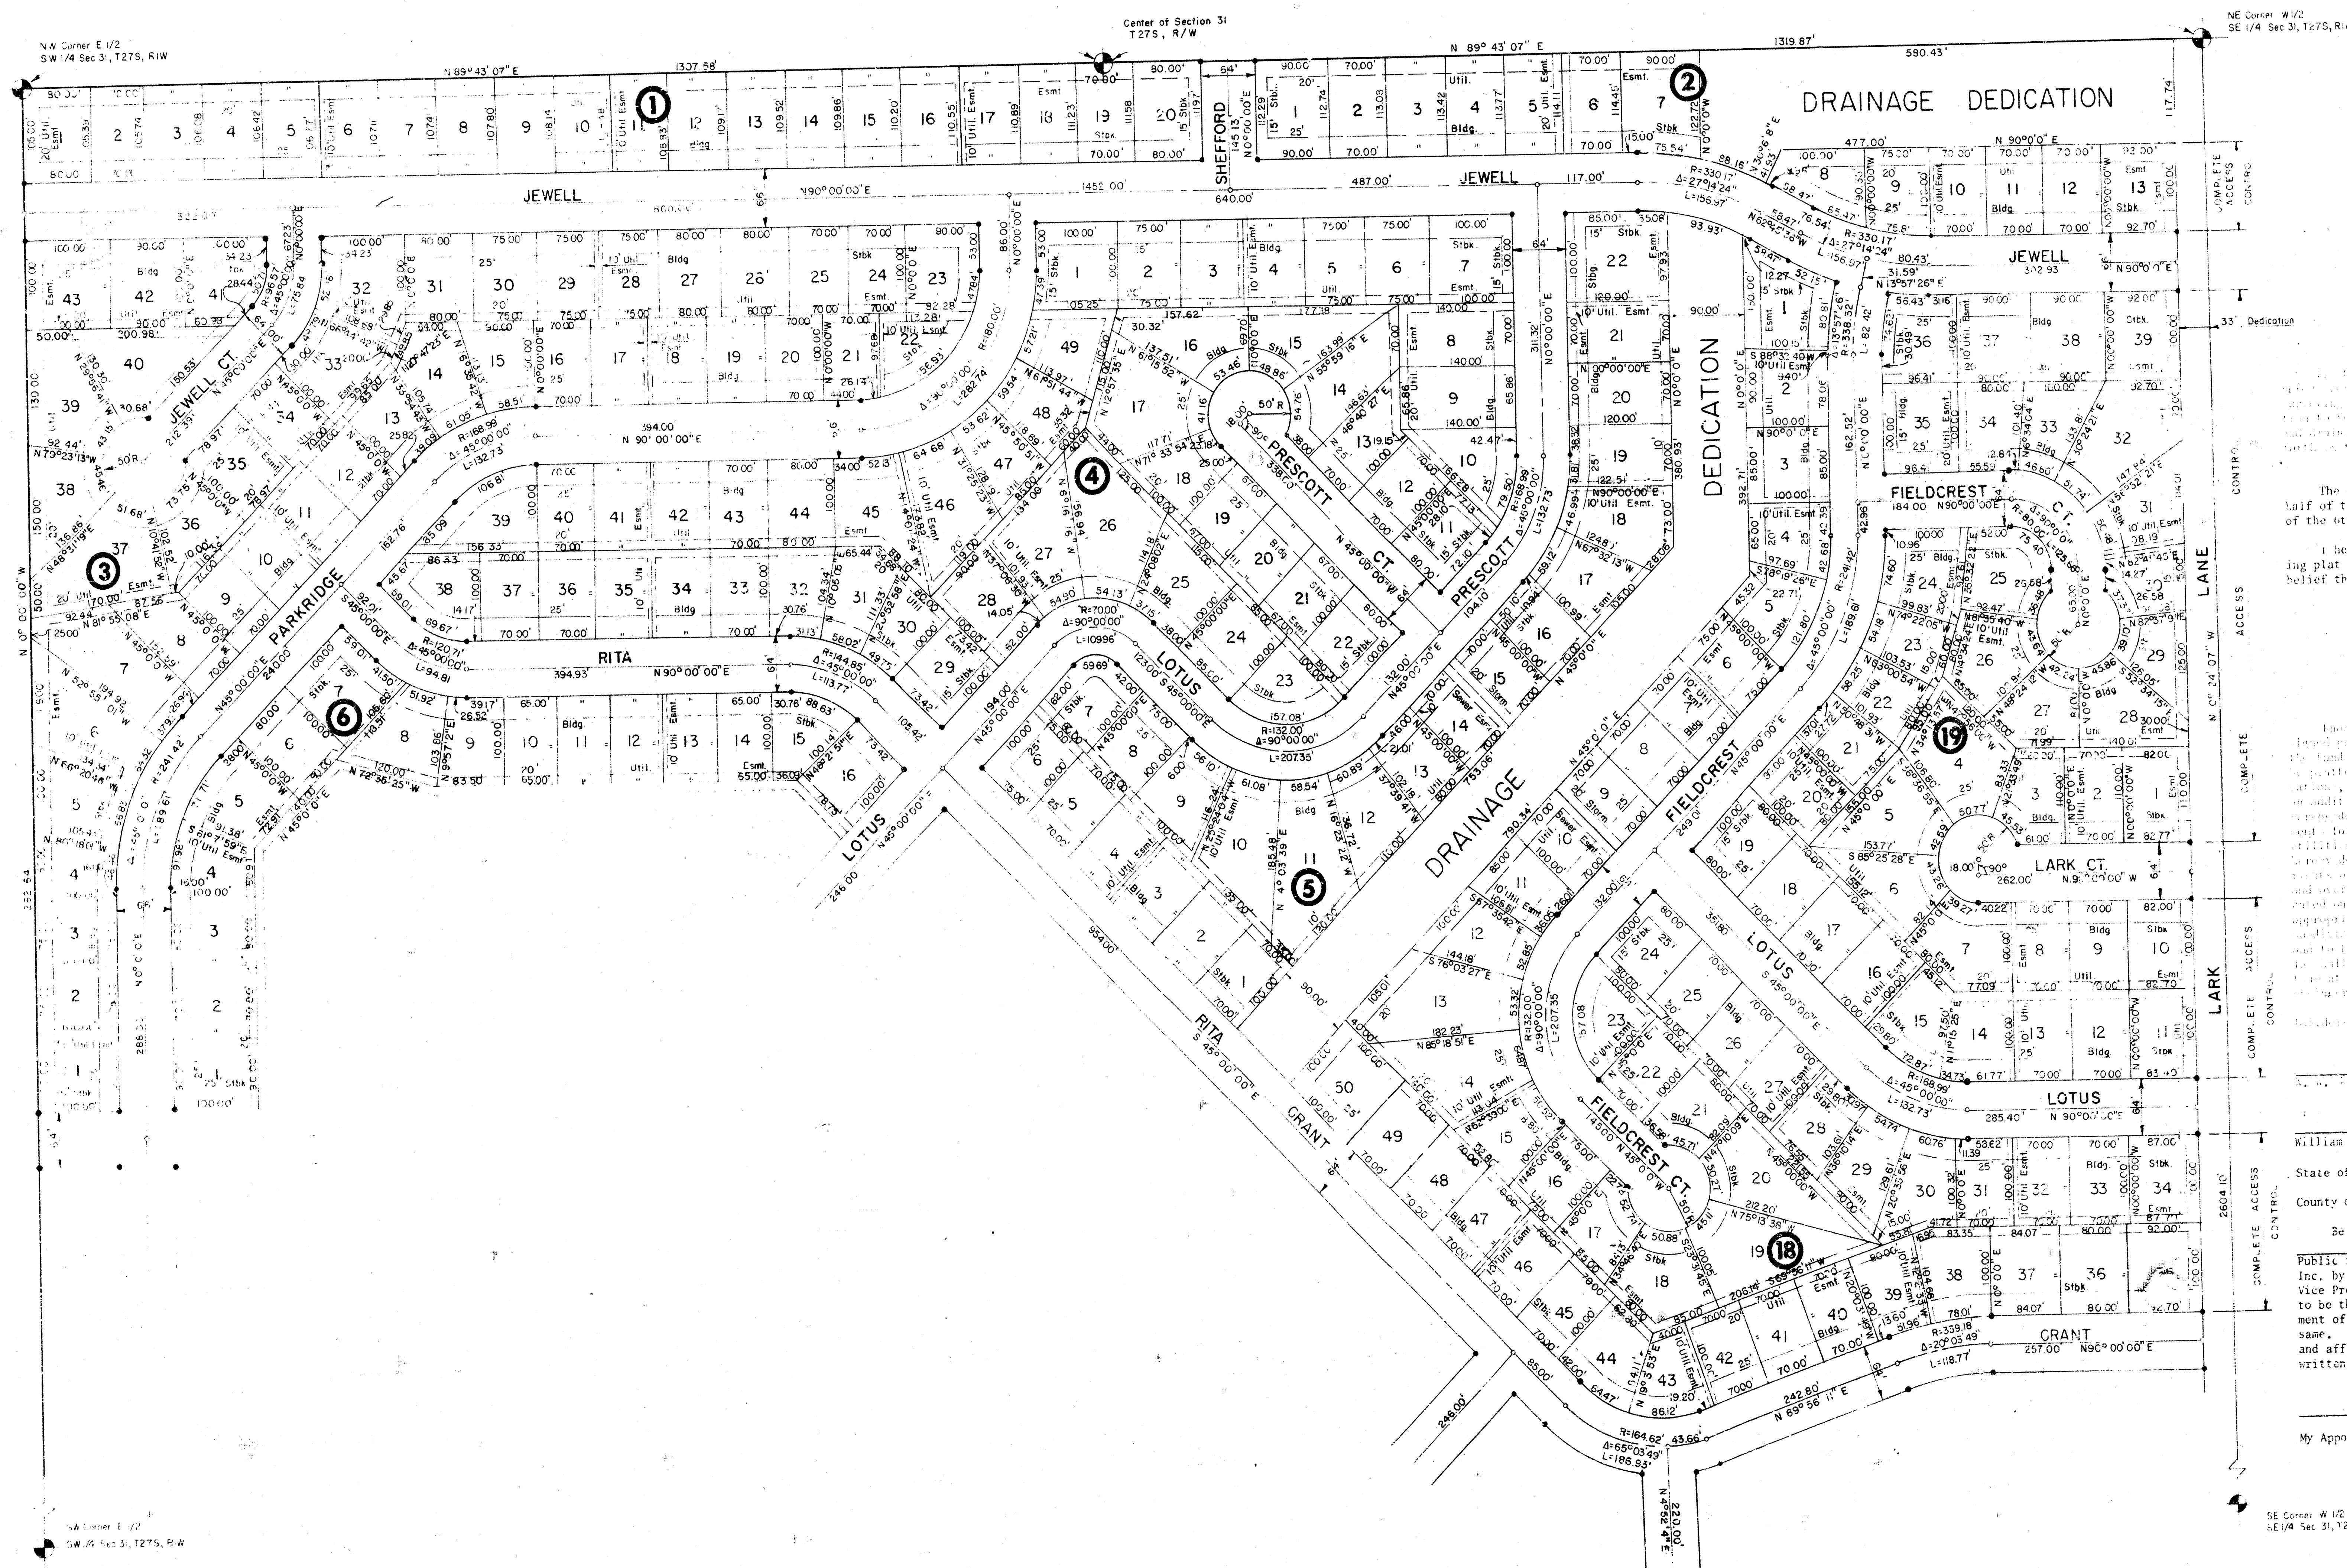

FINAL PLAT OF PAWNEE MESA ADDITION

AN ADDITION TO SEDGWICK COUNTY, KANSAS

SCALE 1" = 100'

NE Corner
W 1/2, SE 1/4
Sec 31, T27S, R. 10W

This plat of "Pawnee Mesa Addition" has been submitted to and approved by the Wichita-Sedgwick County Metropolitan Area Planning Commission, Wichita, Kansas.

Dated this _____ day of _____, 1980.

Wichita-Sedgwick County Metropolitan Area Planning Commission

Robert A. Lakin, Secretary

This plat approved and all dedications shown hereon, if any, accepted by the City Commission of the City of Wichita, Kansas this _____ day of _____, 1980.

Tony Casado, Mayor

Donald C. Glick, City Clerk

Entered on transfer record this _____ day of _____, 1980.

Dorothy K. White, County Clerk

This plat approved and all dedications shown hereon, if any, accepted by the Board of County Commissioners of Sedgwick County, Kansas this _____ day of _____, 1980.

Donald E. Gragg, Commissioner

Attest: _____, County Clerk

State of Kansas, ss:

County of Sedgwick,

This is to certify that this instrument was filed for record in the Register of Deeds Office at _____ on the _____ day of _____, 1980.

Bette E. McCurt, Register of Deeds

Fat Kettler, Deputy

ss: Dedication

Complete Access Control

SW Corner
W 1/2, SE 1/4
Sec 31, T27S, R. 10W