

**SANITARY SEWER IMPROVEMENTS
FOR
WESTWOOD HEIGHTS SECOND ADDITION**

LOTS 1 THROUGH 13 BLOCK 12. LOTS 1 THROUGH
3; 26, 27, and 31 THROUGH 33; BLOCK 13.

LATERAL 1, MAIN 15, S.W. INTERCEPTOR

PROJECT NUMBER



468-76-245-81738-000-000-001

CITY of WICHITA, KANSAS

MICHAEL E. LINDEBAK
CITY ENGINEER

GENERAL NOTES

- Underground utility service lines and overhead utility pole lines are to be adjusted as necessary by others prior to construction unless the plans specifically call for their adjustment by the Contractor or unless the plans specifically identify a utility to be adjusted by its owner during construction. Existing utilities and their location, as shown on the plans, represent the best information obtainable for design. The Contractor will be required to work around existing utilities within the right-of-way which do not conflict with proposed construction.
- The Contractor shall be responsible for preserving property irons. The Contractor will be required to re-establish any property irons which are damaged or destroyed by his construction operations. Such irons shall be re-established by a licensed land surveyor in accordance with state laws.

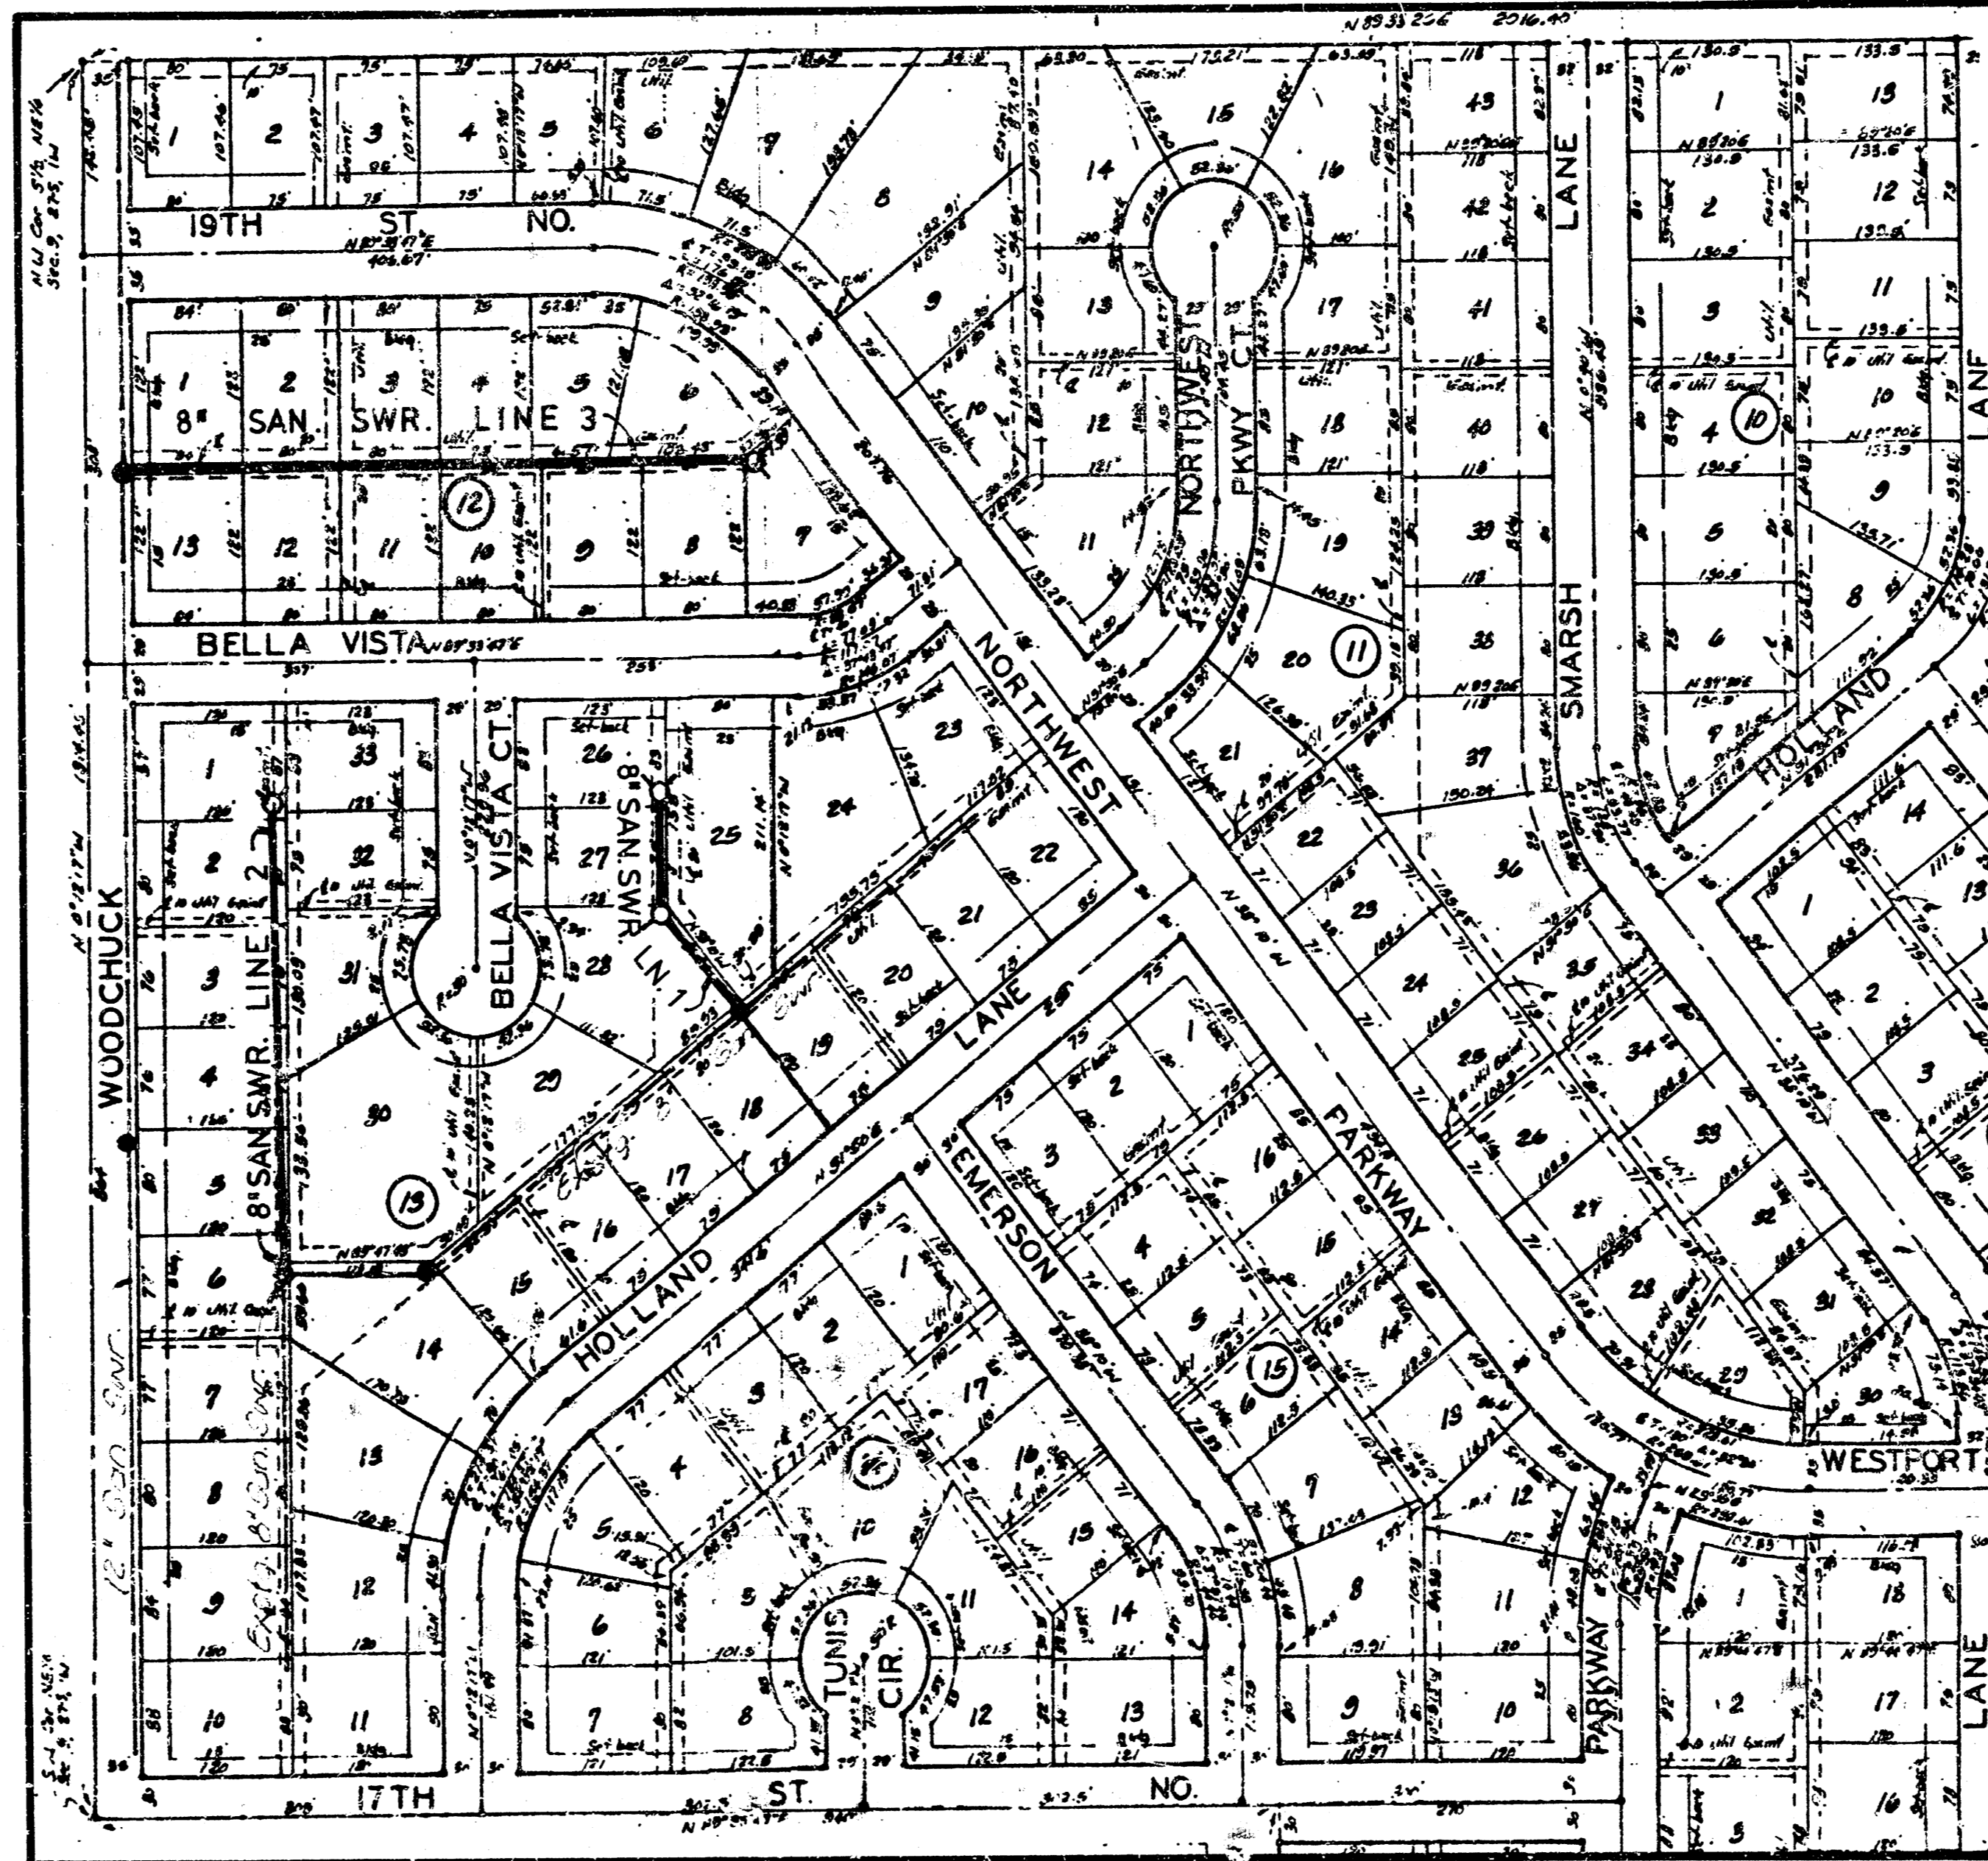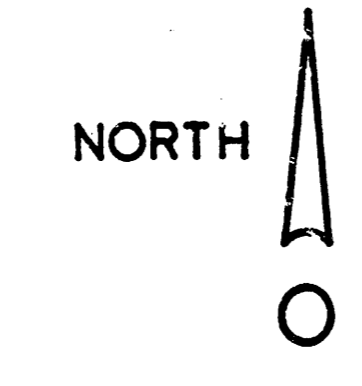

INDEX of SHEETS

- TITLE SHEET
- PLAN/PROFILE-LINE 1 & LINE 2 (BLK.13)
- PLAN/PROFILE-LINE 3 (BLK.12)
- DETAIL SHEET (TYPE "P" & "C" STD. SHALLOW MANHOLE)


BENCHMARKS

- Cut in top of curb 19ft. NWly of SWly cor. Lot 21 Blk. 11 Westwood Heights 2nd Addition
Elev. = 155.47 City datum
- R.R. Spike in "lone" tree (NWly side) 193ft. So. & 47ft. W. of NE. Cor. Lot 15, Blk. 2 Westlink Village 16th Addn.
Elev. = 157.75 City datum

**WESTWOOD HEIGHTS SECOND
ADDITION**

□ IMPROVEMENT DISTRICT

*AS BUILT
7-88
RDL*

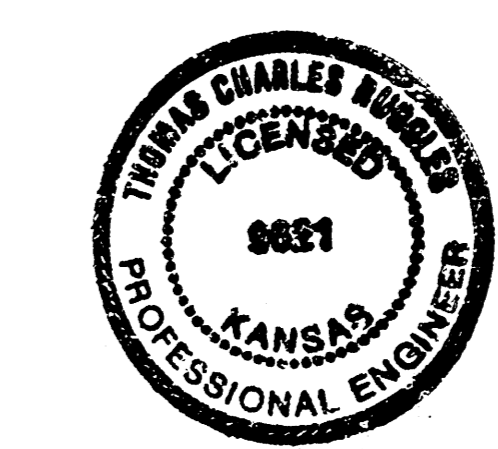



TITLE SHEET

BAUGHMAN COMPANY, P.A.				Sheet 1 of 4
SURVEYING & ENGINEERING 316262-7271 • 315 ELLIS • WICHITA, KANSAS 67211				
Drawn <i>T. Ruggles</i>	Check <i>Stallr.</i>	Approved <i>G. Apr. 88</i>	Date <i>as noted</i>	

**FILMED FROM THE BEST
AVAILABLE COPY**

DATE	
BY	
CHECKED	
NO. BA-18	
DATE	
BY	
CHECKED	
NO. BA-18	

DATE	
BY	
CHECKED	
NO. BA-18	
DATE	
BY	
CHECKED	
NO. BA-18	

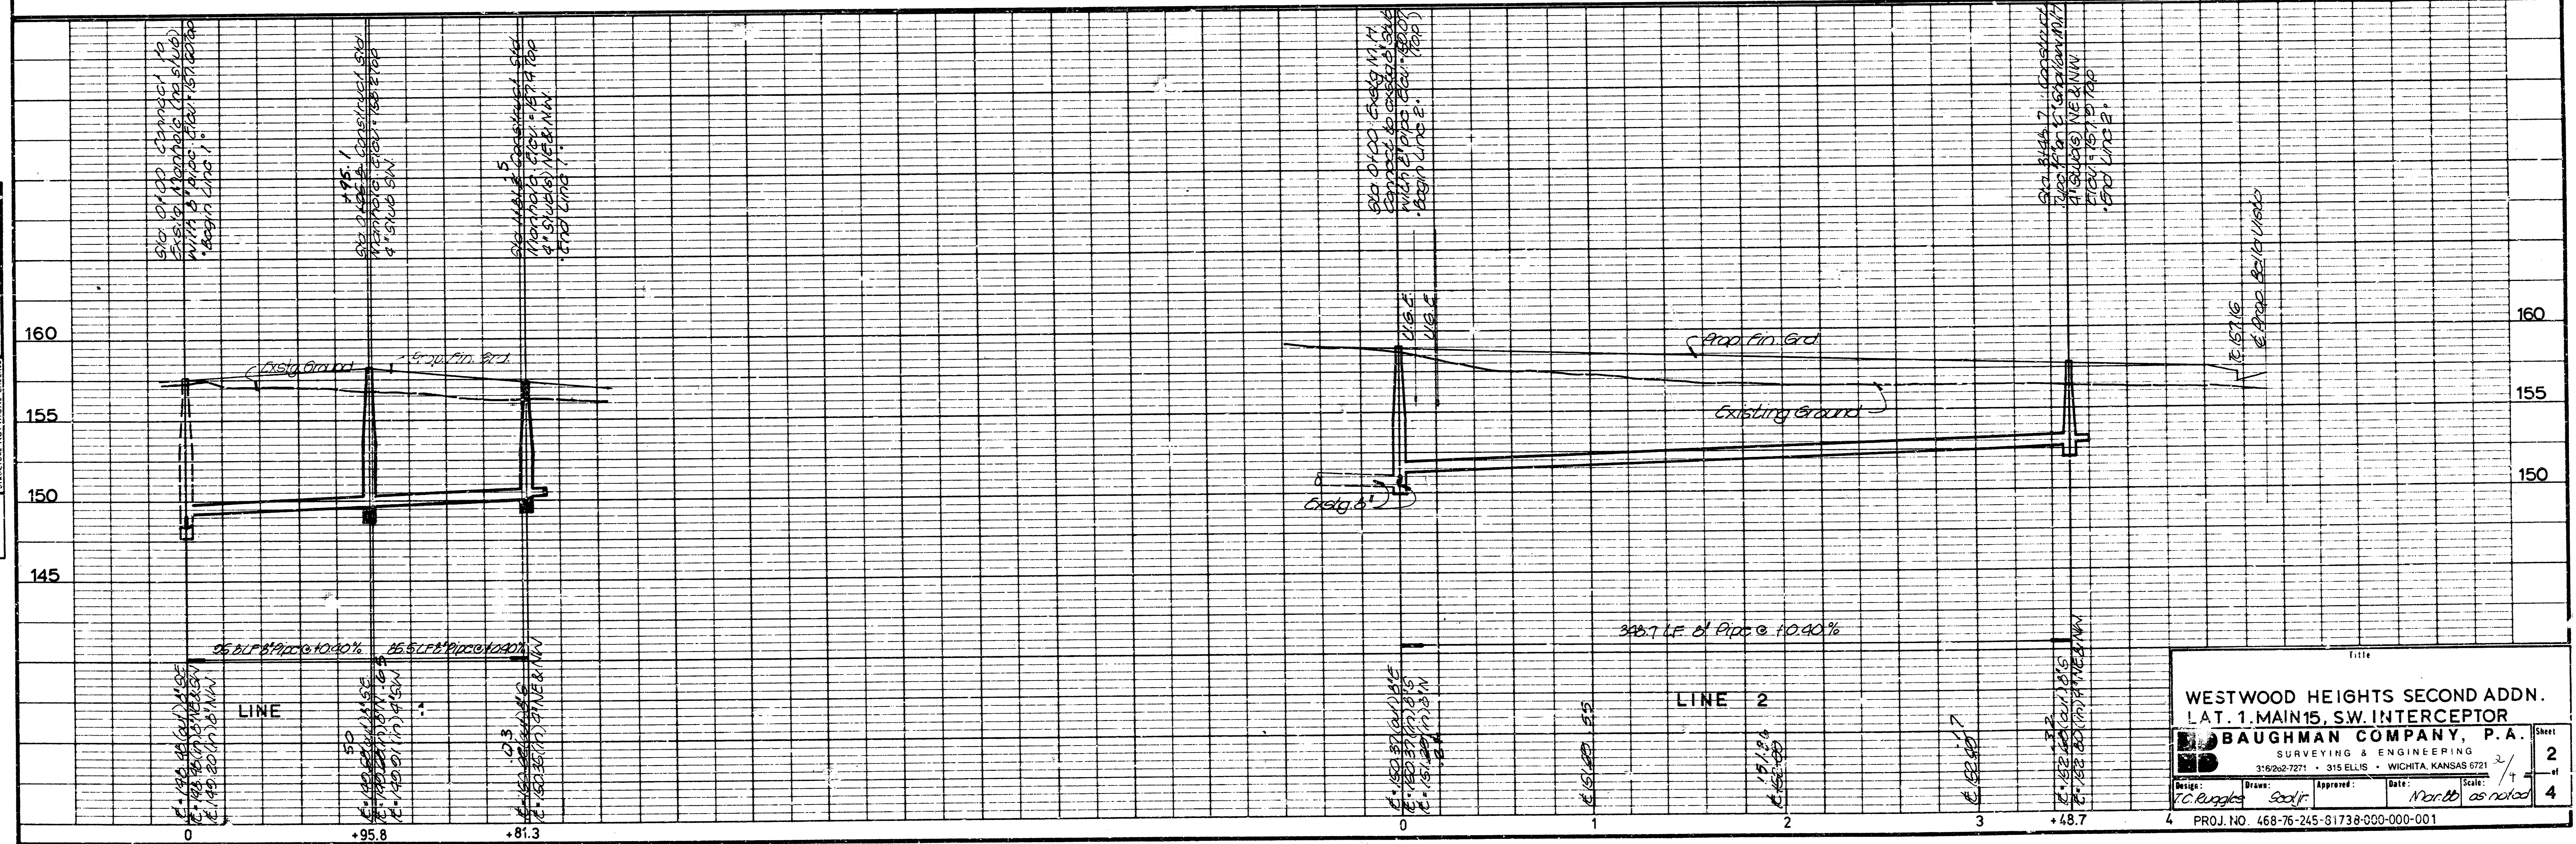
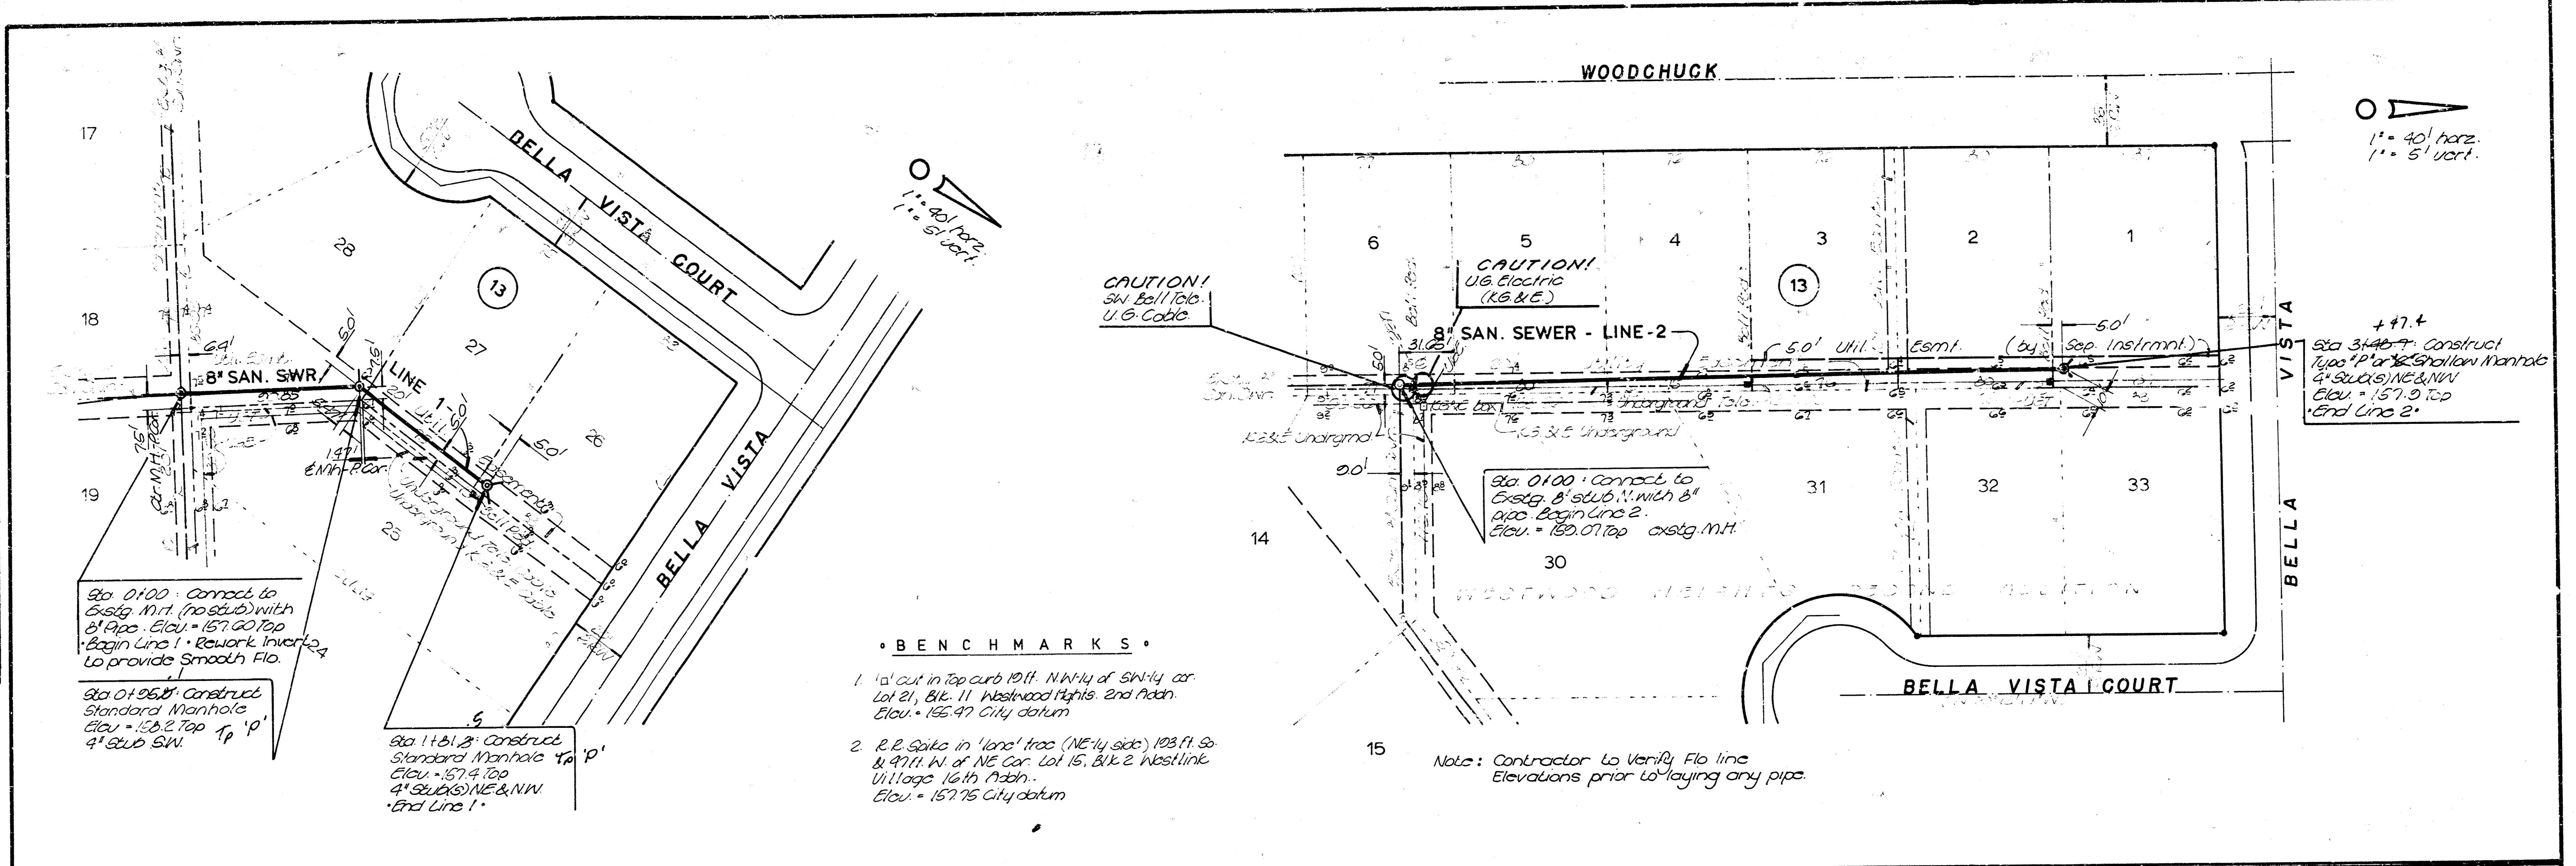


WESTWOOD HEIGHTS SECOND ADDN.
 AT 1. MAIN 15, SW INTERCEPTOR

BAUGHMAN COMPANY, P.A.
 SURVEYING & ENGINEERING
 315 ELLIS • WICHITA, KANSAS 6721

Scale: 1" = 40' horiz. / 1" = 5' vert.
 Date: 10/1/80
 Project No. 468-76-245-81738-000-000-001

FILMED FROM THE BEST AVAILABLE COPY

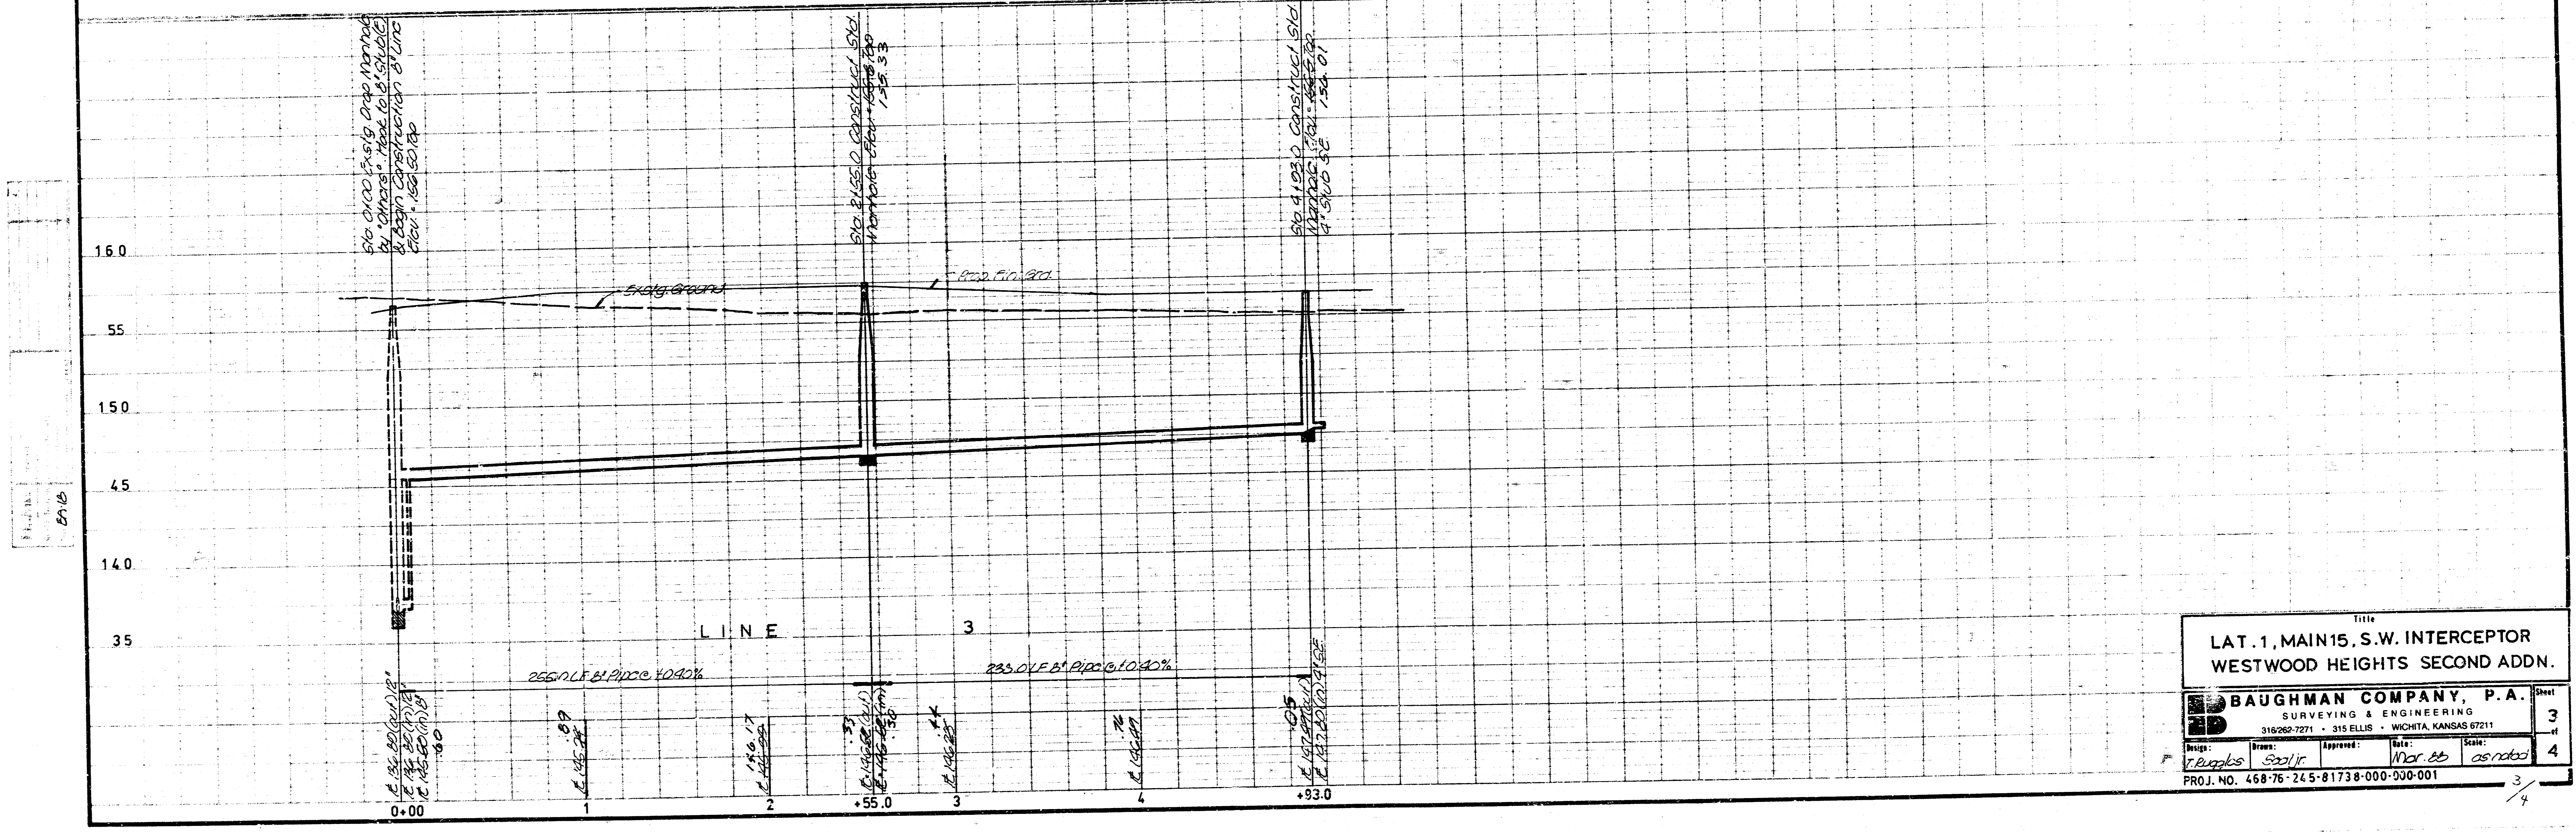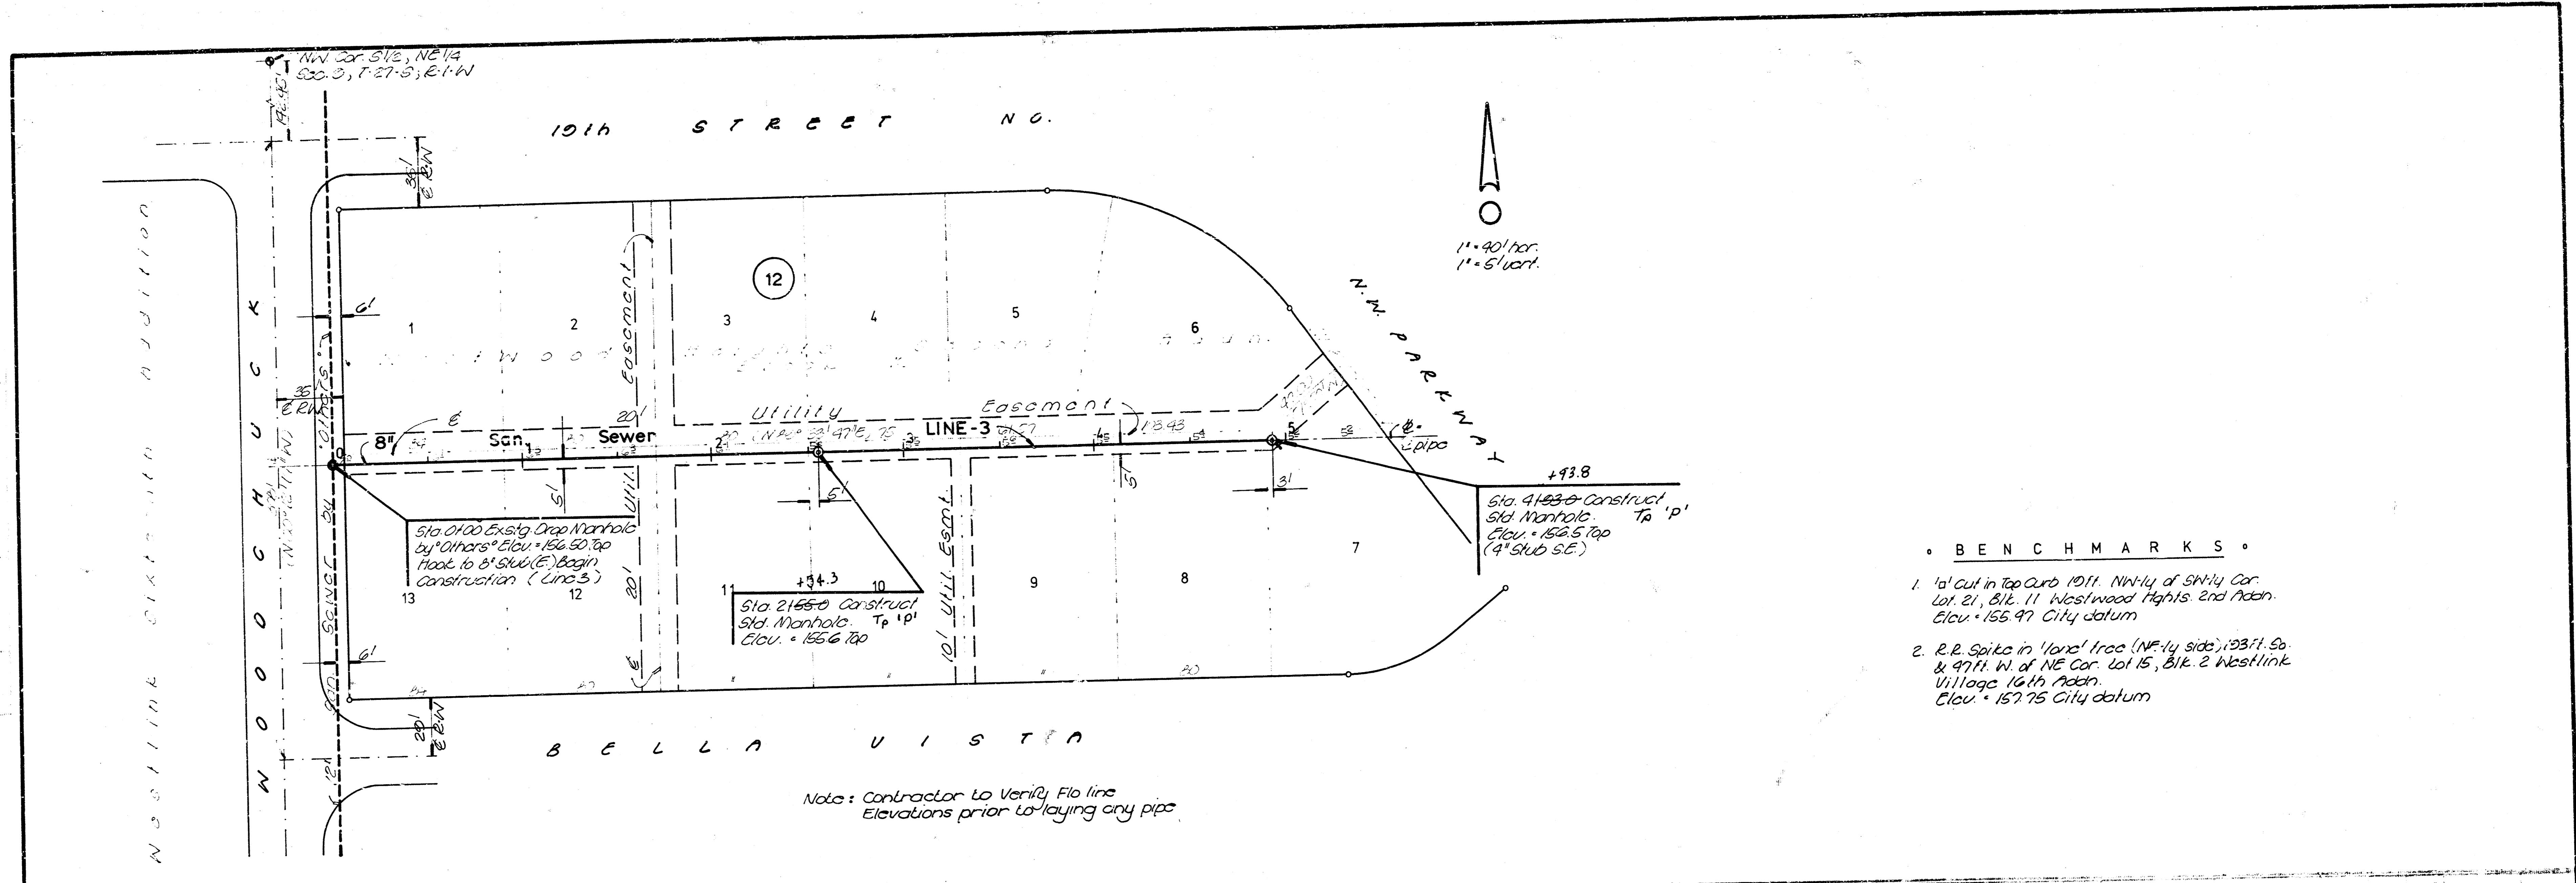

Title
LAT. 1, MAIN 15, S.W. INTERCEPTOR
WESTWOOD HEIGHTS SECOND ADDN.

BAUGHMAN COMPANY, P.A.
SURVEYING & ENGINEERING
316-262-7271 • 315 ELLIS • WICHITA, KANSAS 67211

Design: <i>W. Ruppels</i>	Drawn: <i>Scott R.</i>	Approved: <i>Mar. 03</i>	Date: <i>03/03</i>	Scale: <i>as noted</i>	Sheet: <i>3</i>
PROJ. NO. 468-76-245-81738-000-001					4

FILMED FROM THE BEST AVAILABLE COPY.....

