

B. M. 144.12 Top of bolt N. E. cor.
concrete sign at S.W. cor.
Hillside and Central.

B. M. 149.64 "a" Top W-ab Hillside
@ S. L. Pine extended.

B. M. 149.19 "a" Top curb S. Ret.
S.W. cor. Murdock - Hillside.

NOTE:
Bid price of manhole
Remove is to include
the removal of the
top 1/2 of manhole.
Plugging of pipes
and filling of sand.

NOTE: Remove top 1/2
exist. manhole.
Plug Pipes.
Fill with sand.

NOTE: Exist. K.G.E.
Underground Conduit.




NOTE: Remove top 1/2
exist. manhole.
Plug Pipes
Fill with sand.

NOTE: Plug Pipe South

Plan Scale 1" = 40' Horiz.
Profile Scale 1" = 5' Vert.

NOTE: THIS PROJECT SHALL BE COORDINATED WITH
CONSTRUCTION OF WESLEY MEDICAL CENTER PARKING
GARAGE SUCH THAT PINE AND MURDOCK WILL NOT
BE CLOSED AT THE SAME TIME AND SUCH THAT
CONSTRUCTION OF THE SEWER ACROSS PINE WILL
NOT OCCUR WHILE PINE IS CLOSED FOR CONSTRUCTION
OF TUNNEL IN CONNECTION WITH PARKING GARAGE.

WESLEY MEDICAL CENTER
THIRD ADDITION

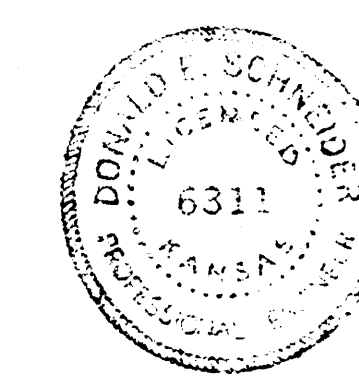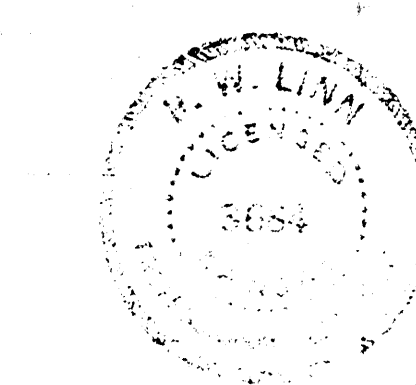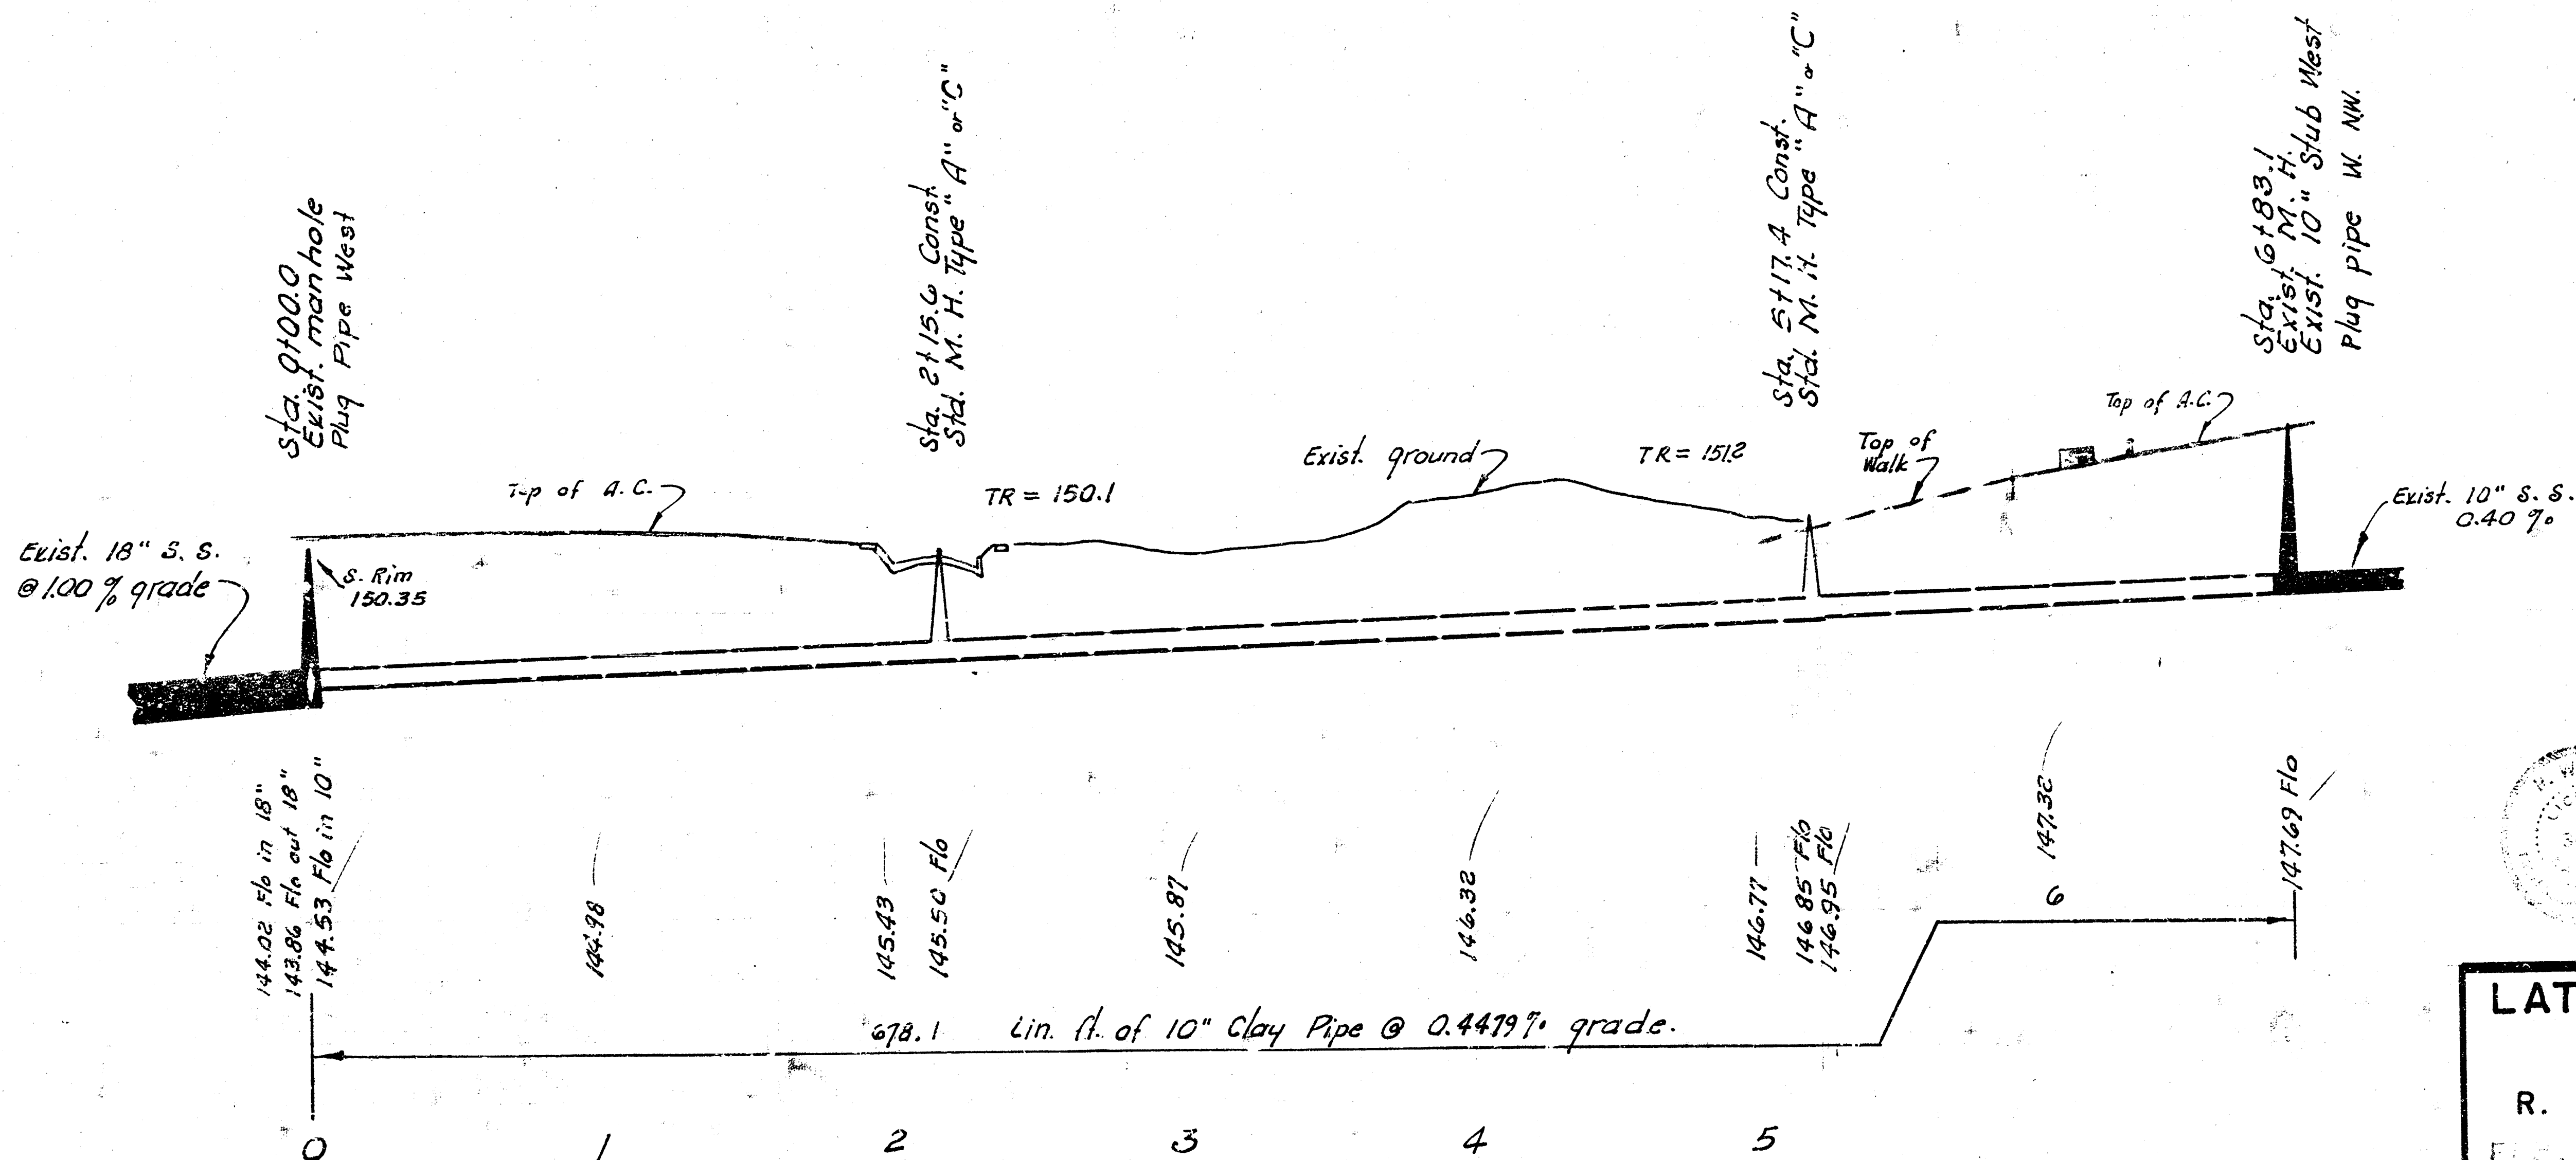

As Built 10-15-75

LAT. 2, WESLEY INTERCEPTER SEWER
CITY OF WICHITA, KANSAS
R. W. LINN — CITY ENGINEER
1975 PROJECT NO. DBKL 5740 82