


Survey by D.L.K.
Planned by J.W.W.
Checked by

B. M. 151.97 W. rim exist. M. H.
Sta. 0+00.0 Lat. 49.
Westlink Sewer. N. of
intersection of Emerson Ave.
and Wilbur Lane.



SECOND ADDITION TO SUNSET MANOR WEST

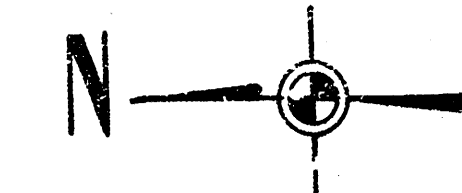

Plan Scale 1" = 40'
Profile Scale 1" = 4' Vert.

B. M. 155.17 Top W. rim exist. M. H.
44' W. & 3' S. of the S. C.
cor lot 2 Blk 6 Second Addn
to Sunset Manor West.

Note: Reconstructed line to a
point 81.7 ft. N.E. of Sta. 0+00
as this line was out of
Easement

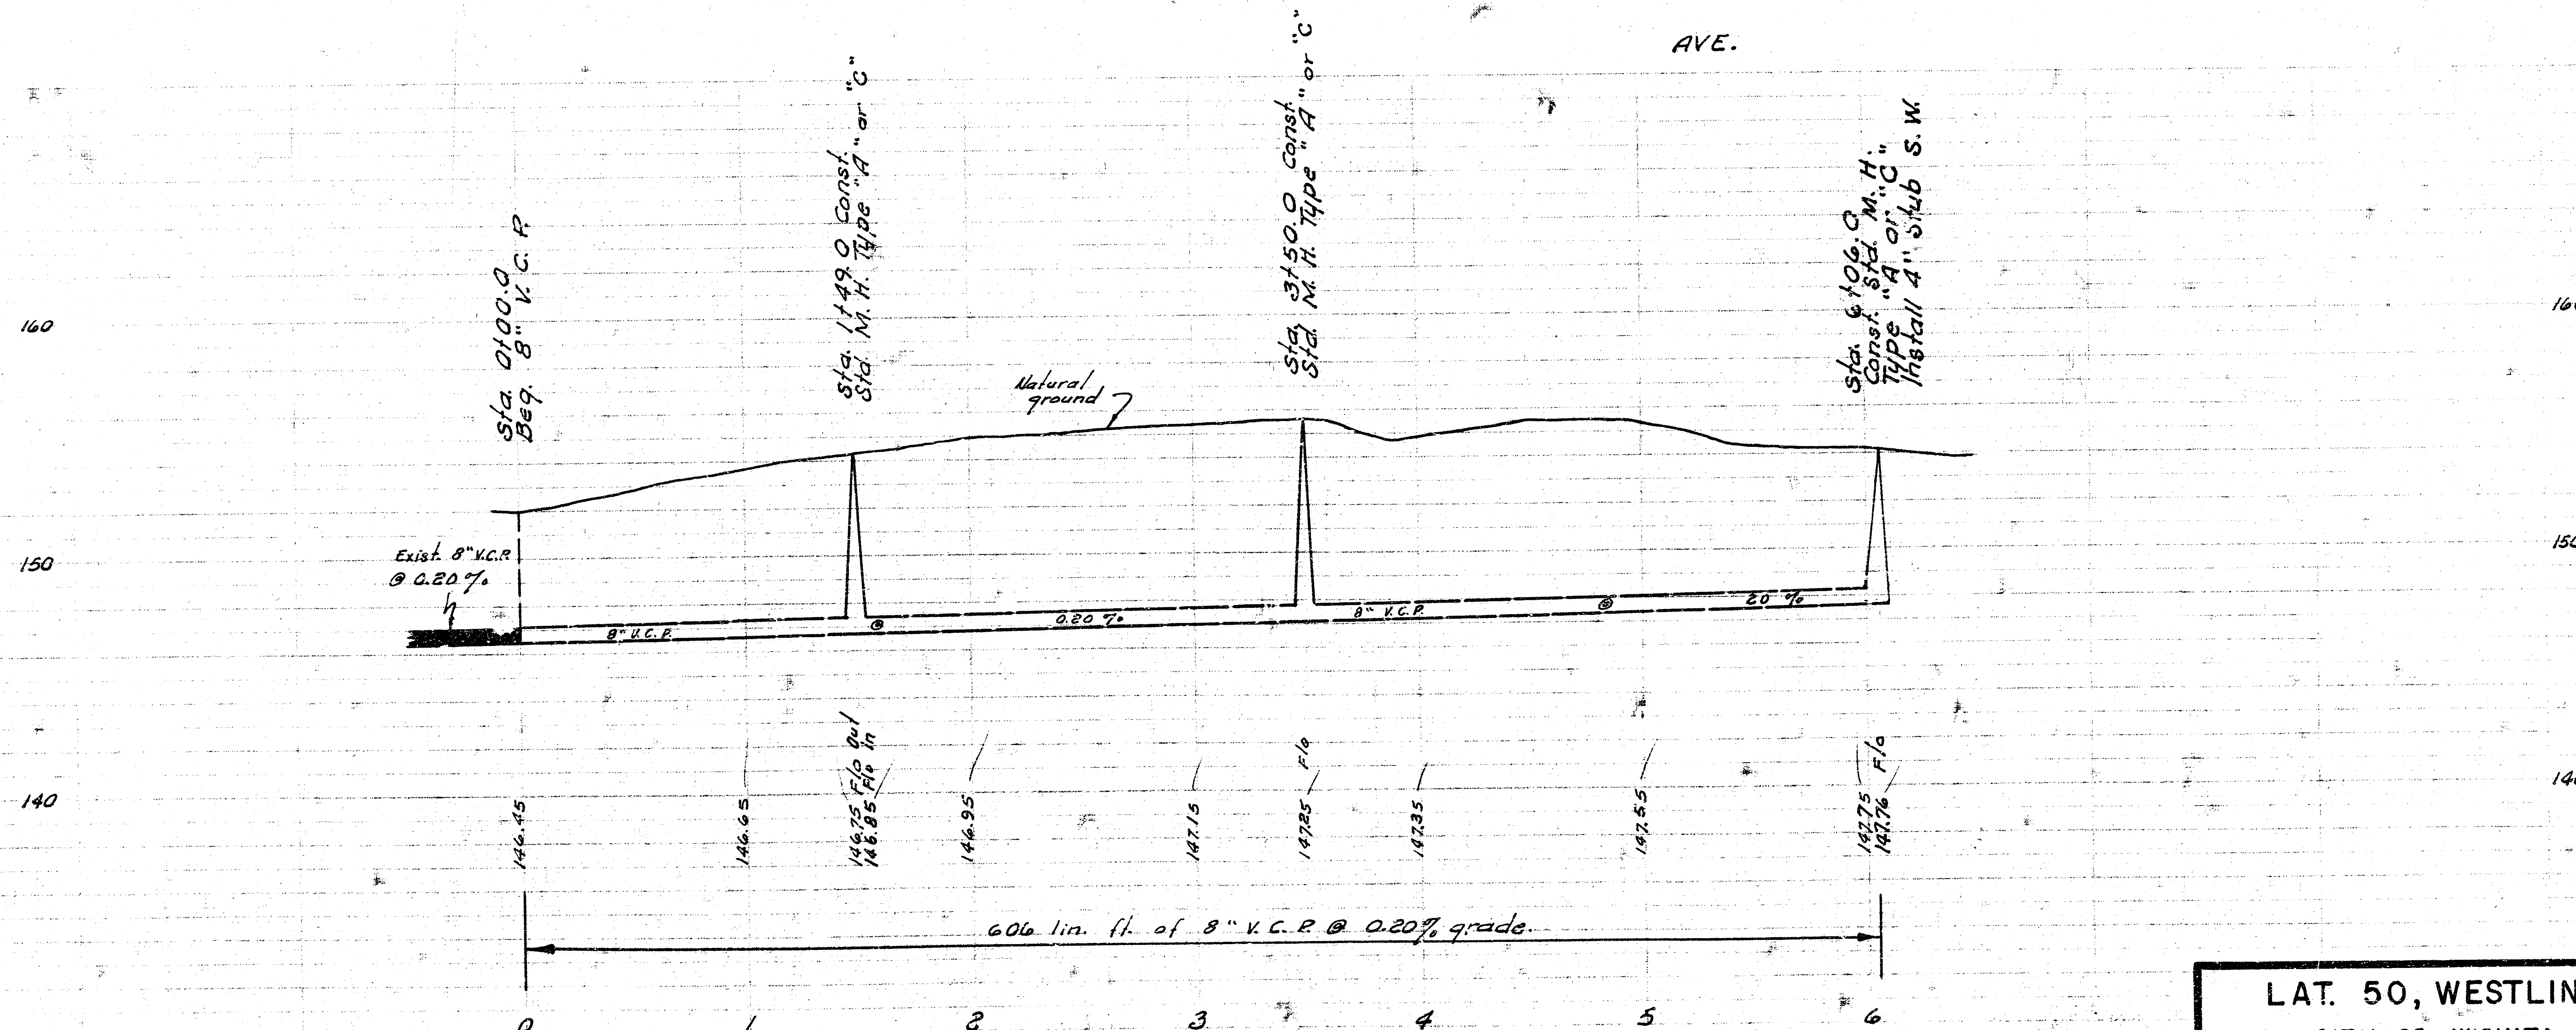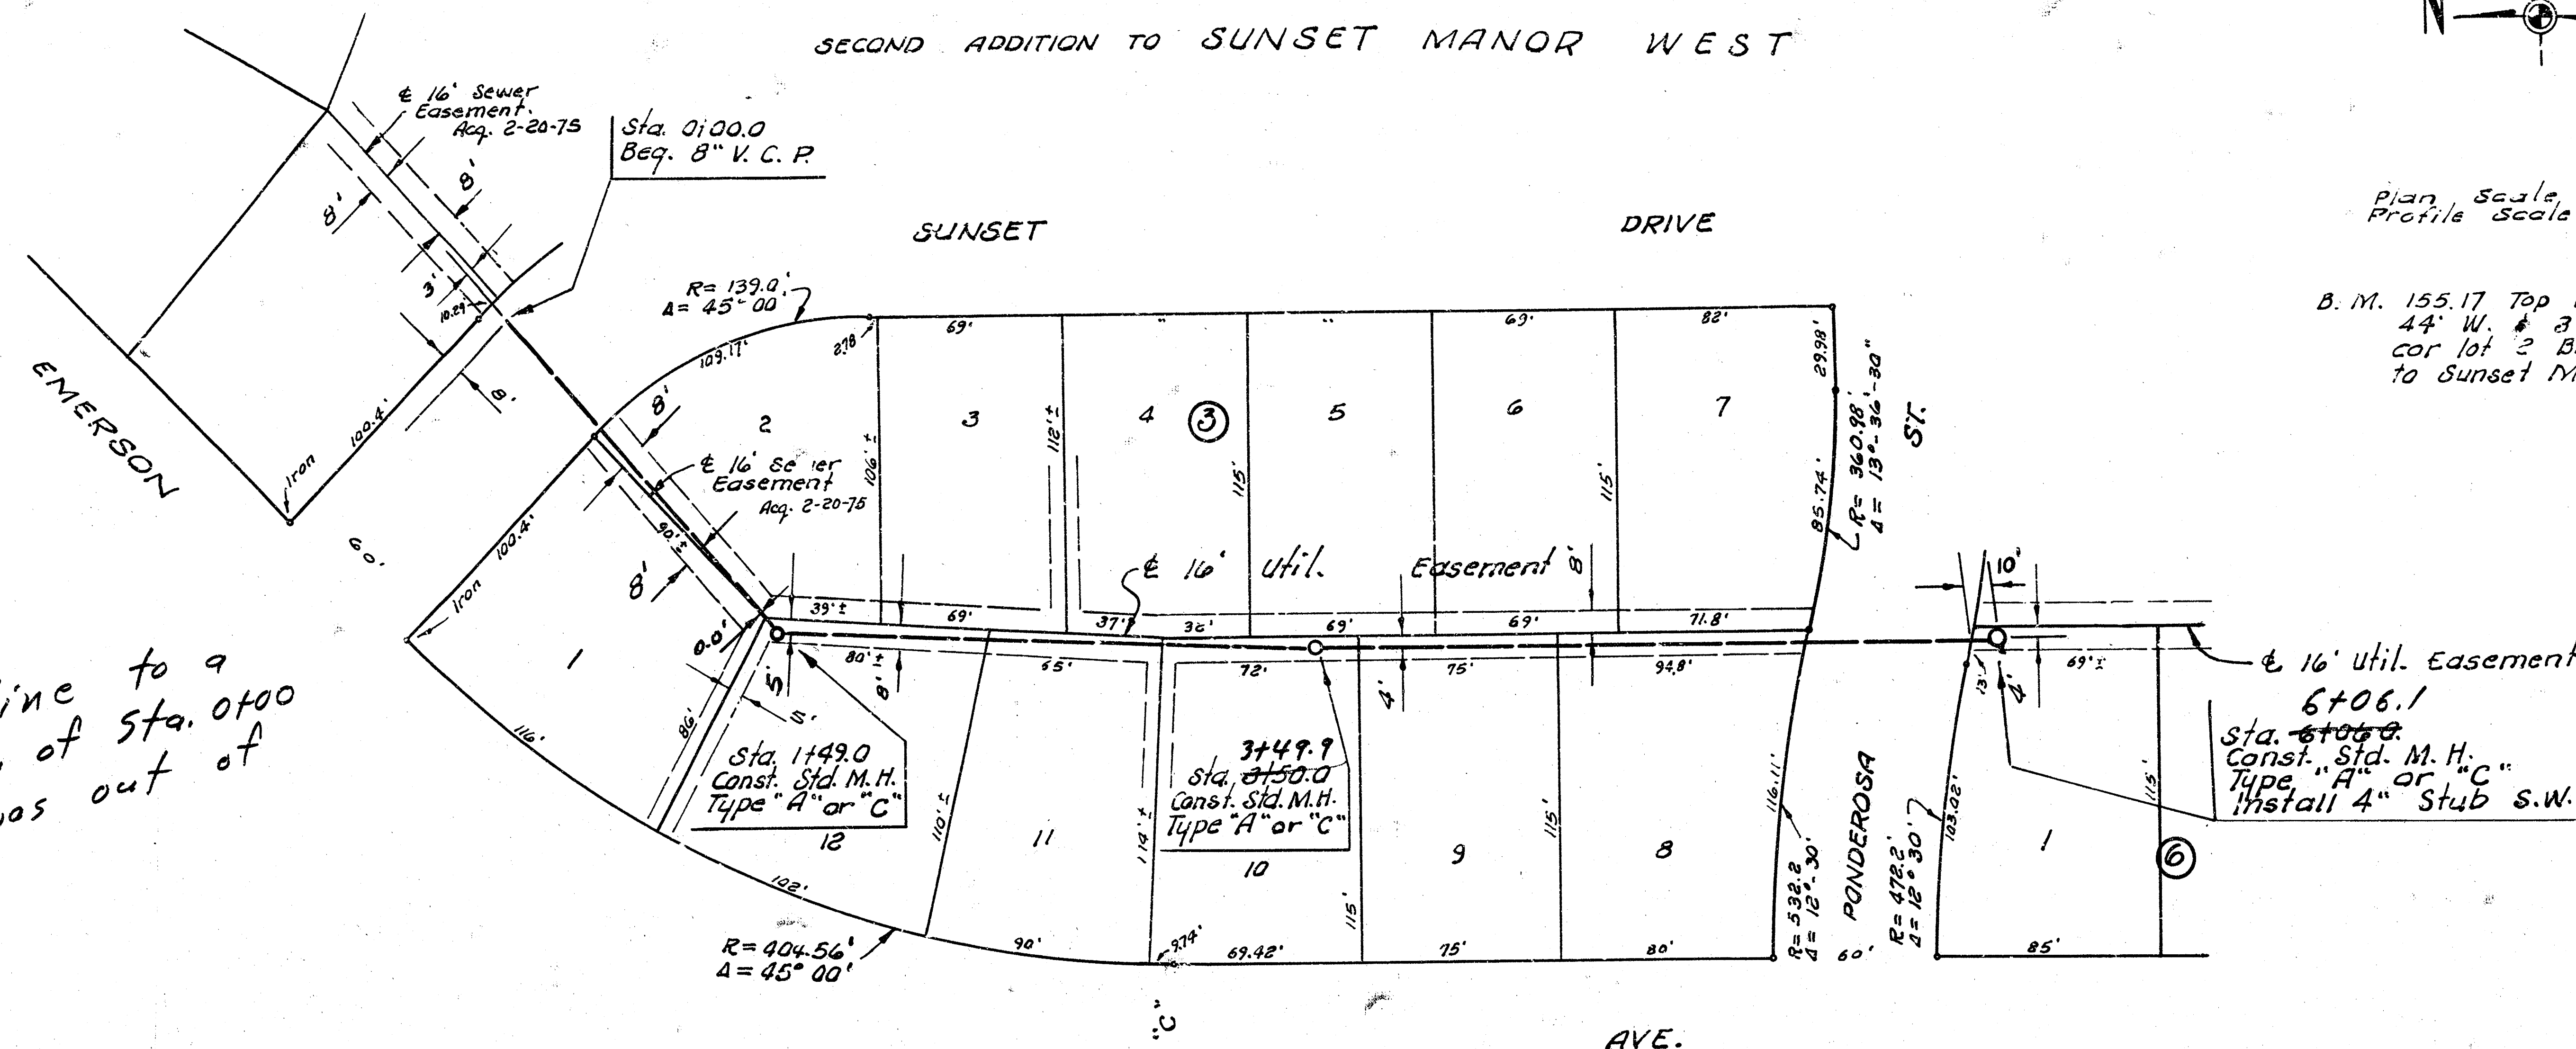

LAT. 50, WESTLINK SEWER
CITY OF WICHITA, KANSAS
R. W. LINN — CITY ENGINEER
1975 PROJECT NO. DBKL568070