



B.M. 10791 STANDARD N.E. TYLER ROAD & 13TH STREET.
 B.M. 10008 'X' IN MID KANSAS. Cir 4" conc walk North, N.E. Cor
 HARVEST LANE & HARVEST CT. Opposite House # 8991 HARVEST LN.

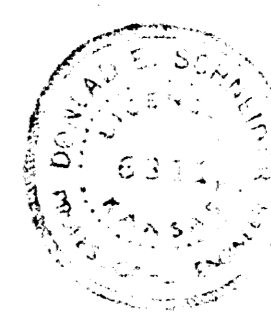

PLAN SCALE 1" = 40'
 PROFILE 1" = 5' VERT
 1" = 40' HORIZ

NOTE: Contractor is to verify top of manhole elevations with the developer.

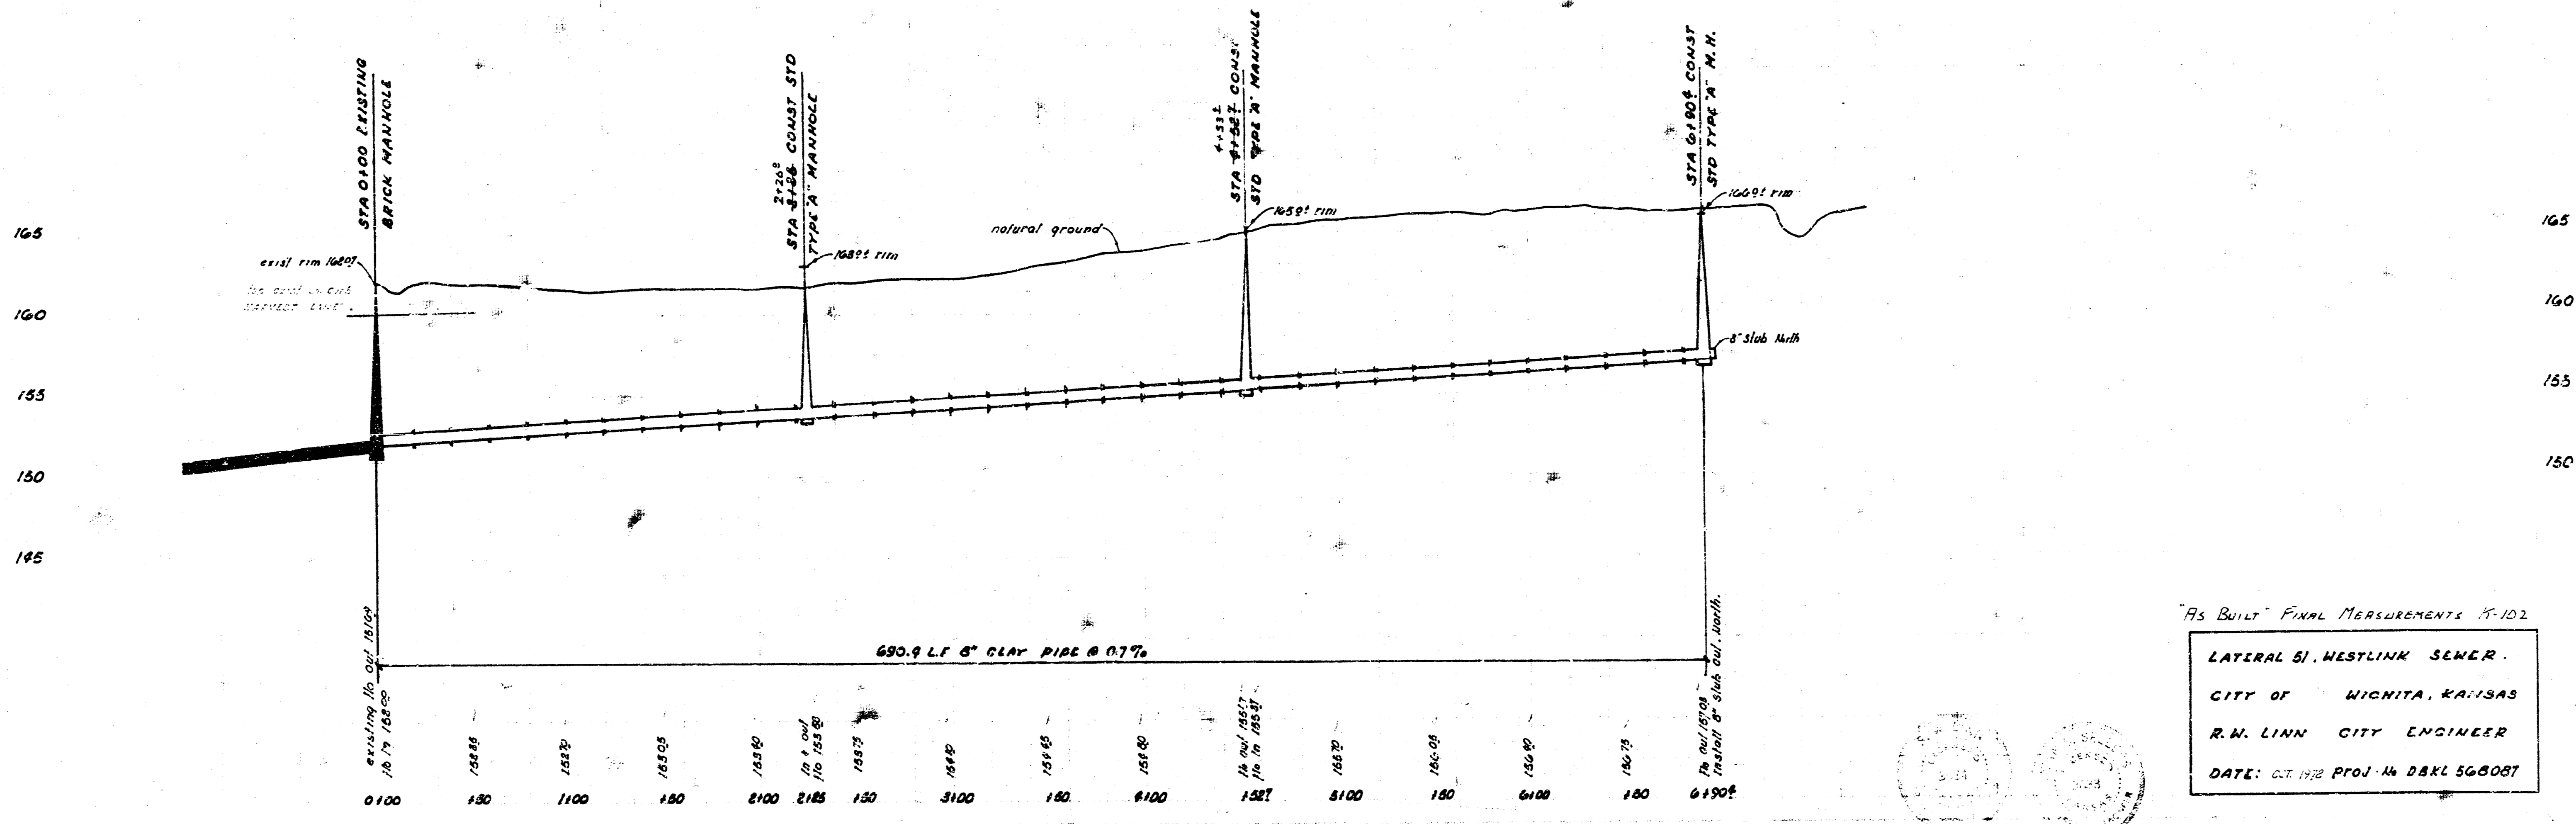

AS BUILT FINAL MEASUREMENTS 15-102
LATERAL 51, WESTLINK SEWER.
 CITY OF WICHITA, KANSAS
 R.W. LINN CITY ENGINEER
 DATE: OCT 1978 PROJ. IN D&R 568087

