



B.M. 16787 STANDARD N.E. TYLER ROAD & 13TH STREET.  
 3 M. 16005 "X" IN MID KANSAS. 41' CONC WALK NORTH, N.E. COR  
 HARVEST LANE & HARVEST CT. OPPOSITE HOUSE #8941 HARVEST LN.

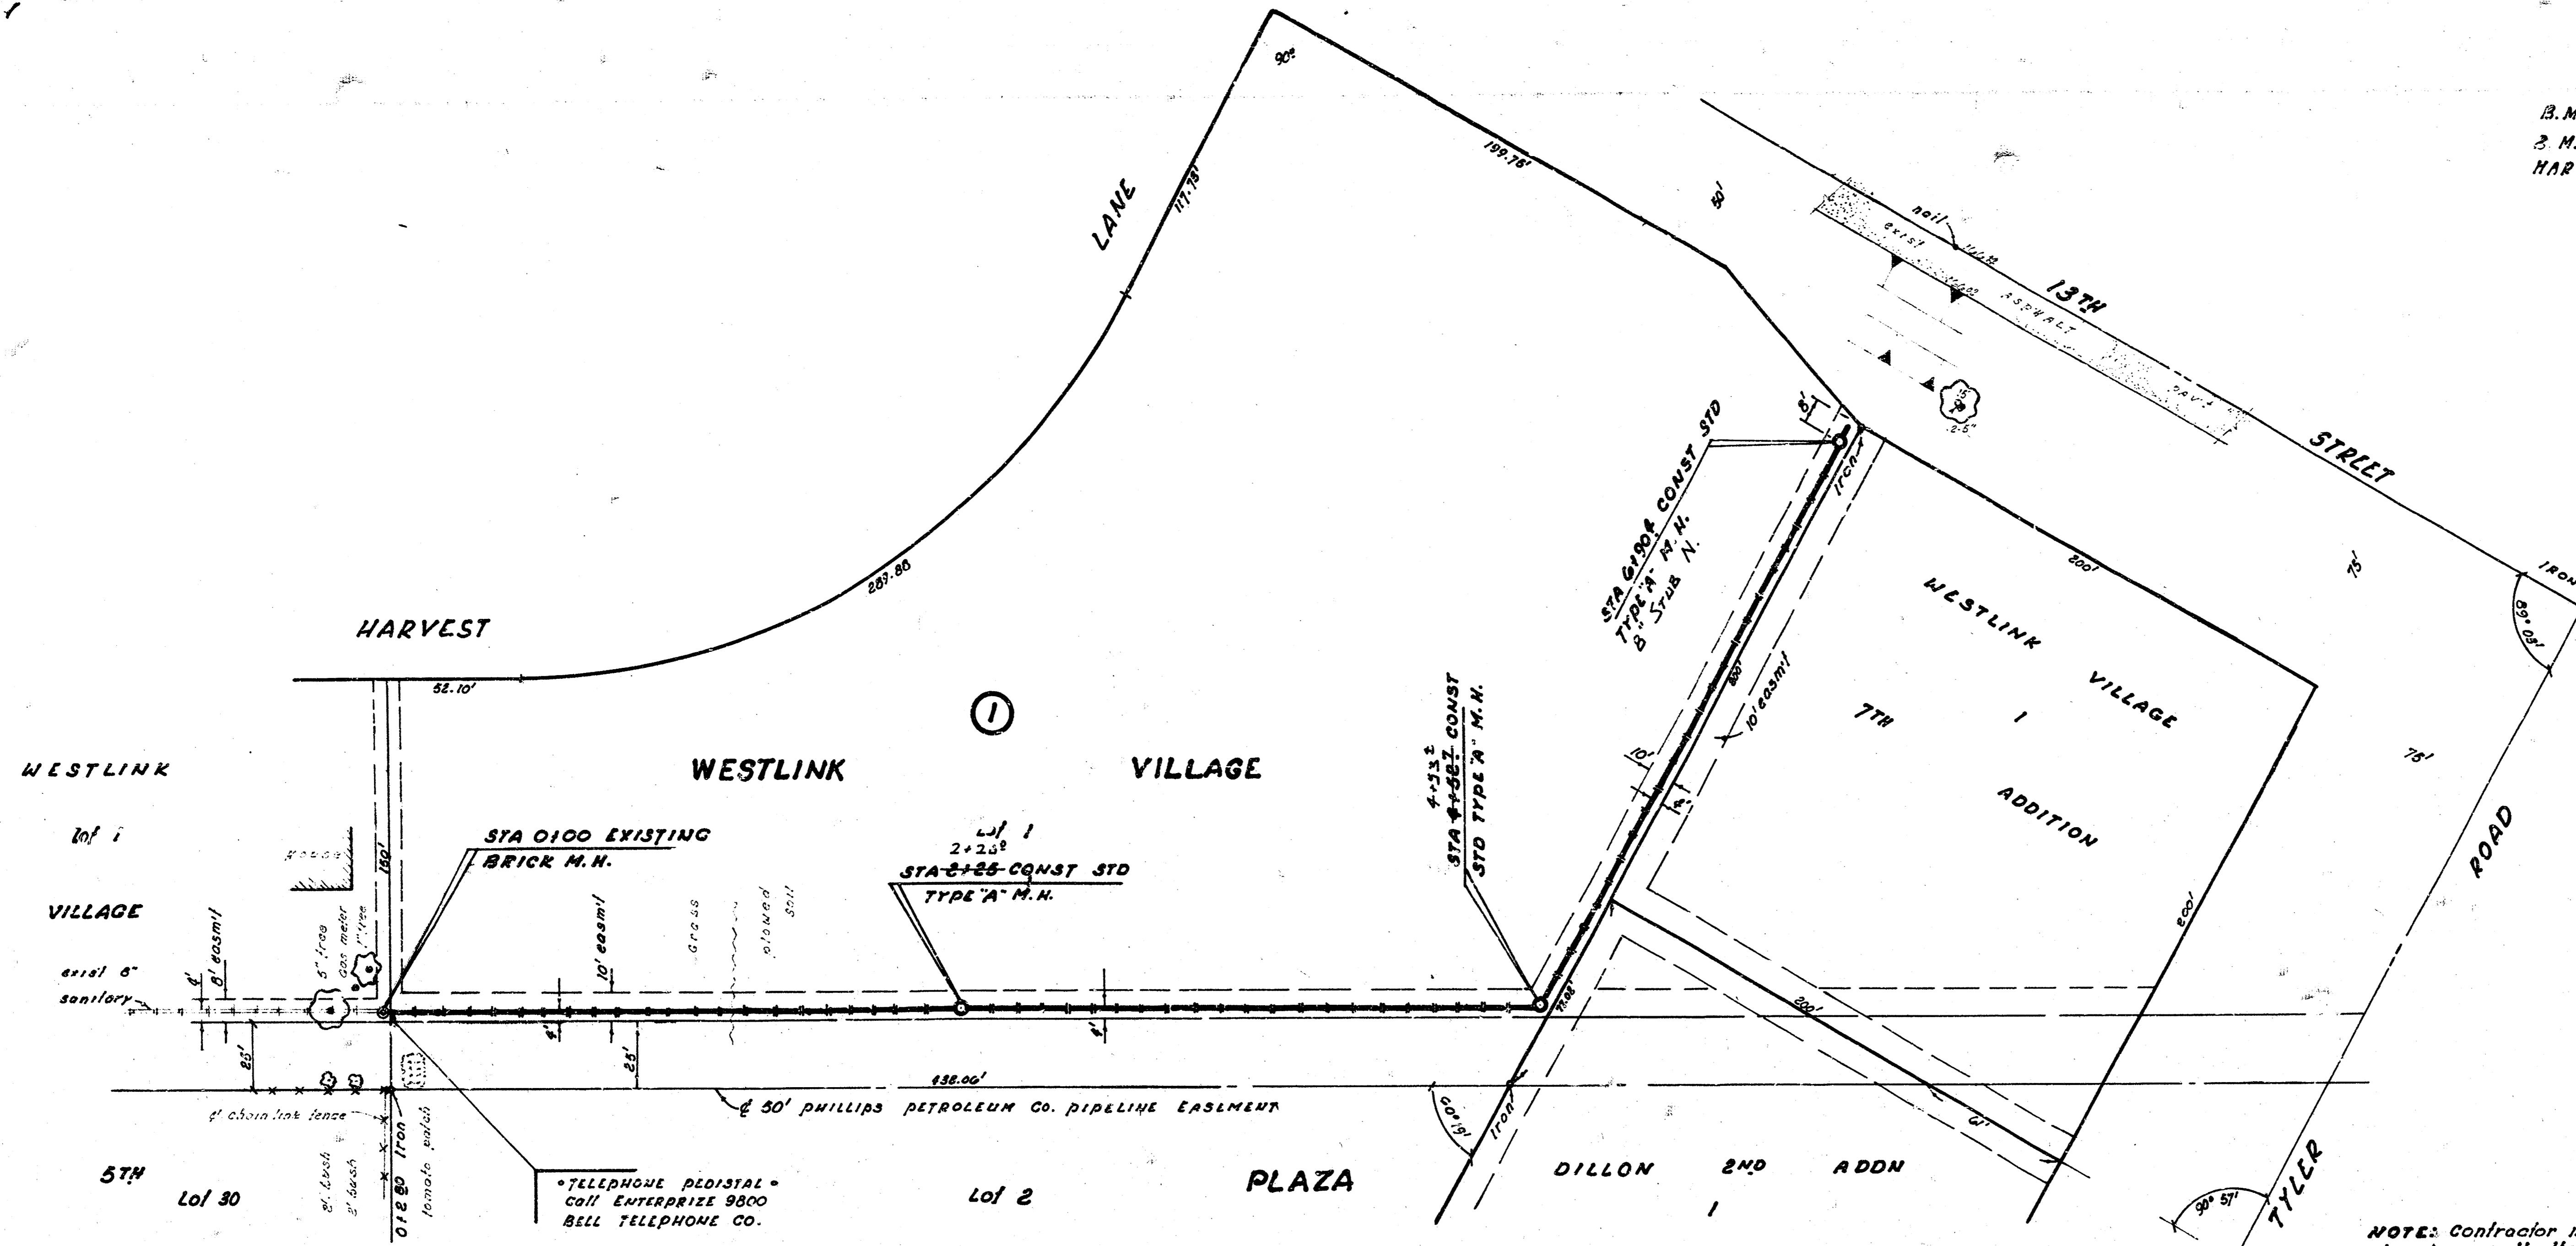



PLAN SCALE 1" = 40'  
 PROFILE 1" = 5' VERT  
 1" = 80' HORIZ.

NOTE: Contractor is to verify top of manhole elevations with the developer.

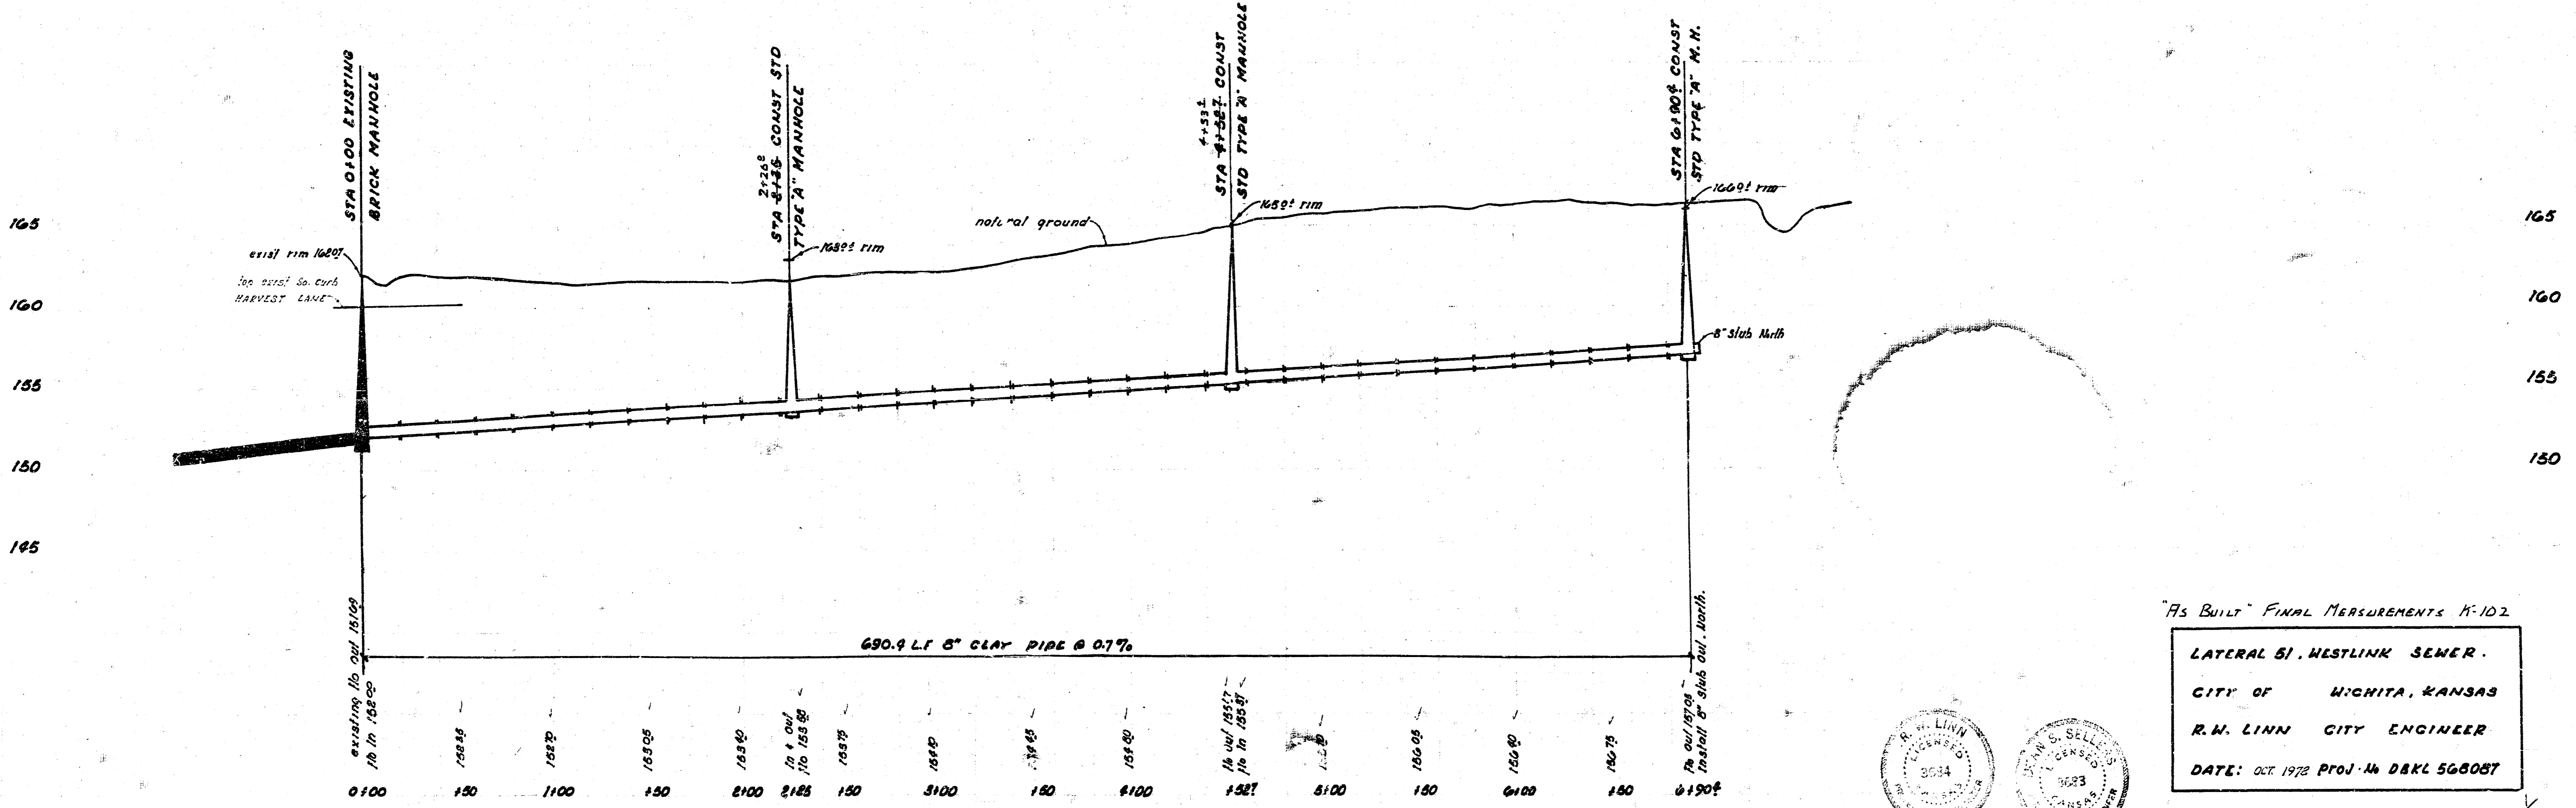

"As Built" Final Measurements N-102

LATERAL 51, WESTLINK SEWER.  
 CITY OF WICHITA, KANSAS  
 R.W. LINN CITY ENGINEER  
 DATE: OCT. 1972 PROJ. No. DRKL 568087

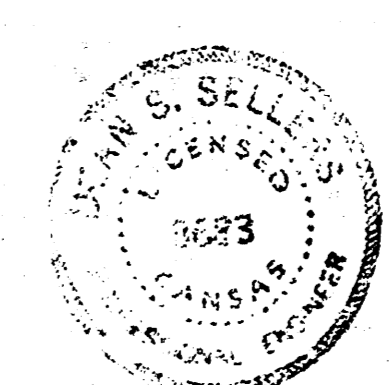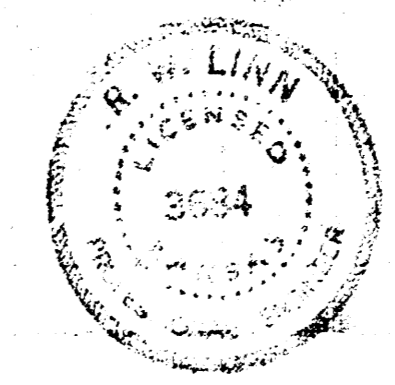

FIL MED FROM THE BEST