



B.M. 16797 STANDARD N.E. CORNER 13TH STREET AND TYLER ROAD.
 B.M. 16085 "K" IN MID KANSAS CTR 1' CONC WALK N. North East Cor HARVEST COURT
 and HARVEST LAKE opposite 16# 89# HARVEST LAKE.

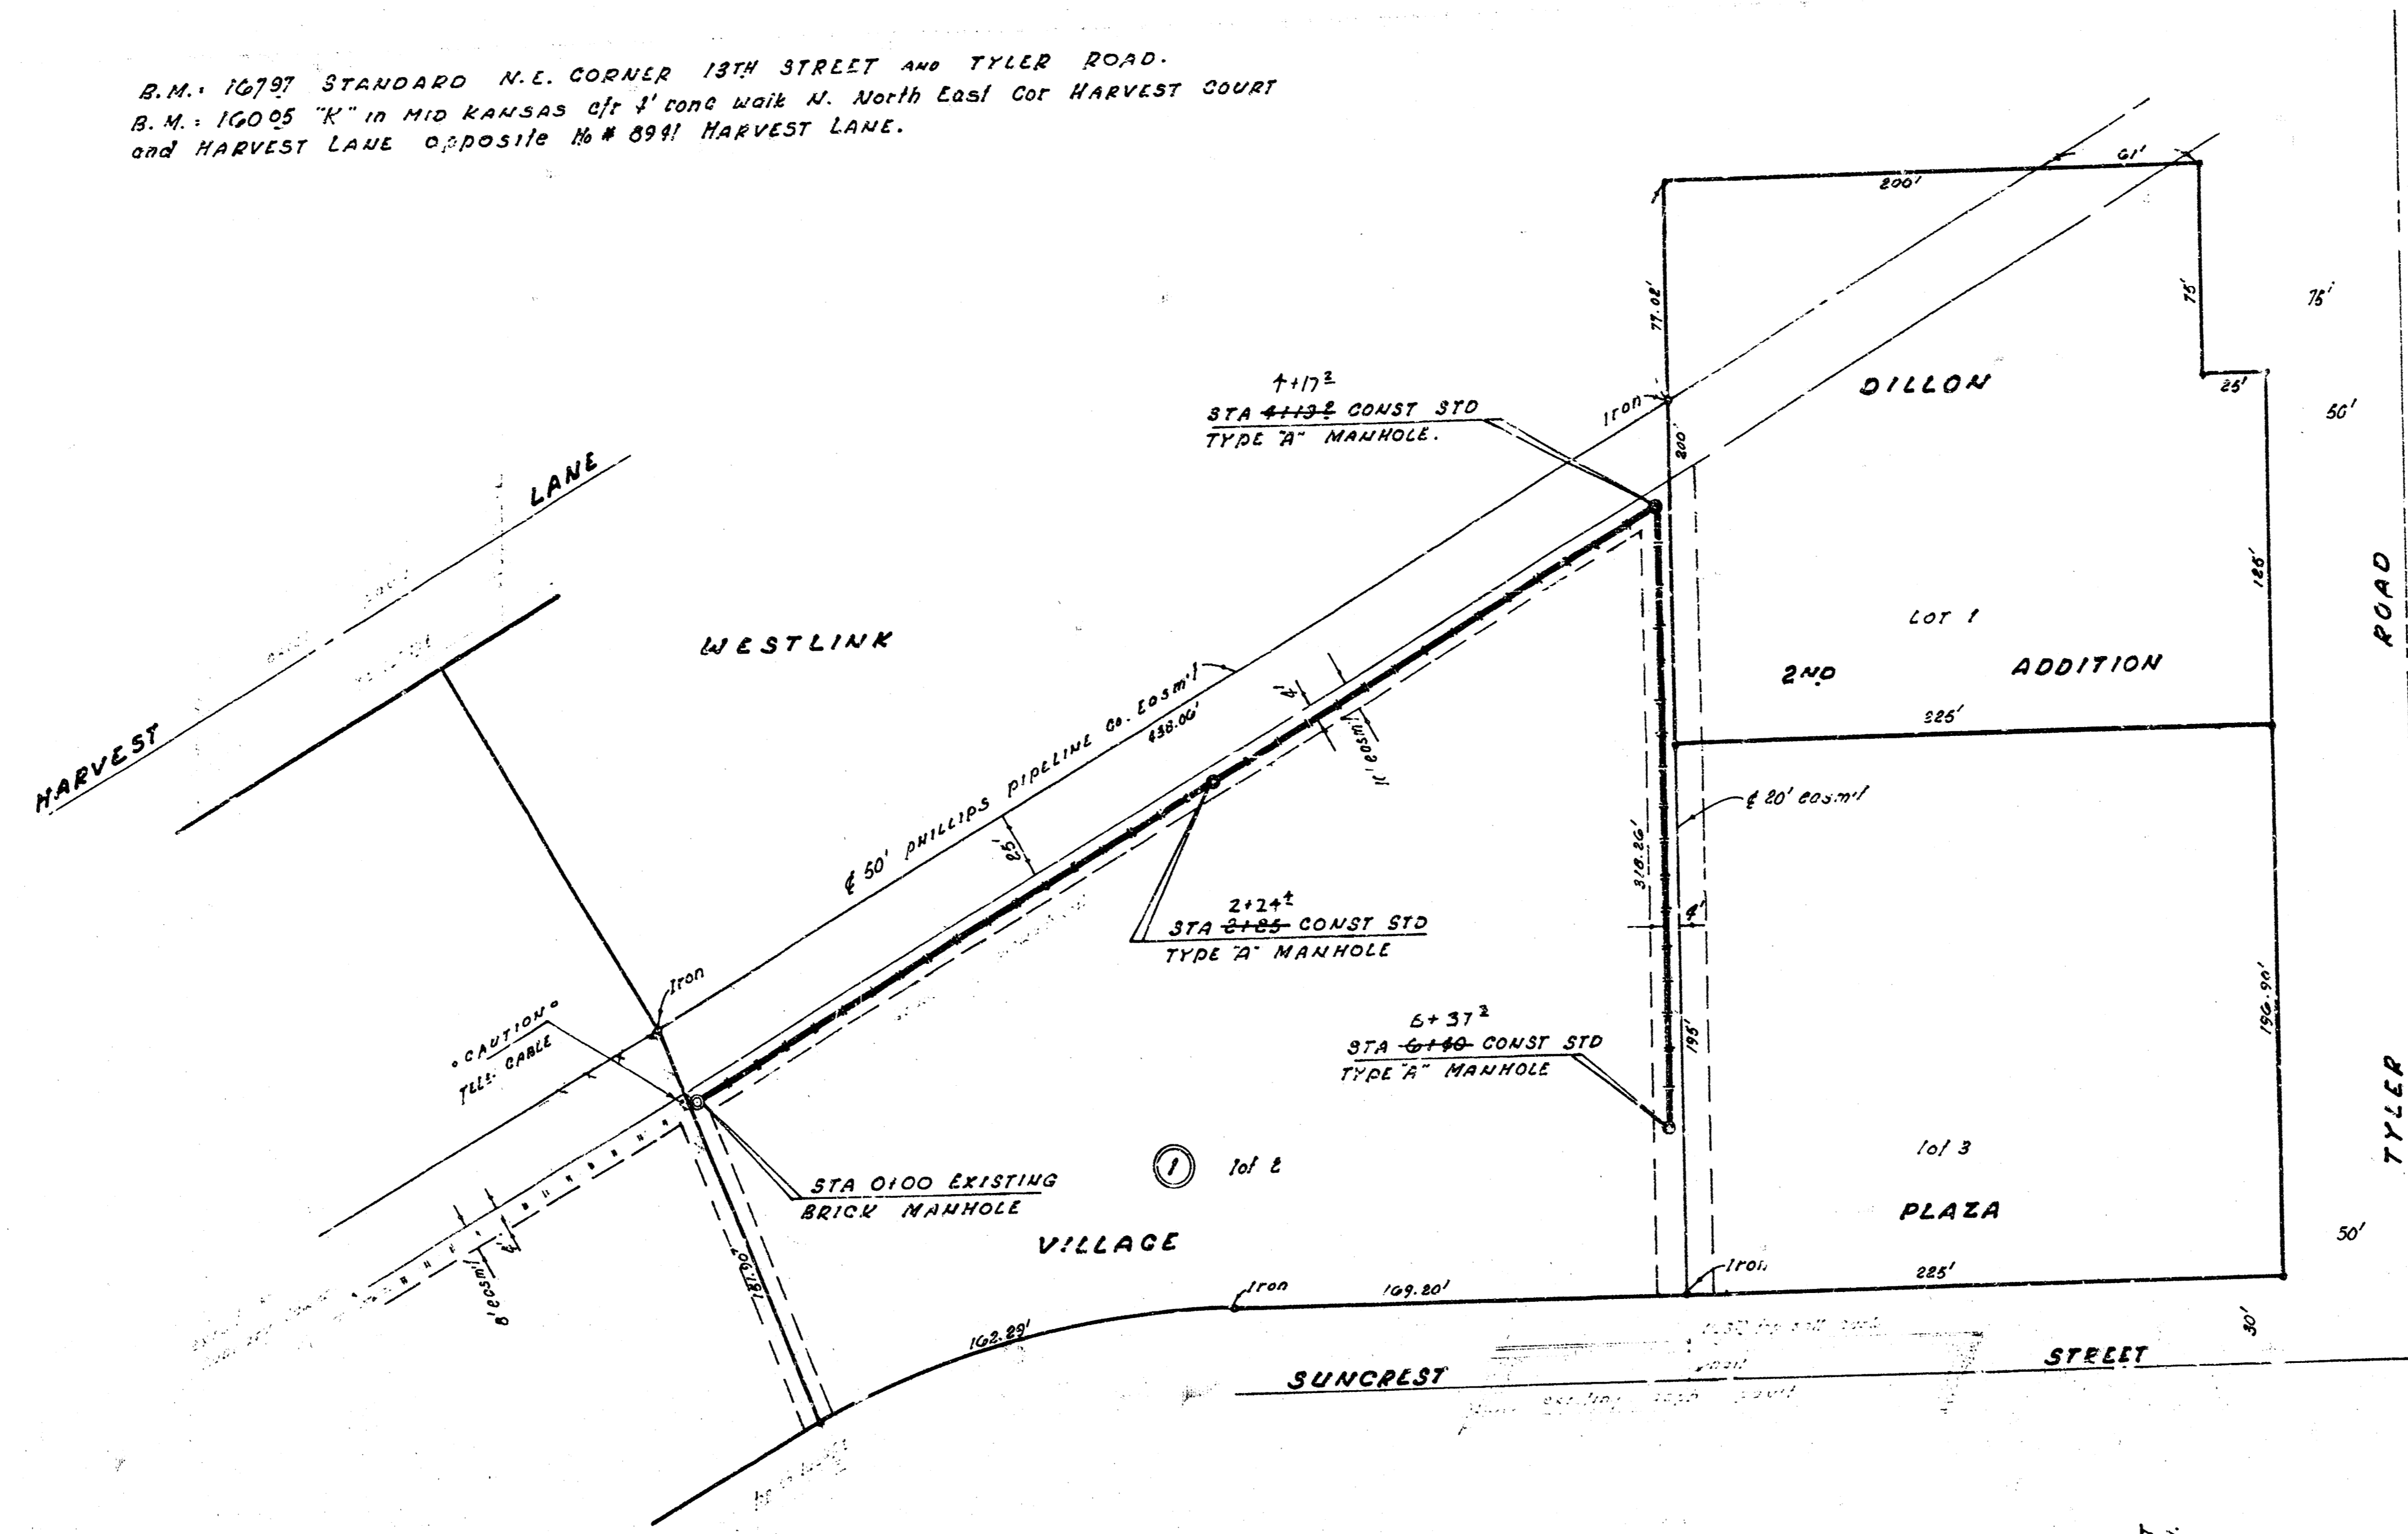

NOTE: Contractor is to verify Top of Manhole elevations with developer.

PLAN SCALE 1"=50'
 PROFILE 1"=5' VERT
 1"=40' HORIZ

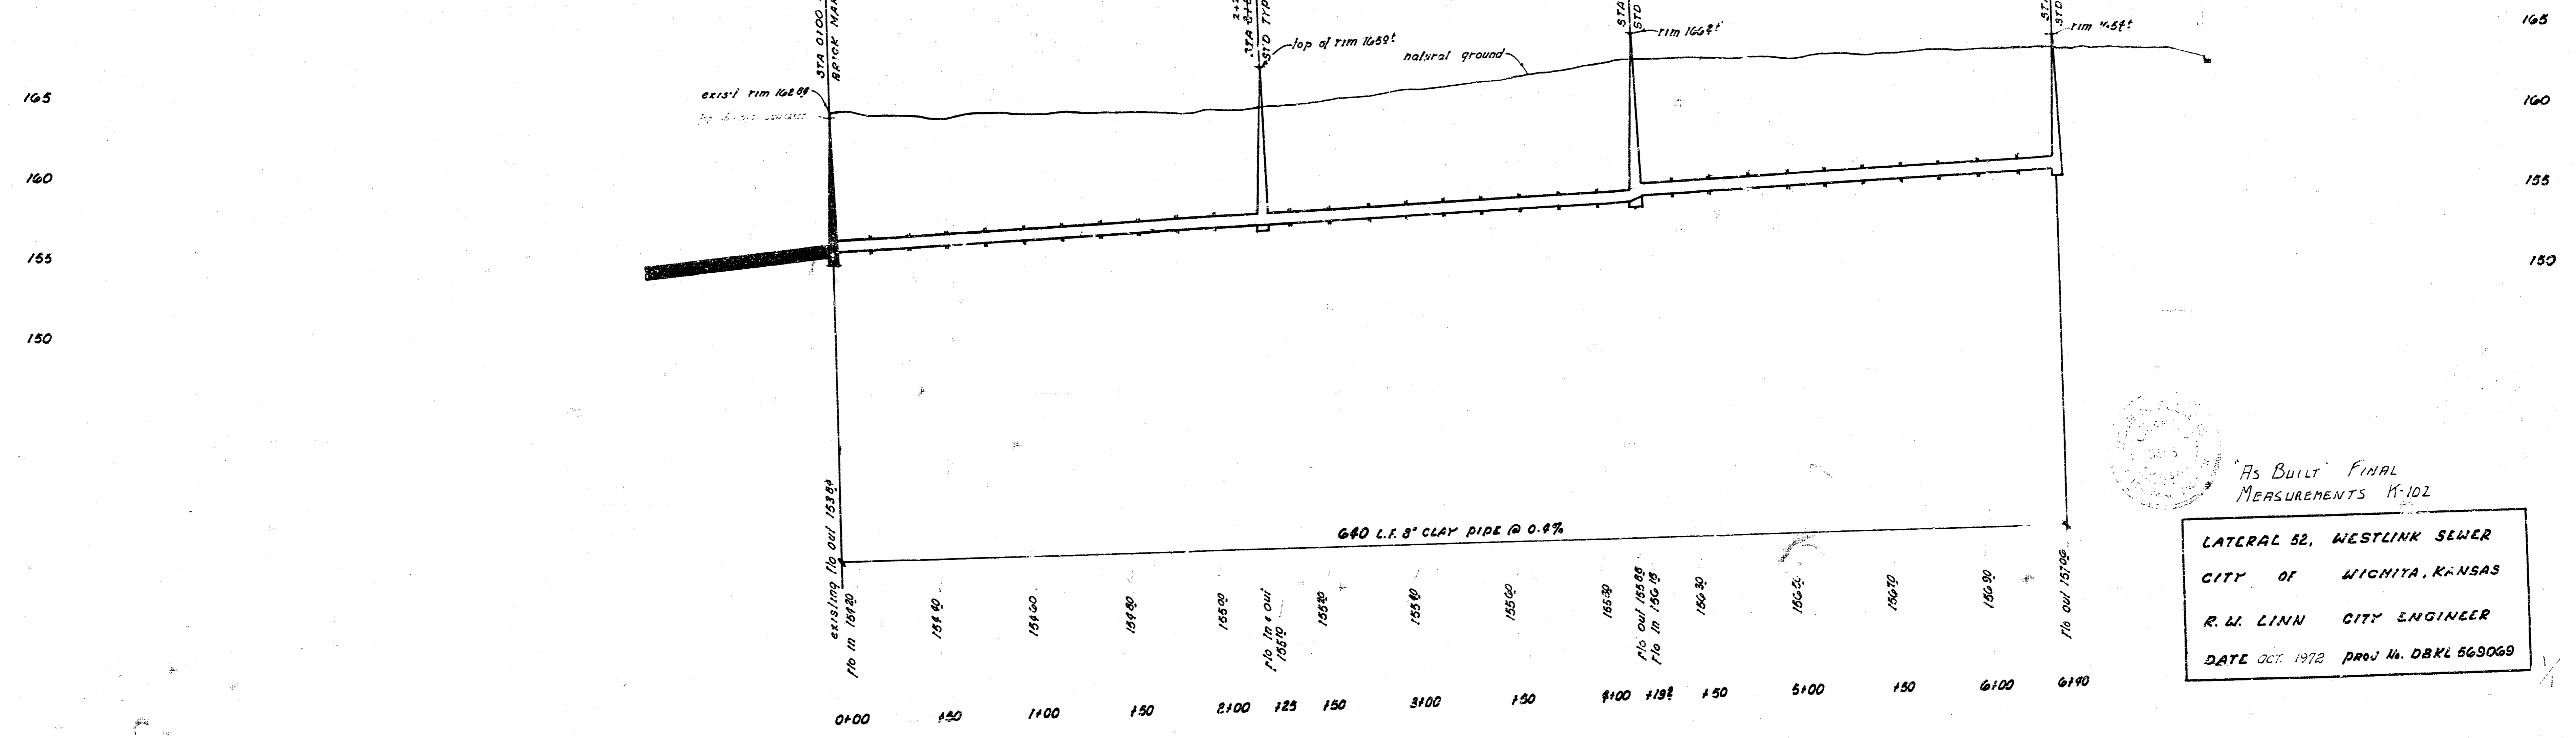

As BUILT FINAL
 MEASUREMENTS K-102

LATERAL 52, WESTLINK SEWER
 CITY OF WICHITA, KANSAS
 R. W. LINN CITY ENGINEER
 DATE OCT. 1972 PROJ. NO. DBXL 563069

FILMED FROM THE BEST