



B.M. 10787 STANDARD N.E. CORNER 18TH STREET AND TYLER ROAD.
 B.M. 10085 "X" IN MID KANSAS CRT 8" CONC WALK W. NORTH EAST COR HARVEST COURT
 and HARVEST LAKE OPPOSITE N# 8911 HARVEST LAKE.

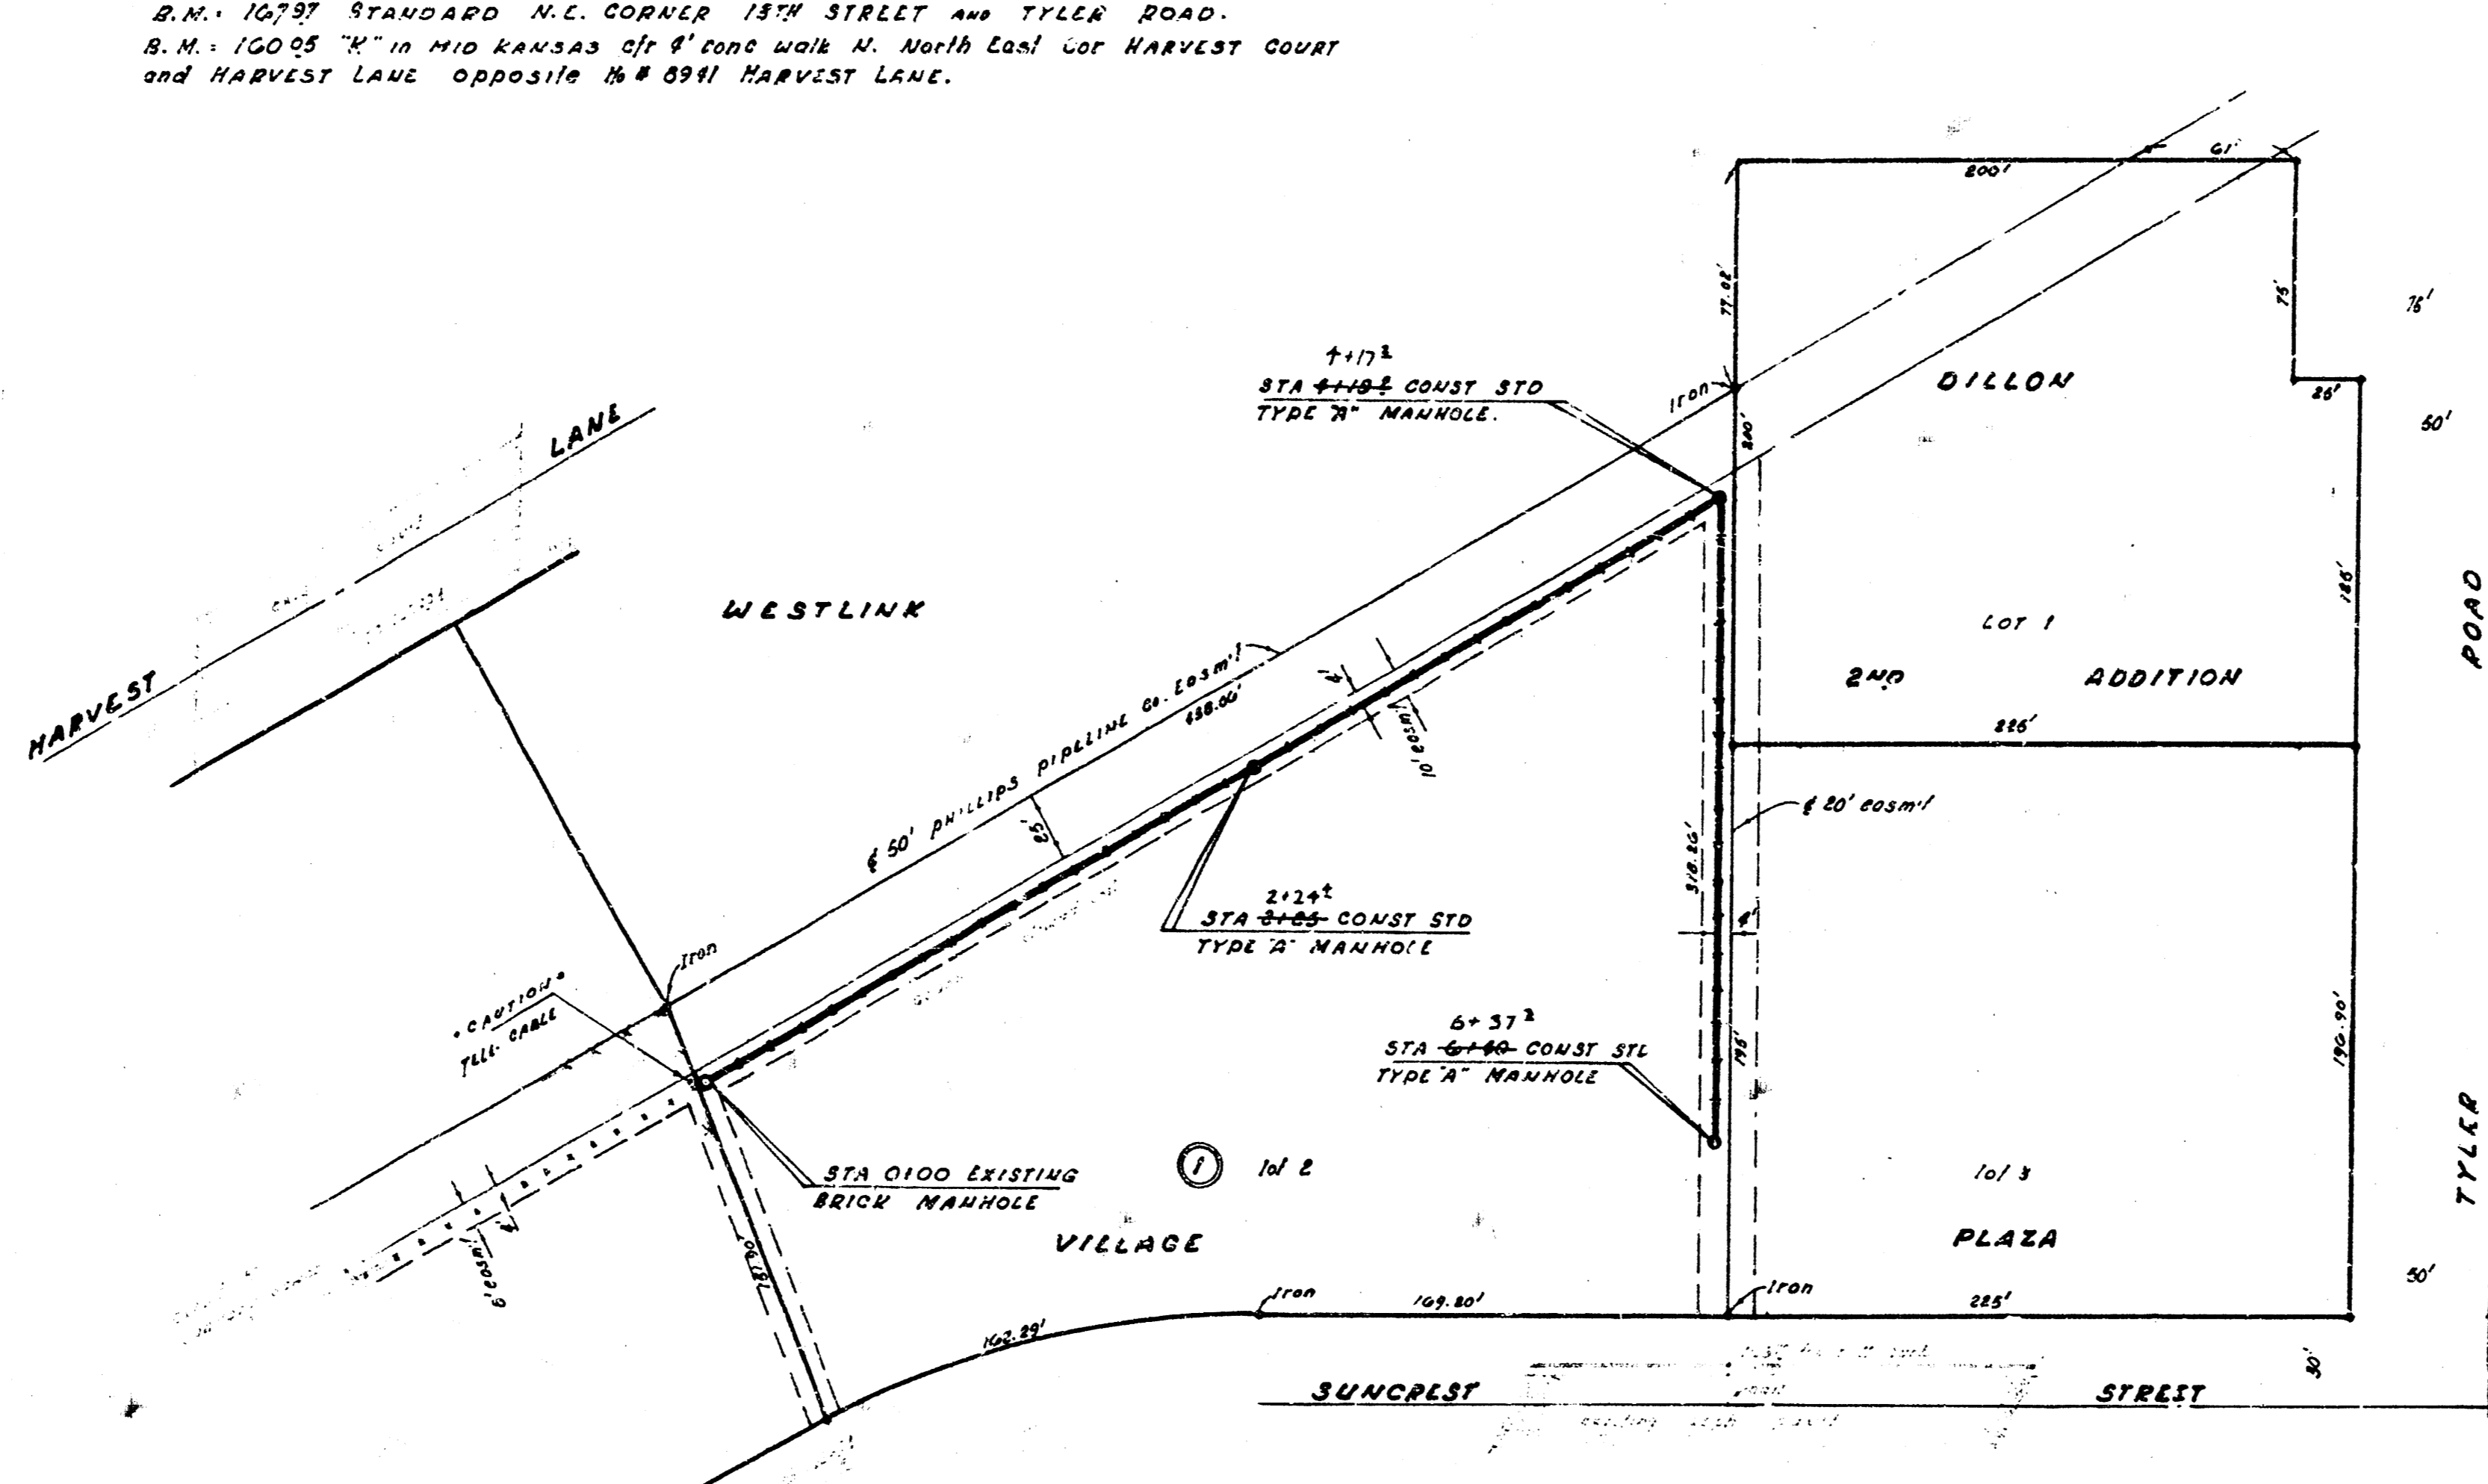

NOTE: Contractor is to verify Top of Manhole elevations with developer.

PLAN SCALE 1" = 50'
 PROFILE 1" = 5' VERT
 1" = 80' HORIZ

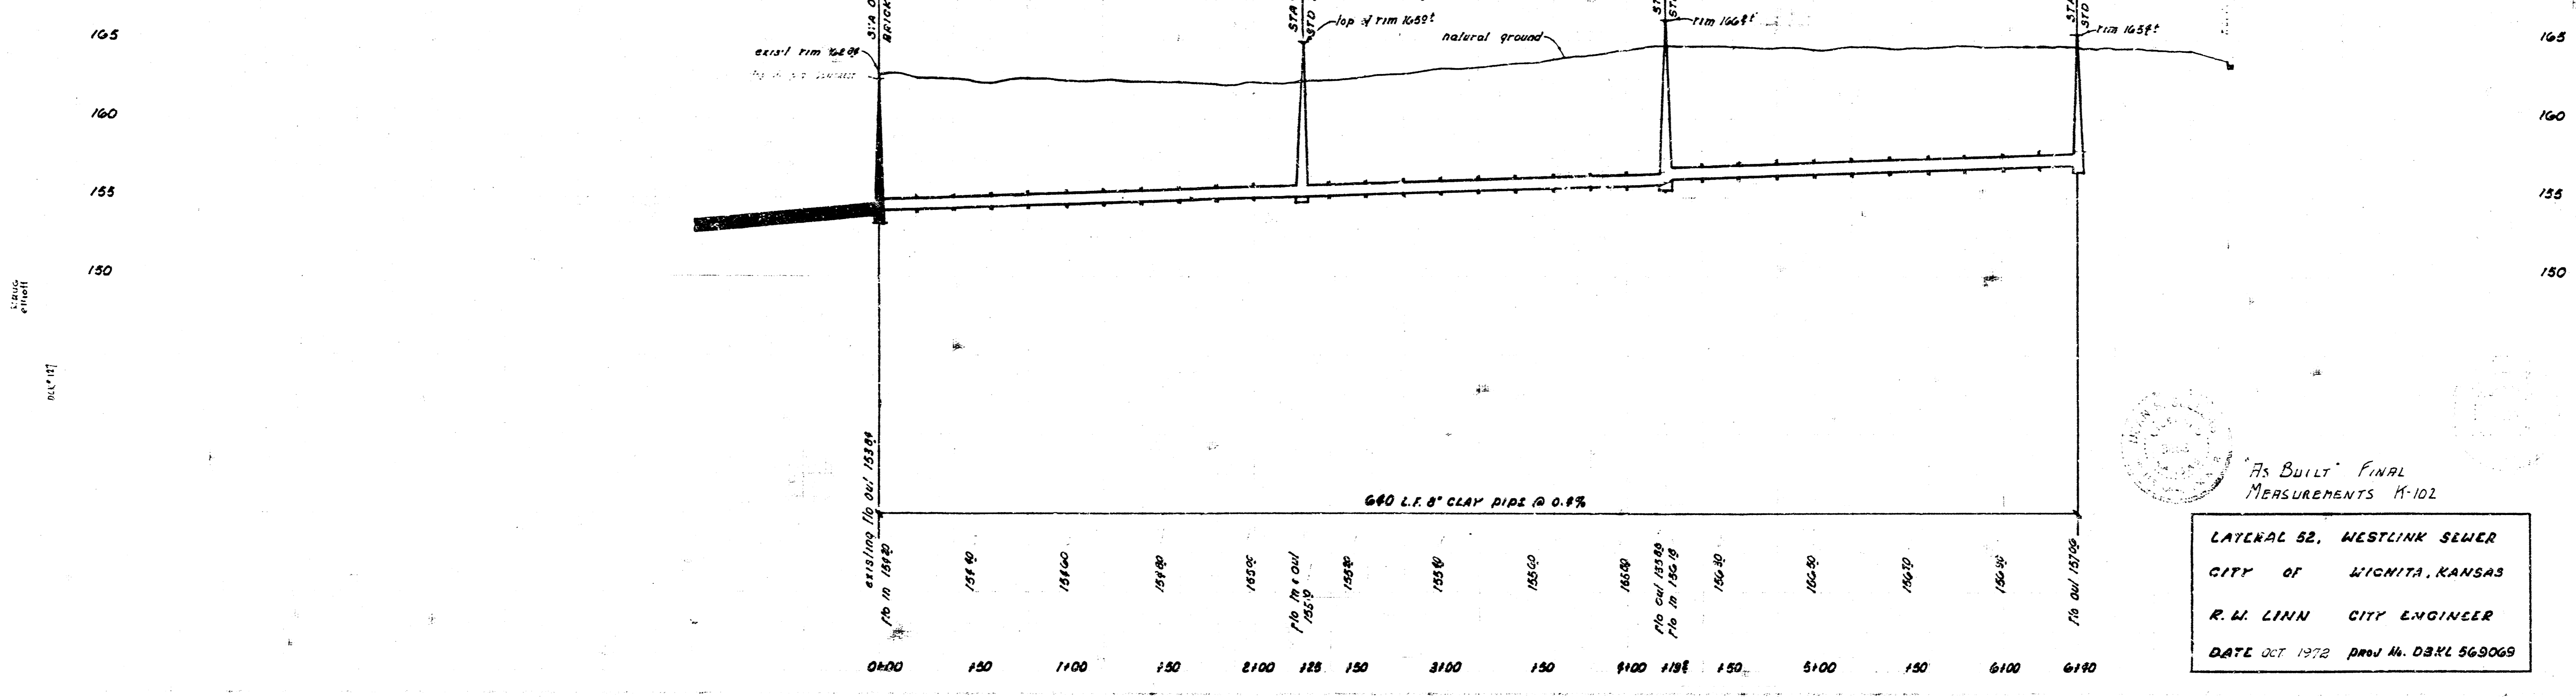

AS BUILT FINAL
 MEASUREMENTS K-102
LATERAL 52, WESTLINK SEWER
 CITY OF WICHITA, KANSAS
 R. W. LINN CITY ENGINEER
 DATE OCT 1978 PROJ. NO. DBXL 563069