

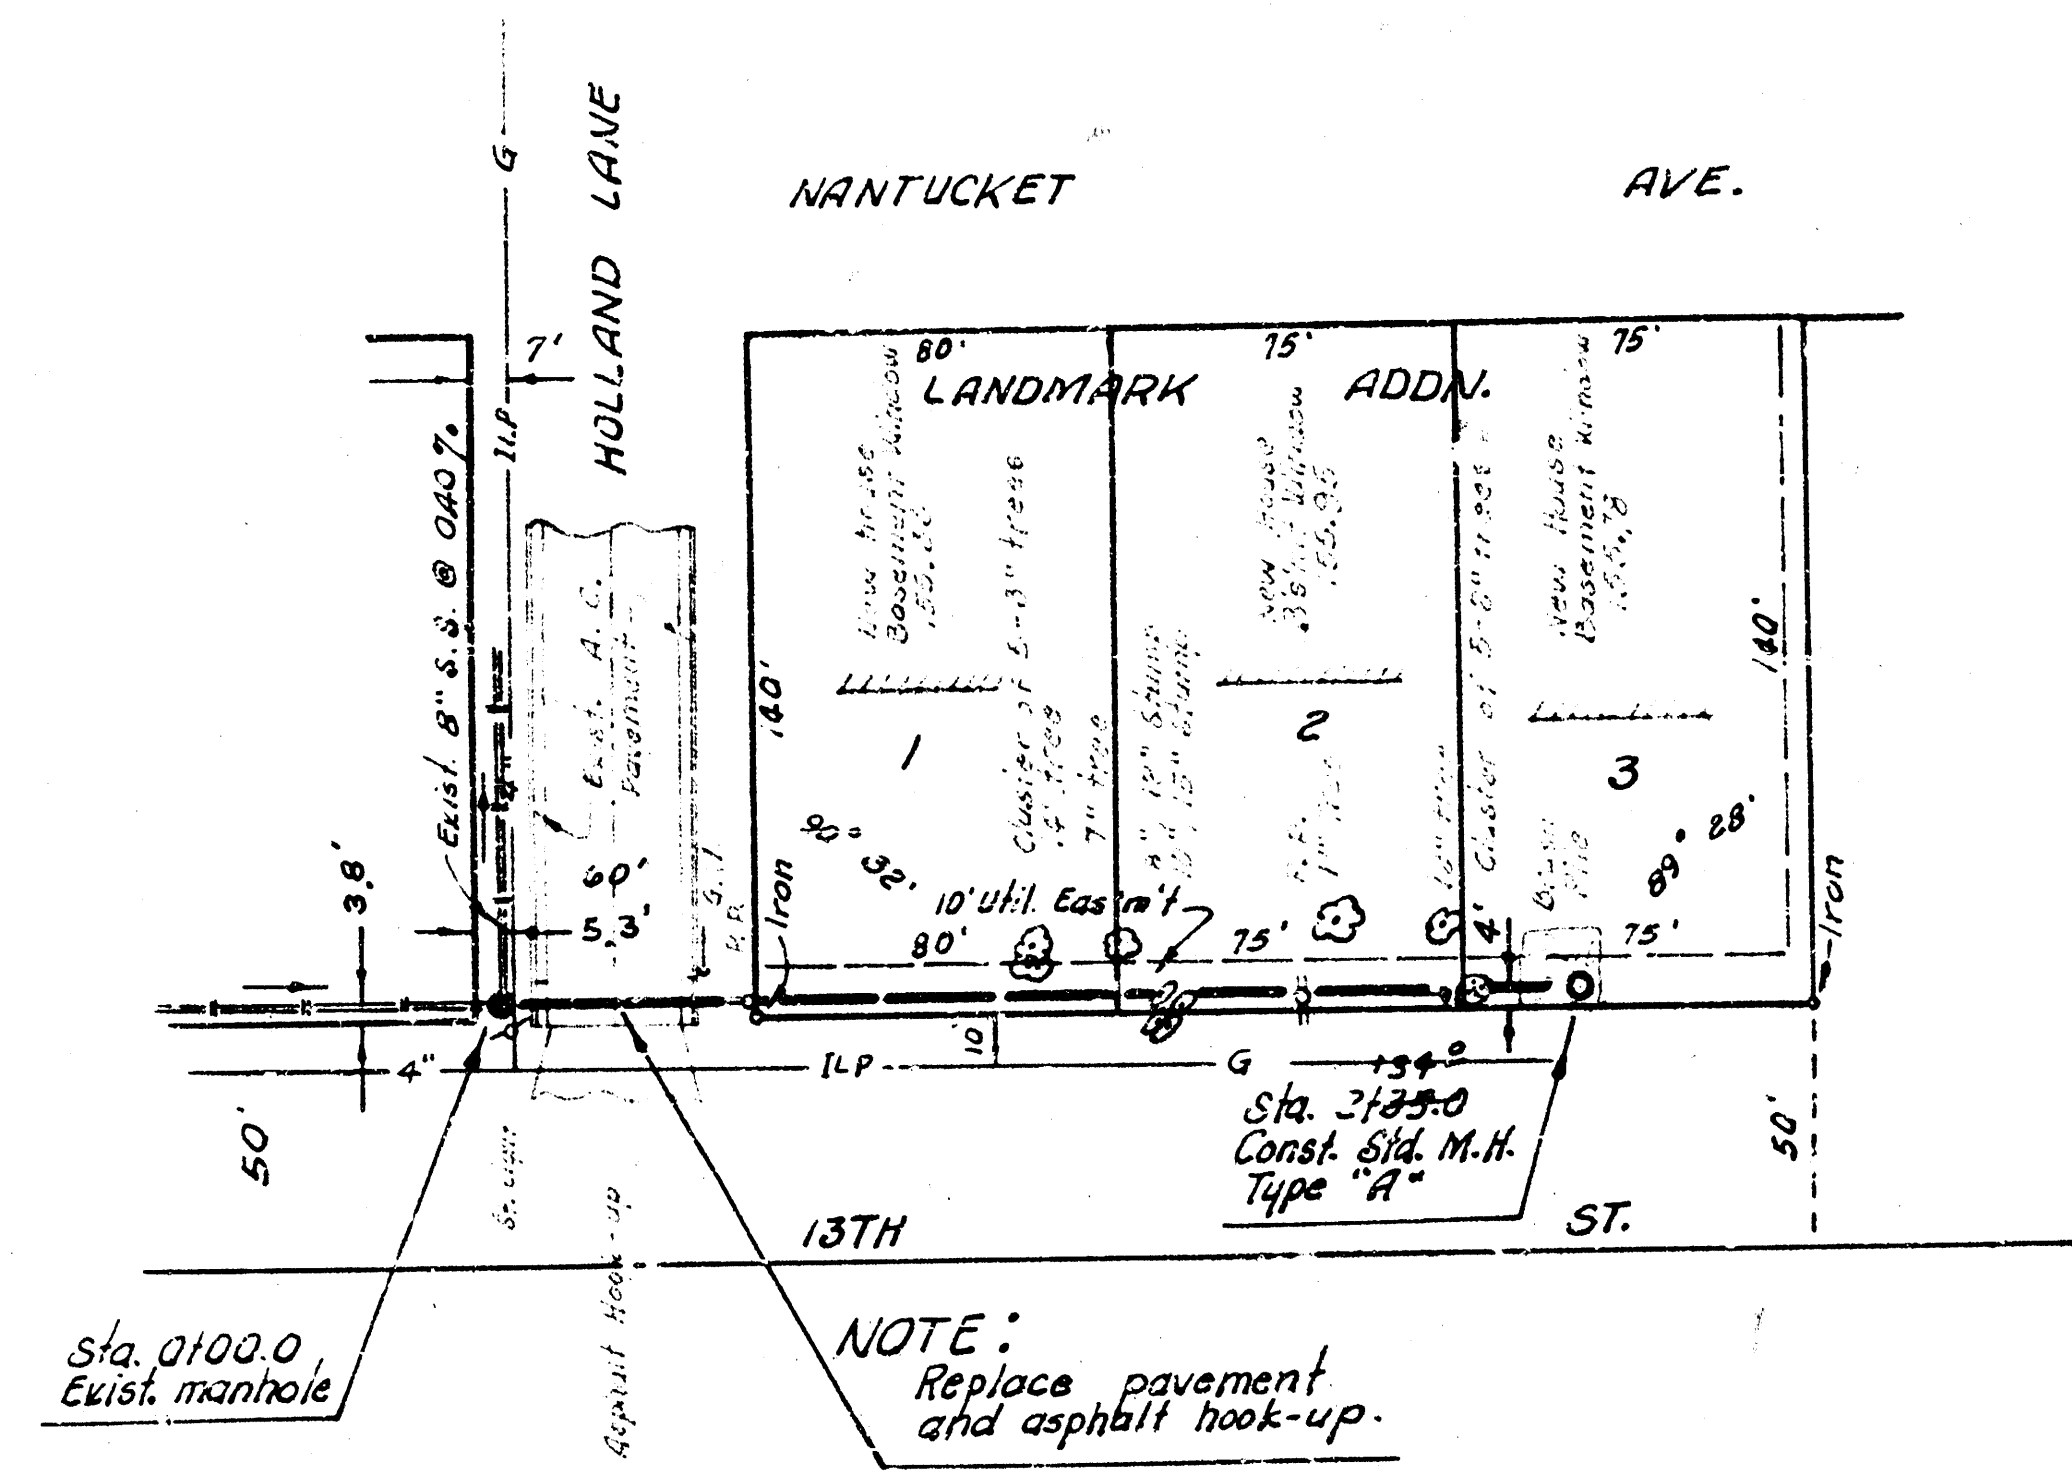


B. M. 148.10 City Std @ Ridge Rd.
 9 13th St.

B. M. 153.12 R.R. Spike W. side P. Pole
 2' E. of E. cb Holland approx.
 25' N. of N. Line 13th St.

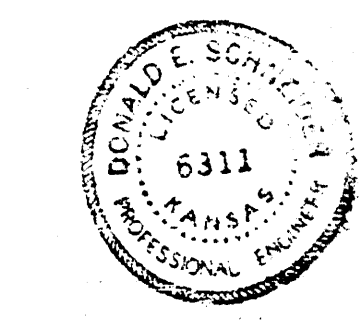

Plan Scale 1" = 40' Horiz.
 Profile Scale 1" = 40' Vert.
 1" = 5' Vert.

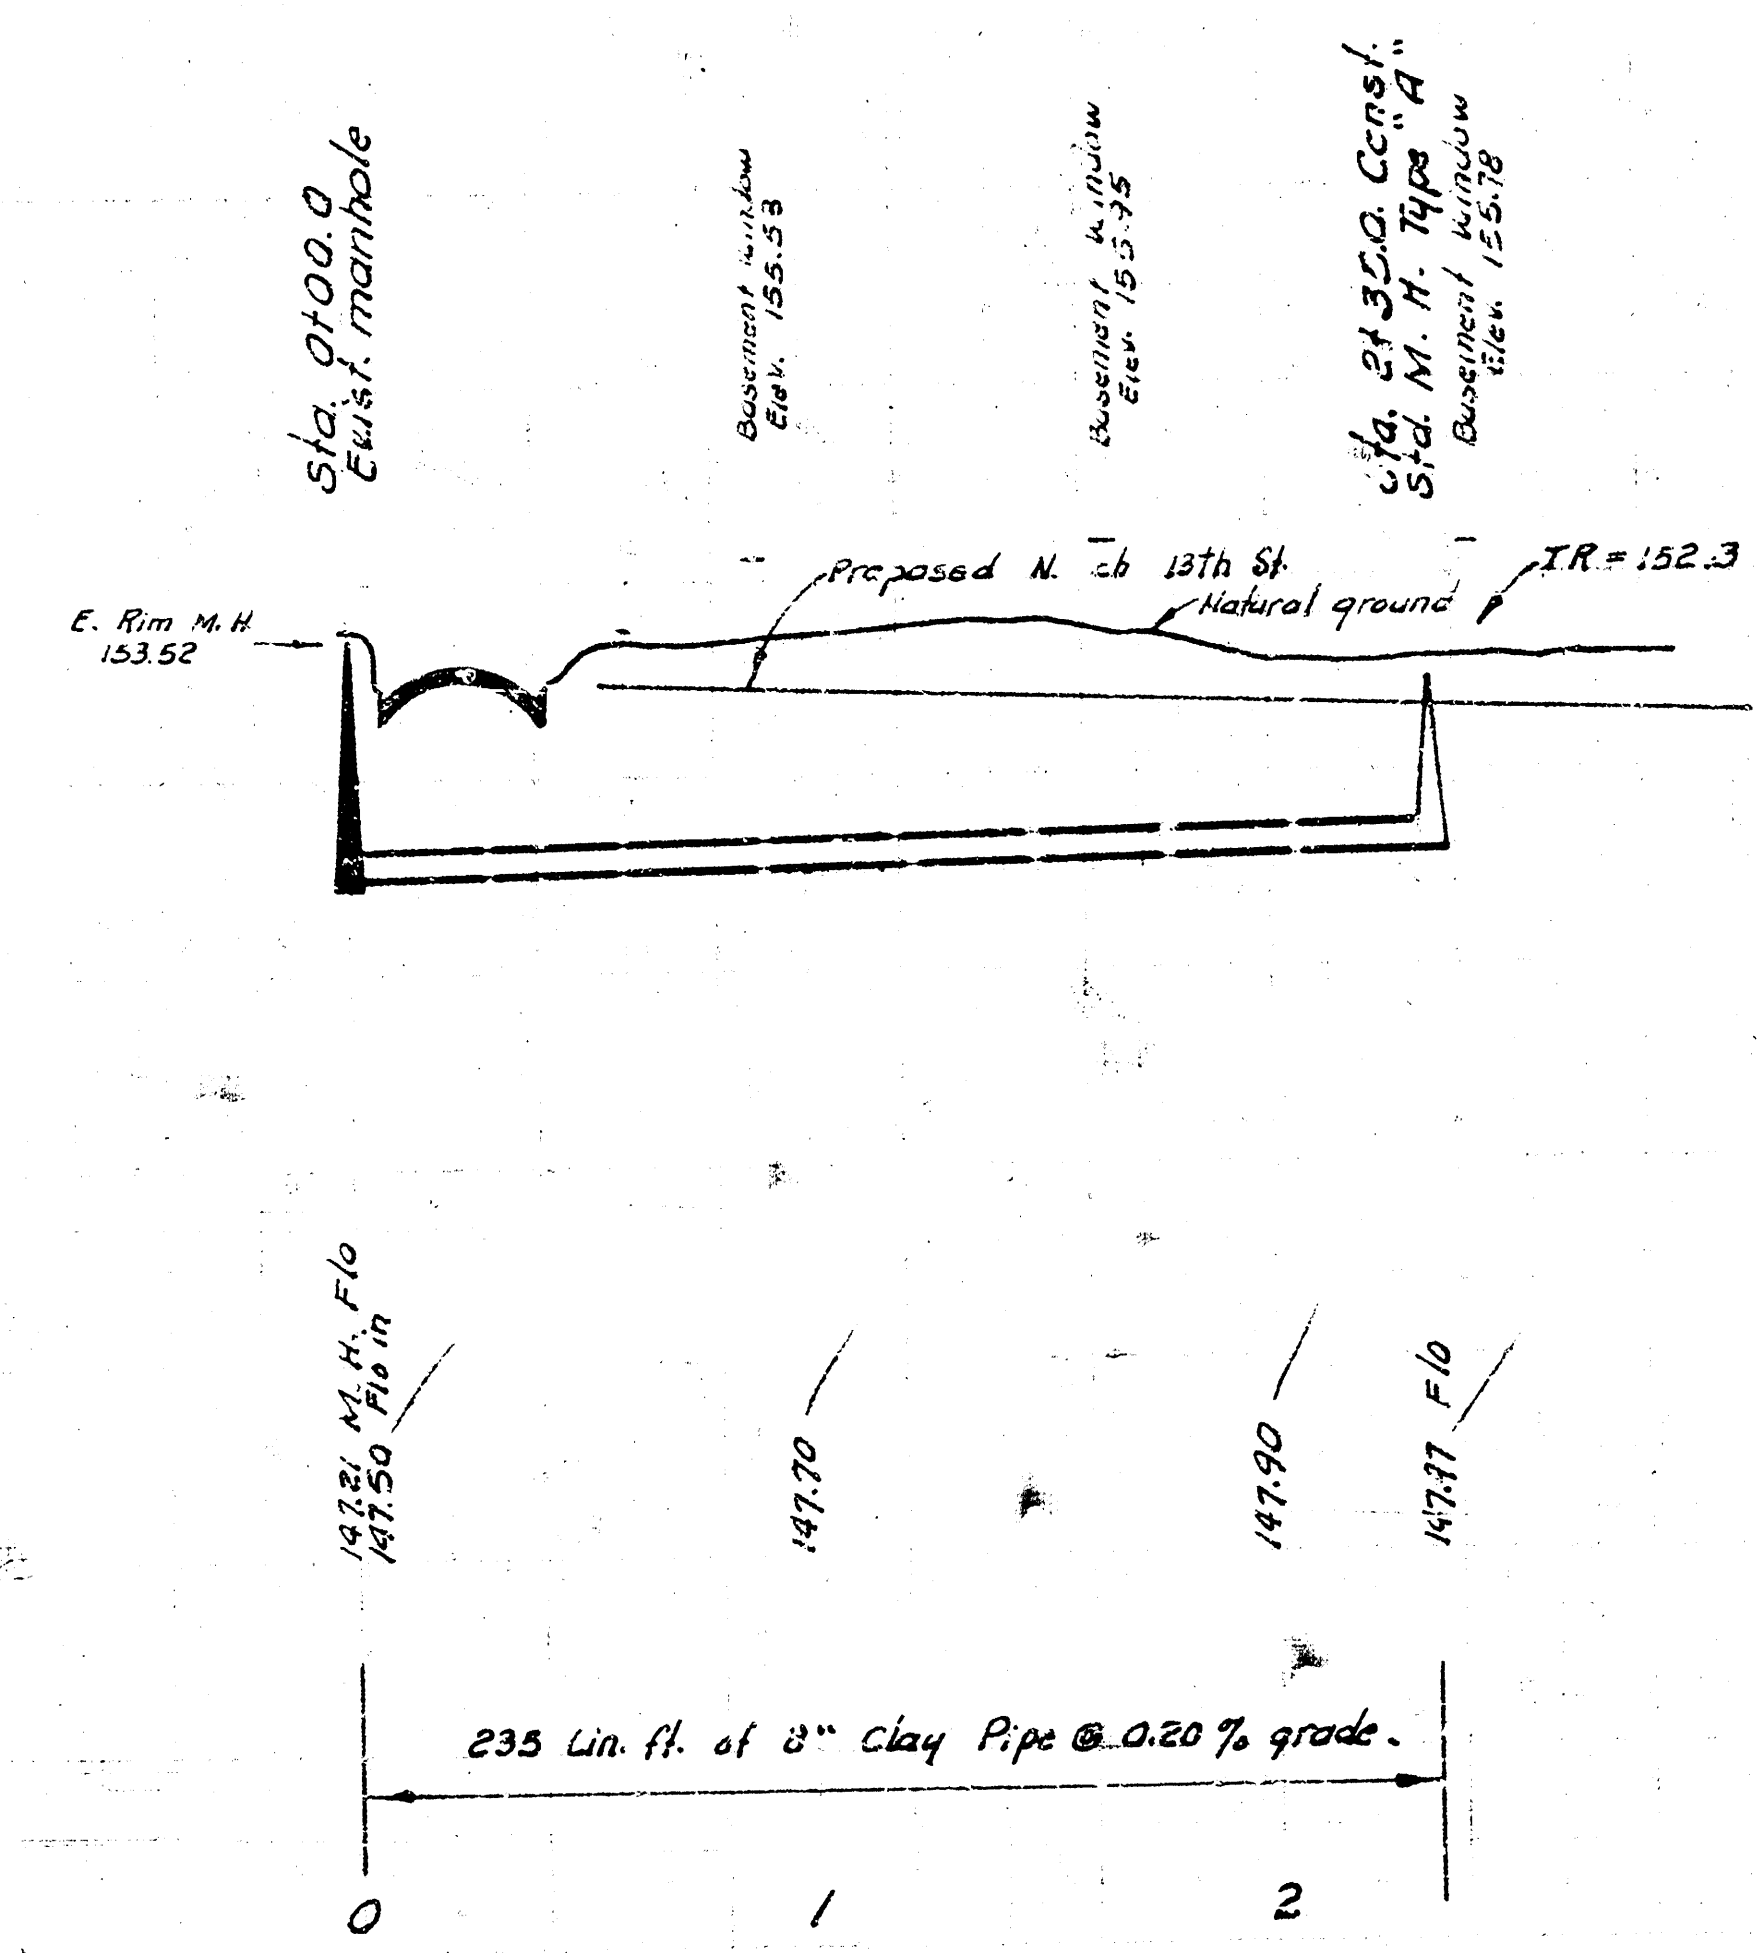

As Built Final Meas. 11-105

LAT. 57, WESTLINK SEWER
 CIT OF WICHITA, KANSAS
 R. W. LINN — CITY ENGINEER
 DEC. 1973 PROJECT NO. DBKL 573006