



B.M. 14226 ~ Std. 4135 S + 525 E @ both Centrl + Maize
 B.M. 14357 ~ R.R. spt. S-face PP SW cor. lot 1, blk. 1, Toh-N-Han Village,
 being 3rd. P.F. N of Squaw Lane in ES Maize Road

*Permits sold
 see sheet #2*

Plan Scale ~ 1" = 40'
 Profile Scale ~ 1" = 4'
 Vert. 1" = 5'

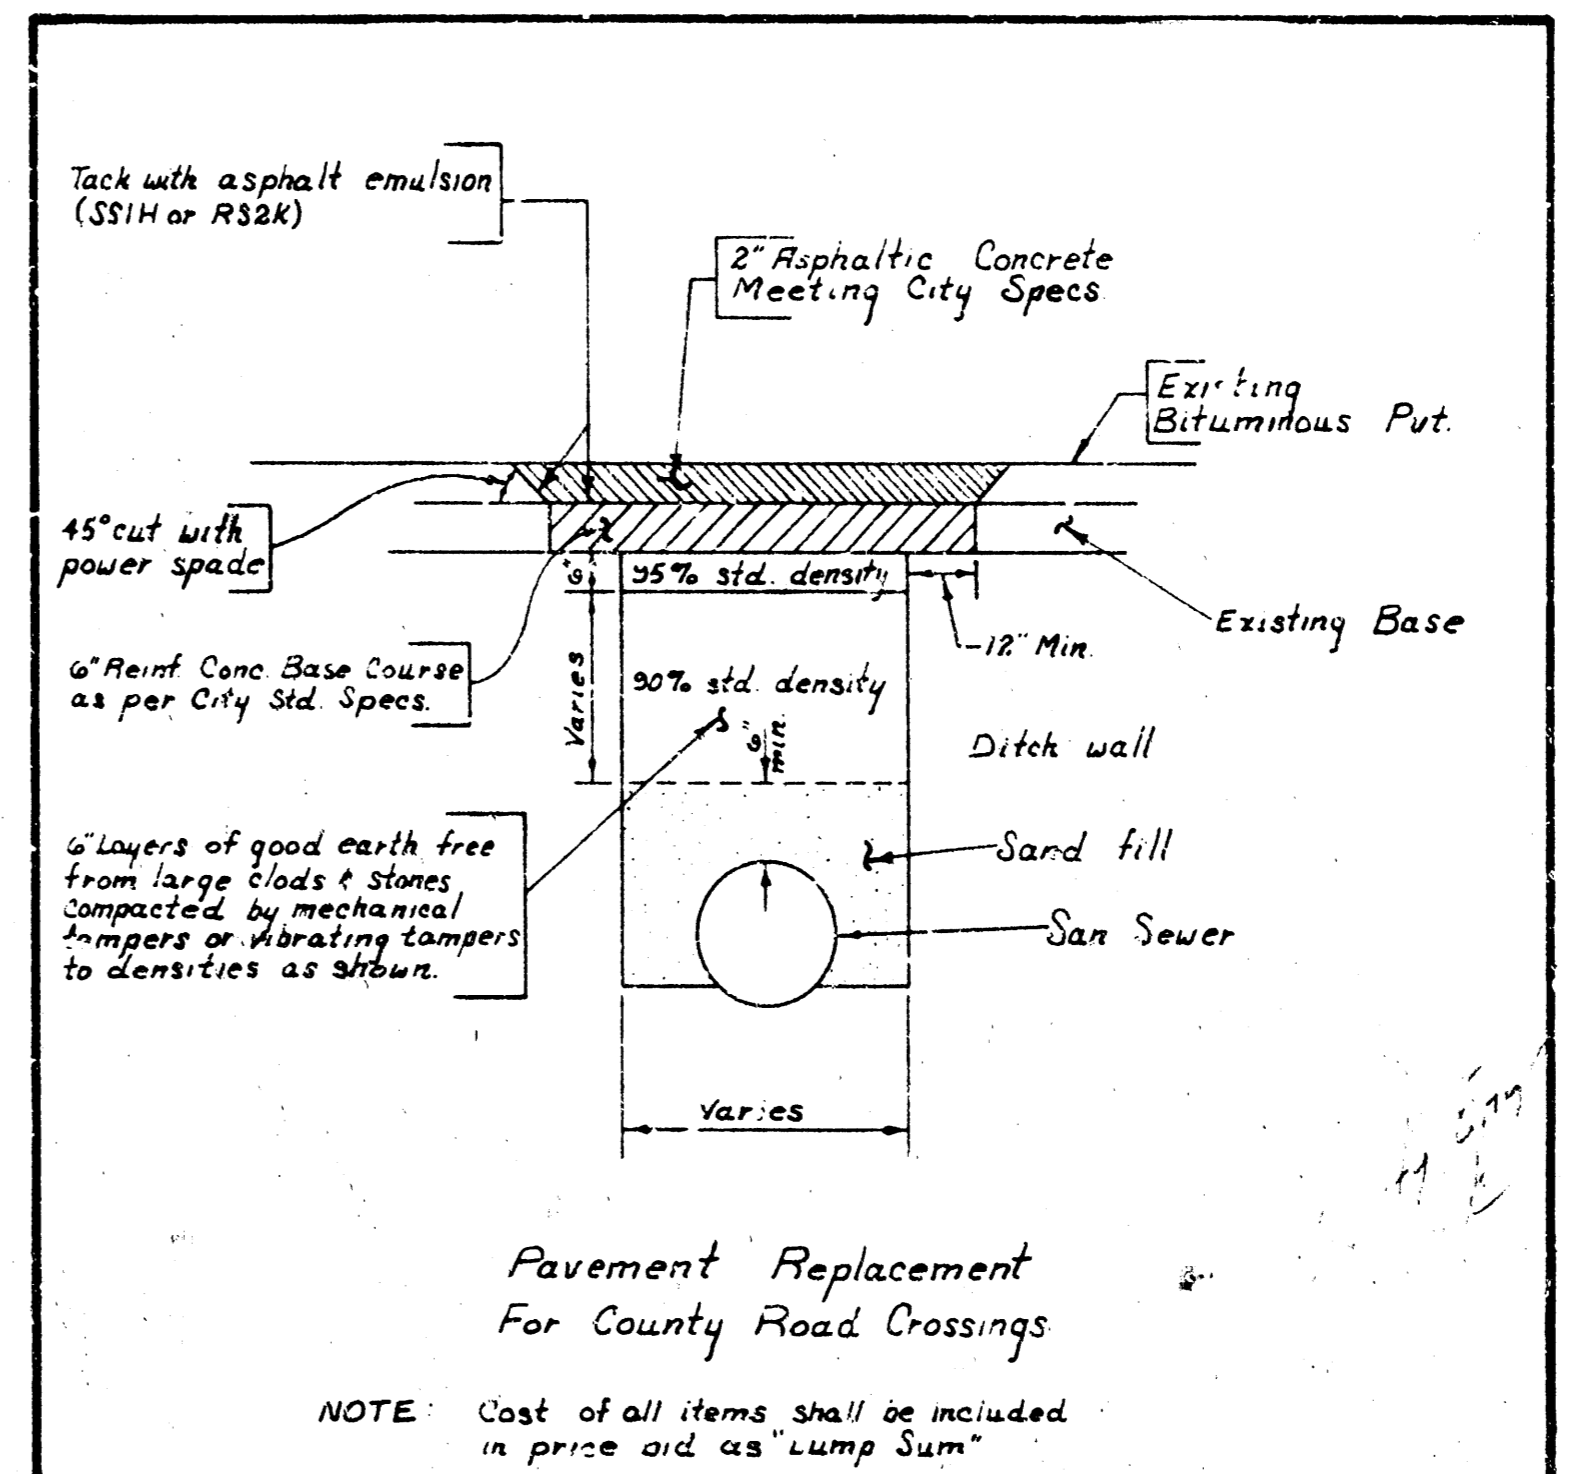


NOTE: Cost of all items shall be included in price bid as "Lump Sum"


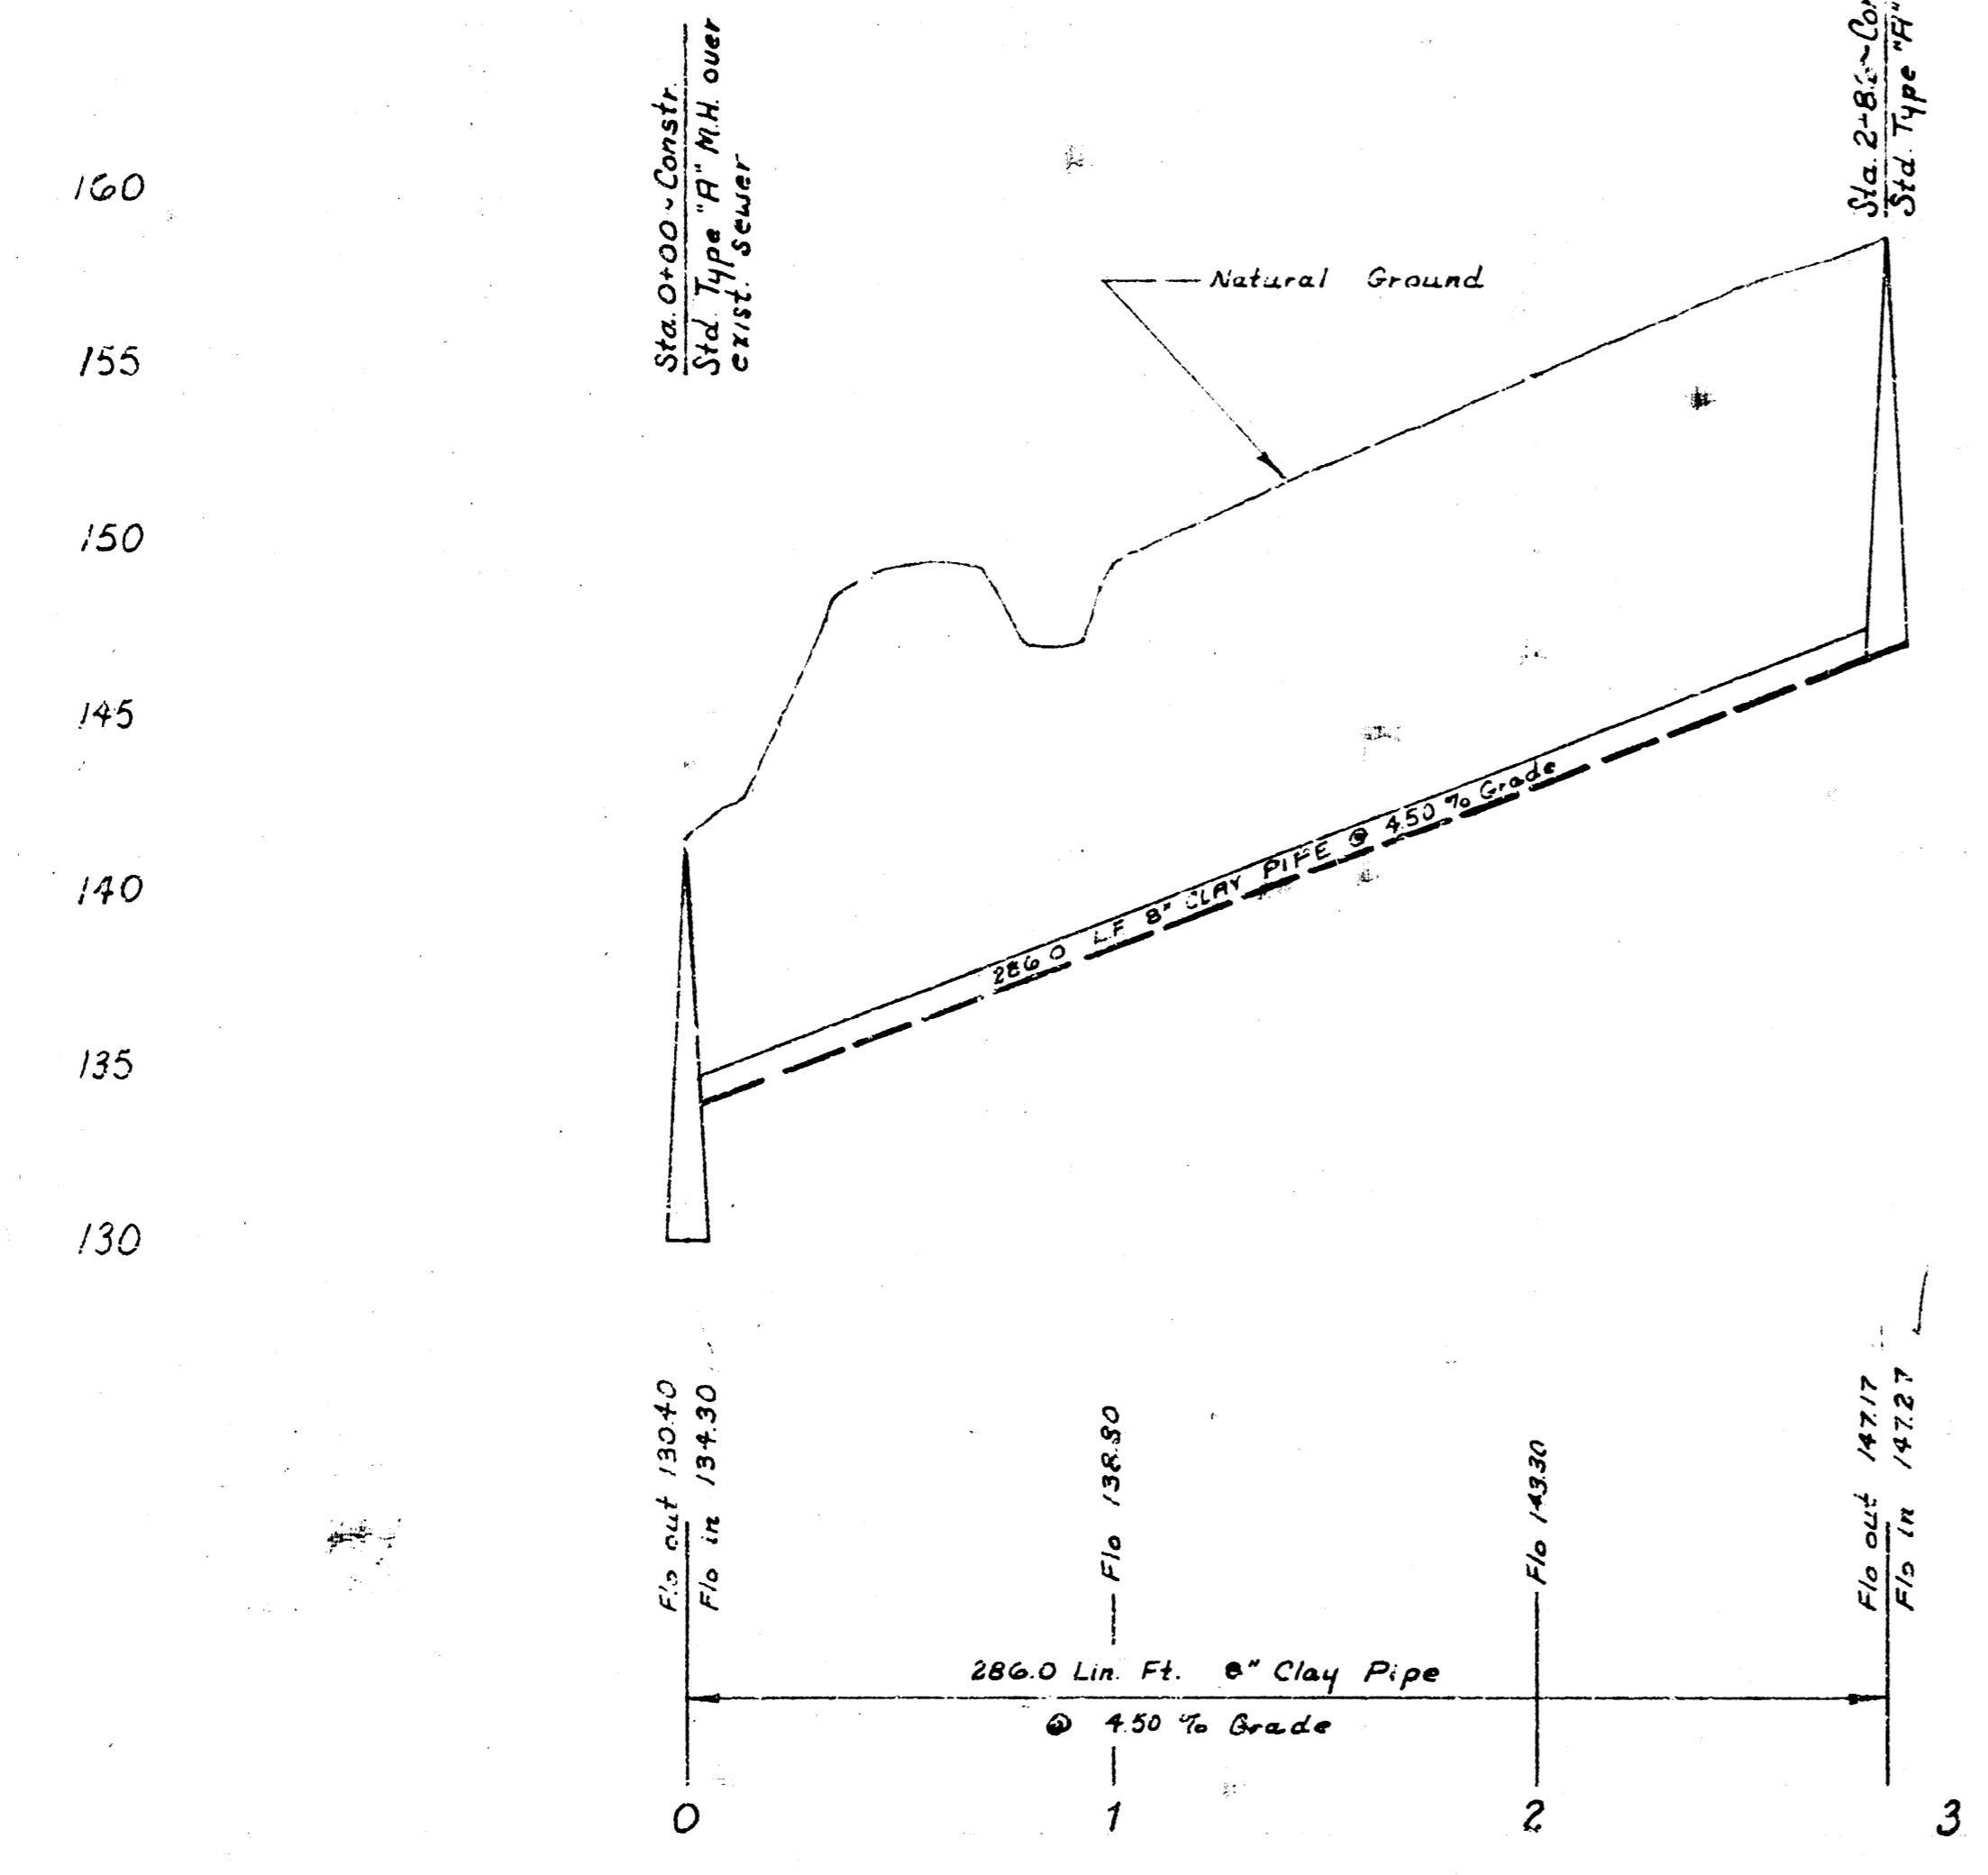


As Built Plans 4 Sept. 73 from K-106
LATERAL 58
WESTLINK INTERCEPTOR
CITY OF WICHITA
R.W. LINN-CITY ENGINEER
 DATE JULY 1973 PROJ. NO. DBKL 573028

1/2

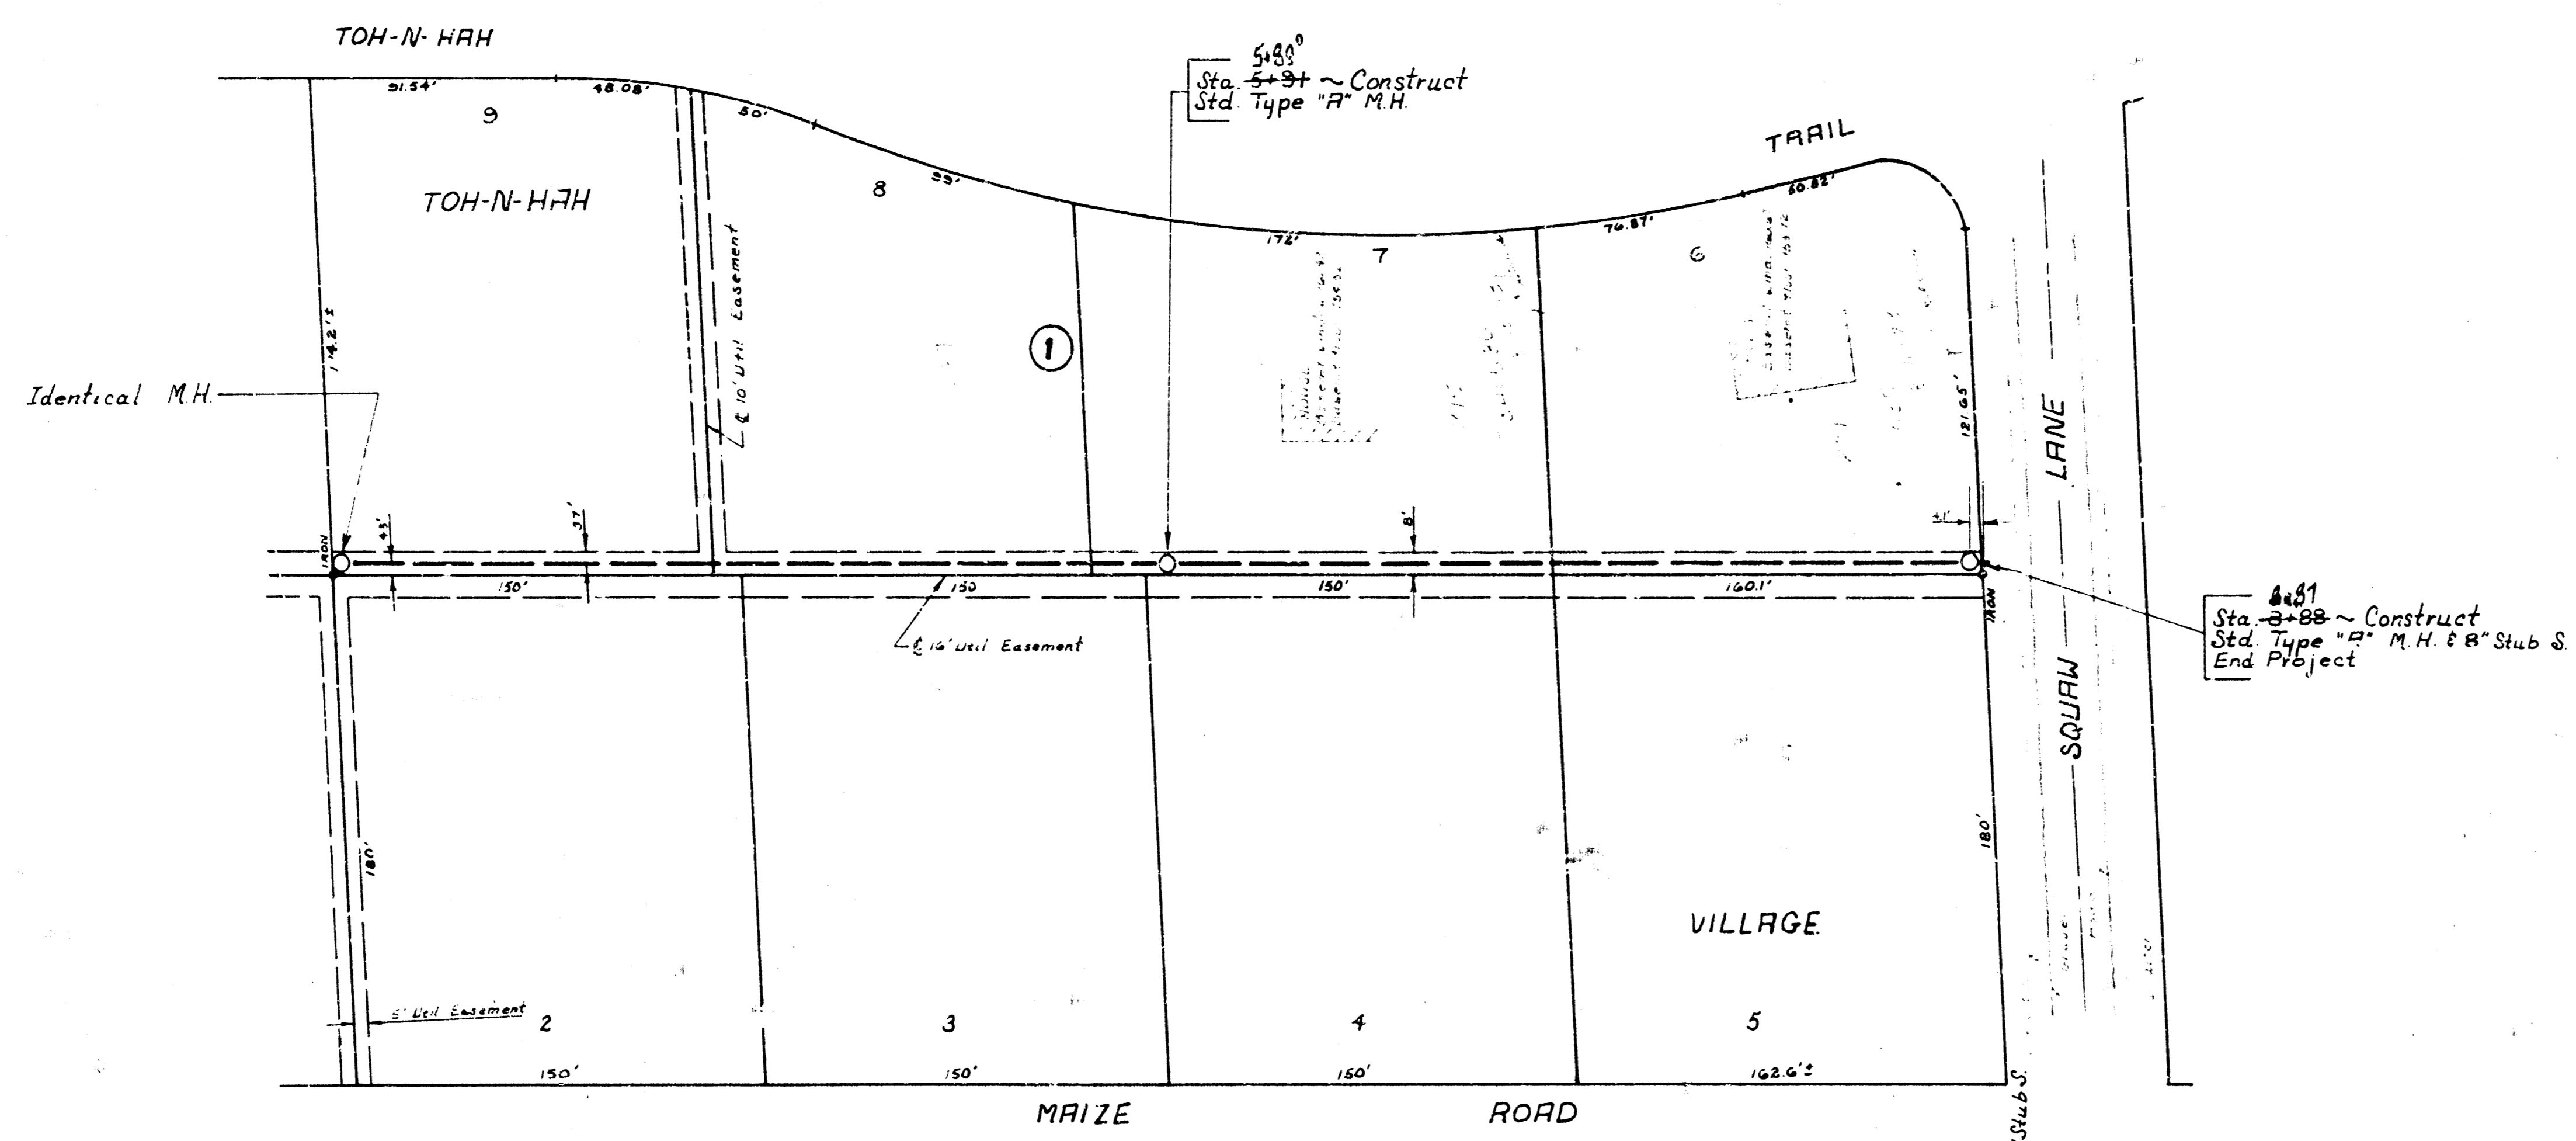

Plan Scale ~ 1" = 40'
 Profile Scale ~ Vert 1" = 5'
 Horiz 1" = 40'

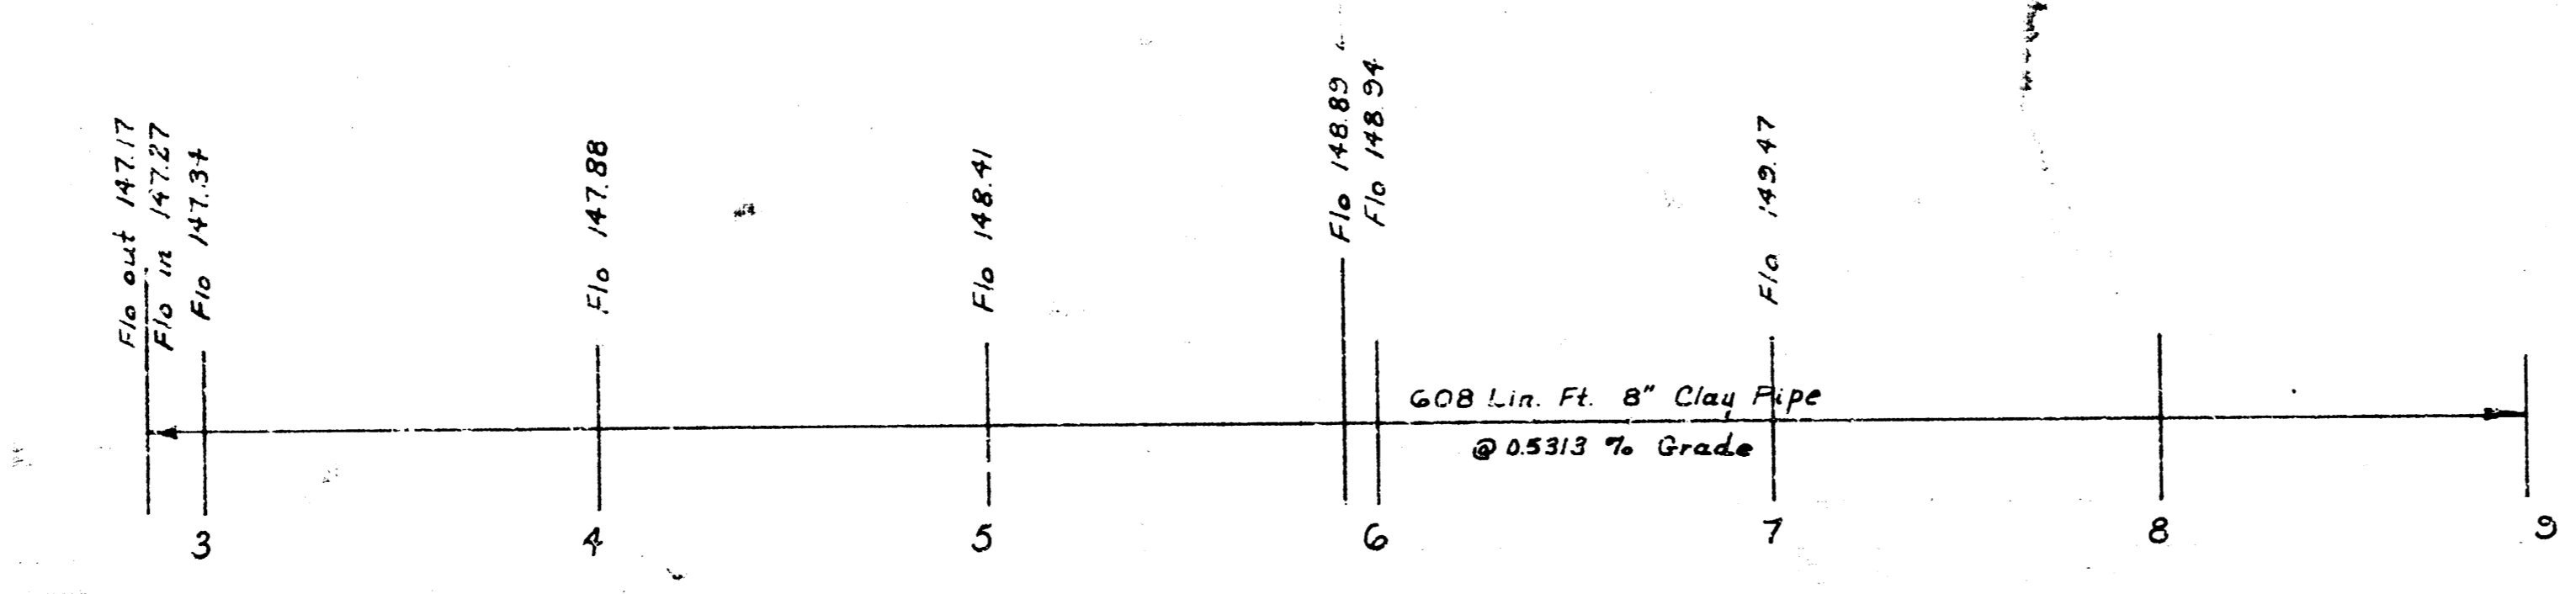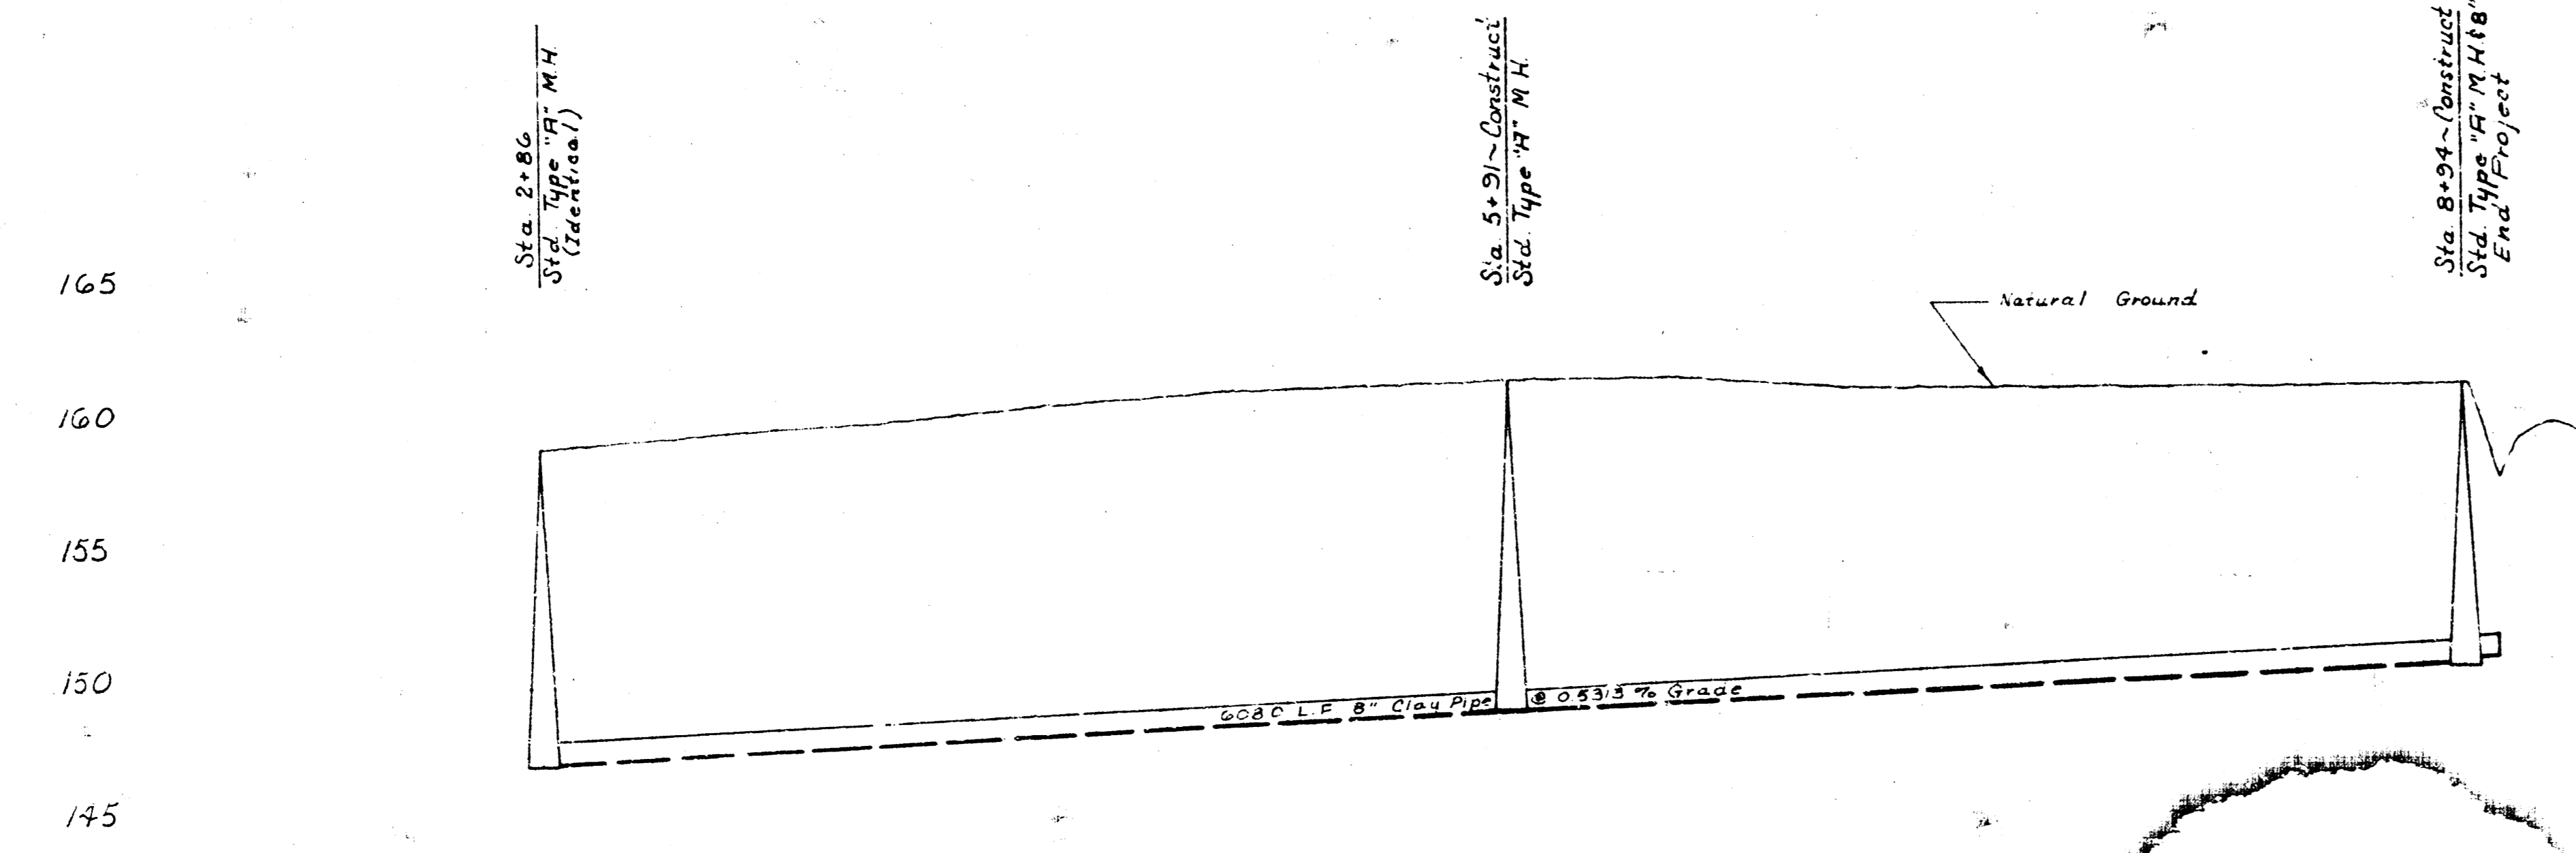

4 R S G