



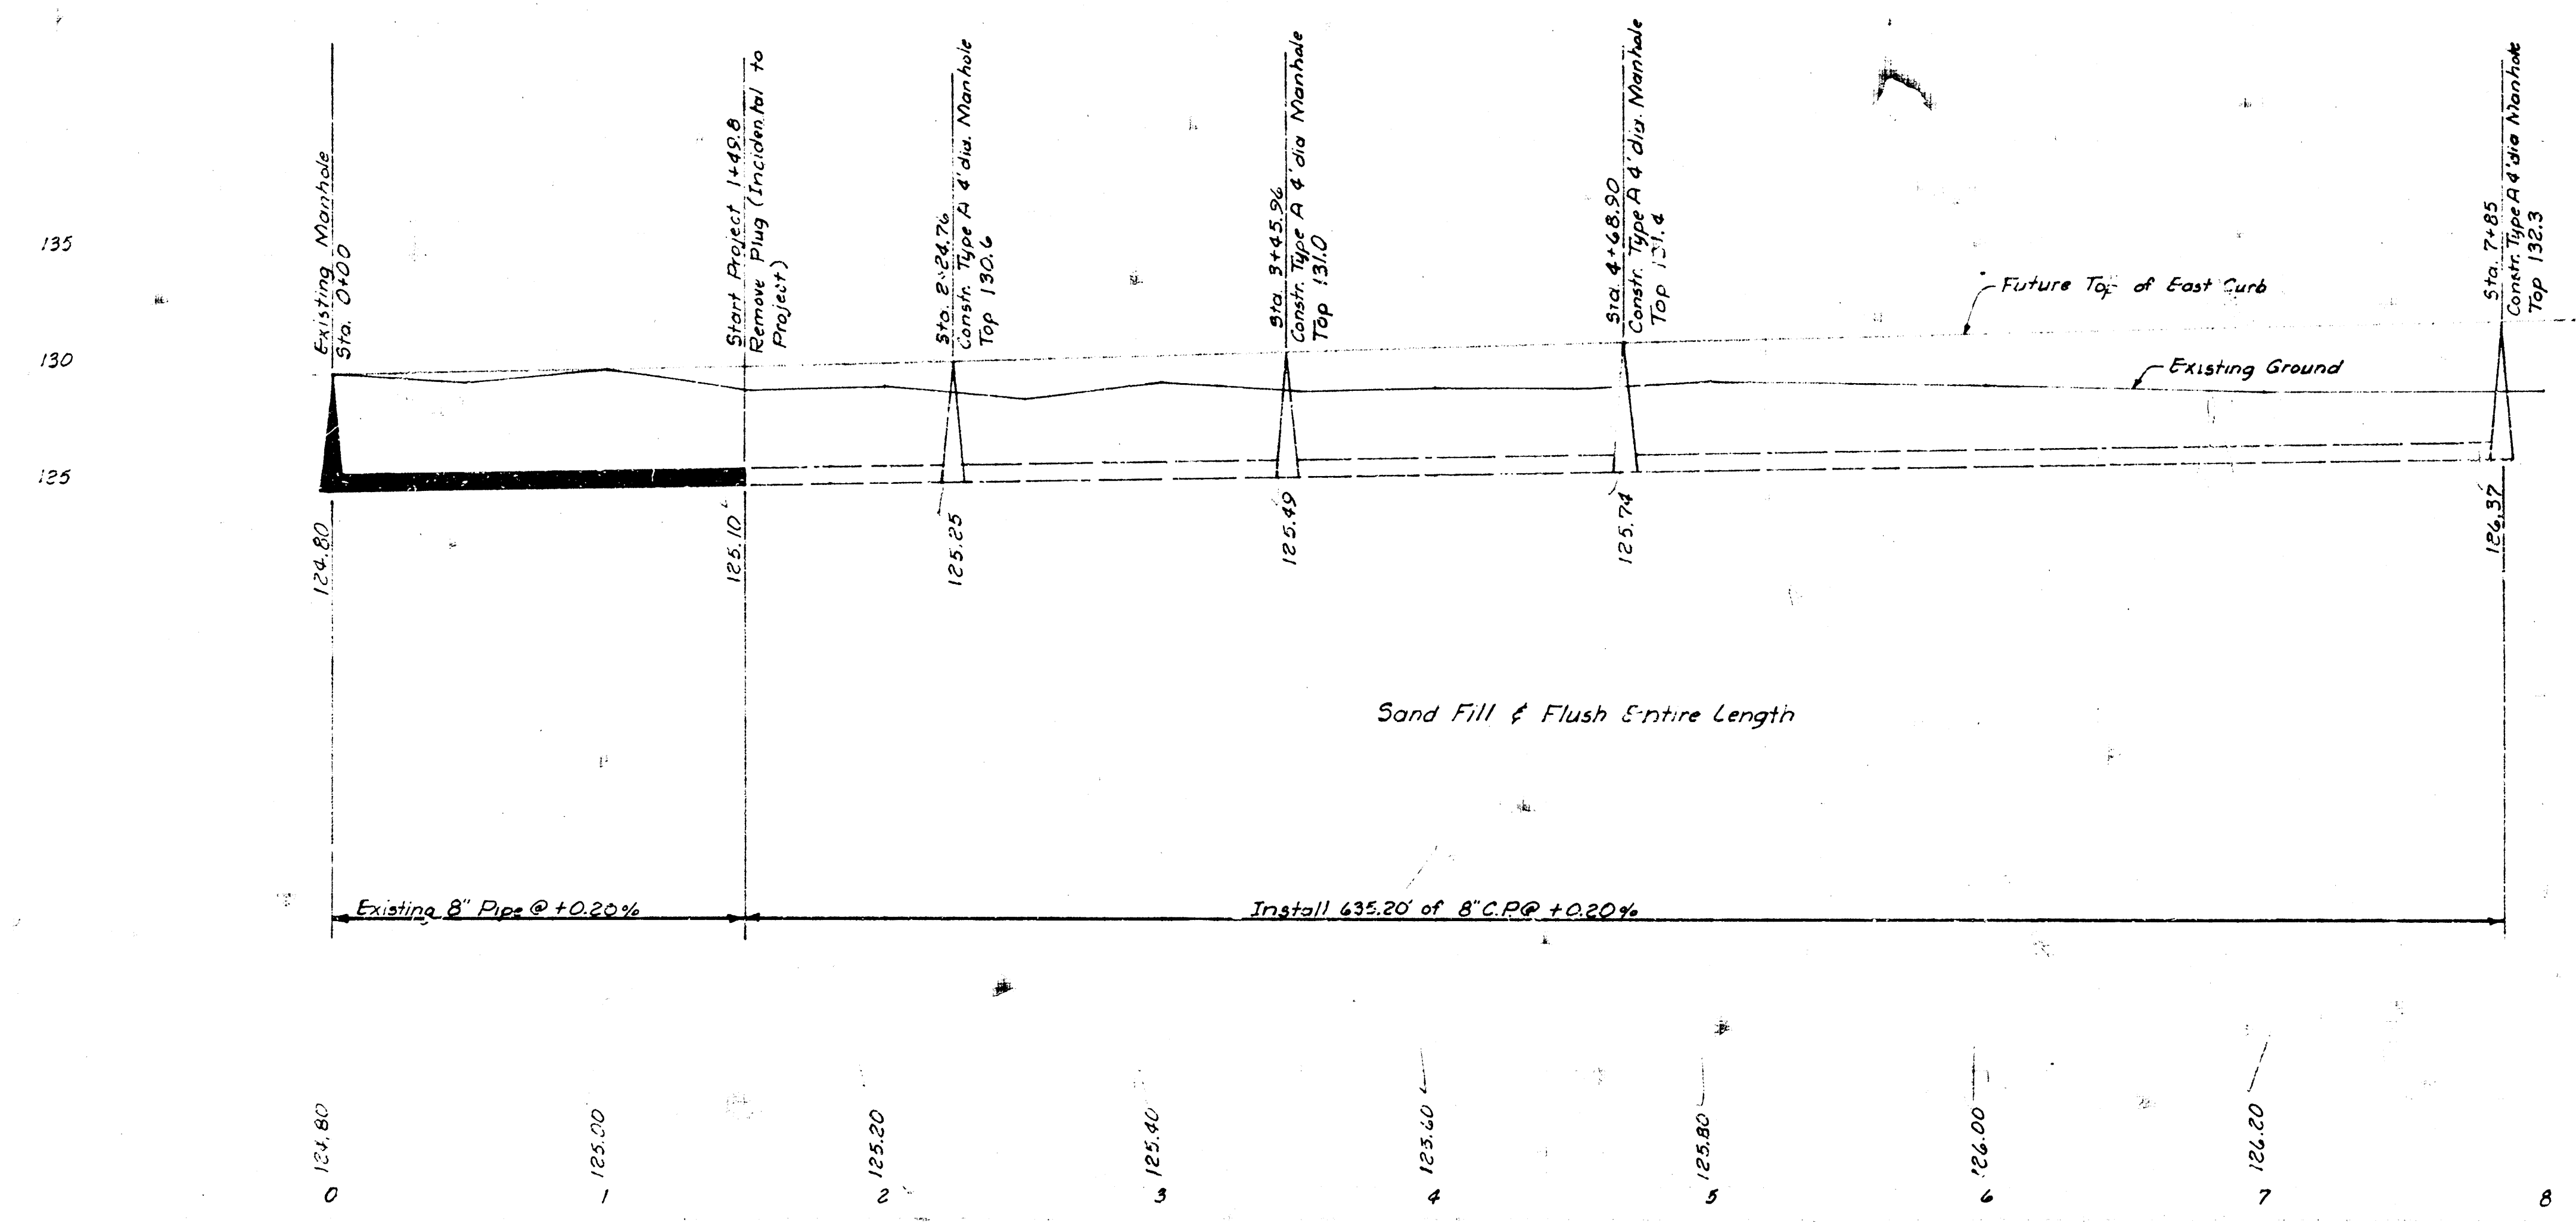

PROFILE SCALE:
Hor. 1" = 40'
Ver. 1" = 5'

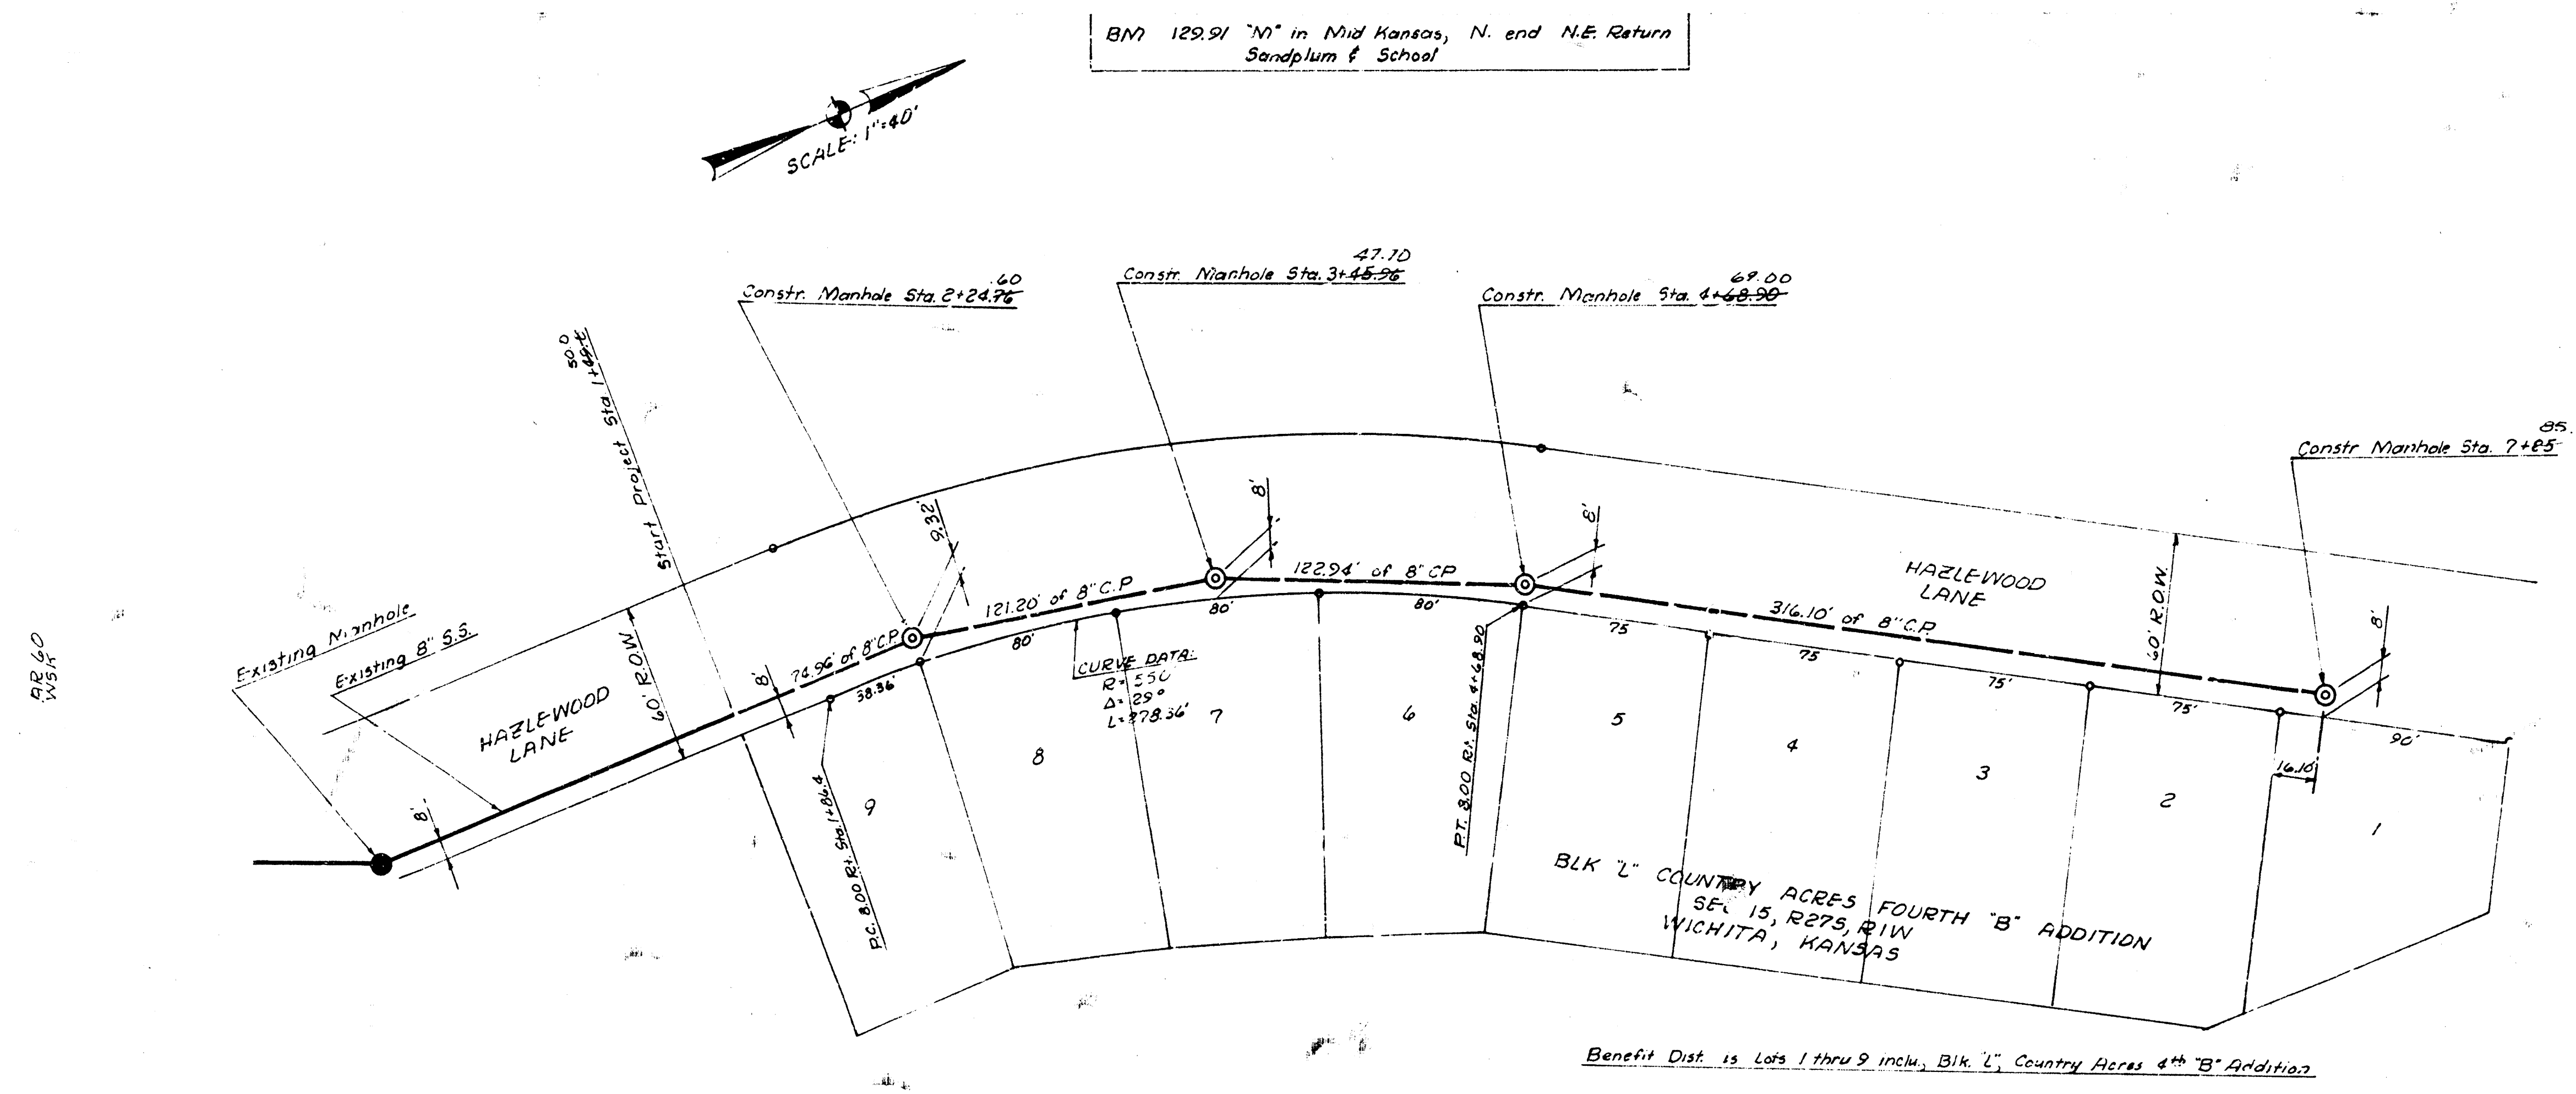

FINAL MEAS. "AS BUILT"
LAT 61, WESTLINK SEWER
CITY OF WICHITA, KANSAS
R.W. LINN, City Engineer
Project No. DBK 574023
DATE: _____

Sheet 1 of 1

14 0 4 3