


LAT 66 WESTLINK SEWER

CITY OF WICHITA

R.W.BRUGGEMAN - CITY ENGINEER

PROJECT NO. 468-76-245-80991-000-000-001

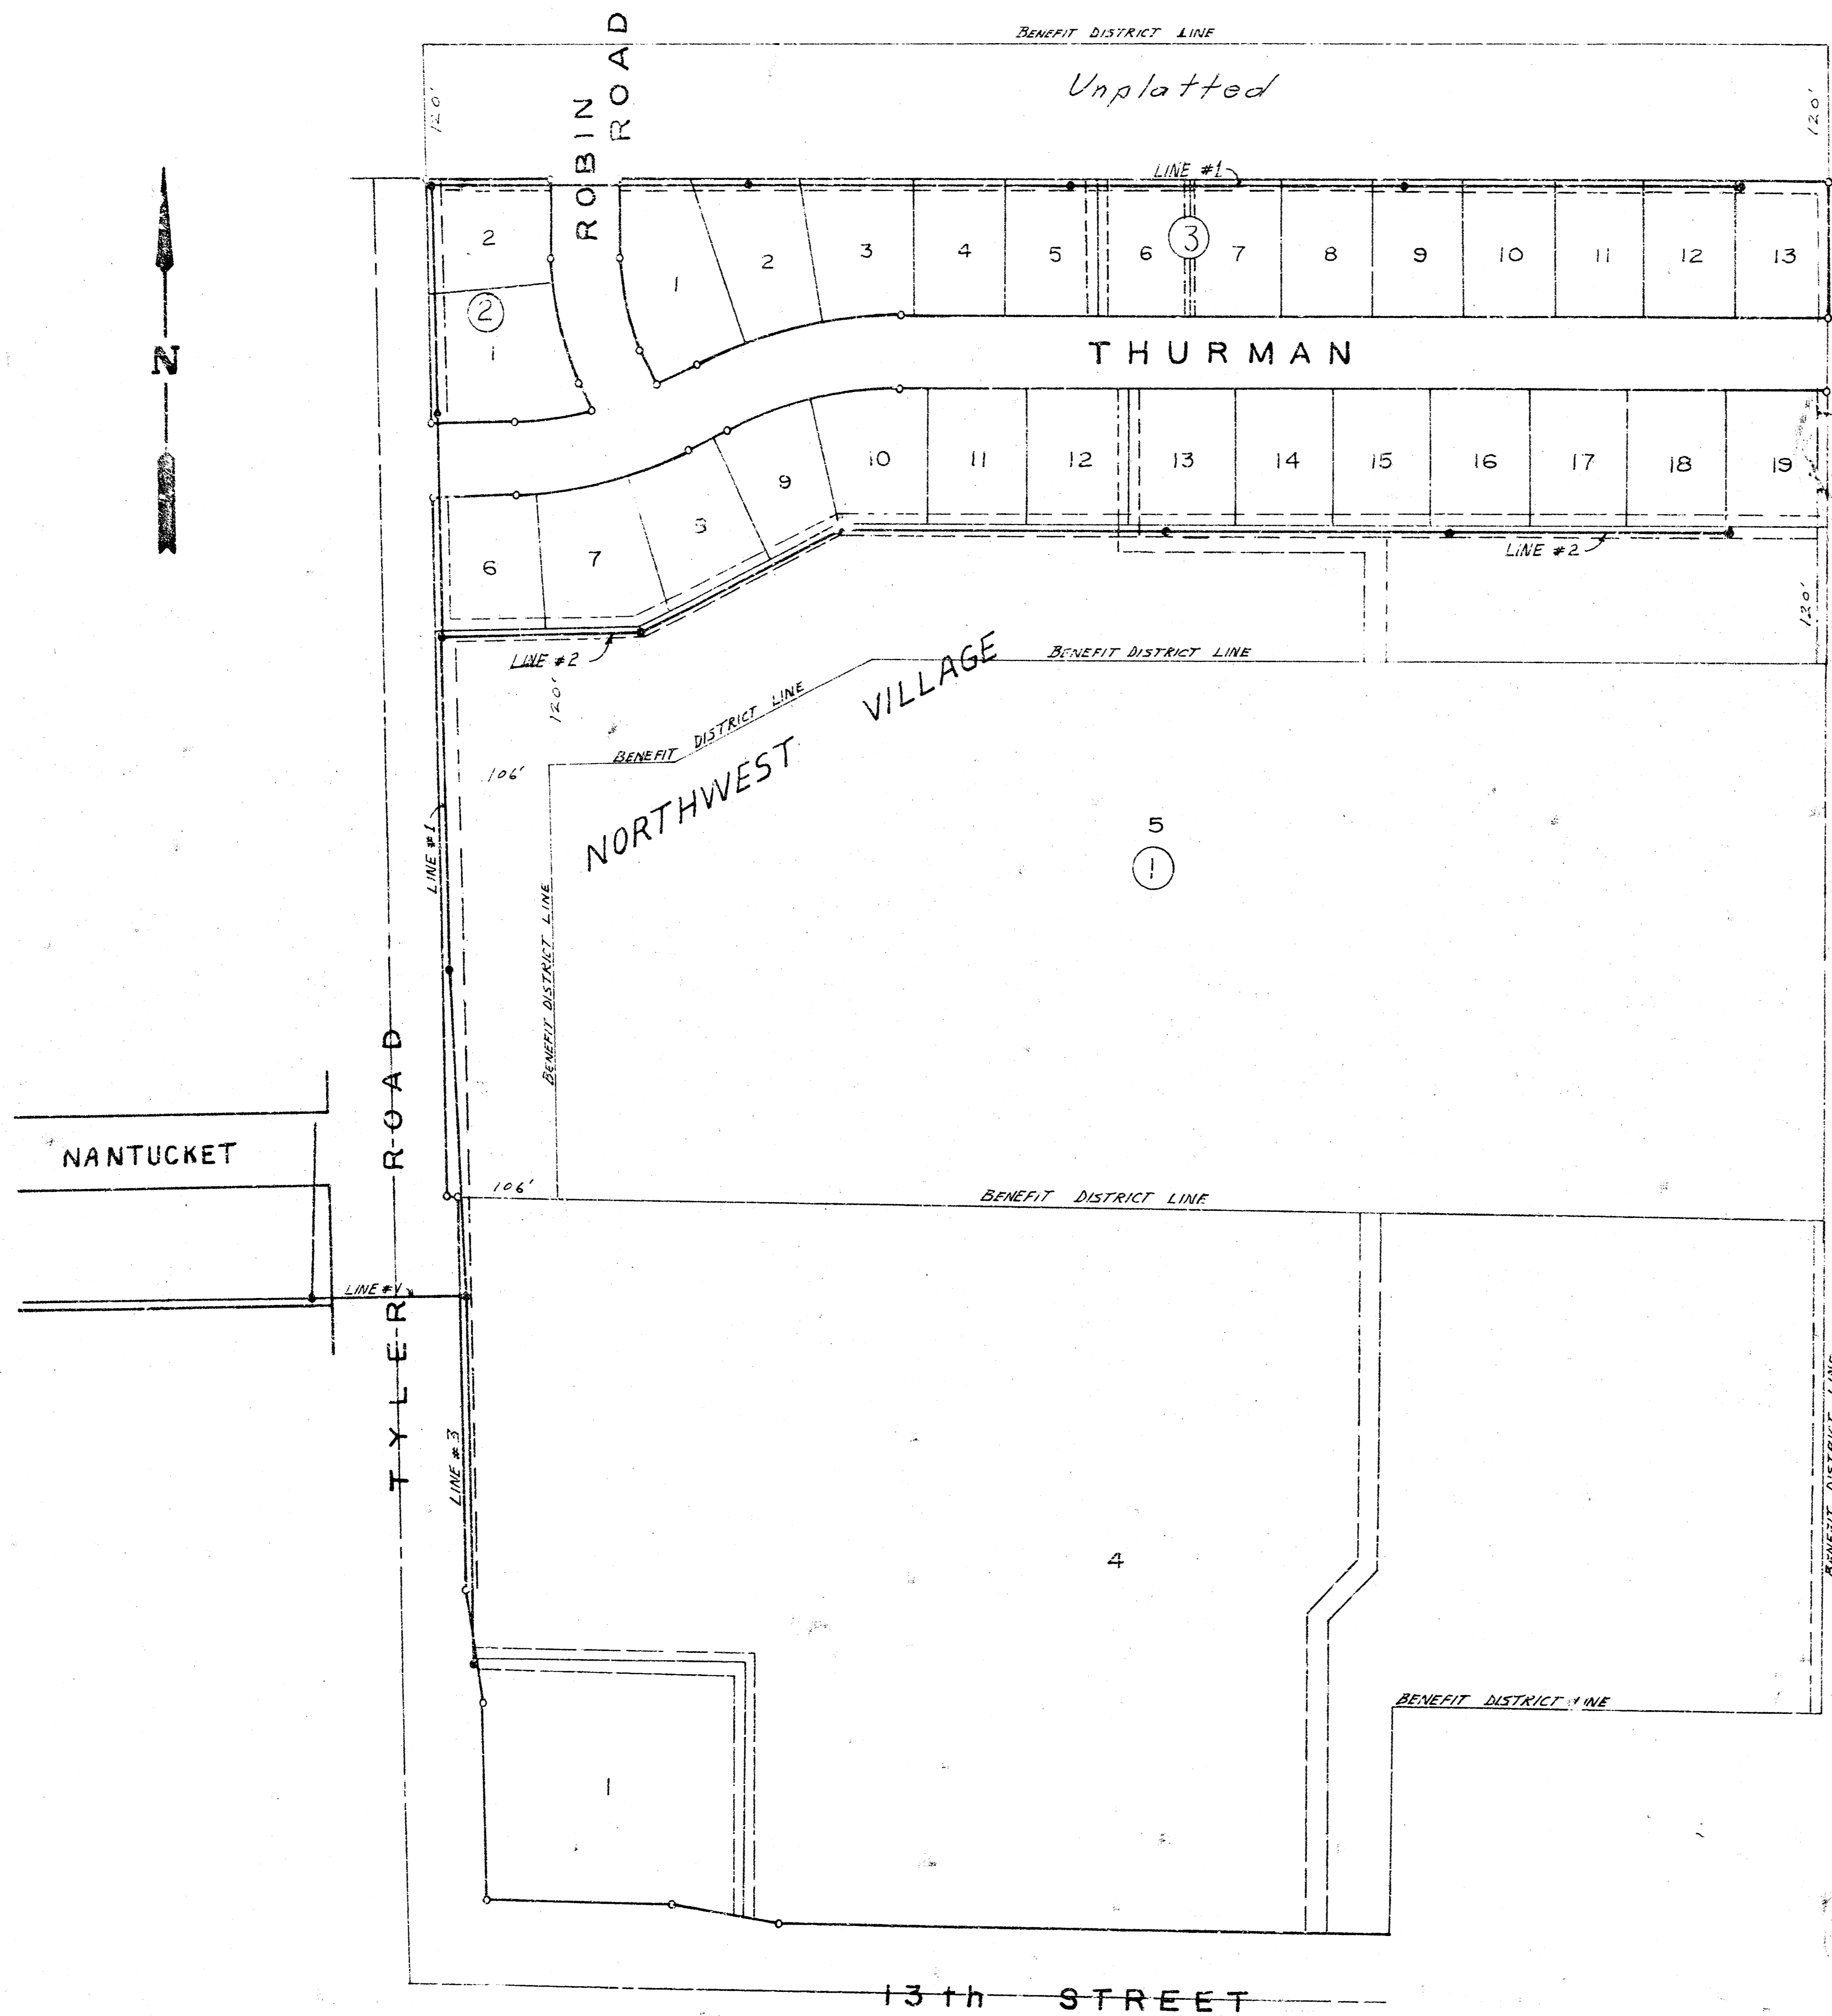

LINE #1	SHEETS	2-3
LINE #2	SHEETS	4-5
LINE #3	SHEET	5


As Built
5/81
JLL



NOTE: TELEPHONE CABLE RUNS N/S ON WEST SIDE & E SIDE OF TYLER ROAD.

SCALE: PLAN 1" = 40'
PROFILE 1" = 40' VERT

CAUTION
UNDERGROUND
UTILITIES

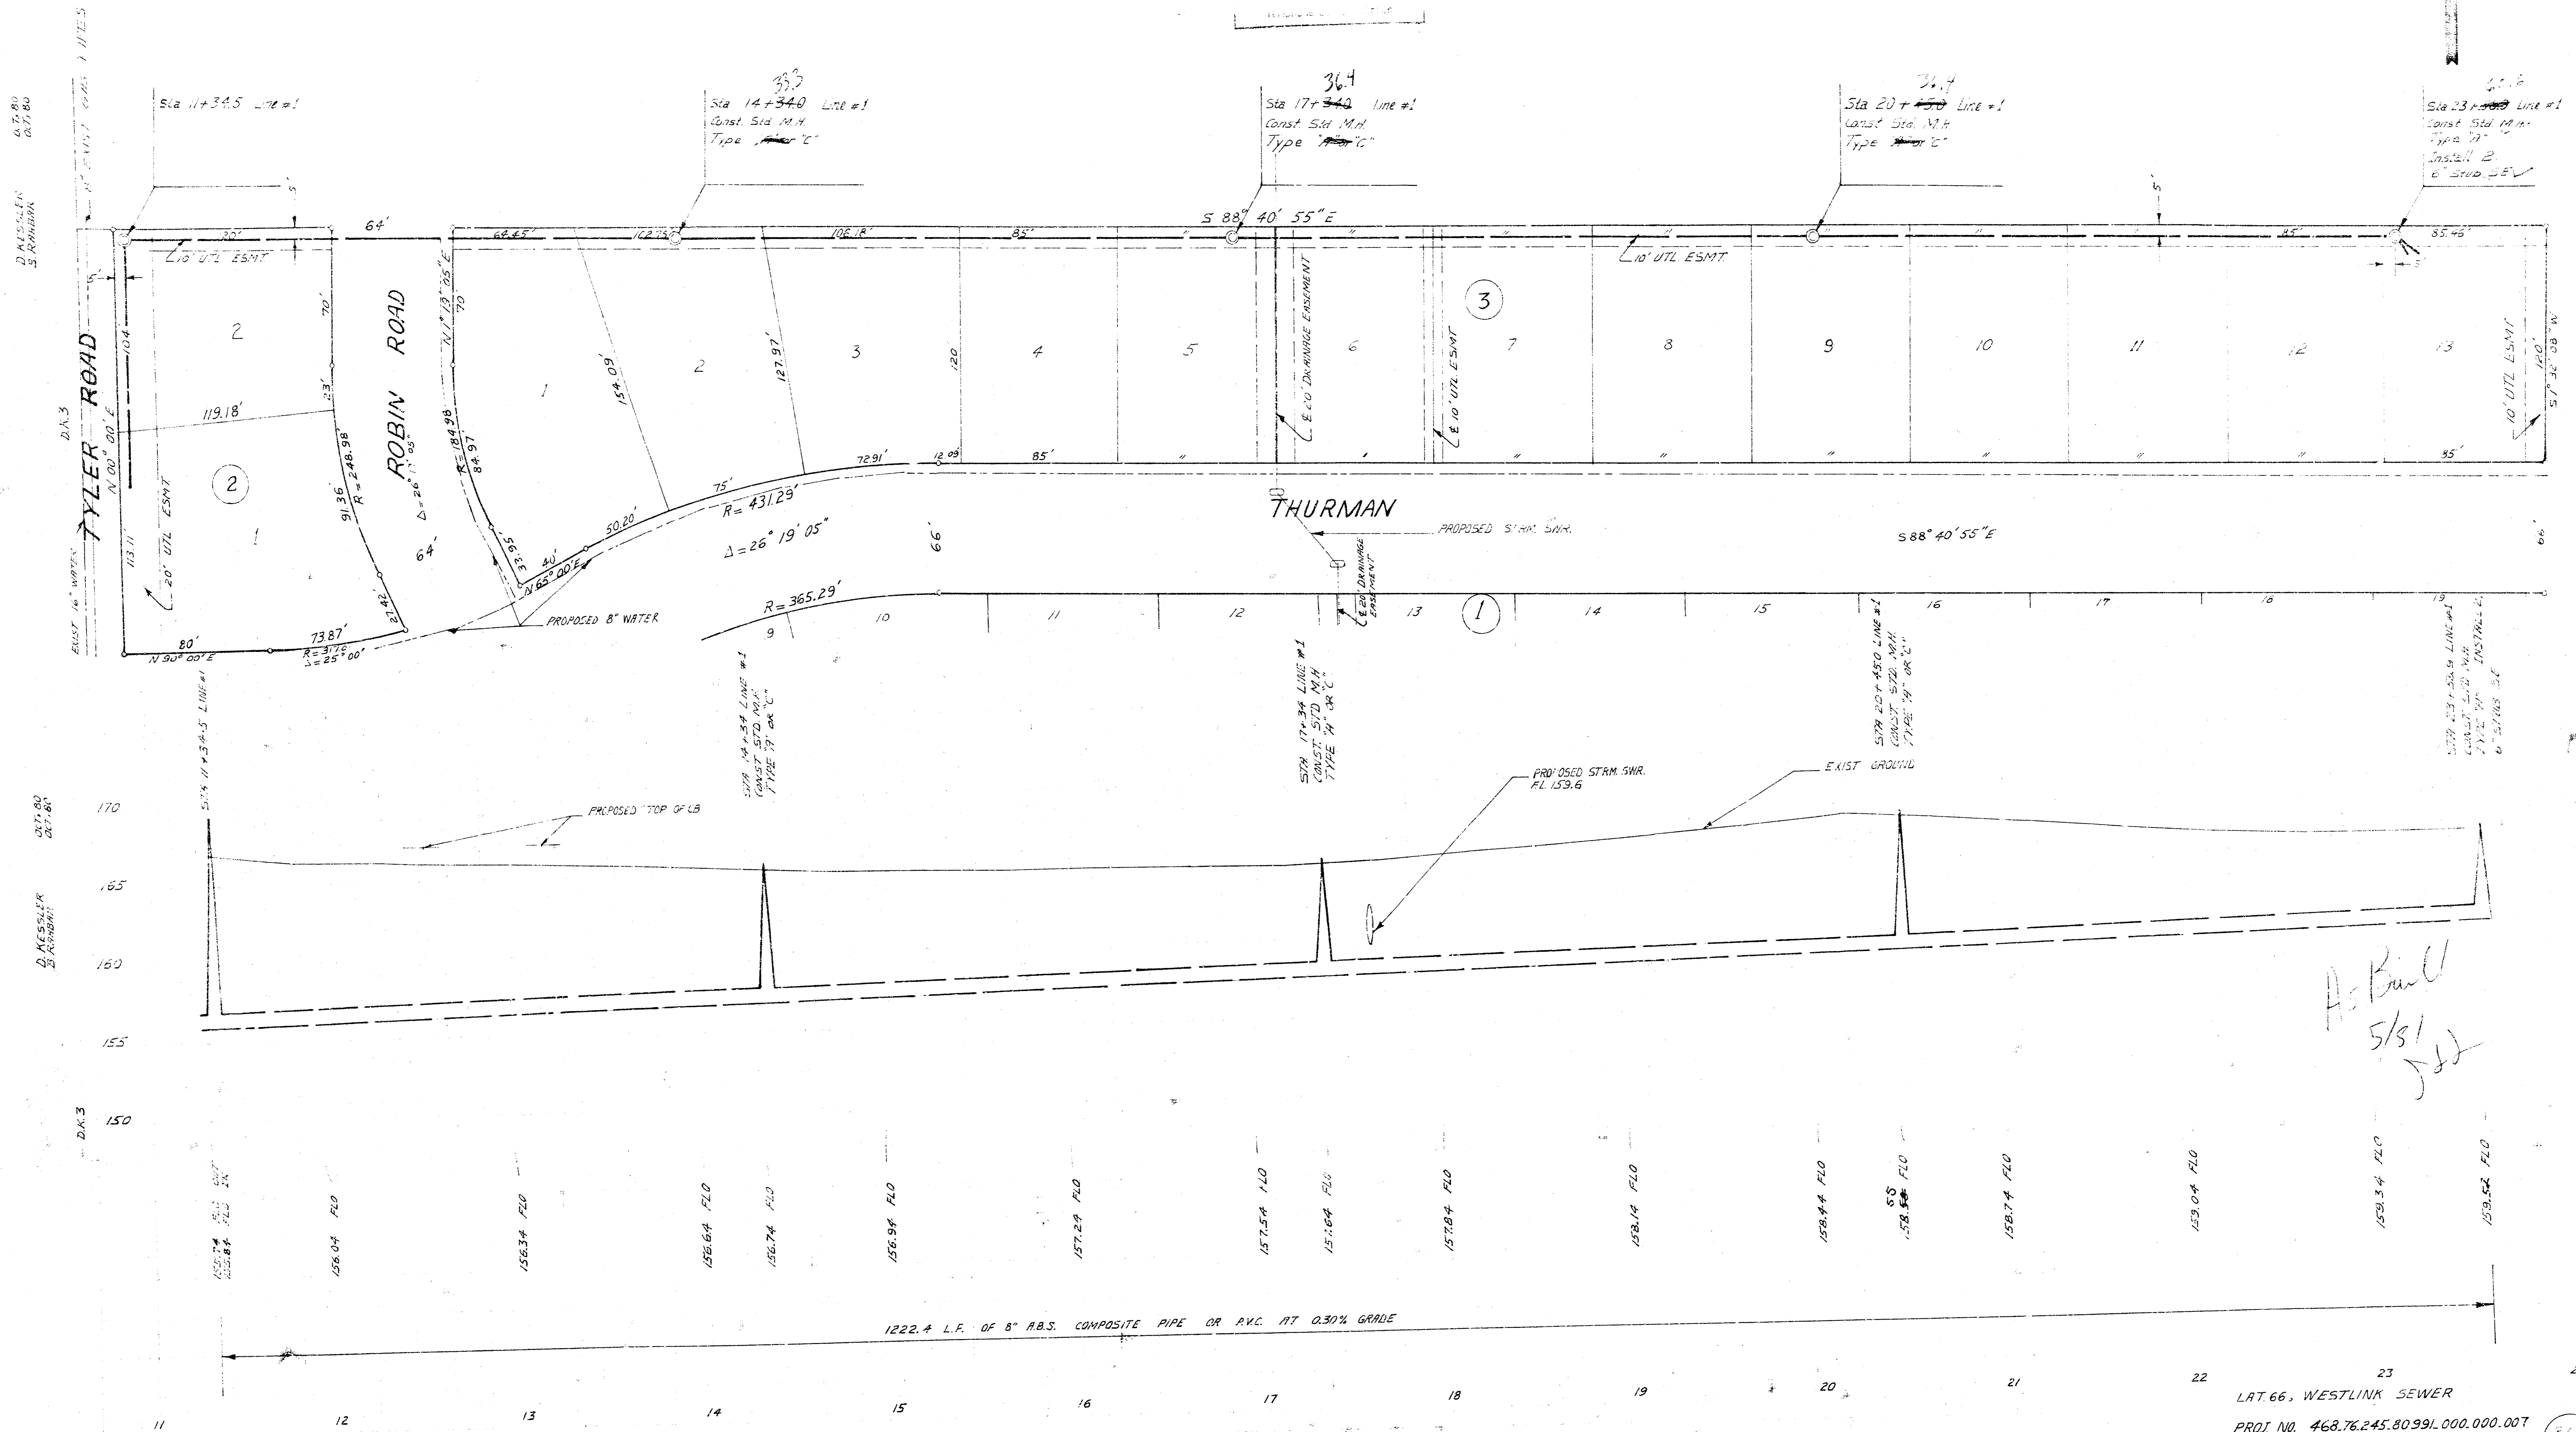


*As Built
5/5/1
JSD*


LAT. 66, WESTLINK SEWER
PROJ. NO. 468.76.245.80991.000.000.007

FILMED FROM THE BEST
AVAILABLE COPY.....

SCALE PLAN 1" = 40'
 PROFILE 1" = 40' HORIZ
 1" = 5' VERT

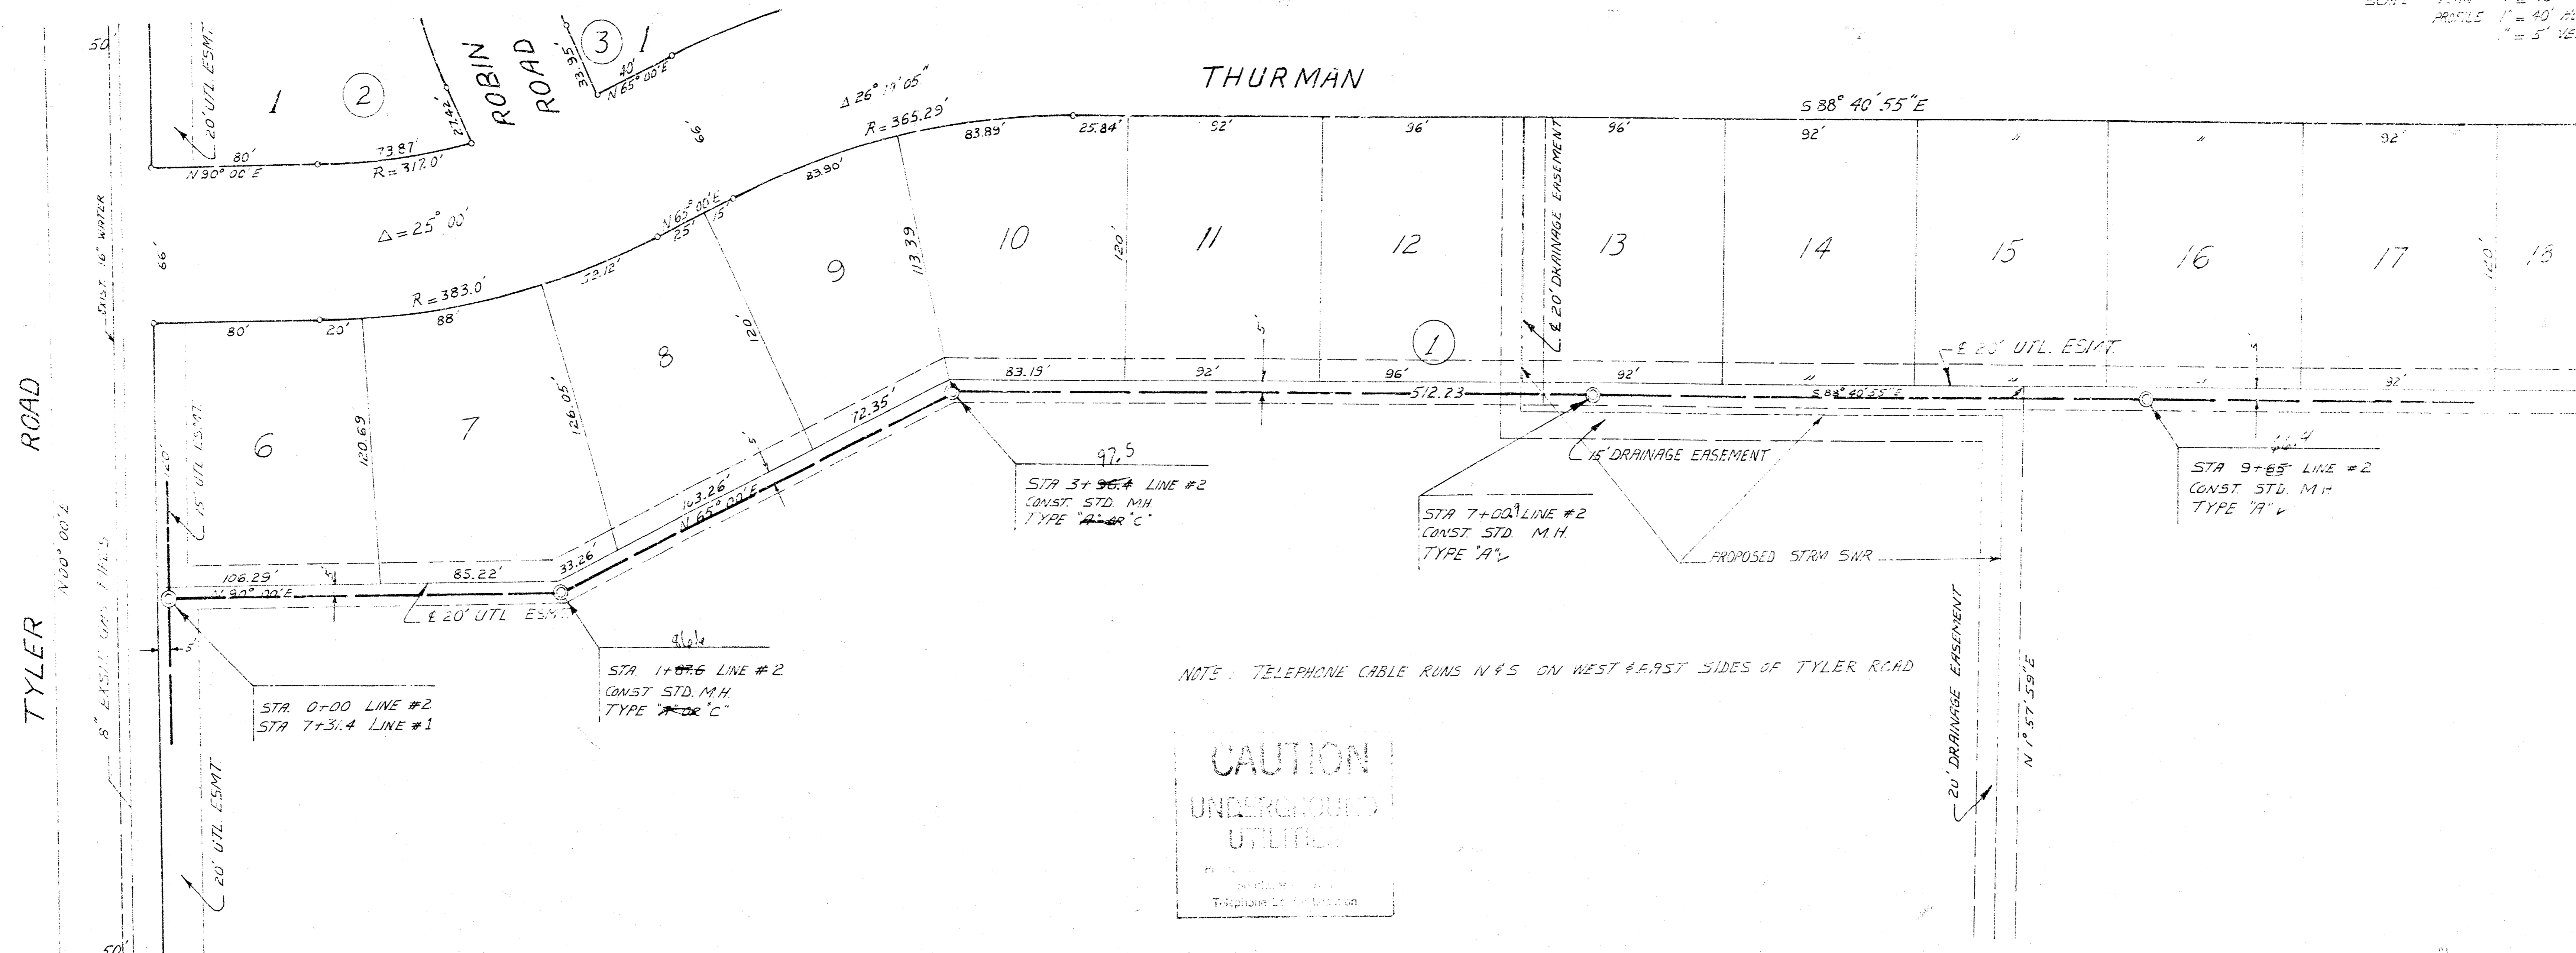

CAUTION
 UNDEGROUND UTILITIES

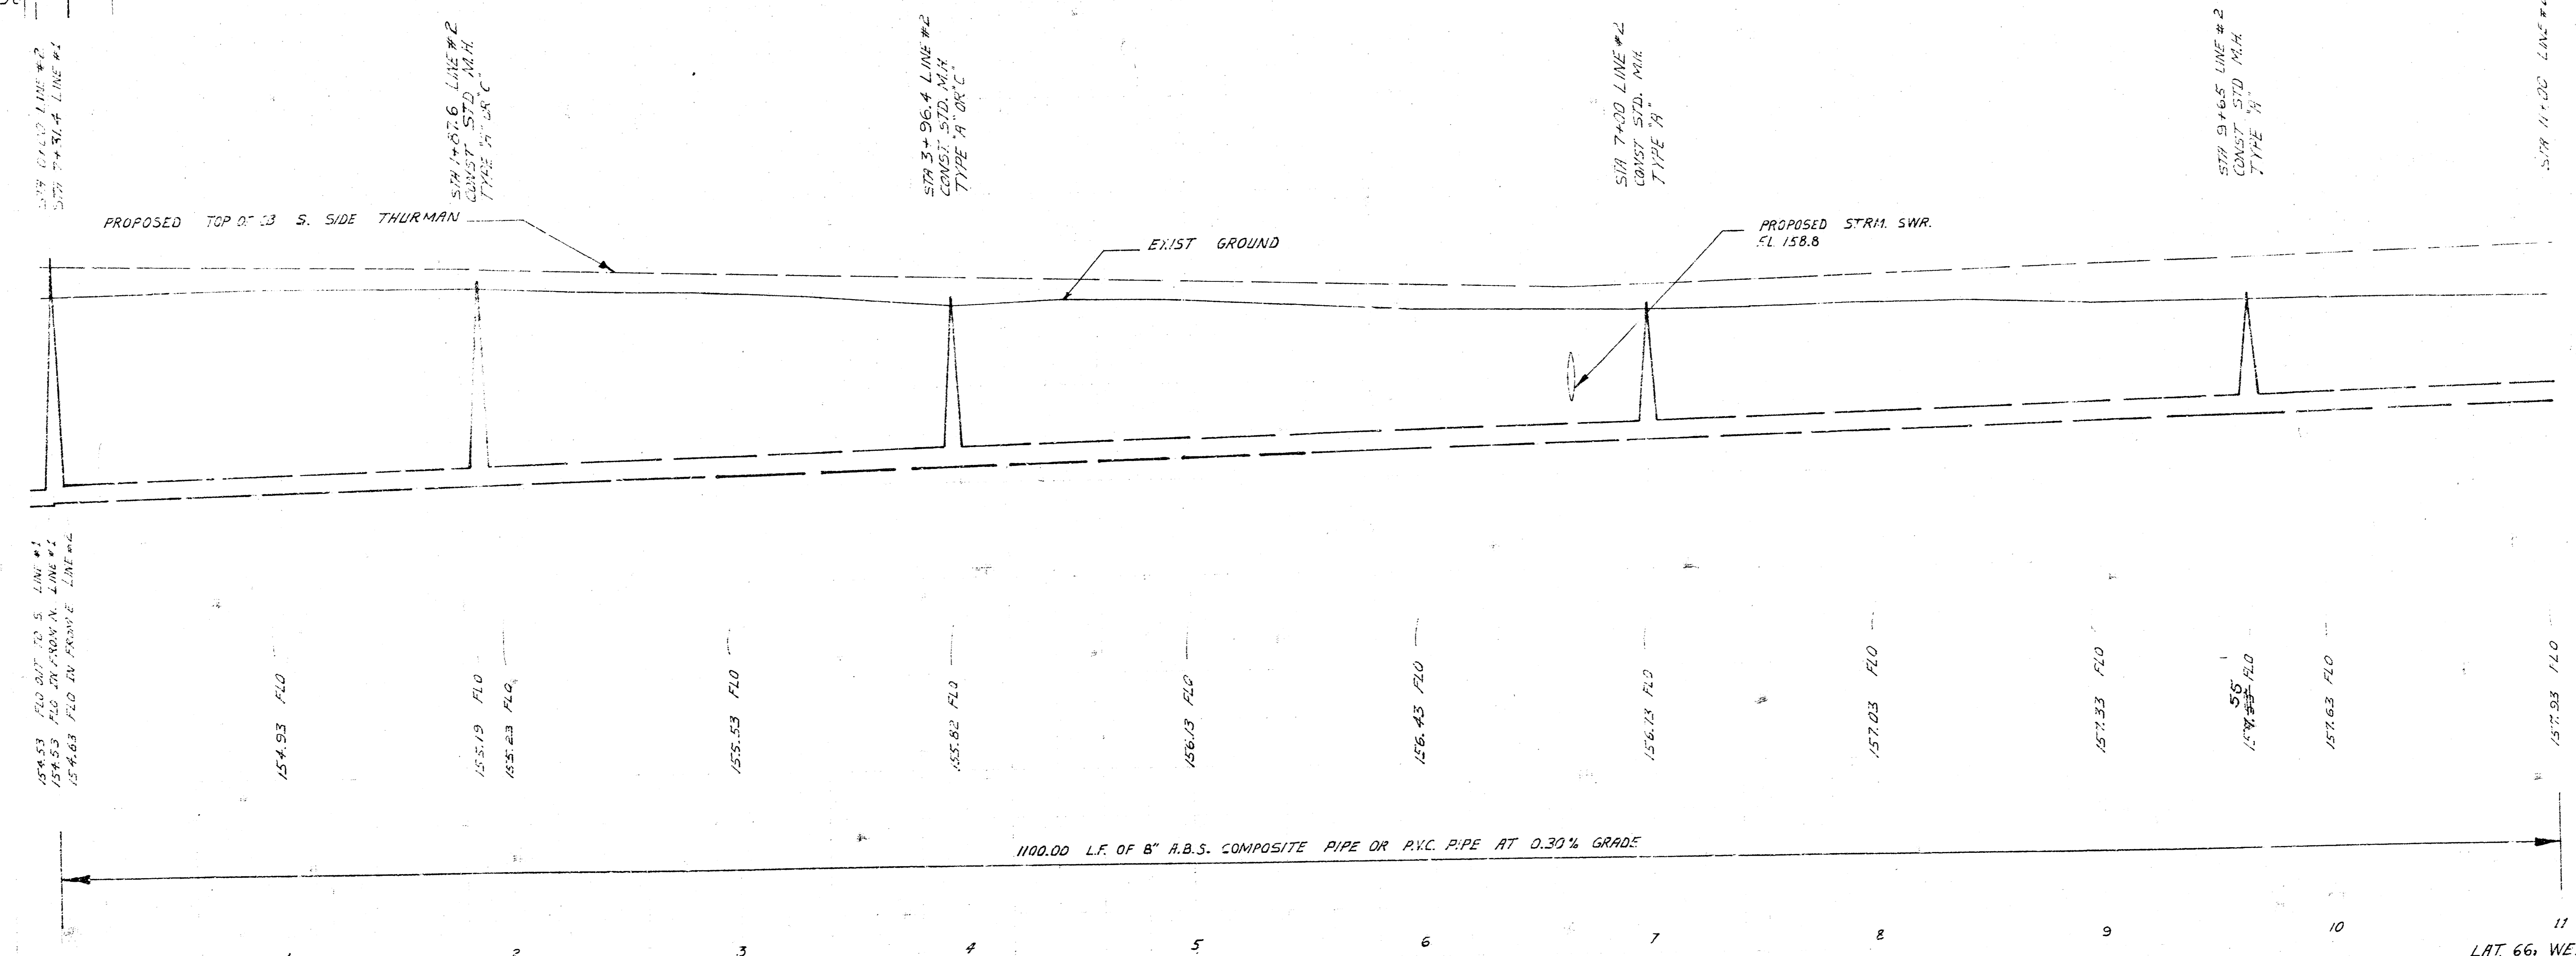

1100.00 LF. OF 8" A.B.S. COMPOSITE PIPE OR R.Y.C. PIPE AT 0.30% GRADE

As Built
 5/8/1
 JJS

LAT. 66, WESTLINK SEWER
 PROJ. NO. 468.76.245.80991.000.000.007

FILMED FROM THE BEST AVAILABLE COPY

