


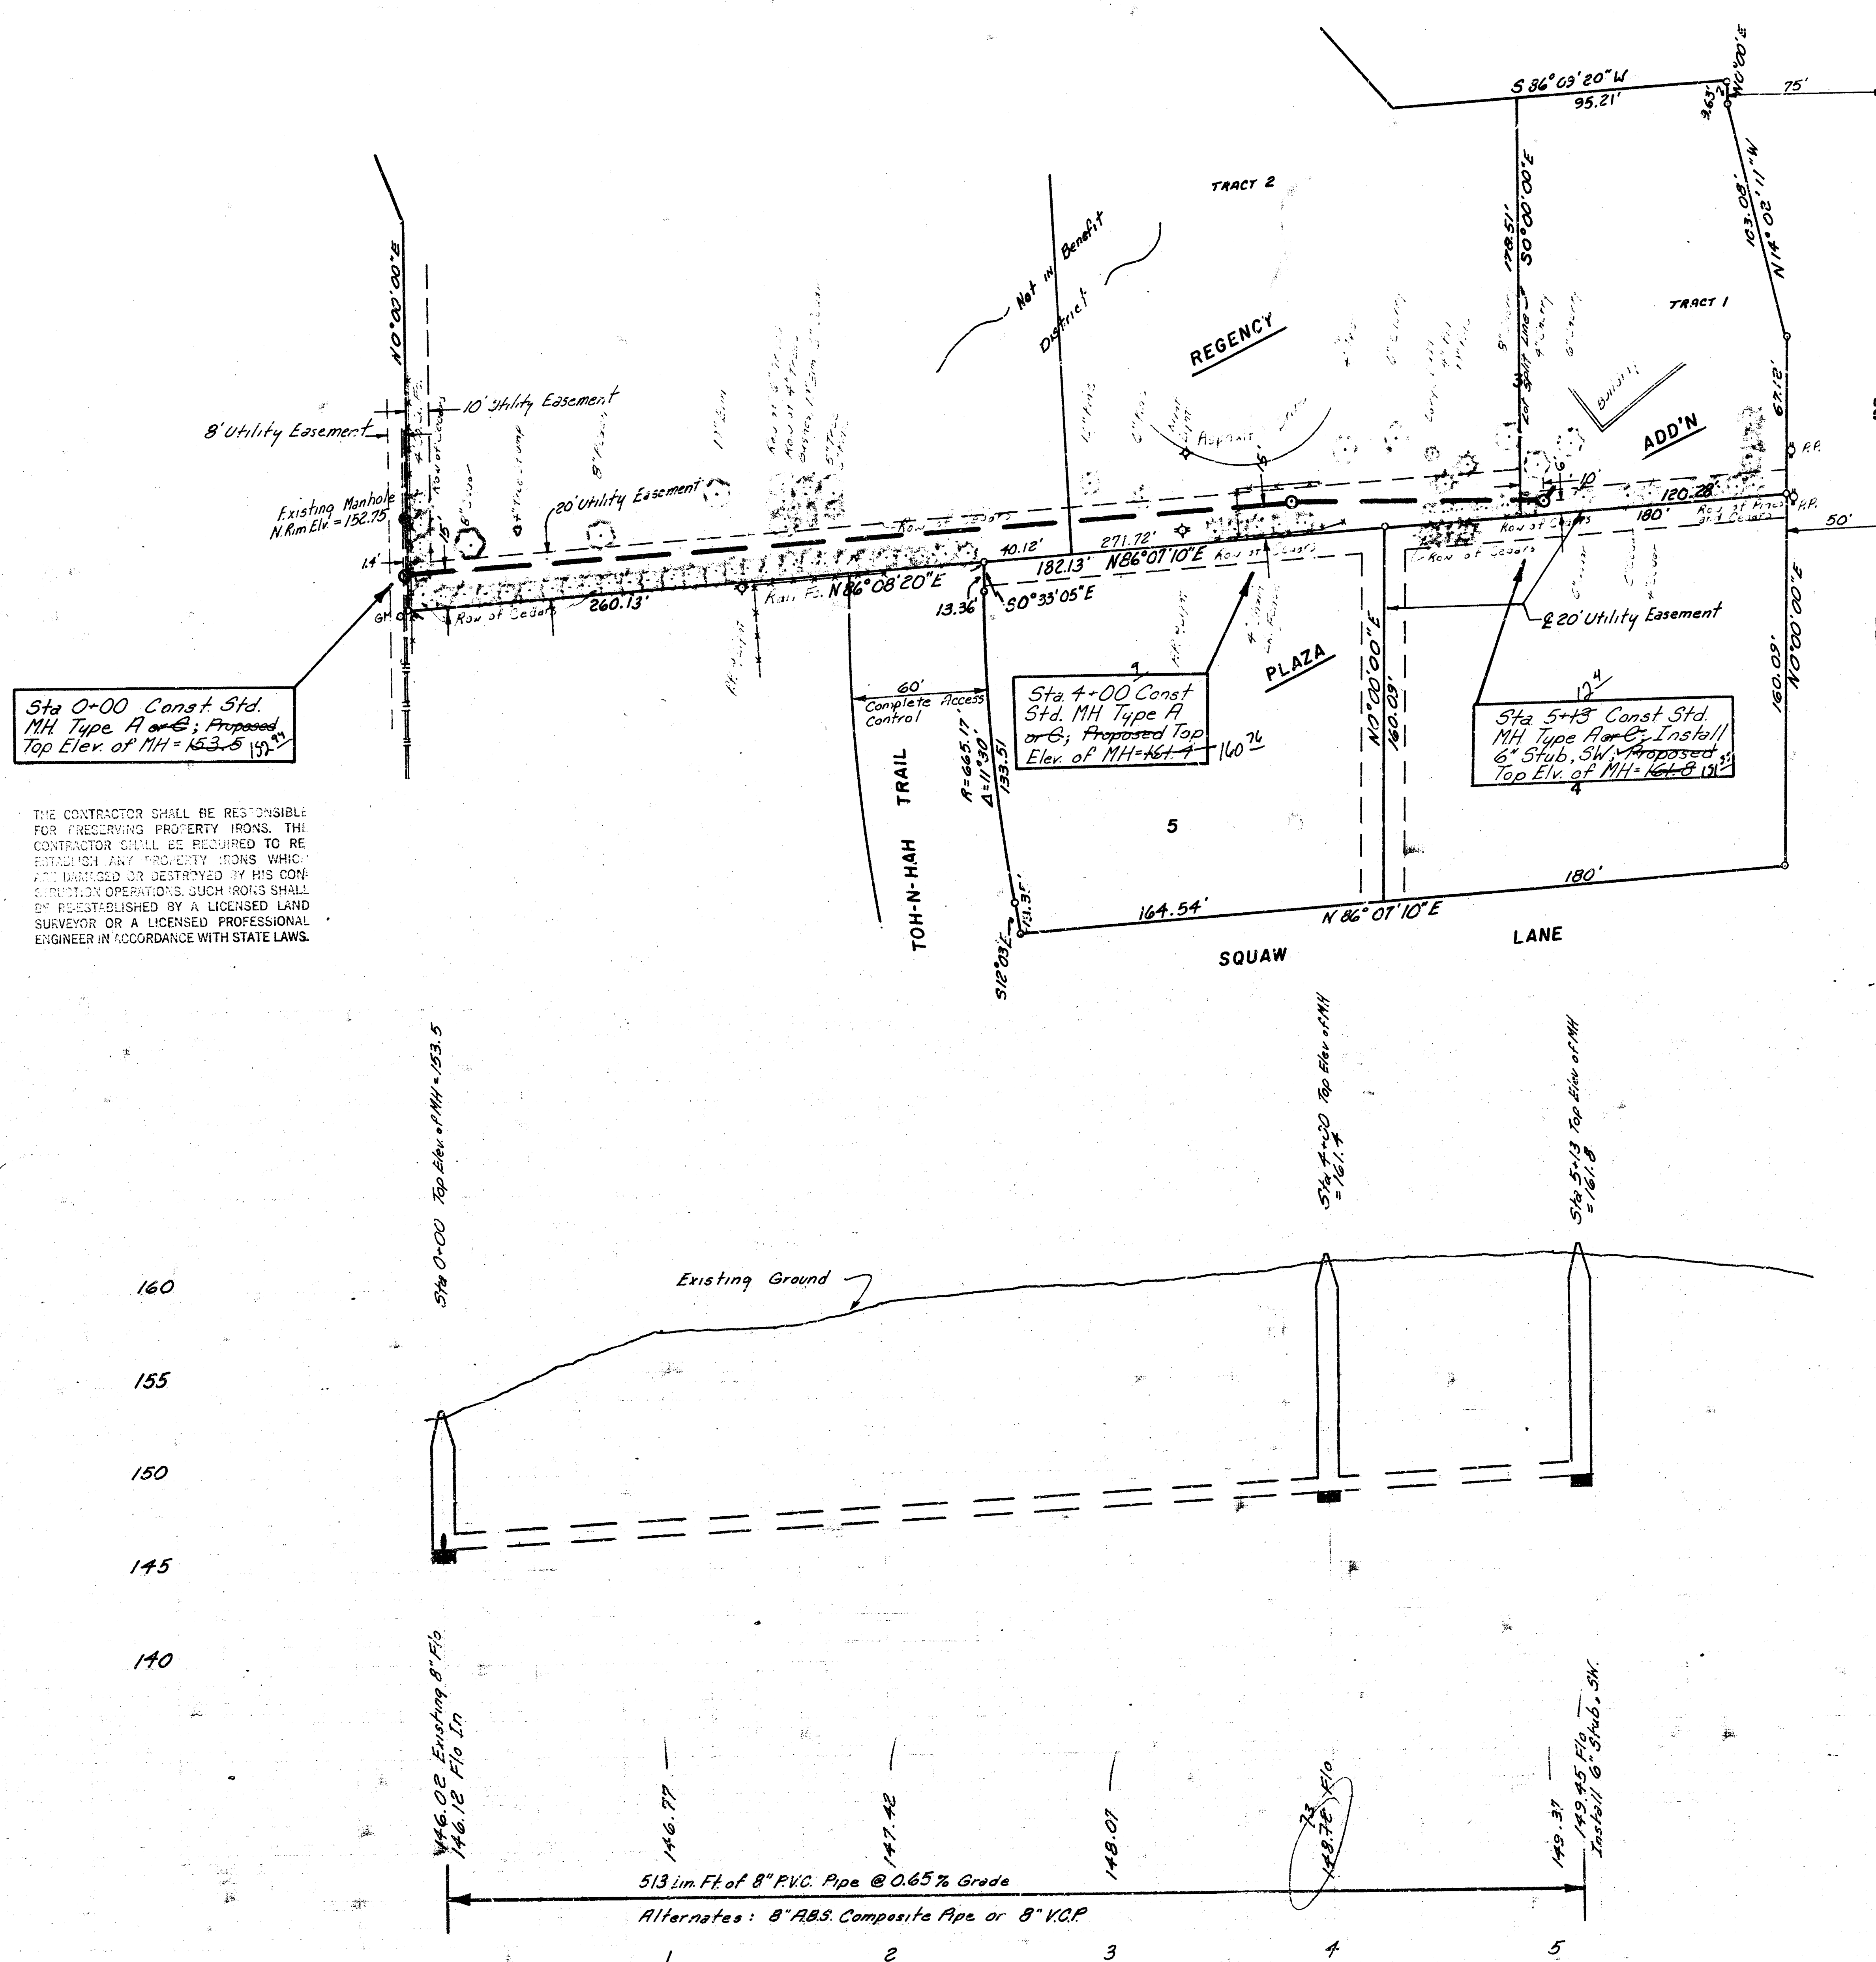


NOTE: CONTRACTOR SHALL REMOVE ONLY THOSE TREES WHICH ARE ABSOLUTELY NECESSARY TO FACILITATE CONSTRUCTION OF THE SEWER AND AS APPROVED BY THE FIELD ENGINEER. CONTACT THURMAN SMITH, 722-6791, BEFORE REMOVAL OF TREES.

CONTRACTOR SHALL REMOVE FENCE BELTED SILL, 3+75 AND 4+10. PROPERTY OWNER SHALL BE GIVEN THE OPPORTUNITY TO RETAIN UNDESIRABLE SALVAGED FENCE; OTHERWISE CONTRACTOR SHALL DISPOSE OF FENCE IN A SUITABLE MANNER.

Scale: 1" = 40' Plan
Horz. 1" = 40' Profile
Vert. 1" = 5'

BENCH MARK: 142.26 CITY STD. DISC., 41.3 FT. SOUTH AND 52.5 FT. EAST OF CENTERLINE BOTT.
T.B.M. - 161.20 TOP OF BUILDING FOUNDATION

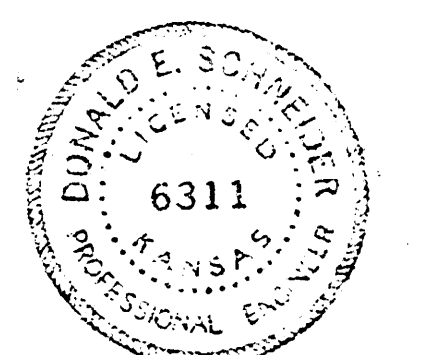

DESCRIPTION			
LATERAL 68, WESTLINK SEWER			
PROJECT NUMBER 468-76-245-81012-000-000-001			
BOOK NO. DCD-201	APPROVED BY	DATE 3/82	REVISED
DRAWN BY LINDSEY	CITY OF WICHITA DEPARTMENT OF ENGINEERING		
DIRECTOR OF ENG./CITY ENGINEER R. W. BRUGGEMAN			SCALE