


LATERAL 72 WESTLINK SEWER

Project no. 468-76-245-81277-000-000-001

CITY OF WICHITA, KANSAS
MIKE LINDEBAK CITY ENGINEER

As Built
J.L.L.
984

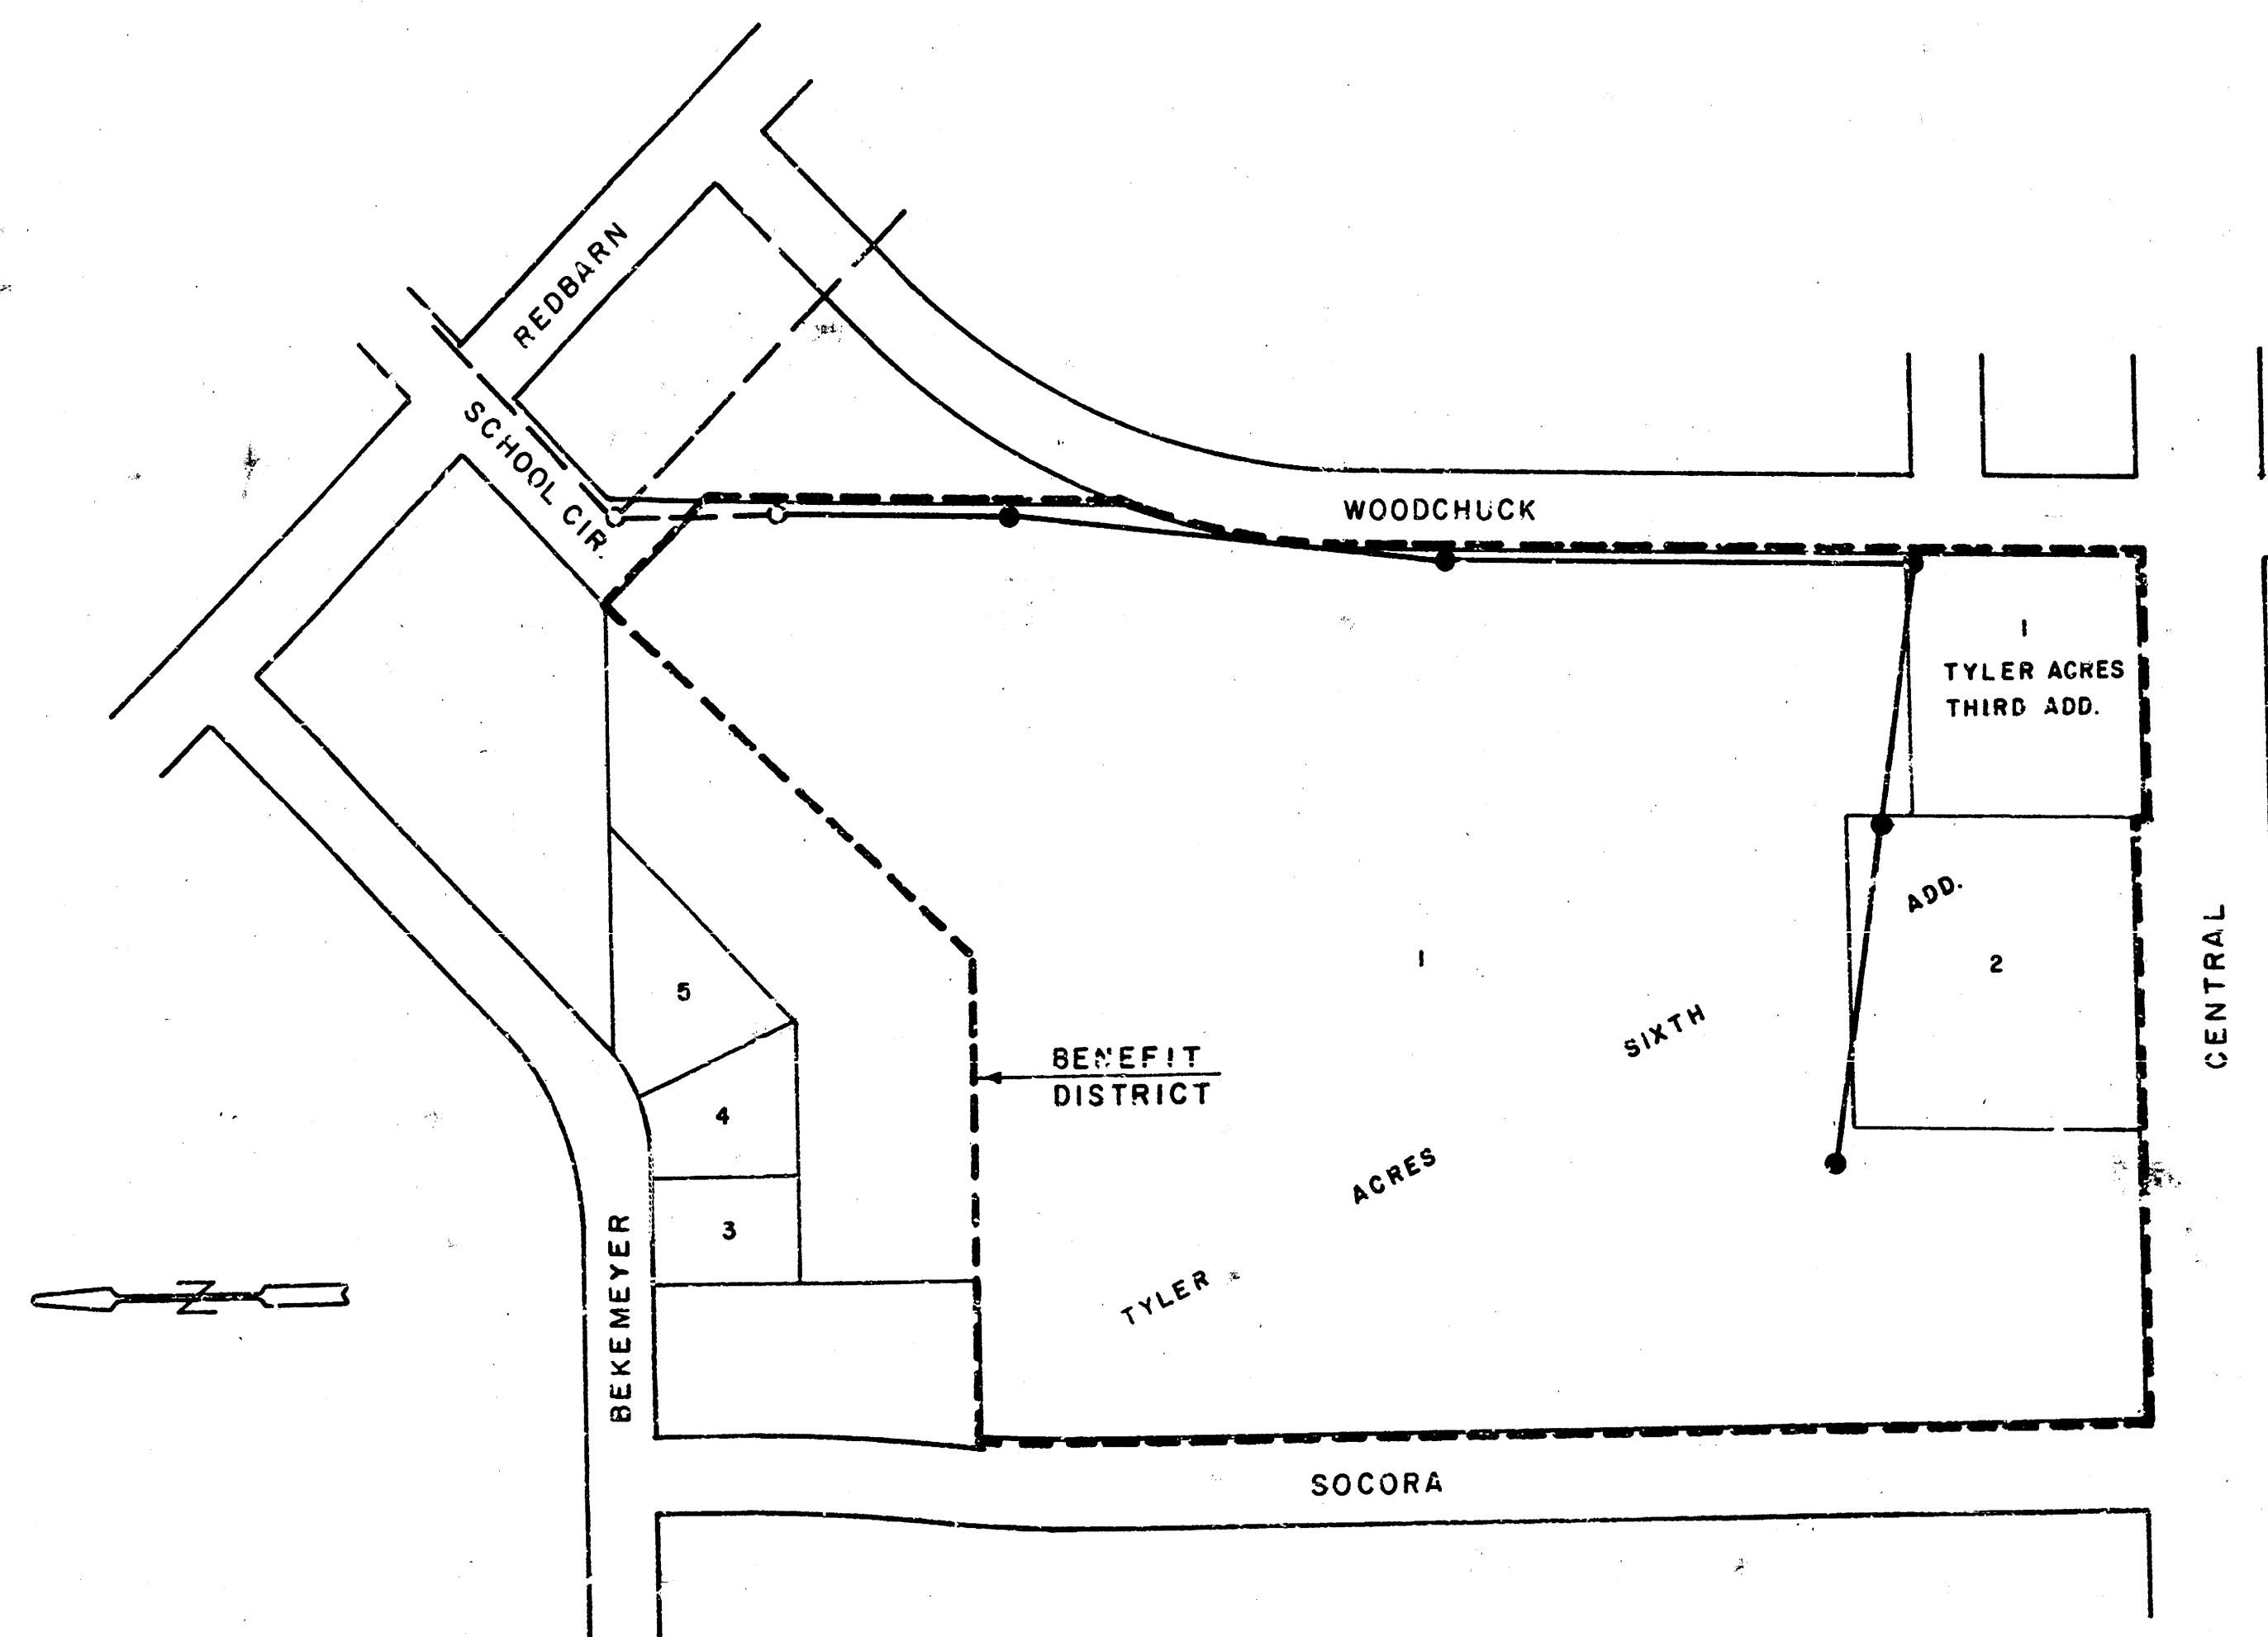

LOCATION MAP



April 24.




BAUGHMAN COMPANY, P.A.
SURVEYING & ENGINEERING
316/262-7271 • 330 LAURA • WICHITA, KANSAS 67211

SH. 1 OF 3



1/3

Scale: Hor. 1" = 40'
Ver. 1" = 5'


As Built
J.L.L.
9-84

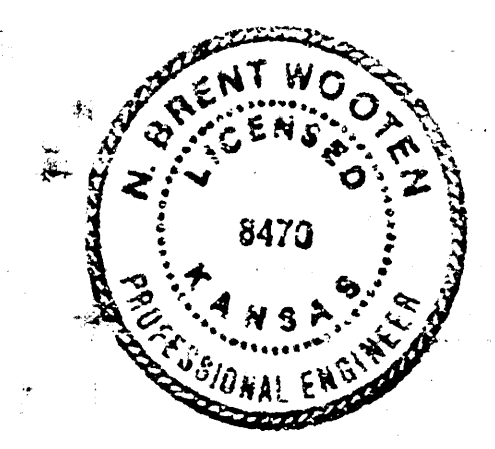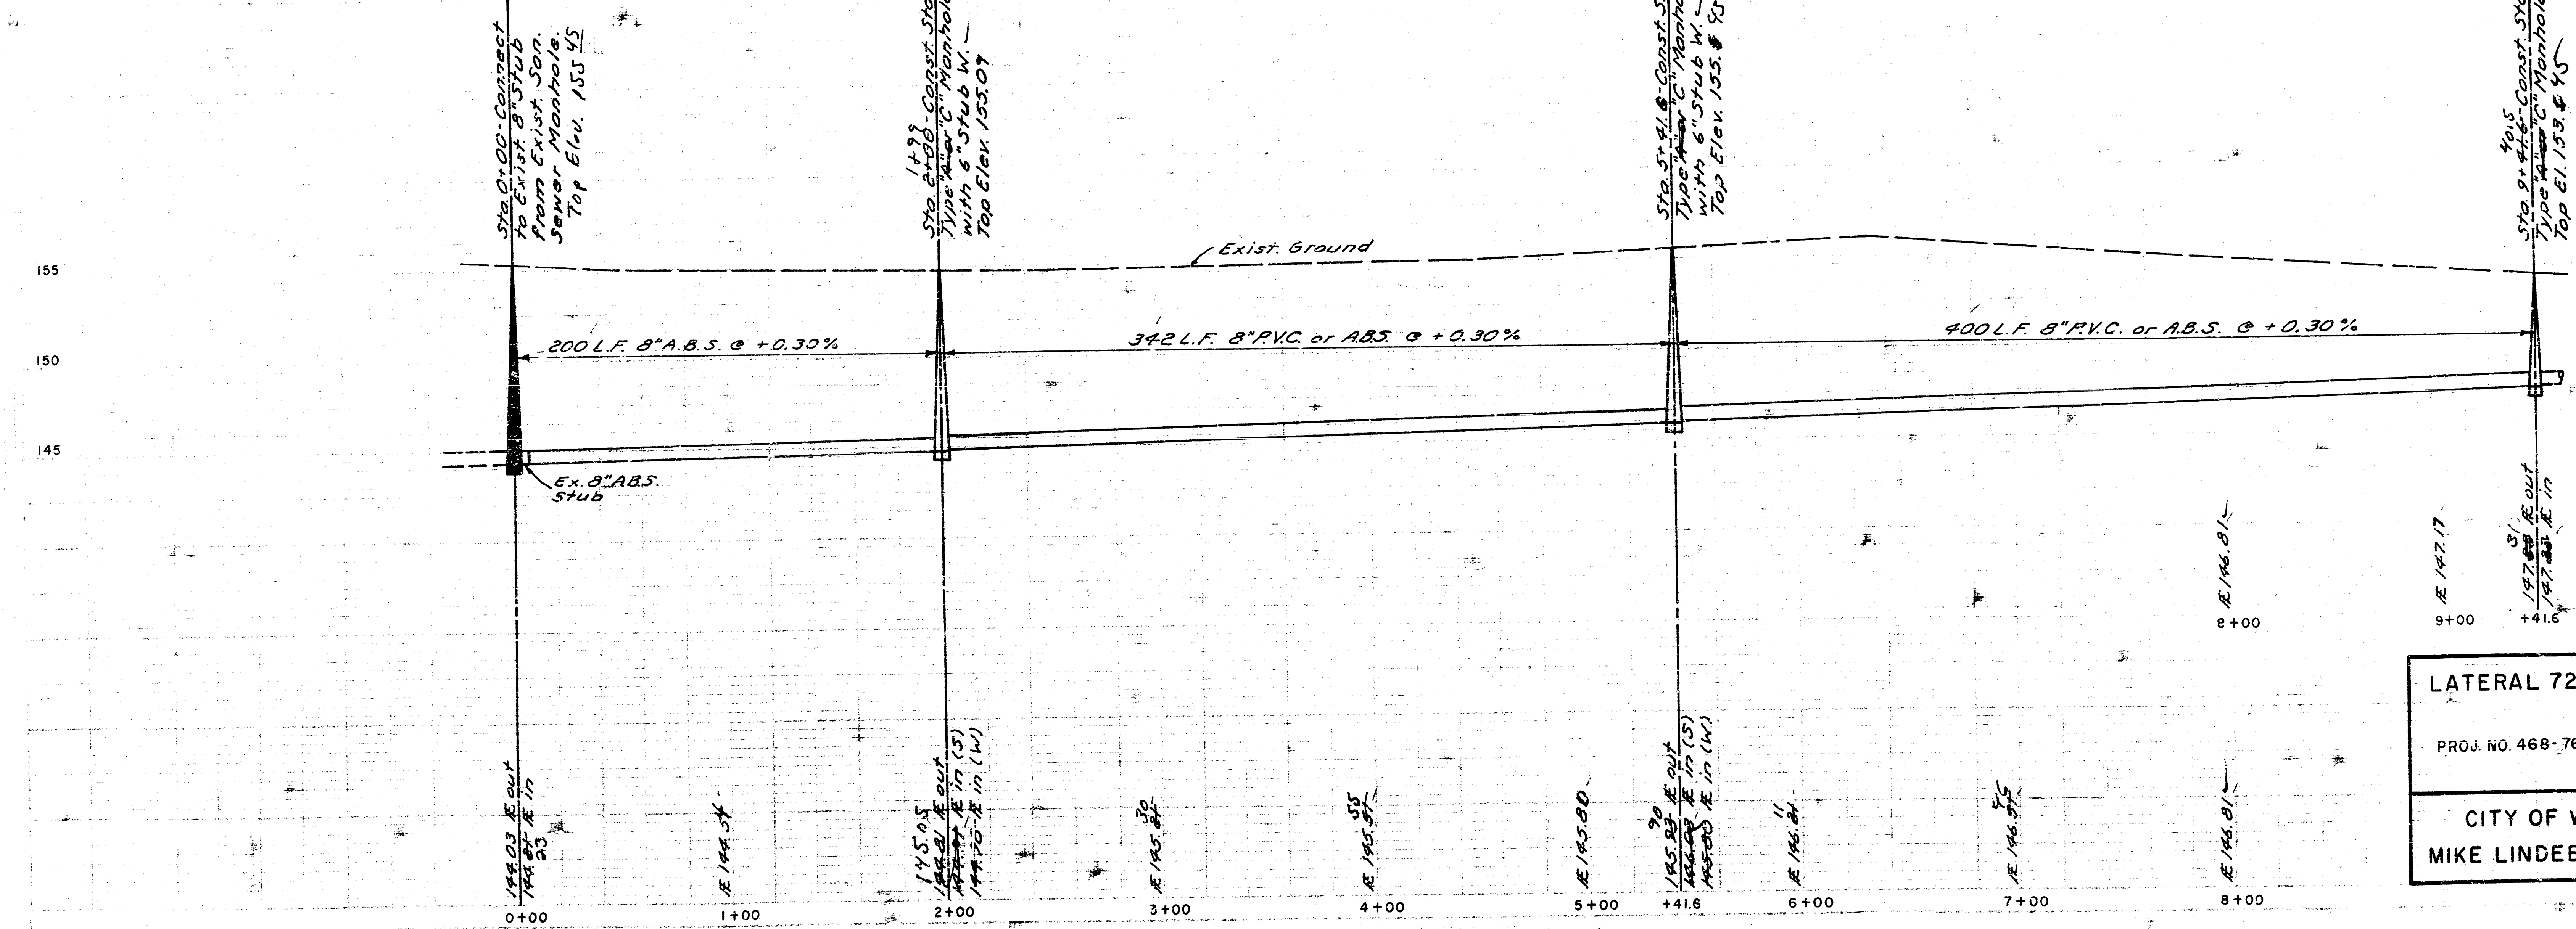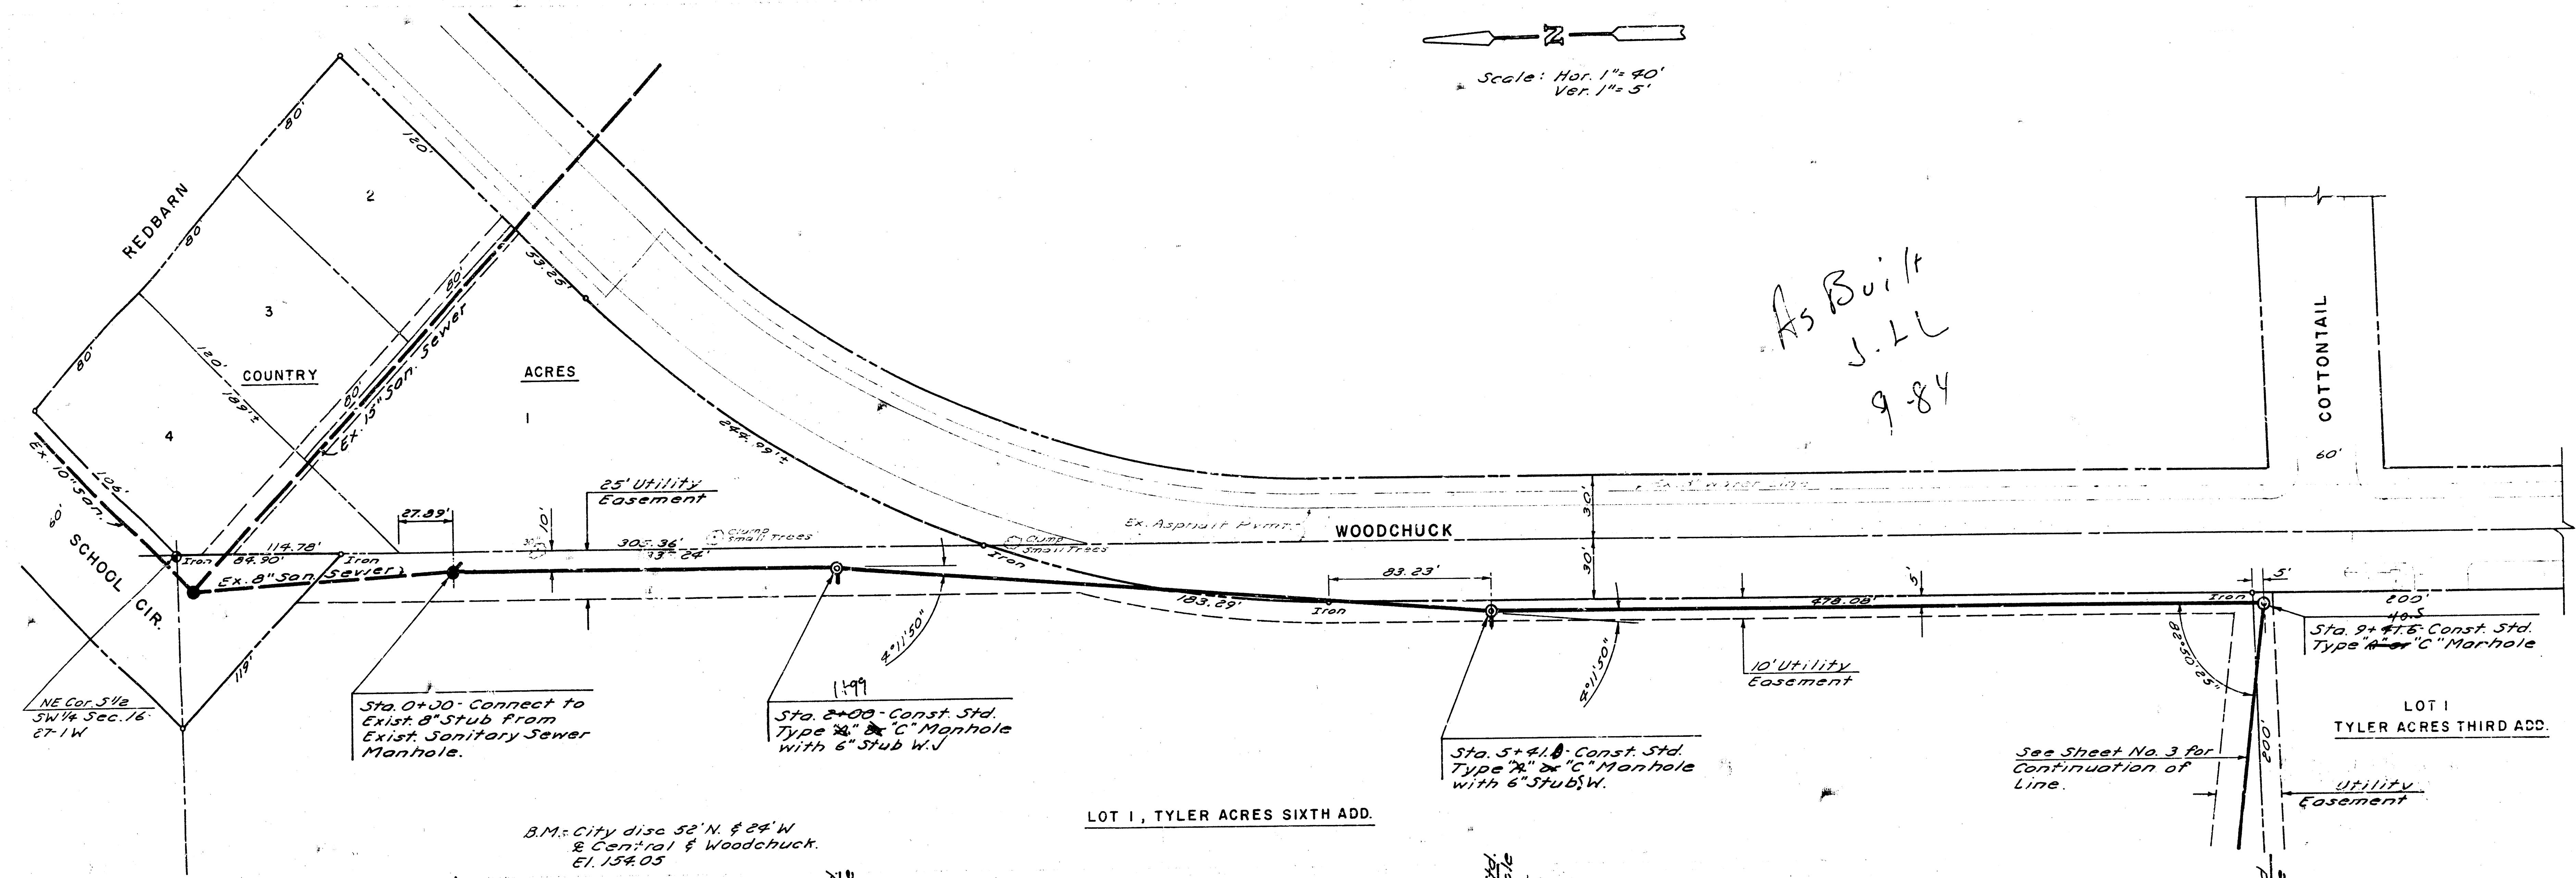

LATERAL 72- WESTLINK SEWER
 PROJ. NO. 468-76-245-81277-000-000-001
CITY OF WICHITA, KANSAS
MIKE LINDEBAK CITY ENGINEER

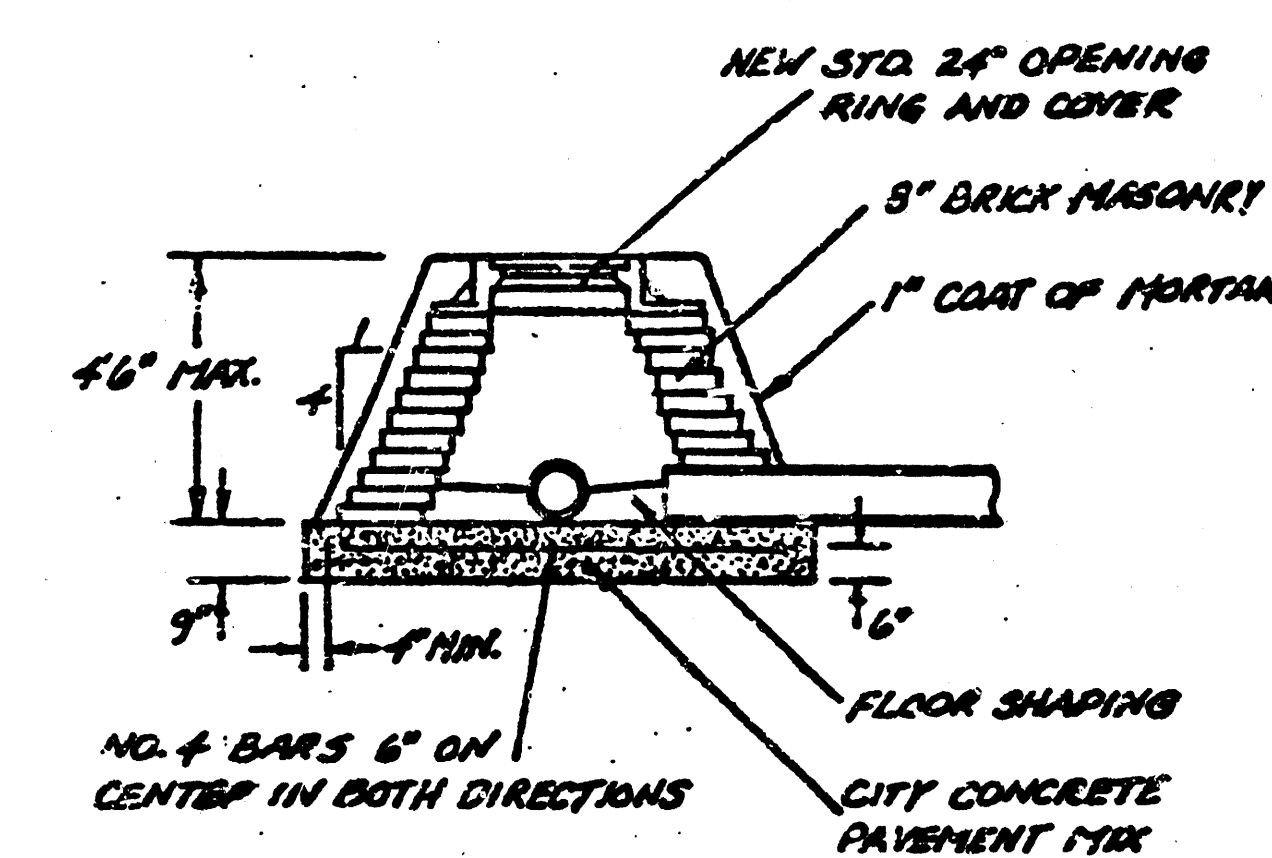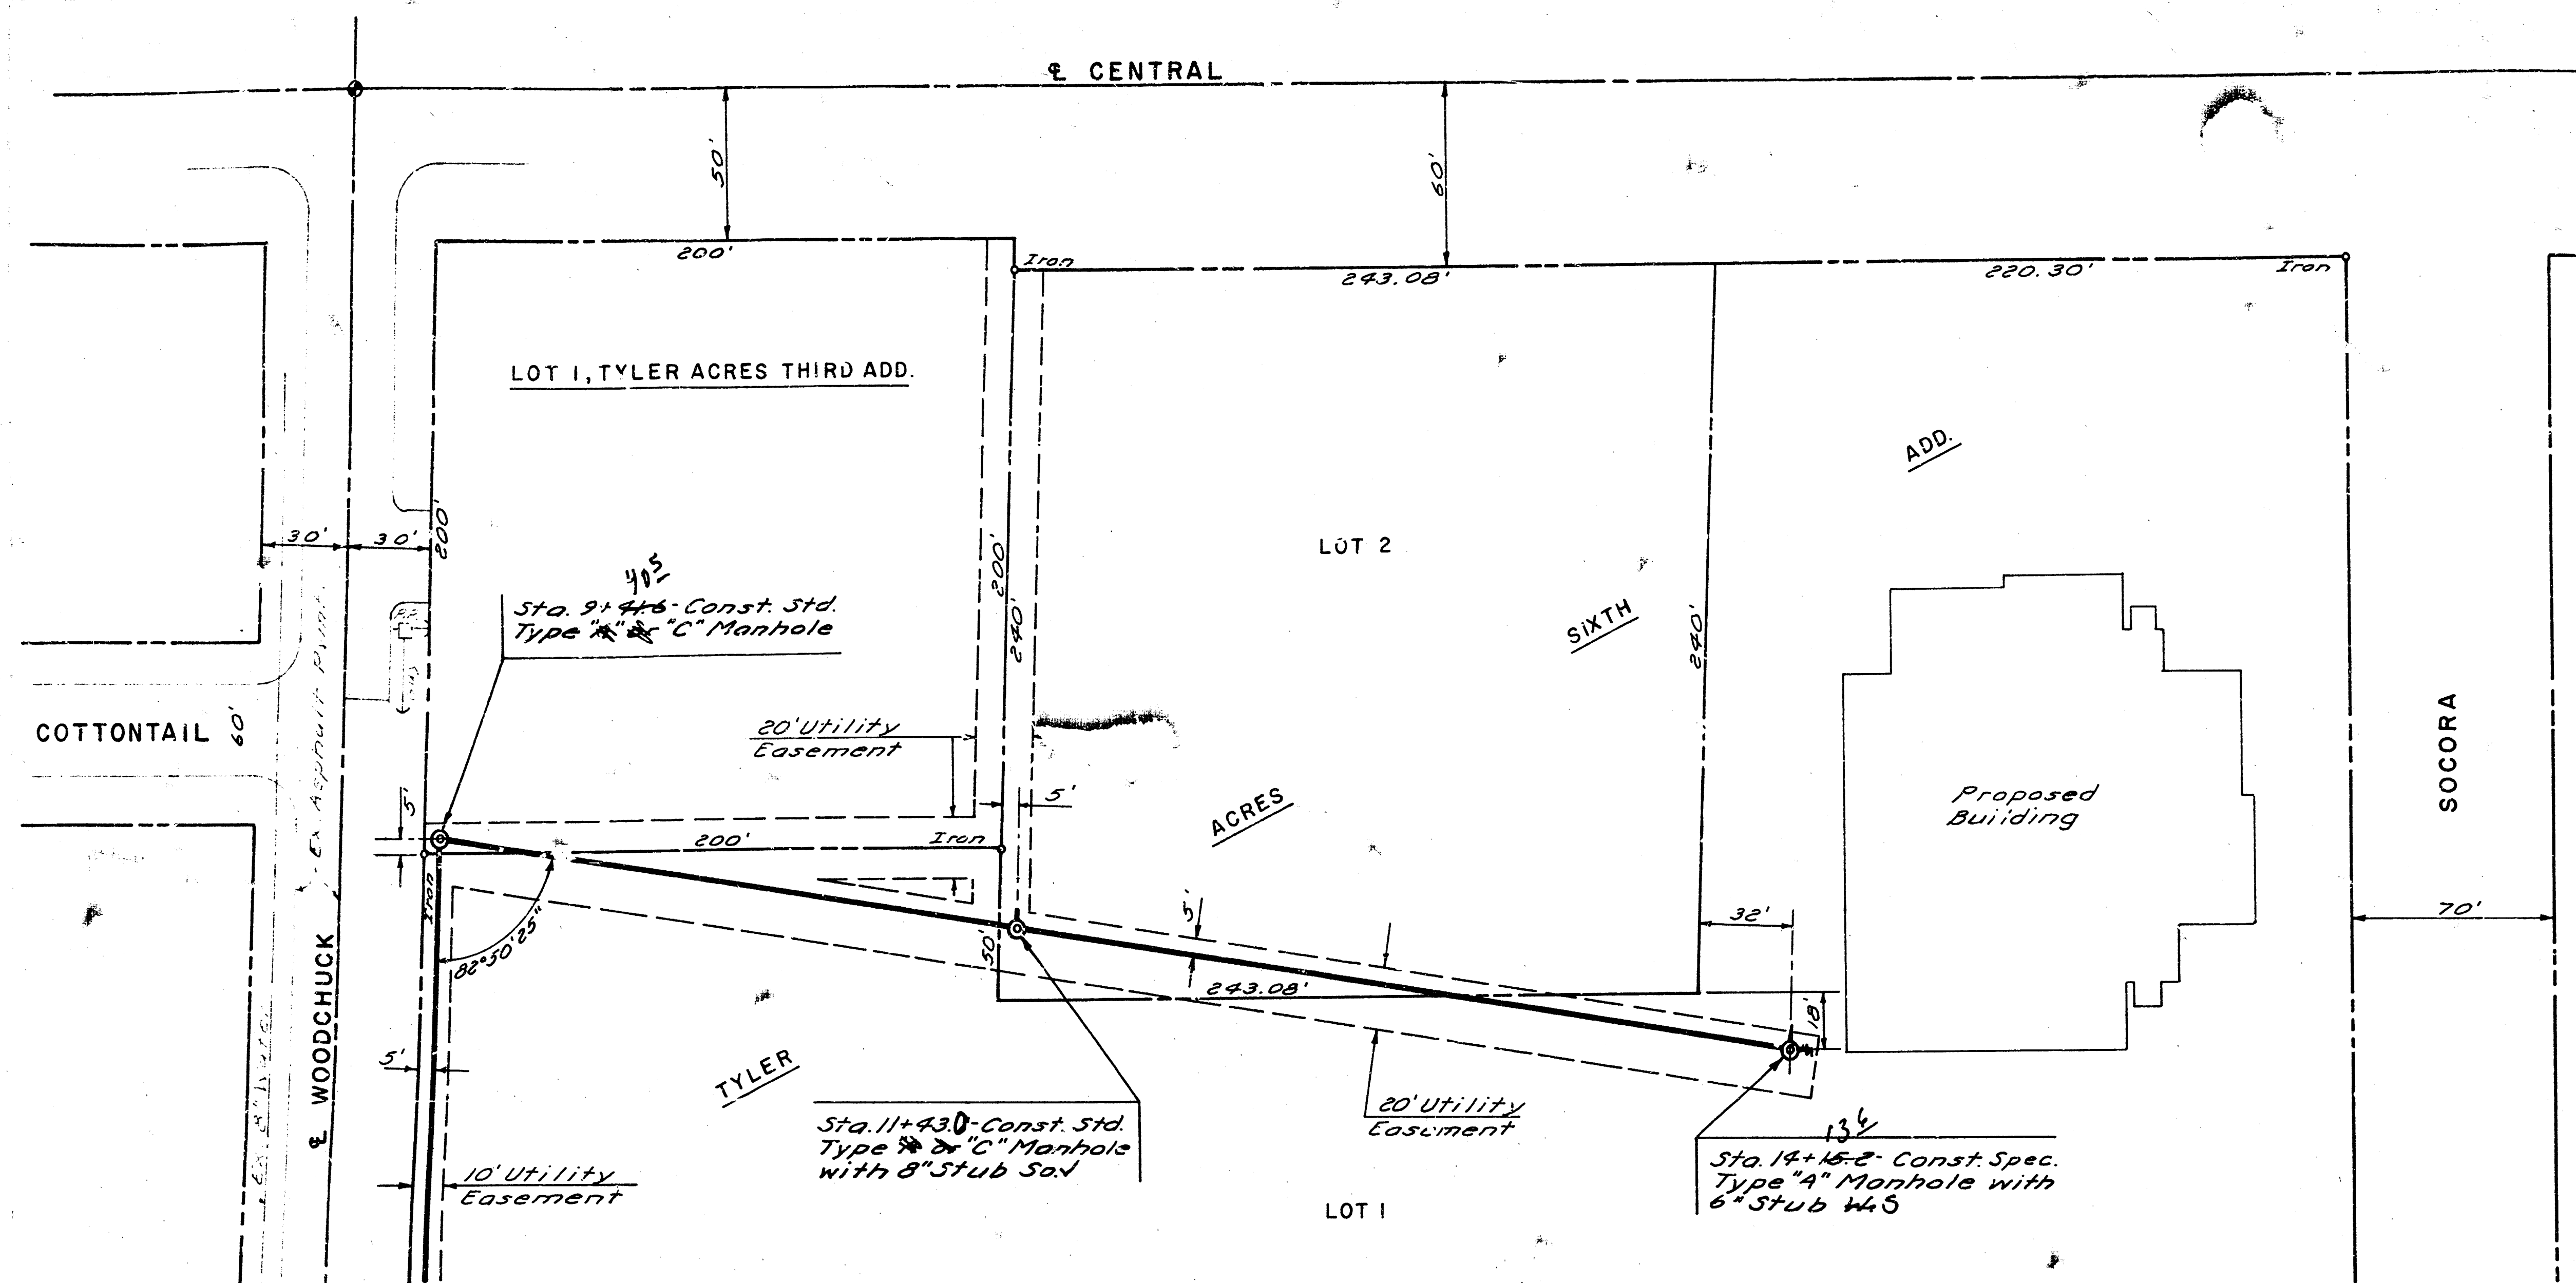

SPECIAL MANHOLE "TYPE A"

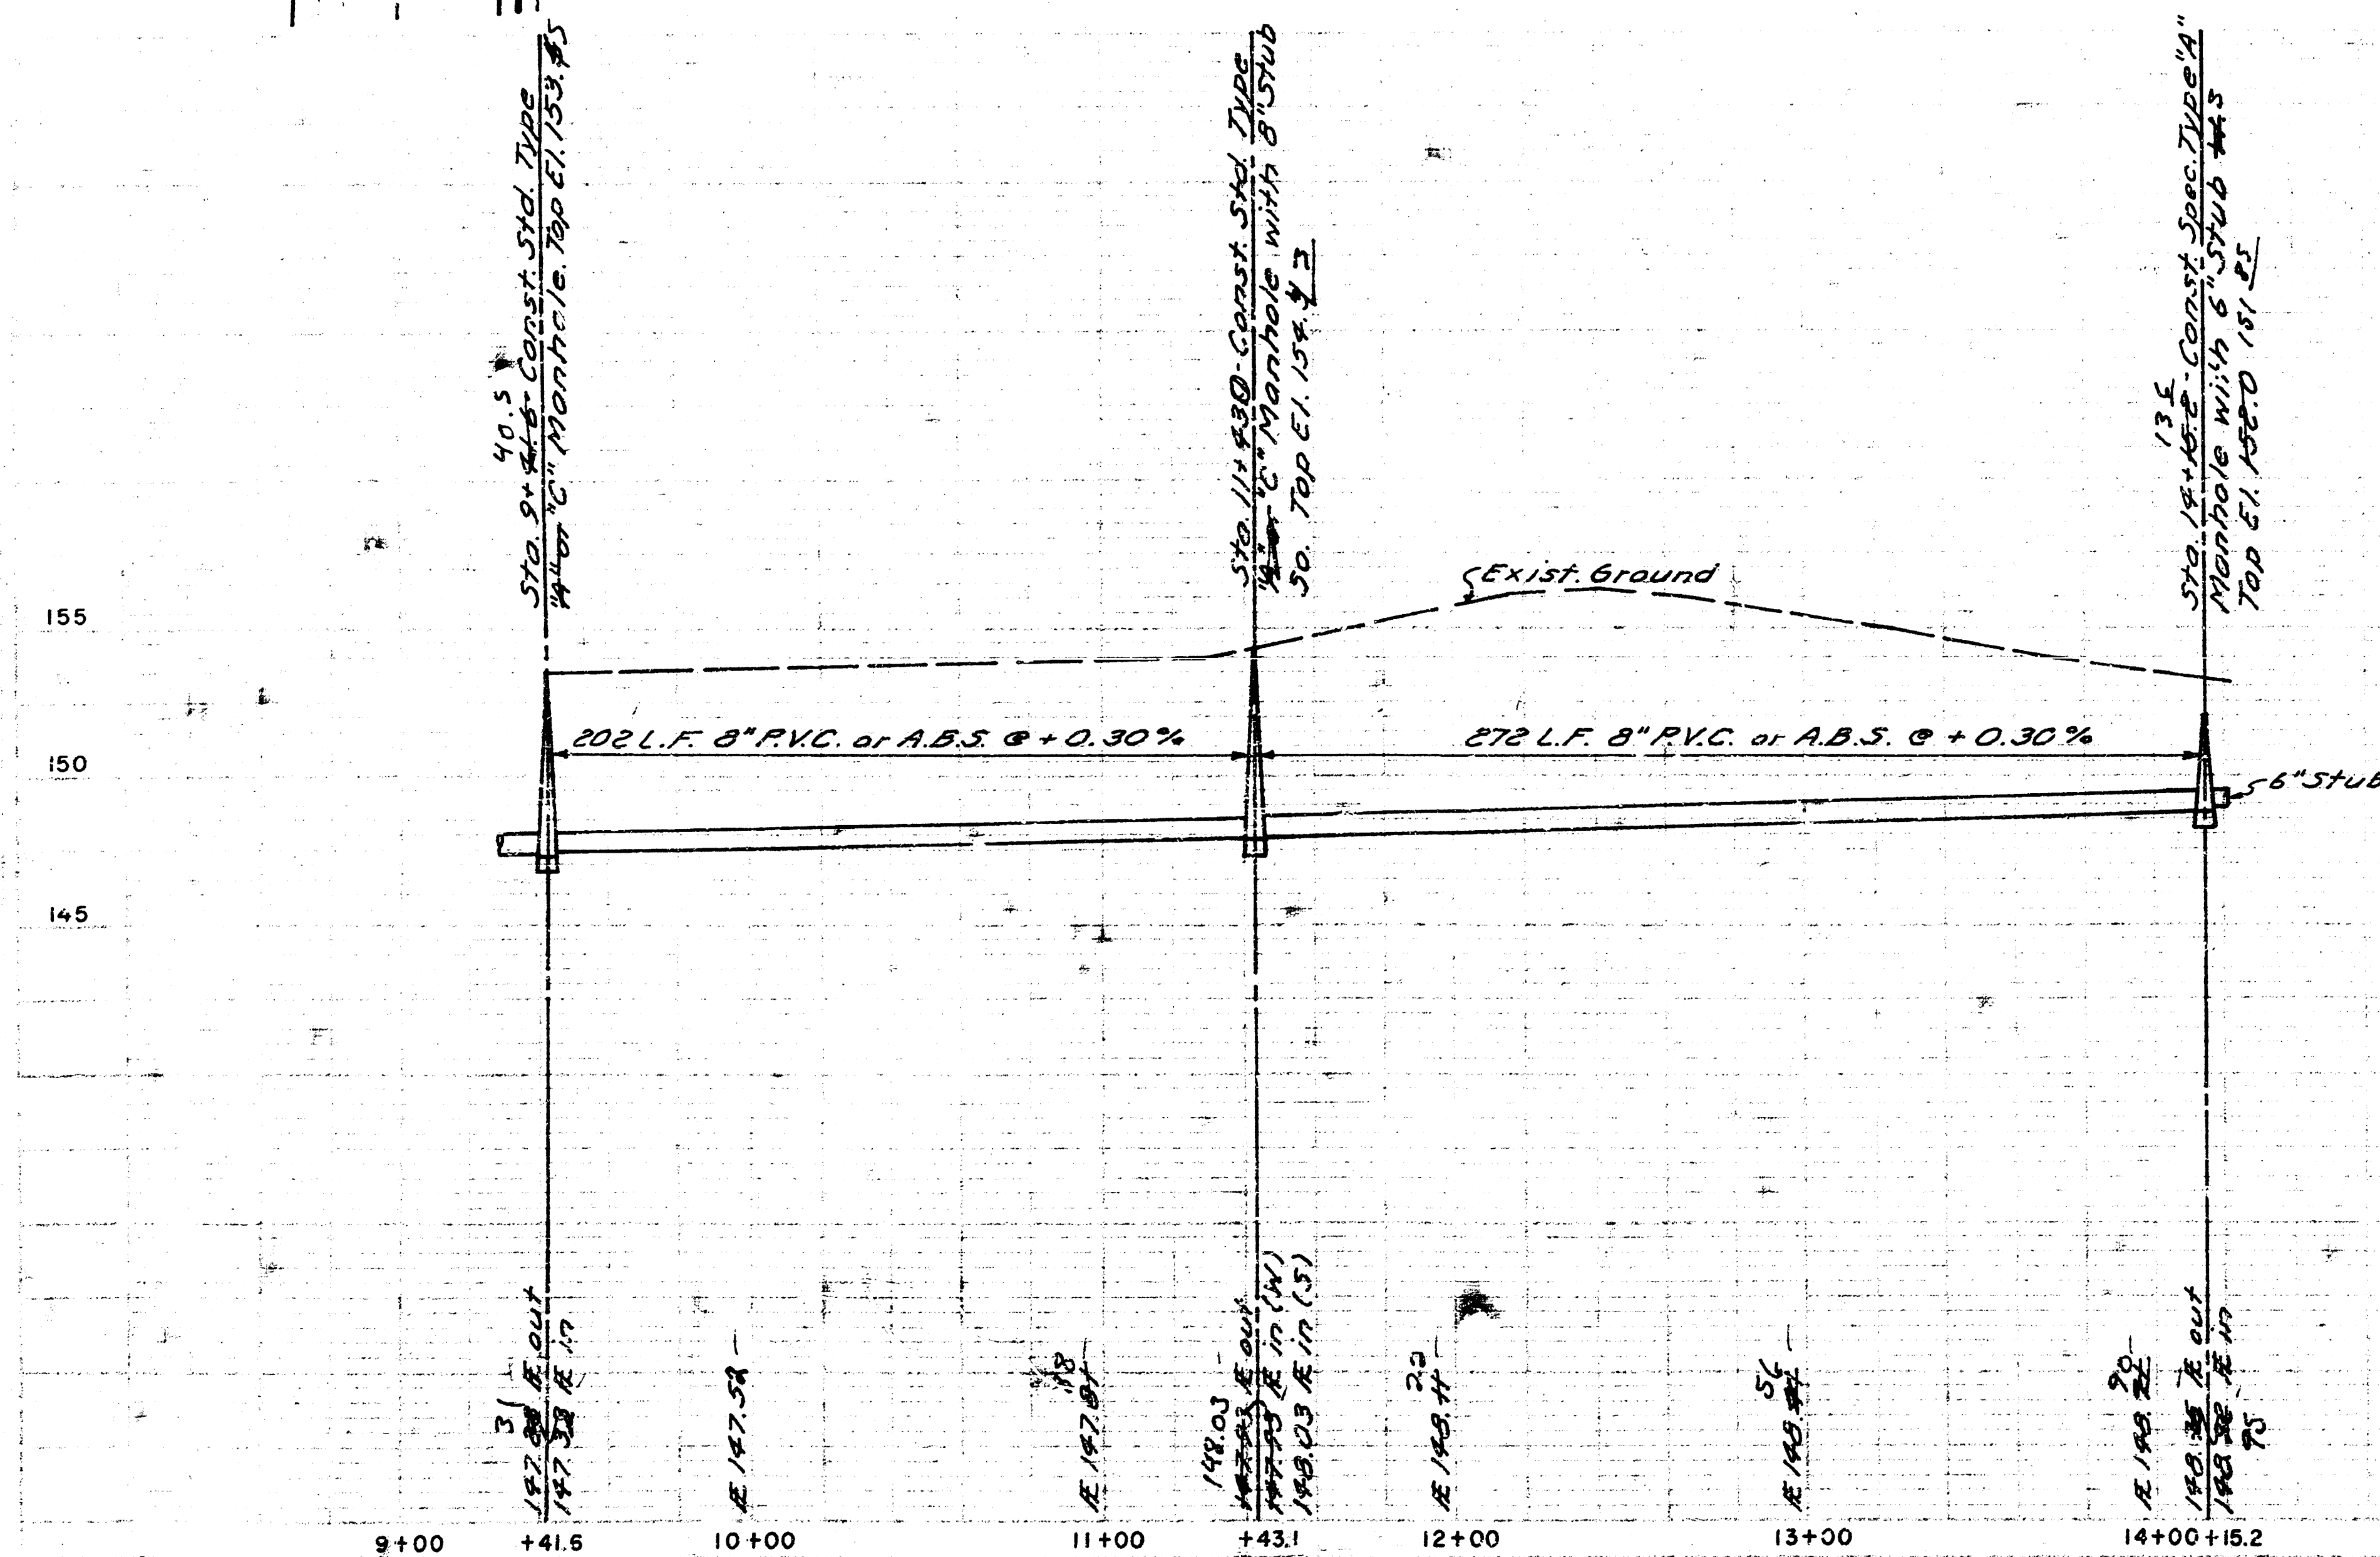

LATERAL 72 - WESTLINK SEWER
 PROJ. NO. 468-76-245-81277-000-000-001
 CITY OF WICHITA, KANSAS
 MIKE LINDBAK CITY ENGINEER

SH. 3 OF 3

14 8 3 0