
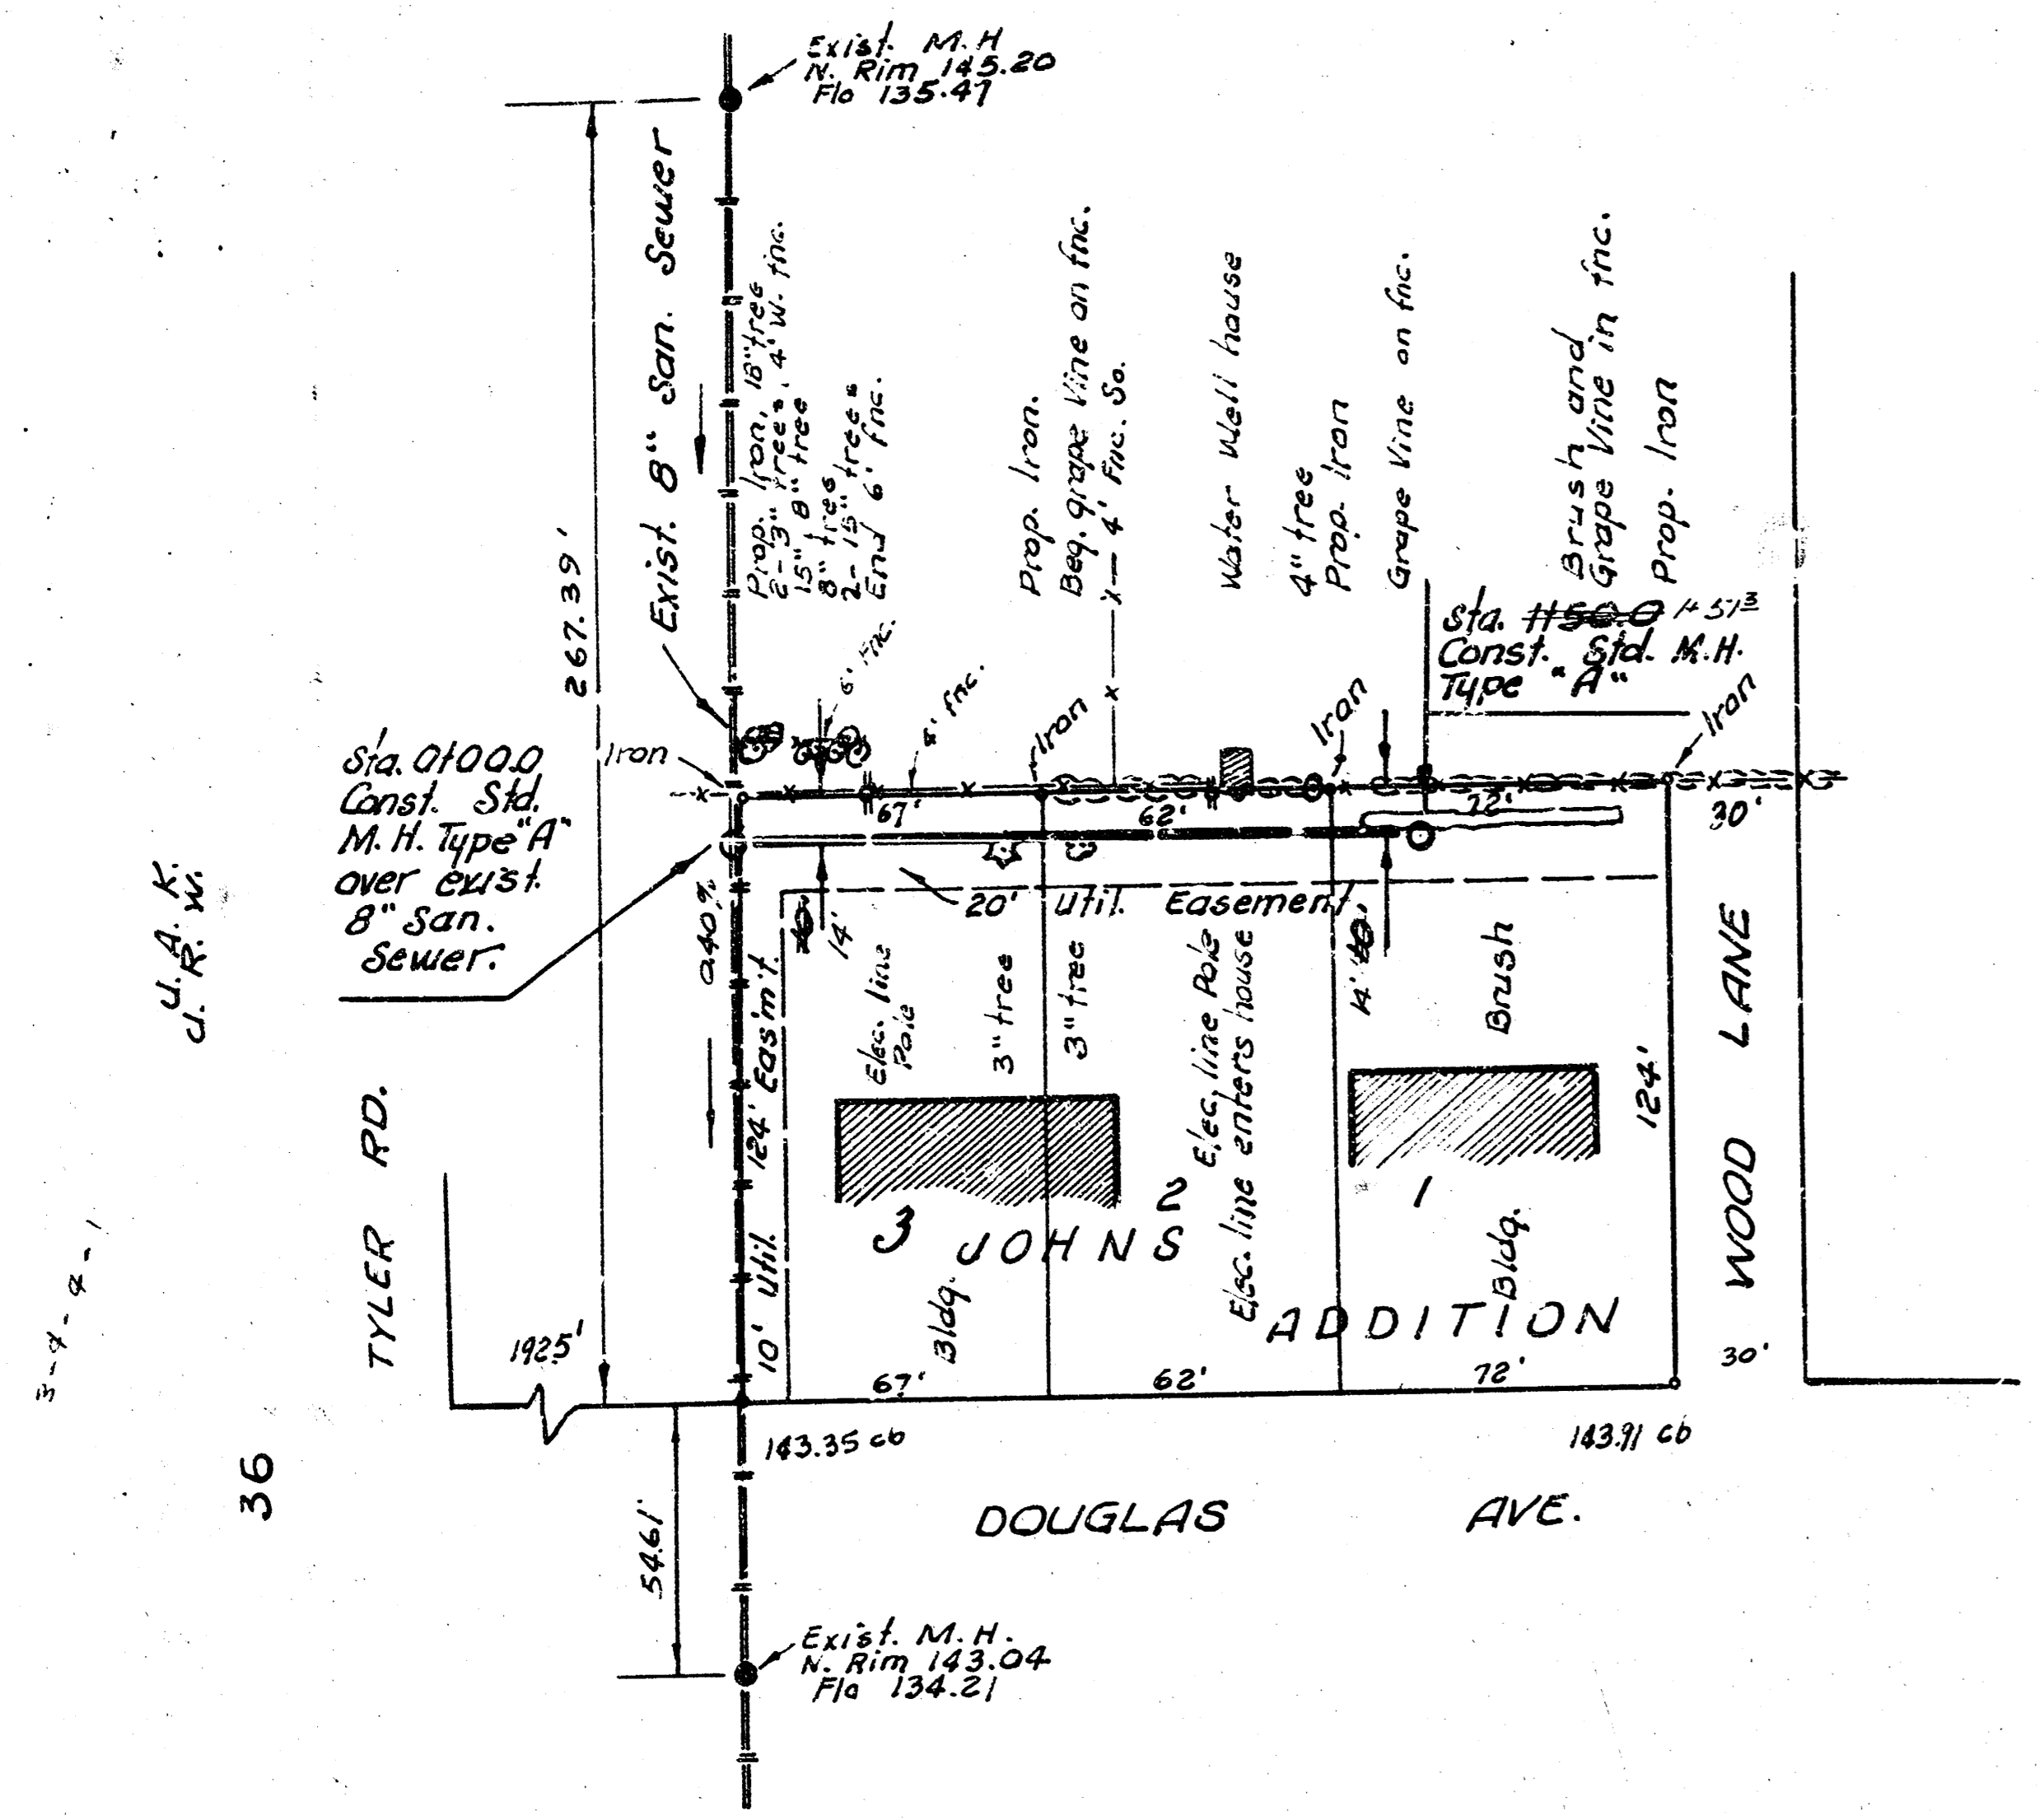


B. M. 144.04 R. R. Spike S.S.P.  
 Pole N. Side Douglas 2nd  
 Pole W. of Tyler Rd

Plan Scale 1" = 40'  
 Profile Scale 1" = 40' Horiz.  
 1" = 5' Vert.

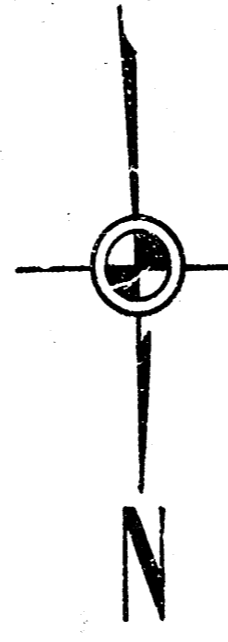

"AS BUILT" FINAL MEAS. 4-2

**LAT. 14, MAIN I, WESTLINK SEWER**  
 CITY OF WICHITA, KANSAS  
 R. W. LINN — CITY ENGINEER  
 MAY 1974 PROJECT NO. DBKL573080

11-Eng'rs  
 1-Water

FILMED FROM THE BEST AVAILABLE COPY