

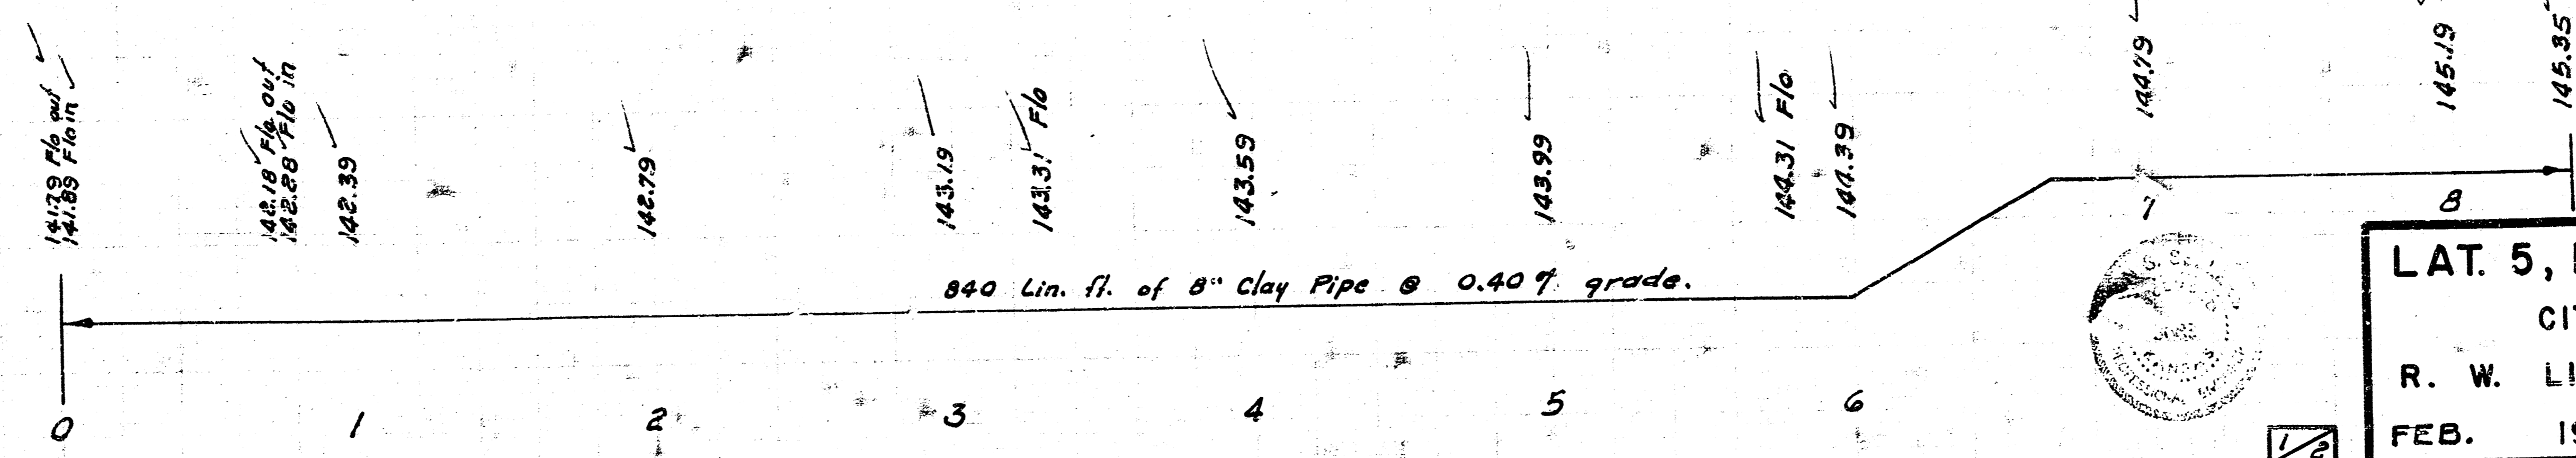
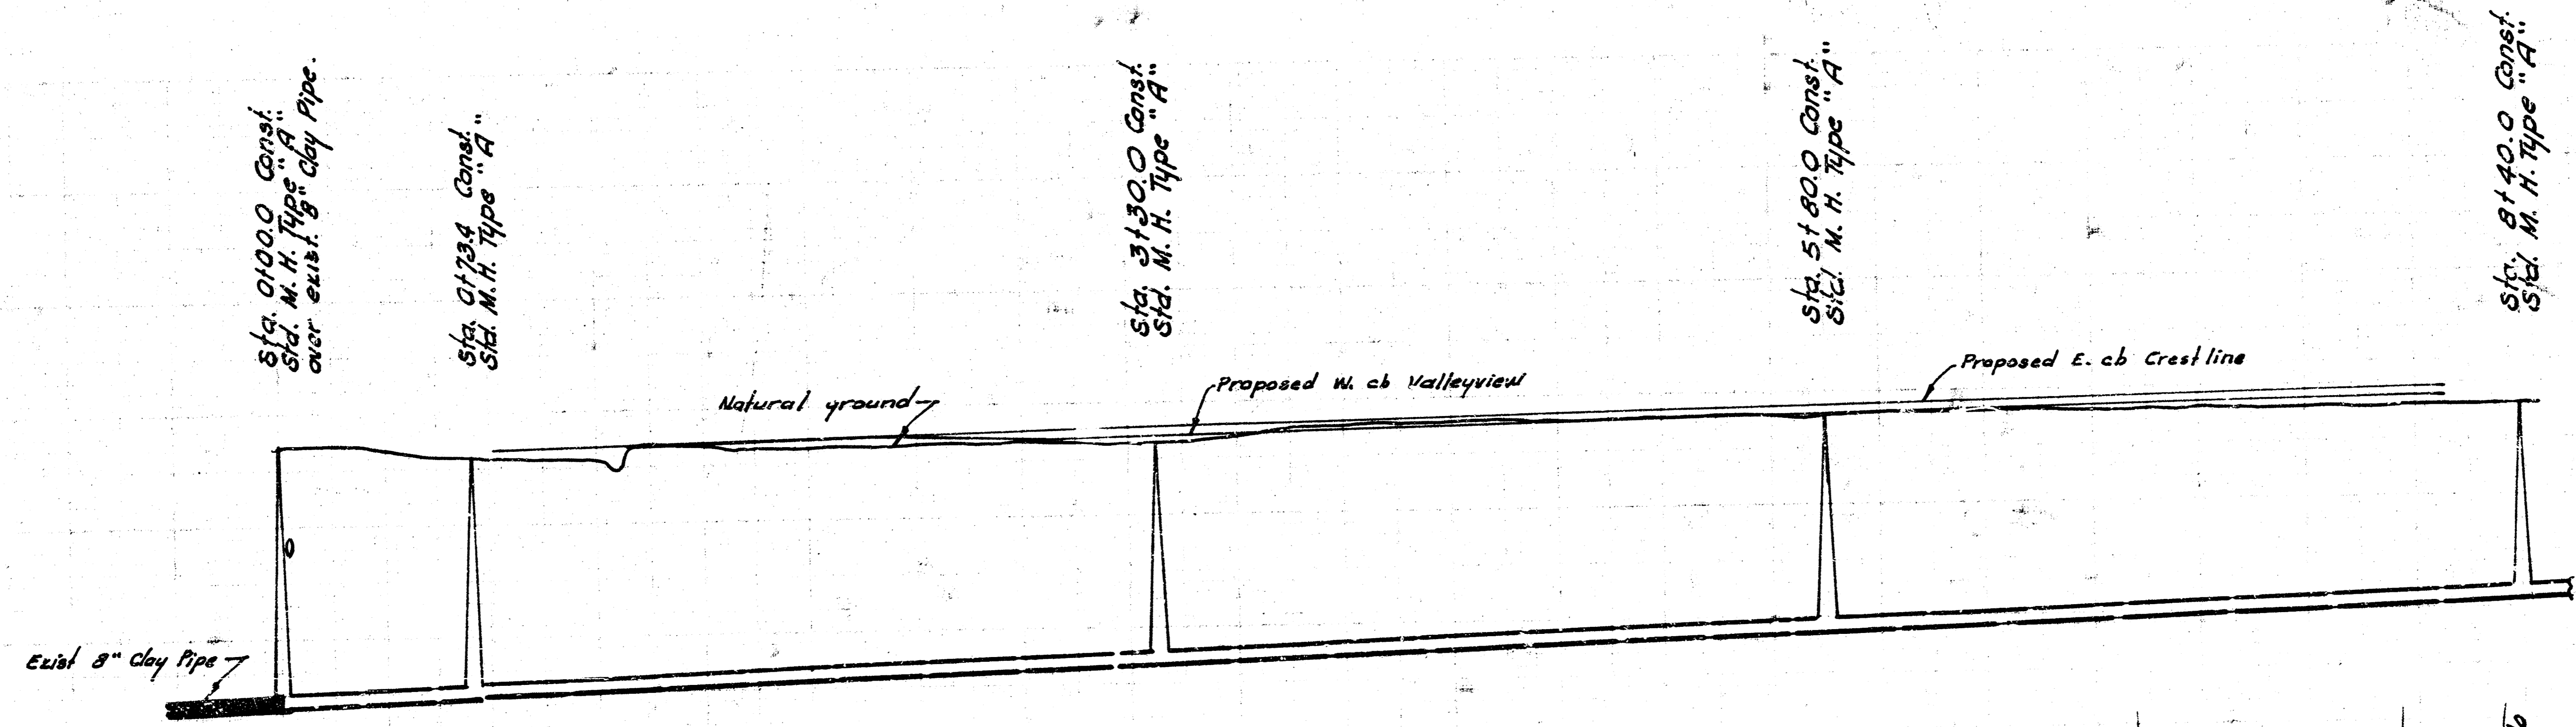
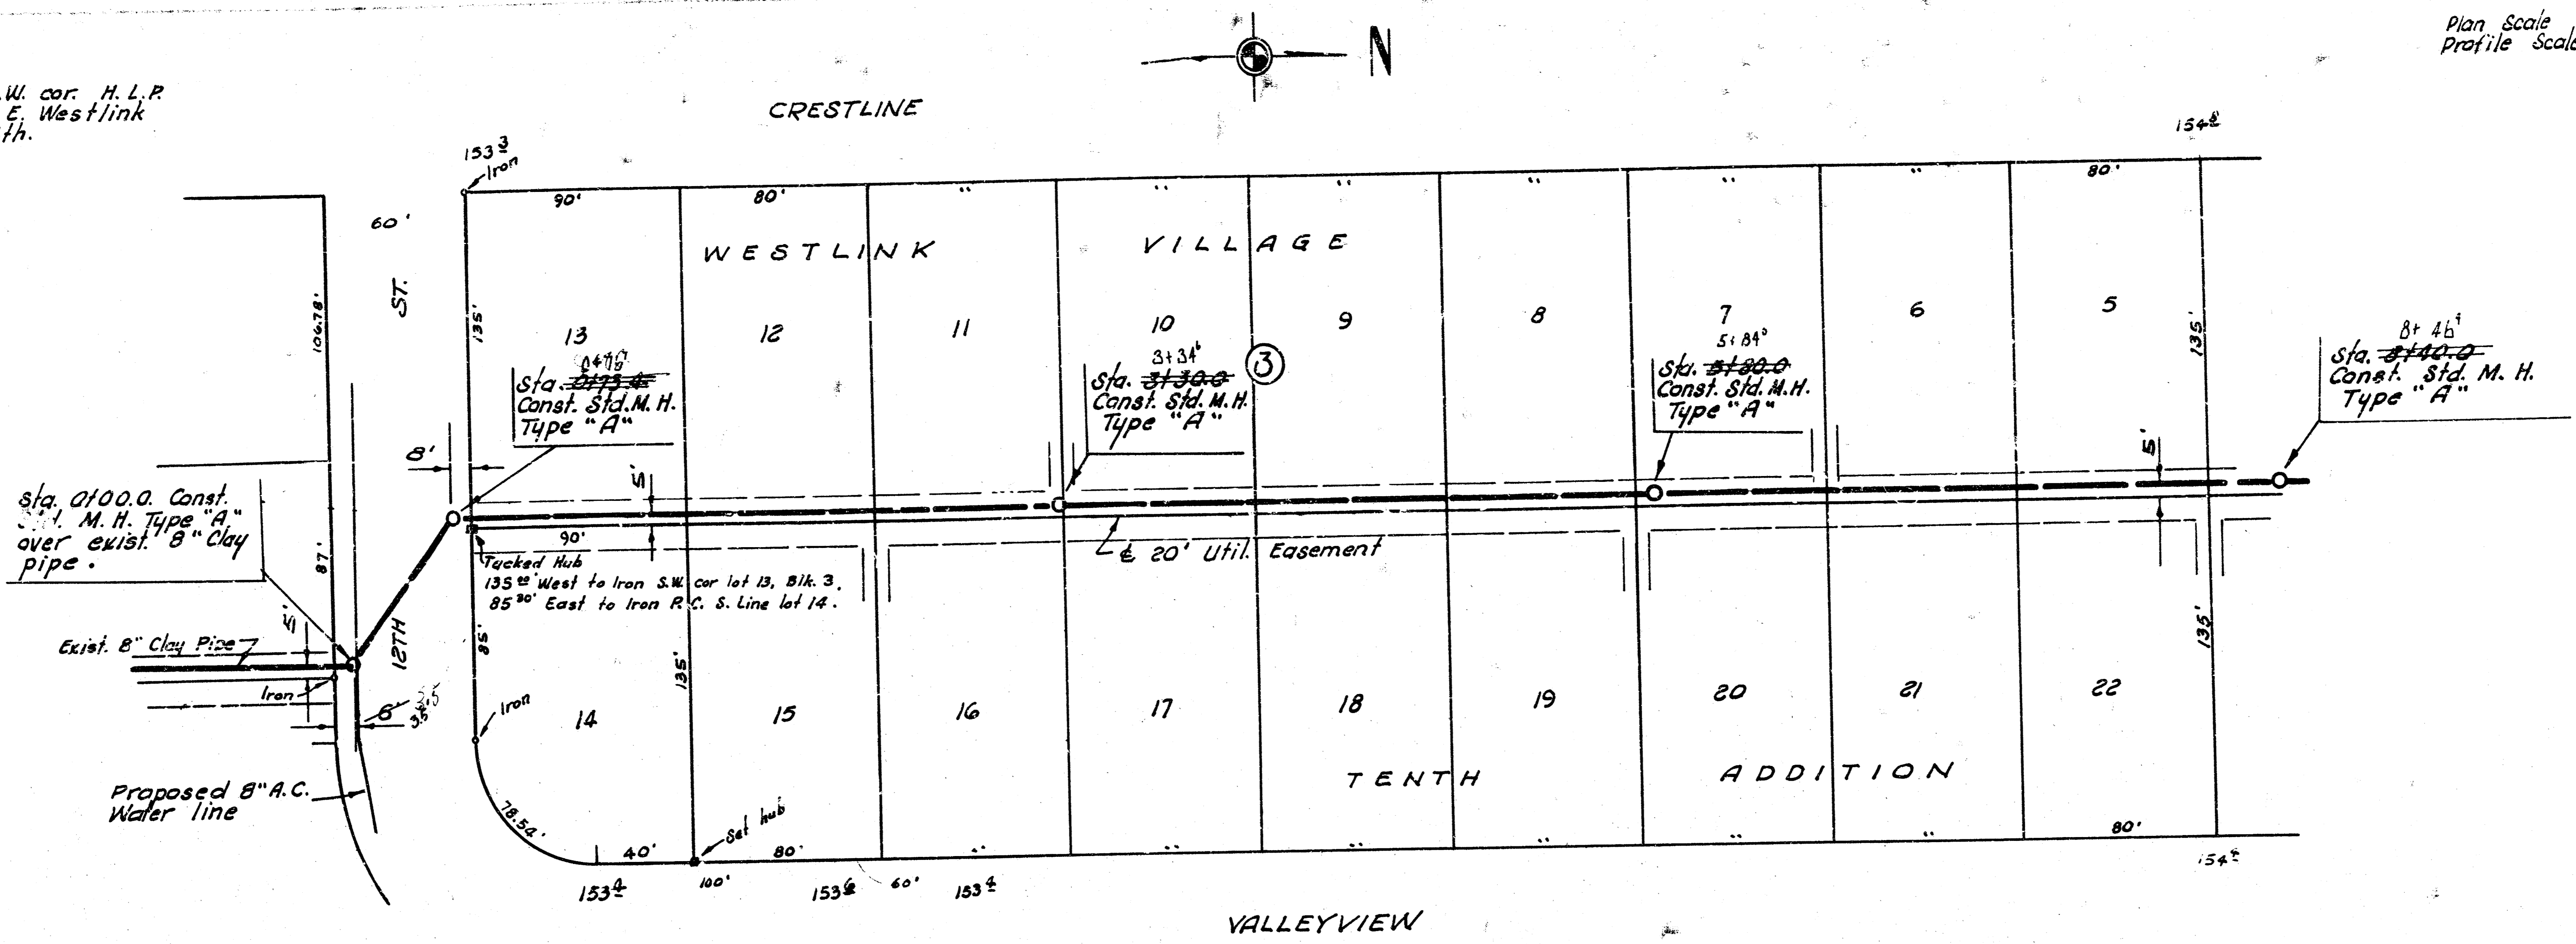


B. M. 15708 Top bolt S.W. cor. H.L.P.
Base S-Side K.G.E. Westlink
sub station on 13th.

Plan Scale 1" = 40'
Profile Scale 1" = 40' Horiz.
1" = 5' Vert.



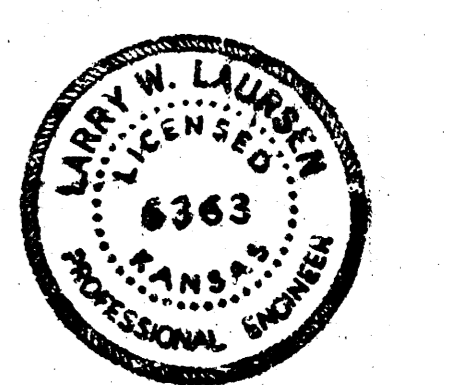


AS BUILT FROM PLAN K-109
LAT. 5, MAIN 2, WESTLINK SEWER
 CITY OF WICHITA, KANSAS 1/2
 R. W. LINN — CITY ENGINEER
 FEB. 1973, PROJECT NO. DBKL572053

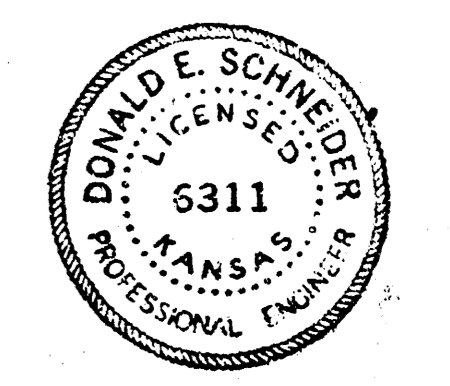


10 sets Engr.
1 set water

B. M. 157.08 top bolt S.W. cor. H. L. P. base
 S-side K. G. E. Westlink Substation on 13th.

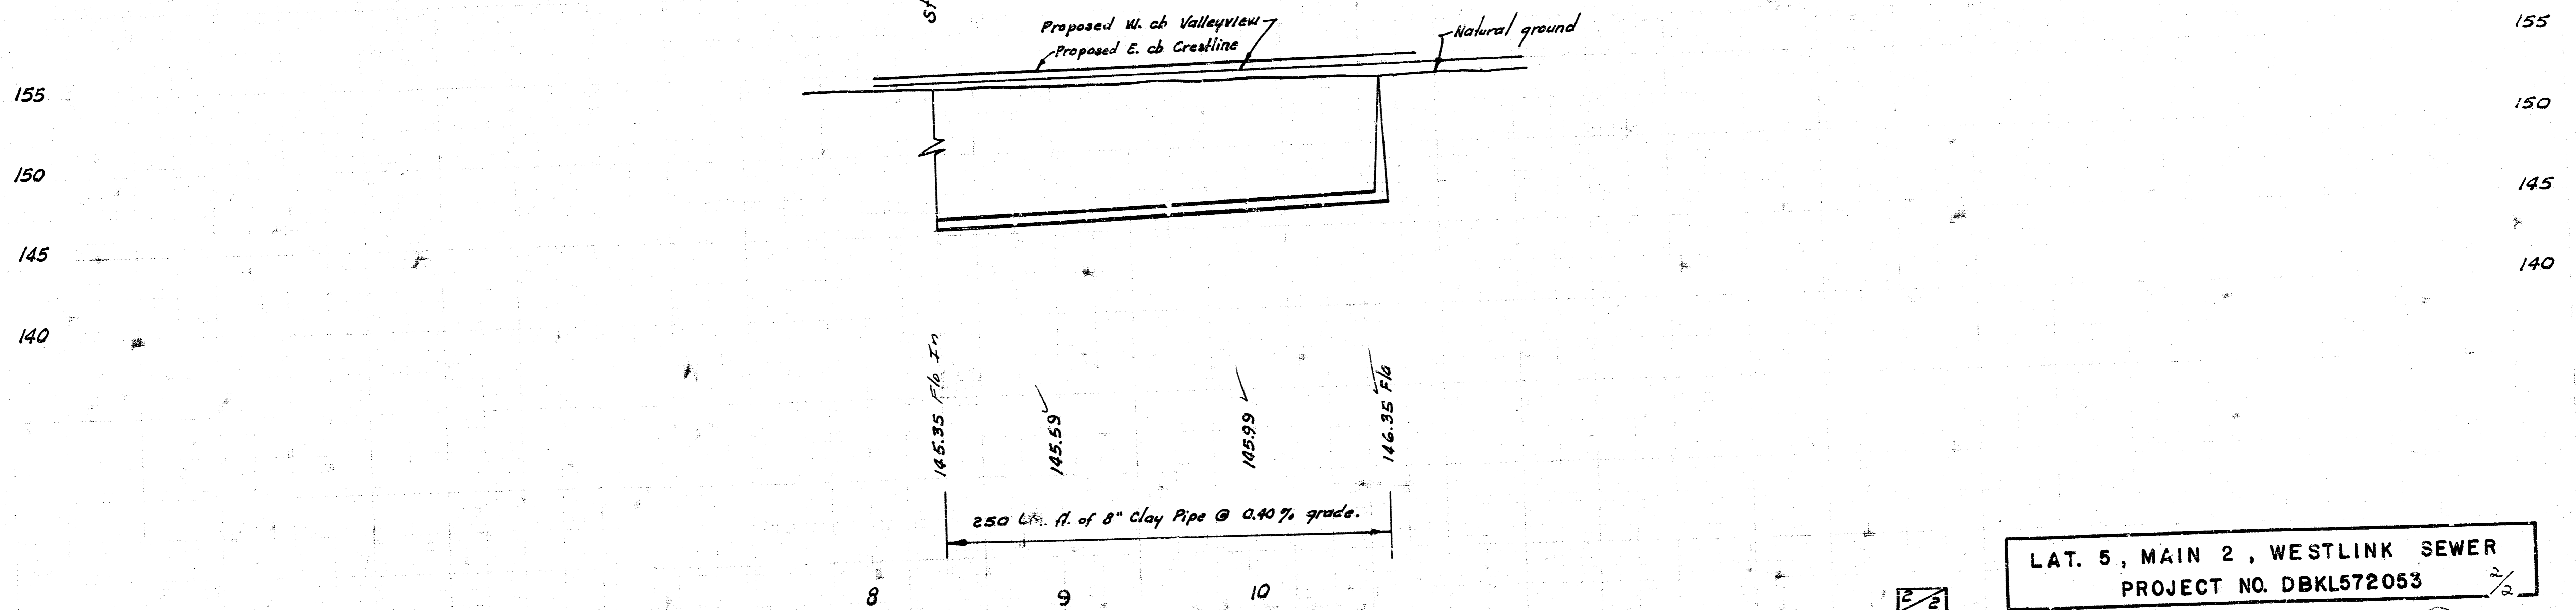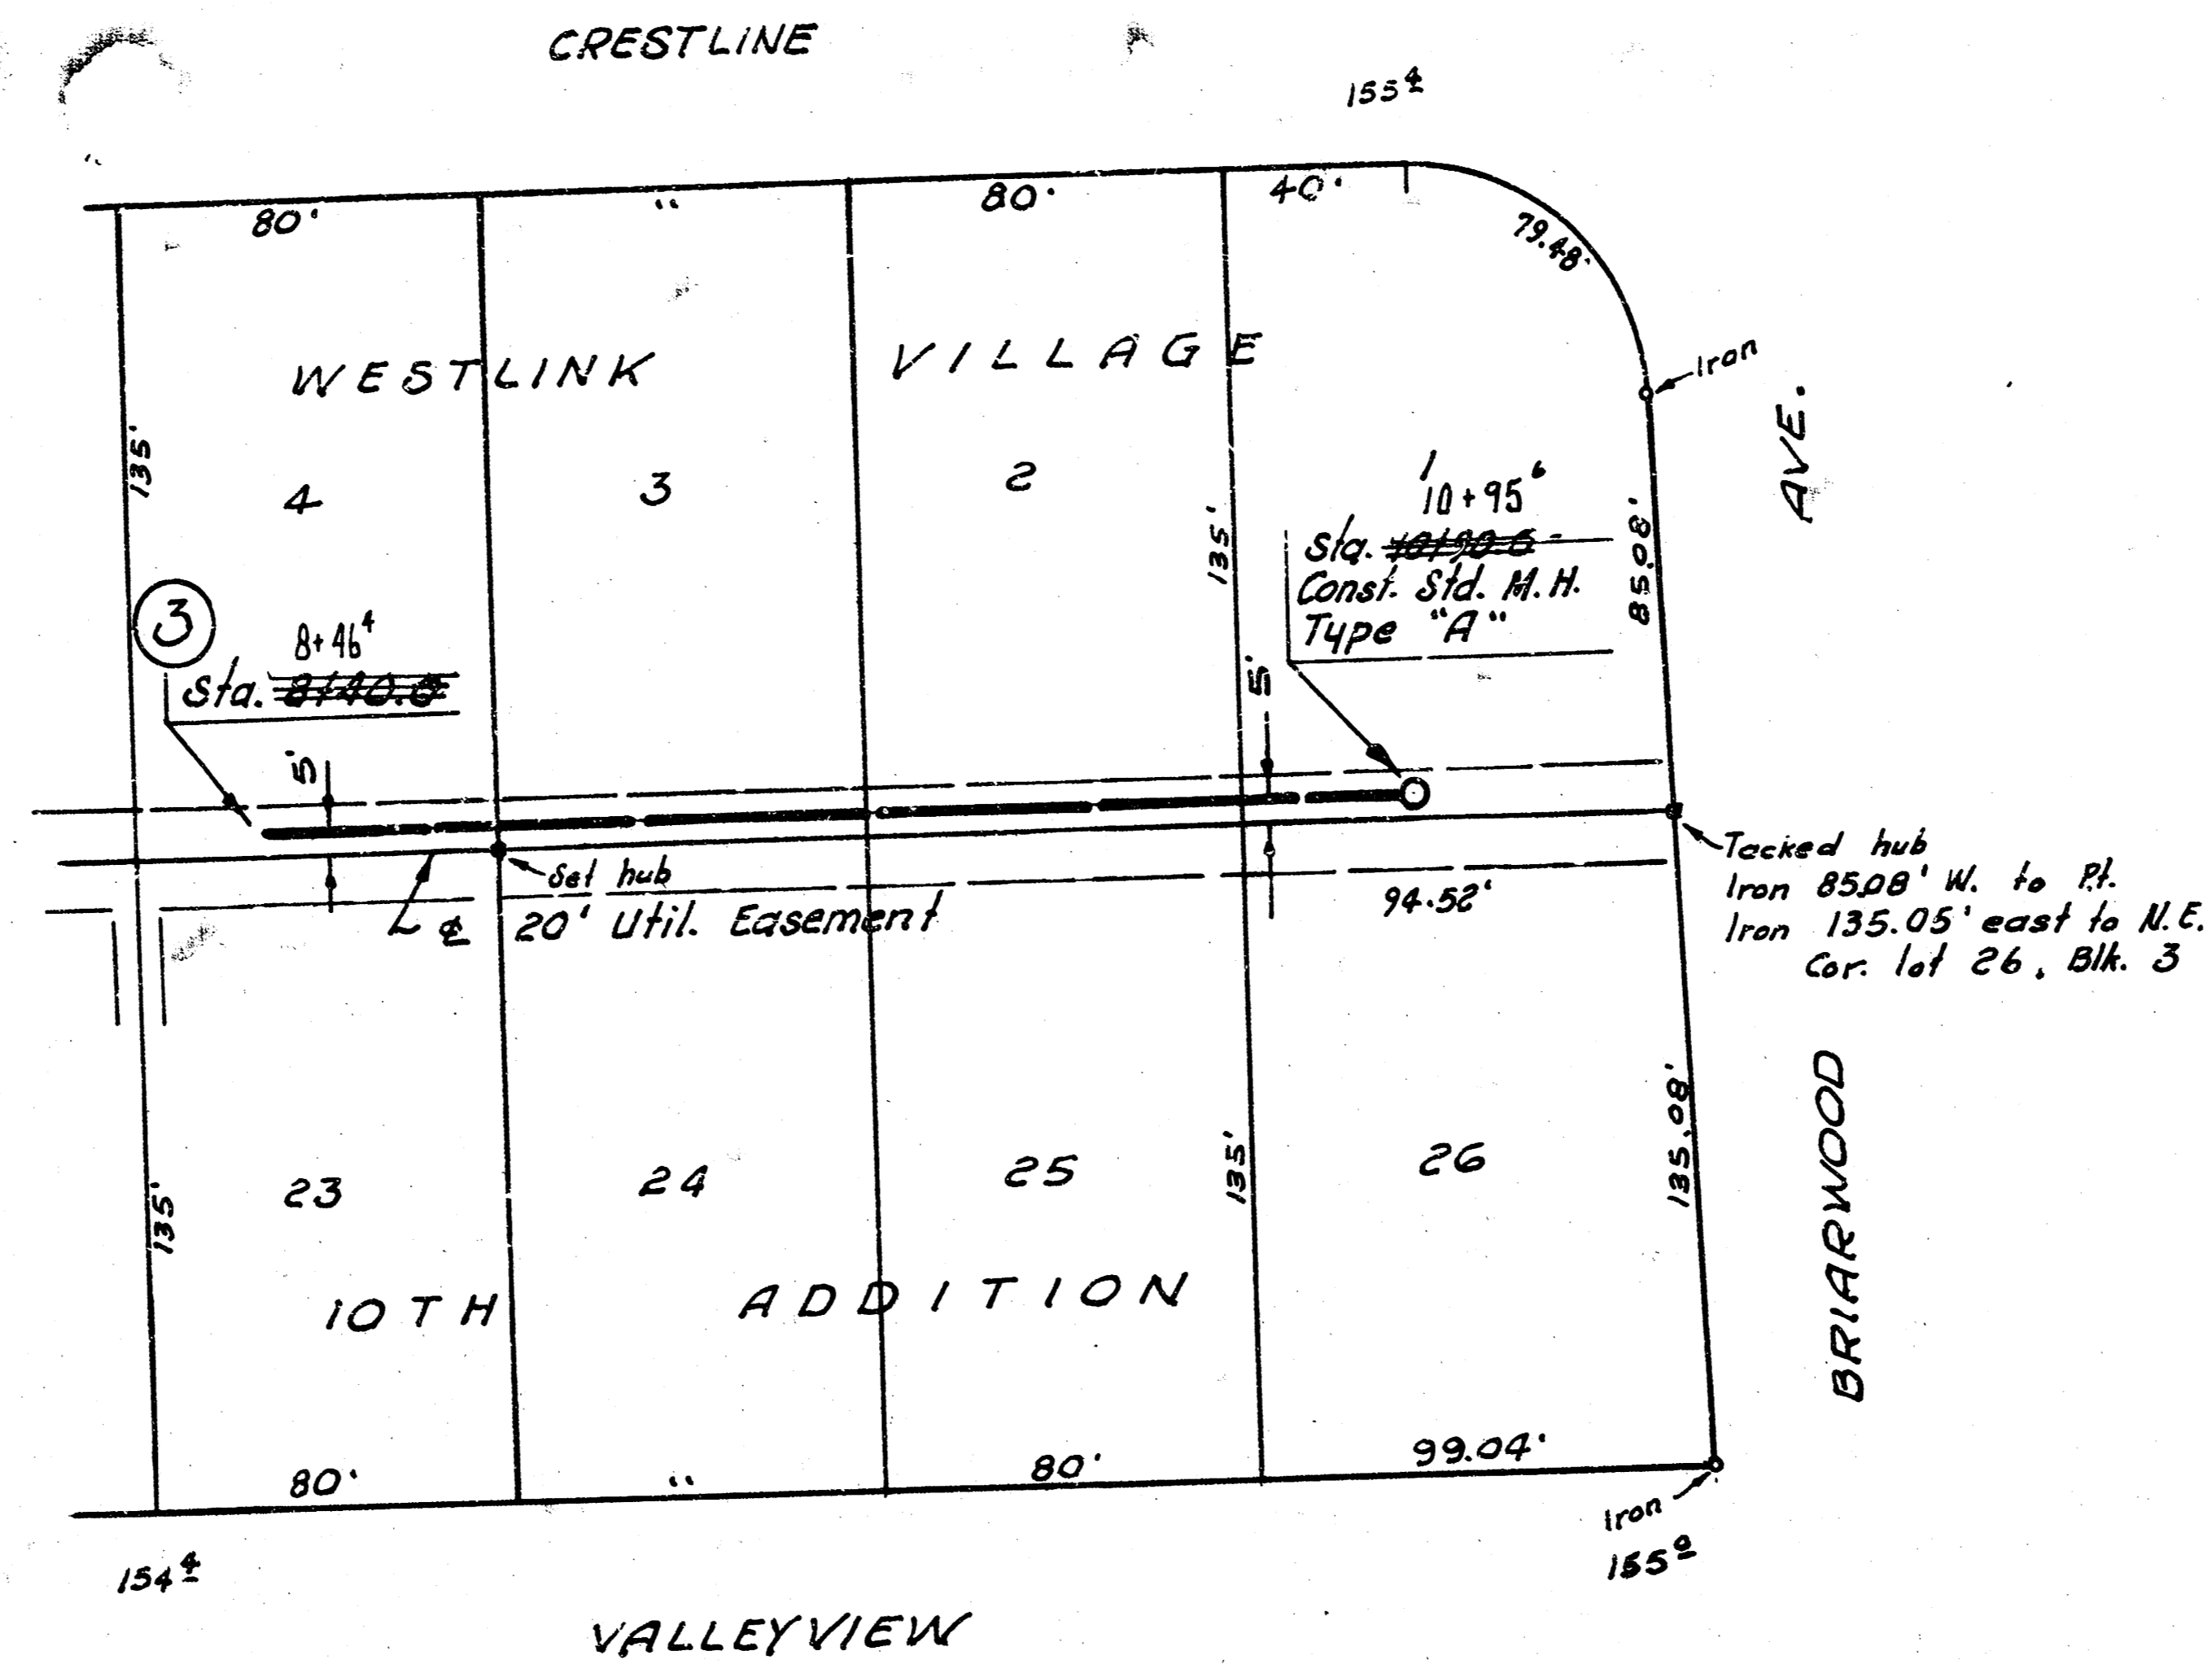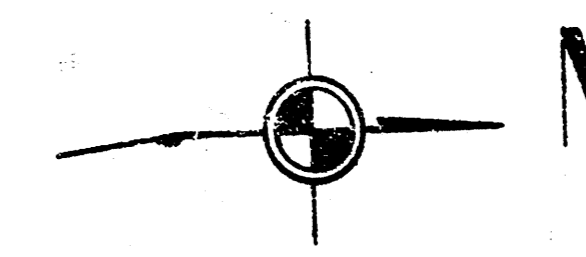

LAT. 5, MAIN 2, WESTLINK SEWER
 PROJECT NO. DBKL572053

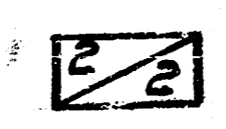

14 2 1 2