



Plan Scale 1" = 40'
 Profile Scale 1" = 40' Horiz
 1" = 5' Vert.

BM. 159.32 City Std. disc 39.3' S. and 56' E. of C. of 13th St. and Maize Rd.
 BM. 168.68 □ on Top Curb @ ES. Chipper Lane @ NL. Harvest

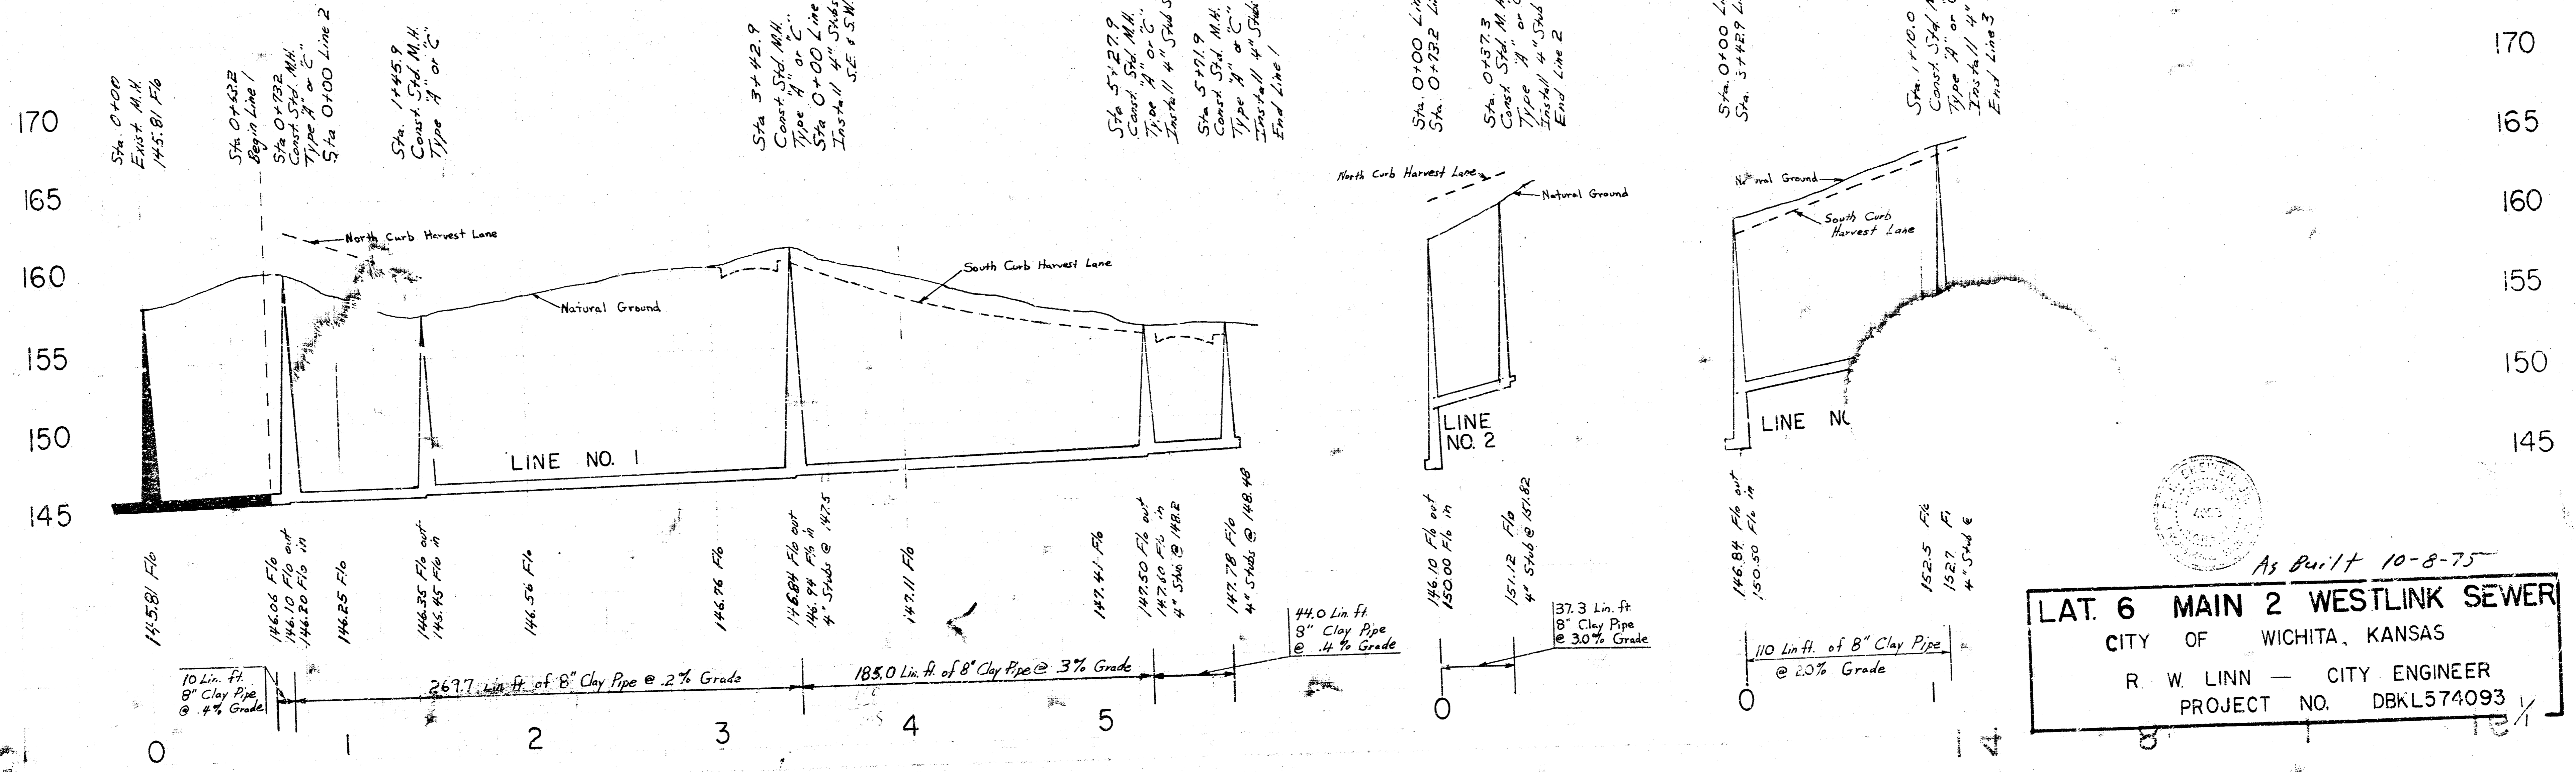

LAT. 6 MAIN 2 WESTLINK SEWER
 CITY OF WICHITA, KANSAS
 R. W. LINN — CITY ENGINEER
 PROJECT NO. DBKL574093

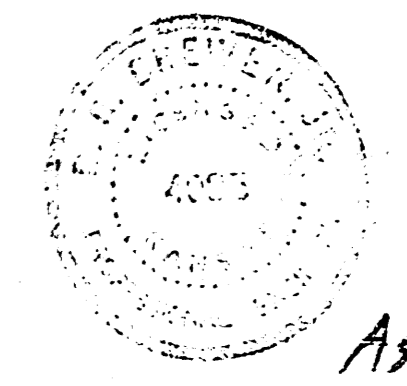

As Built 10-8-75