




B. M. 158.58 N.W. cor. conc porch,
W. S. House 1502 MURRAY.

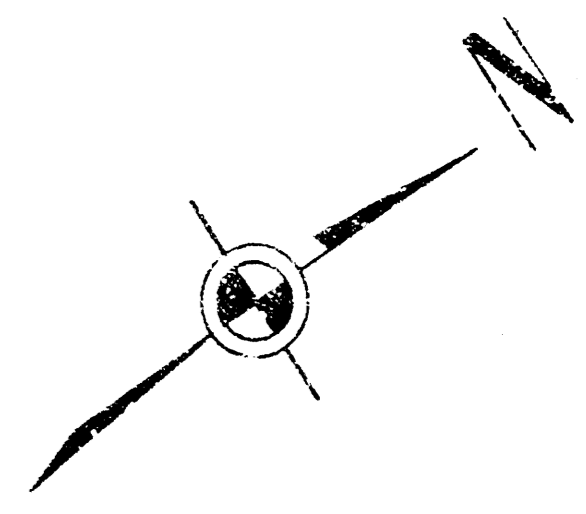

Plan Scale 1" = 40'
Profile Scale 1" = 5' Vert

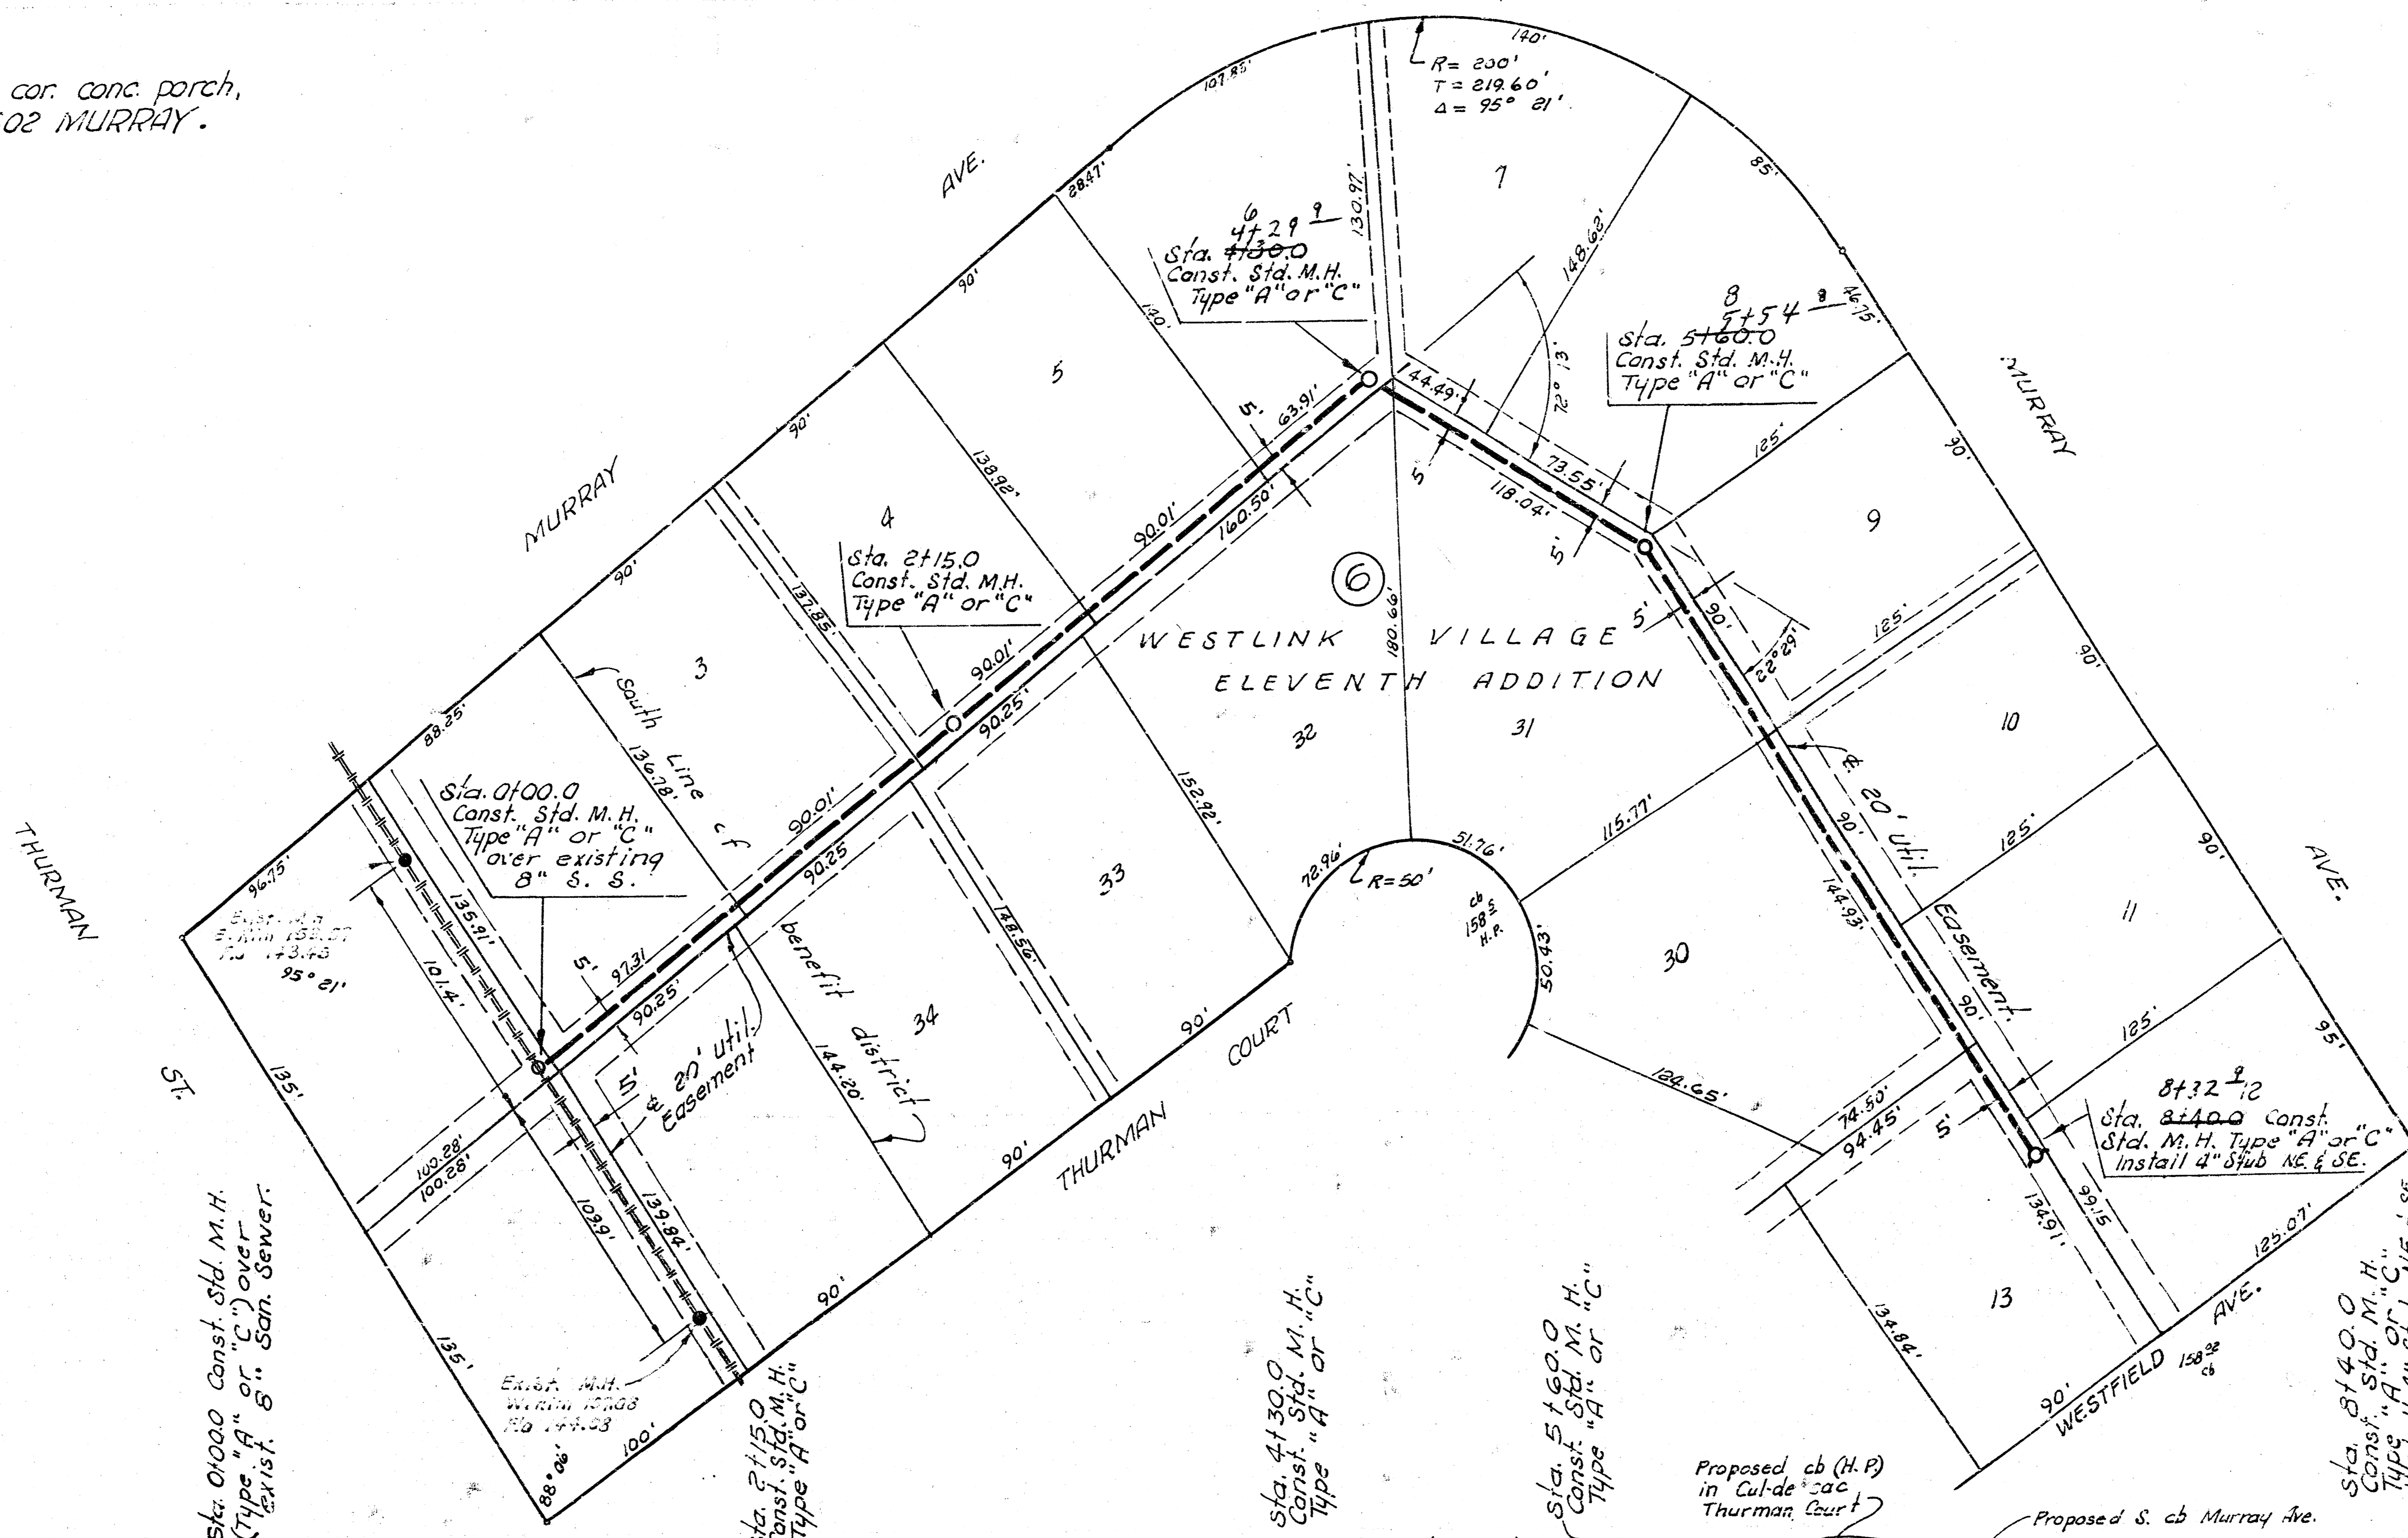

160
155
150
145
140

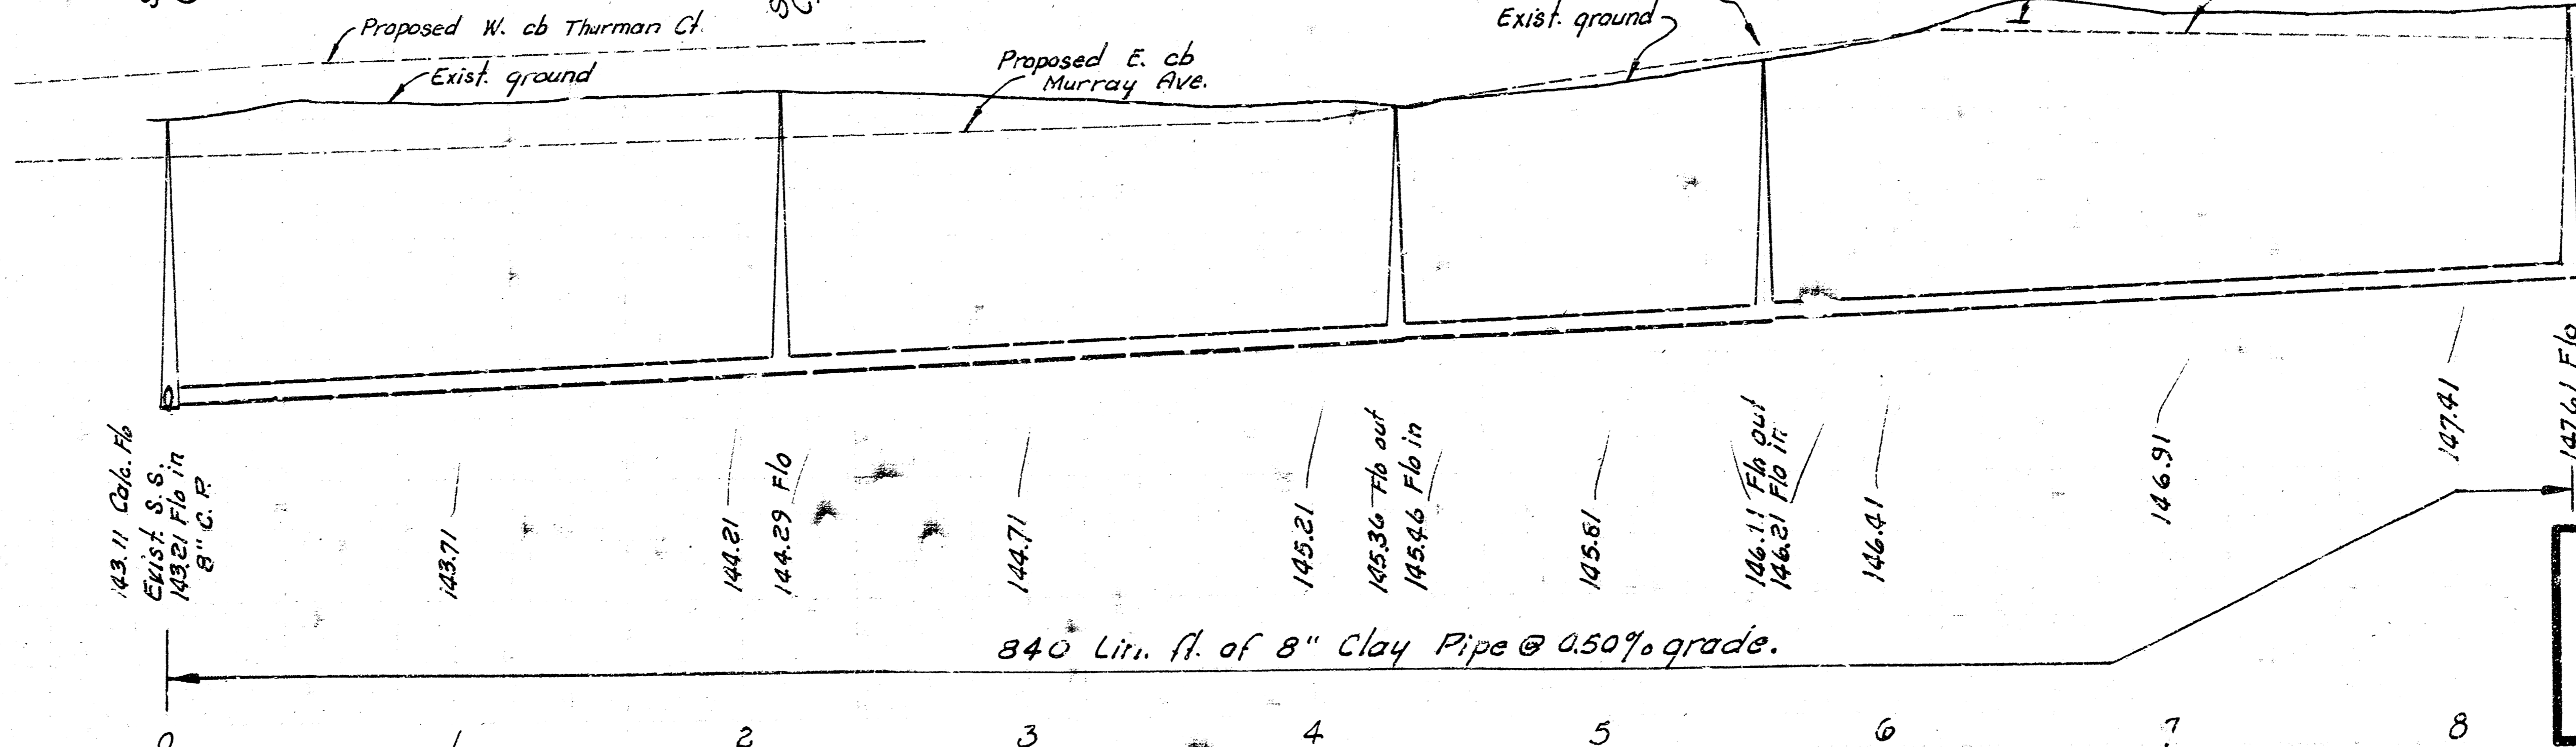

As Built 7-24-75
LAT. 4, MAIN 3, WESTLINK SEWER
 CITY OF WICHITA, KANSAS
 R. W. LINN — CITY ENGINEER
 MAY 1975 PROJECT NO. DBKL574028

