
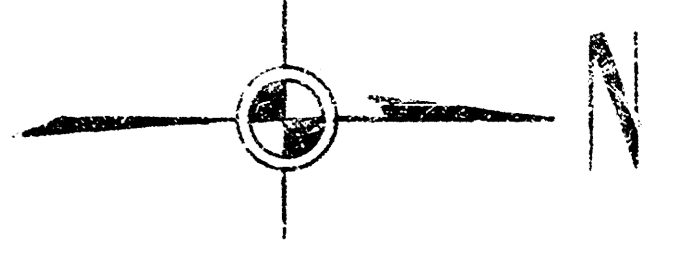


B. M. 158.58 N.W. cor. conc. porch,
W. S. house 1502 Murray.

D. C. P.
U. R. W.


90

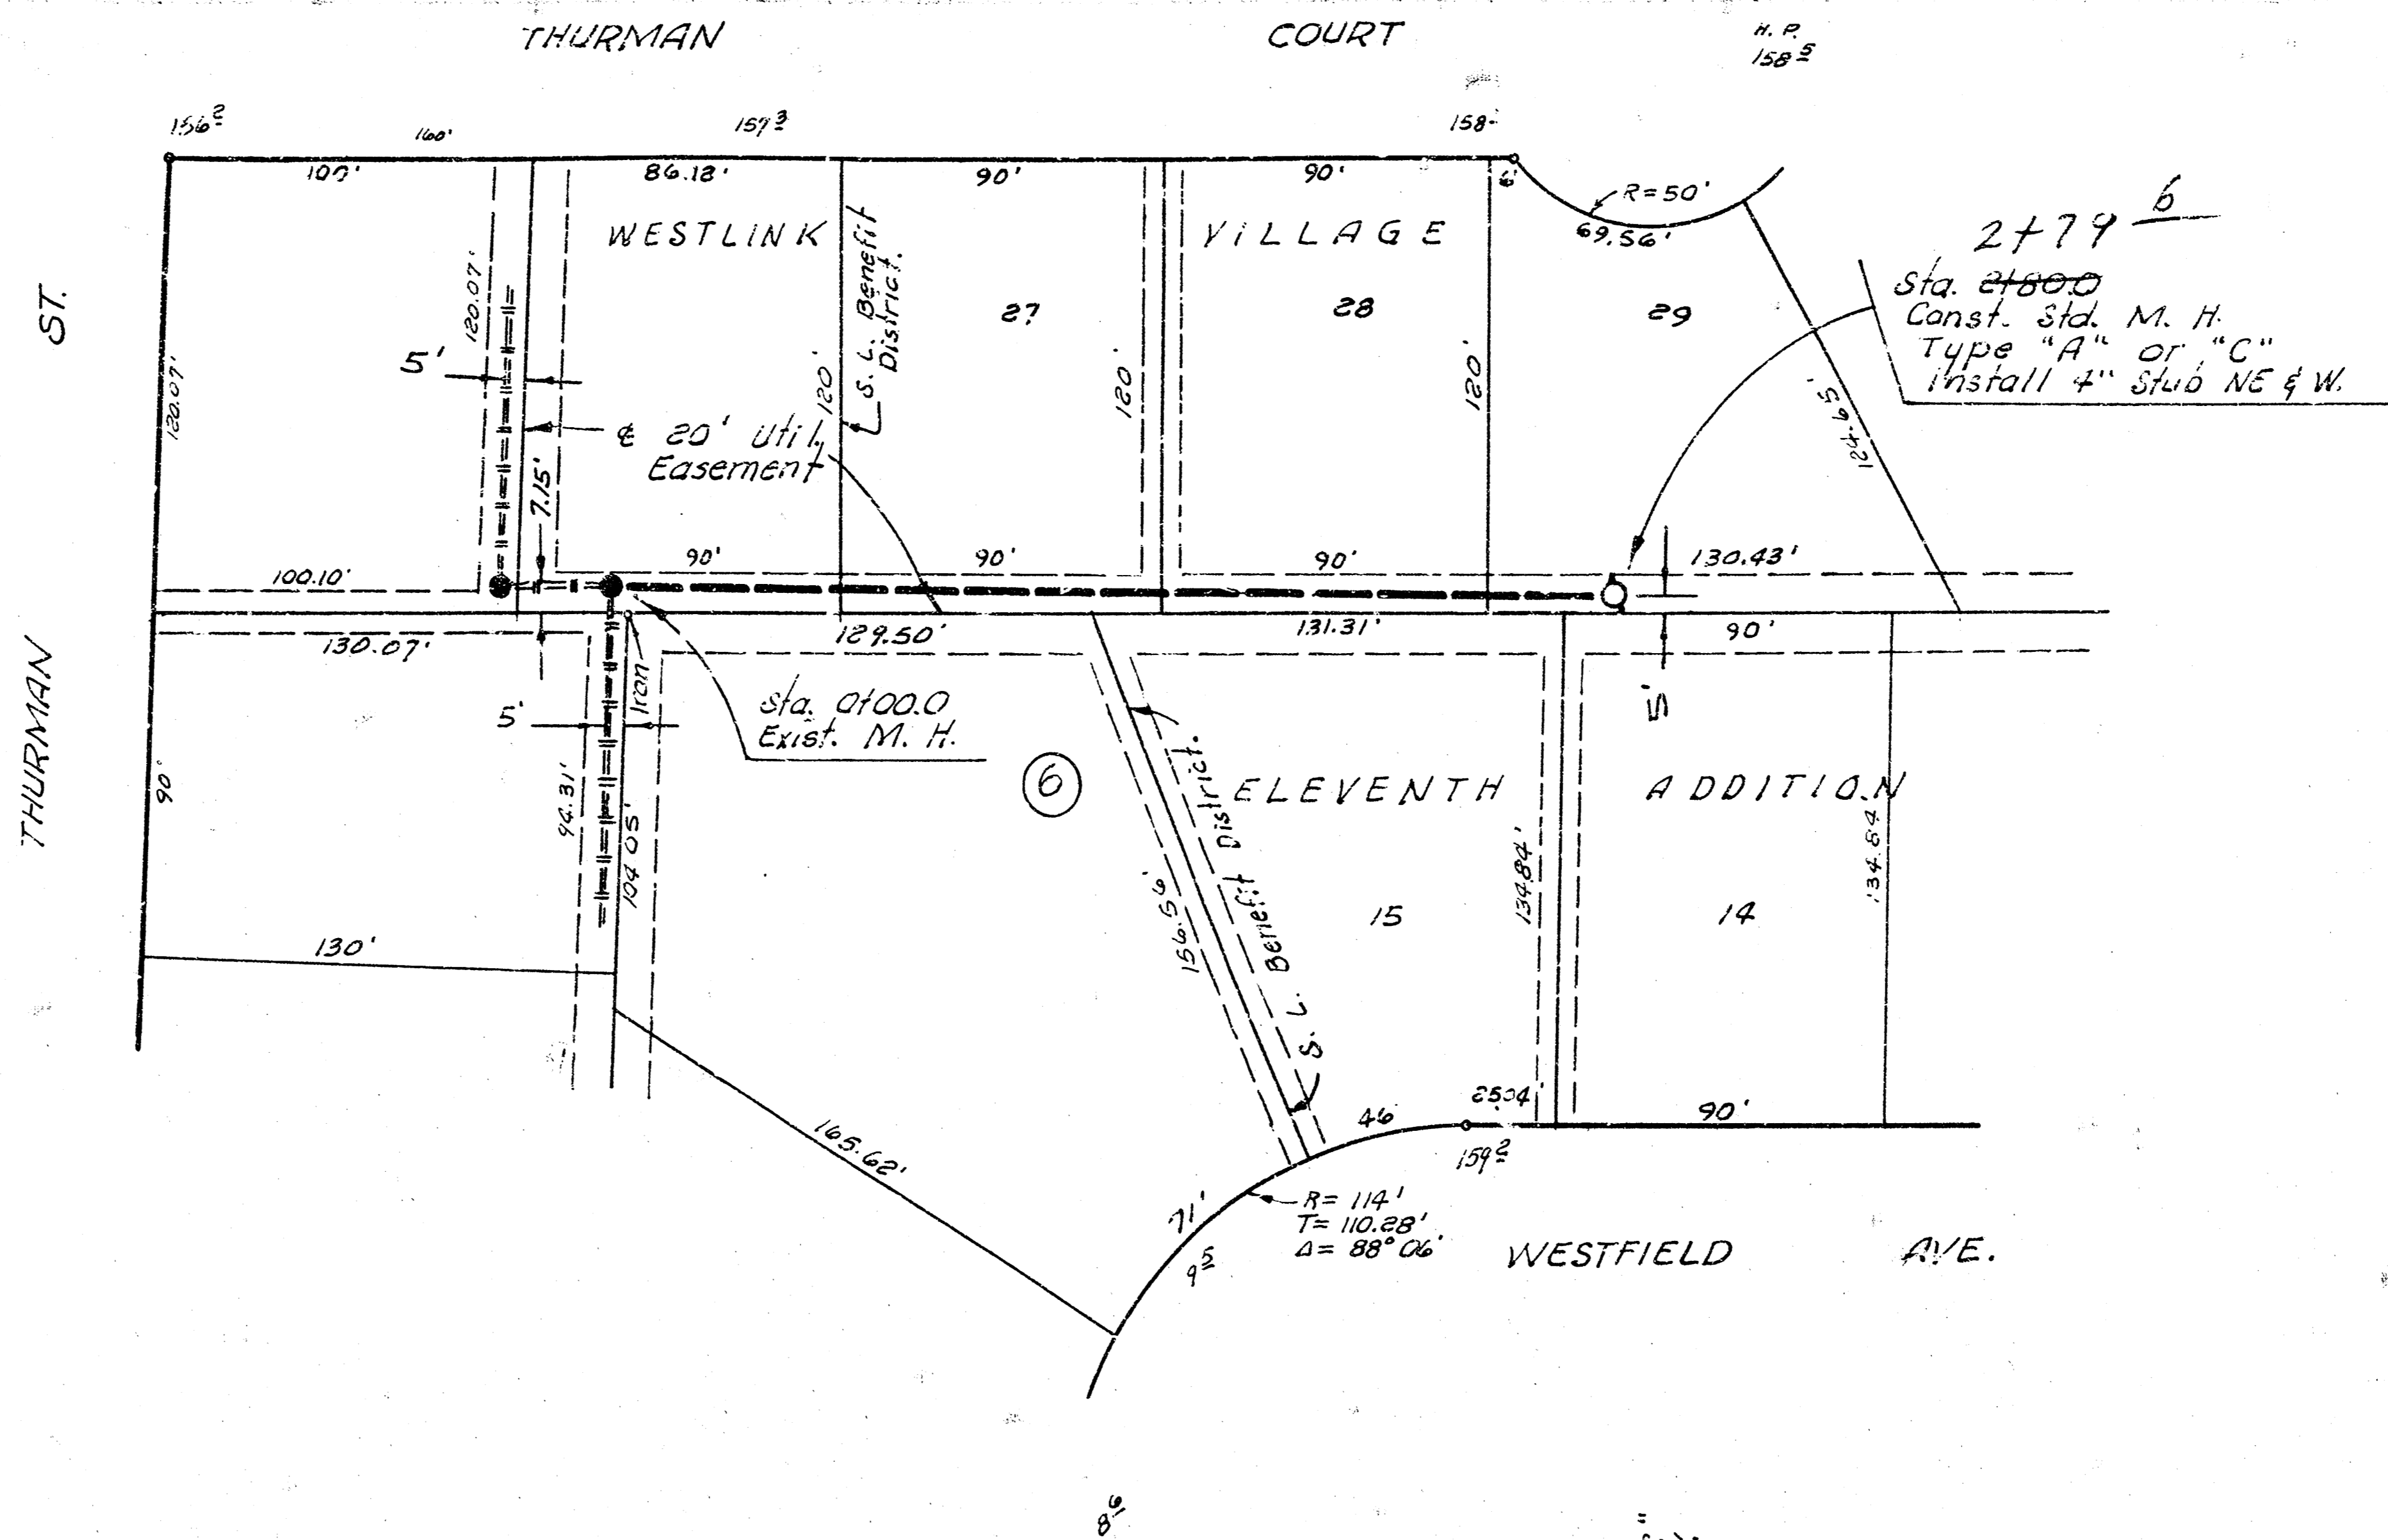

Plan Scale 1"=40'
Profile Scale 1"=40' Horiz.
1"=5' Vert.

160
155
150
145
140

160
155
150
145
140

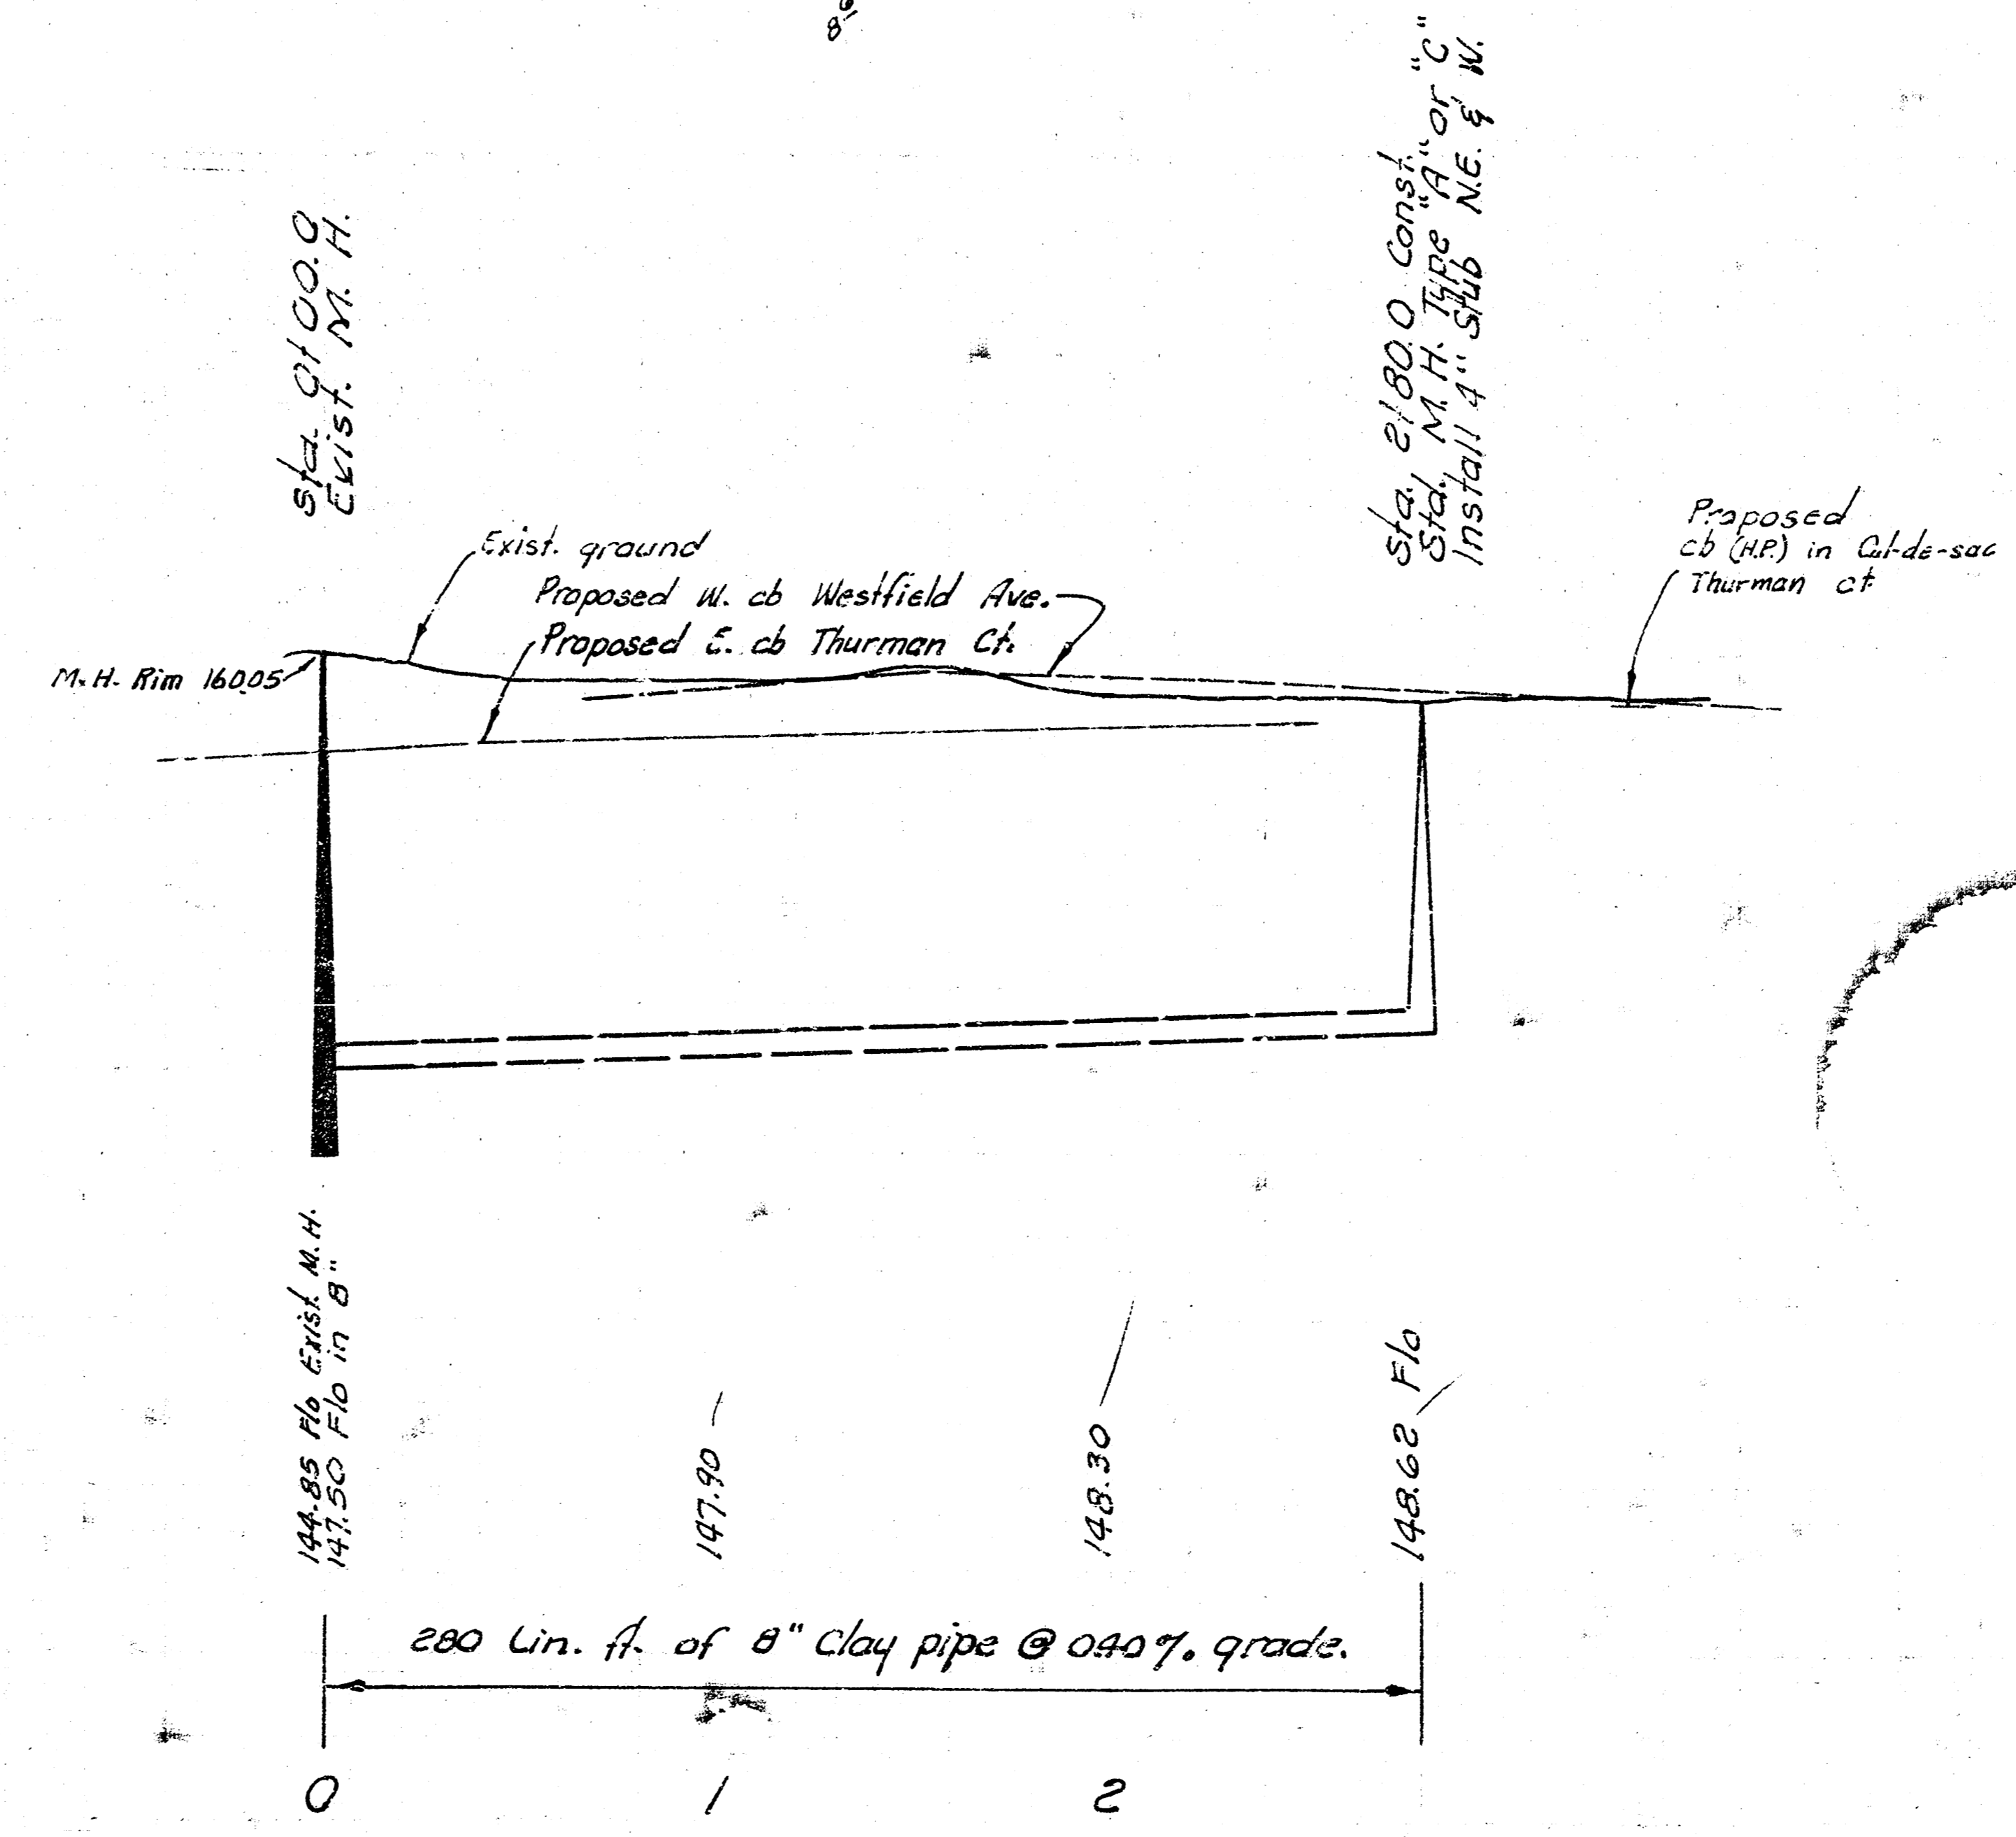

As Built 7-24-75

LAT. 5, MAIN 3, WESTLINK SEWER
 CITY OF WICHITA, KANSAS
 R. W. LINN — CITY ENGINEER
 1975 PROJECT NO. DBKL574029

14 8 1 10 11