




PLAN  
 Scale: 1" = 40'  
 DATE: 8-25-76  
 DRAWN BY: [Name]  
 CHECKED BY: [Name]

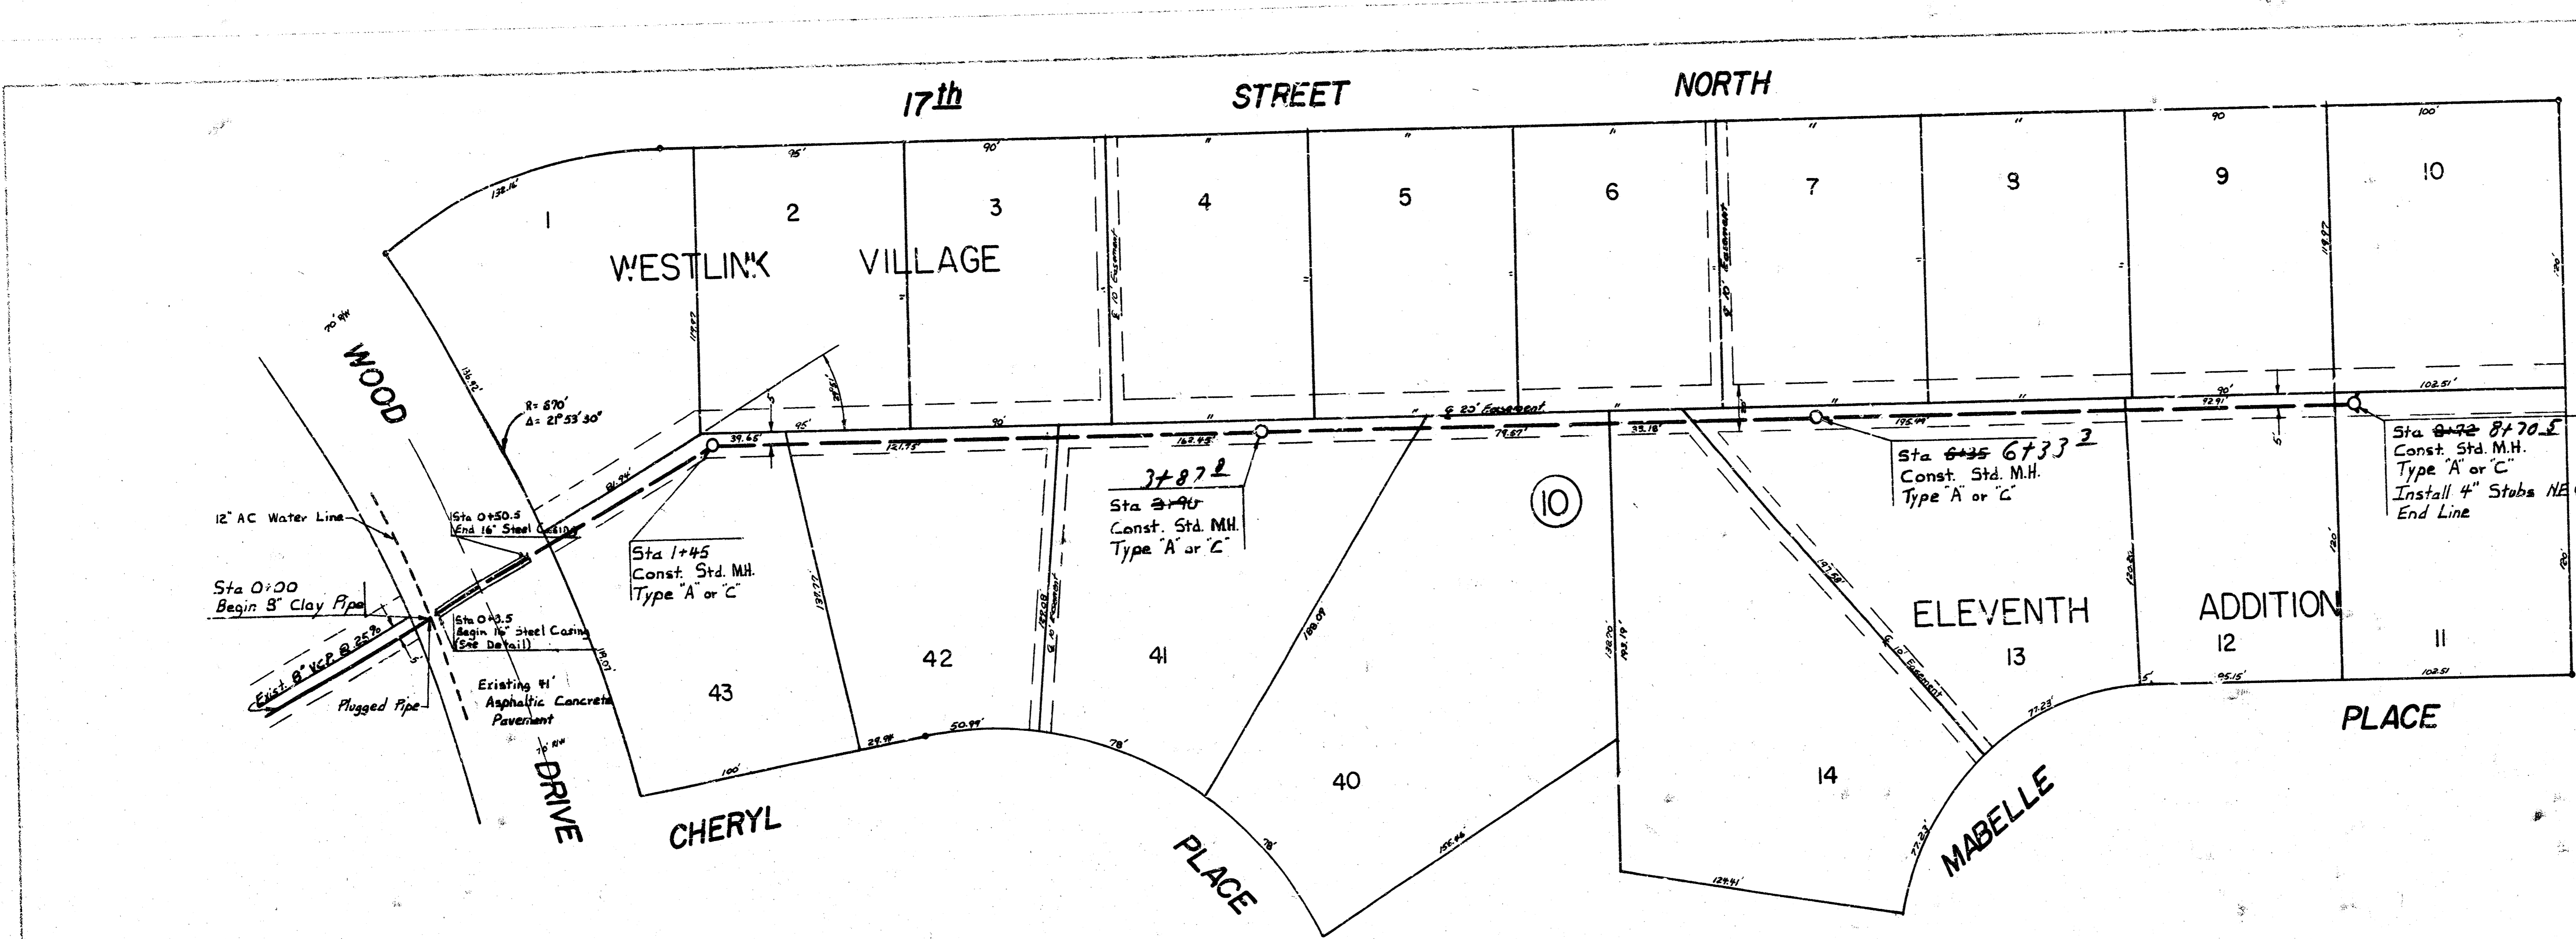

Plan Scale 1" = 40'  
 Profile Scale 1" = 40' Horiz  
 1" = 5' Vert.

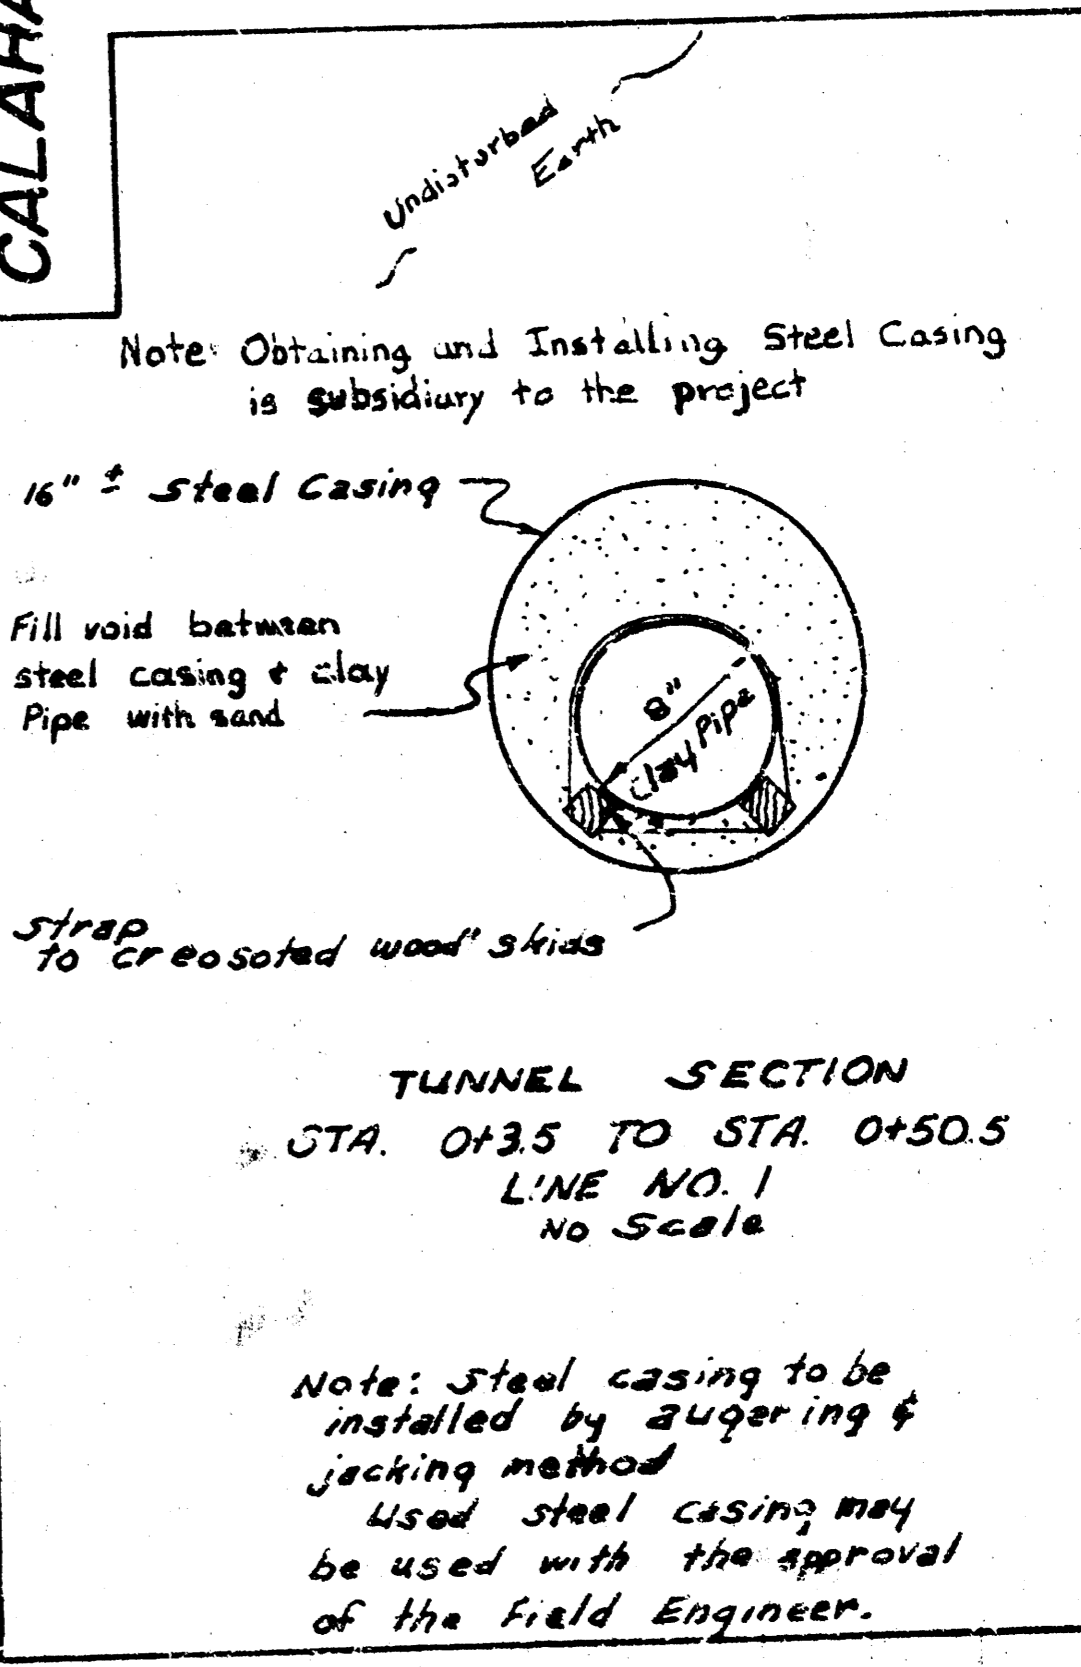

BM. 172.48 City Std SE Corner 17th St North & Tyler Road  
 BM. 158.65 "□" top East curb Wood Drive at South Line 17th St. North

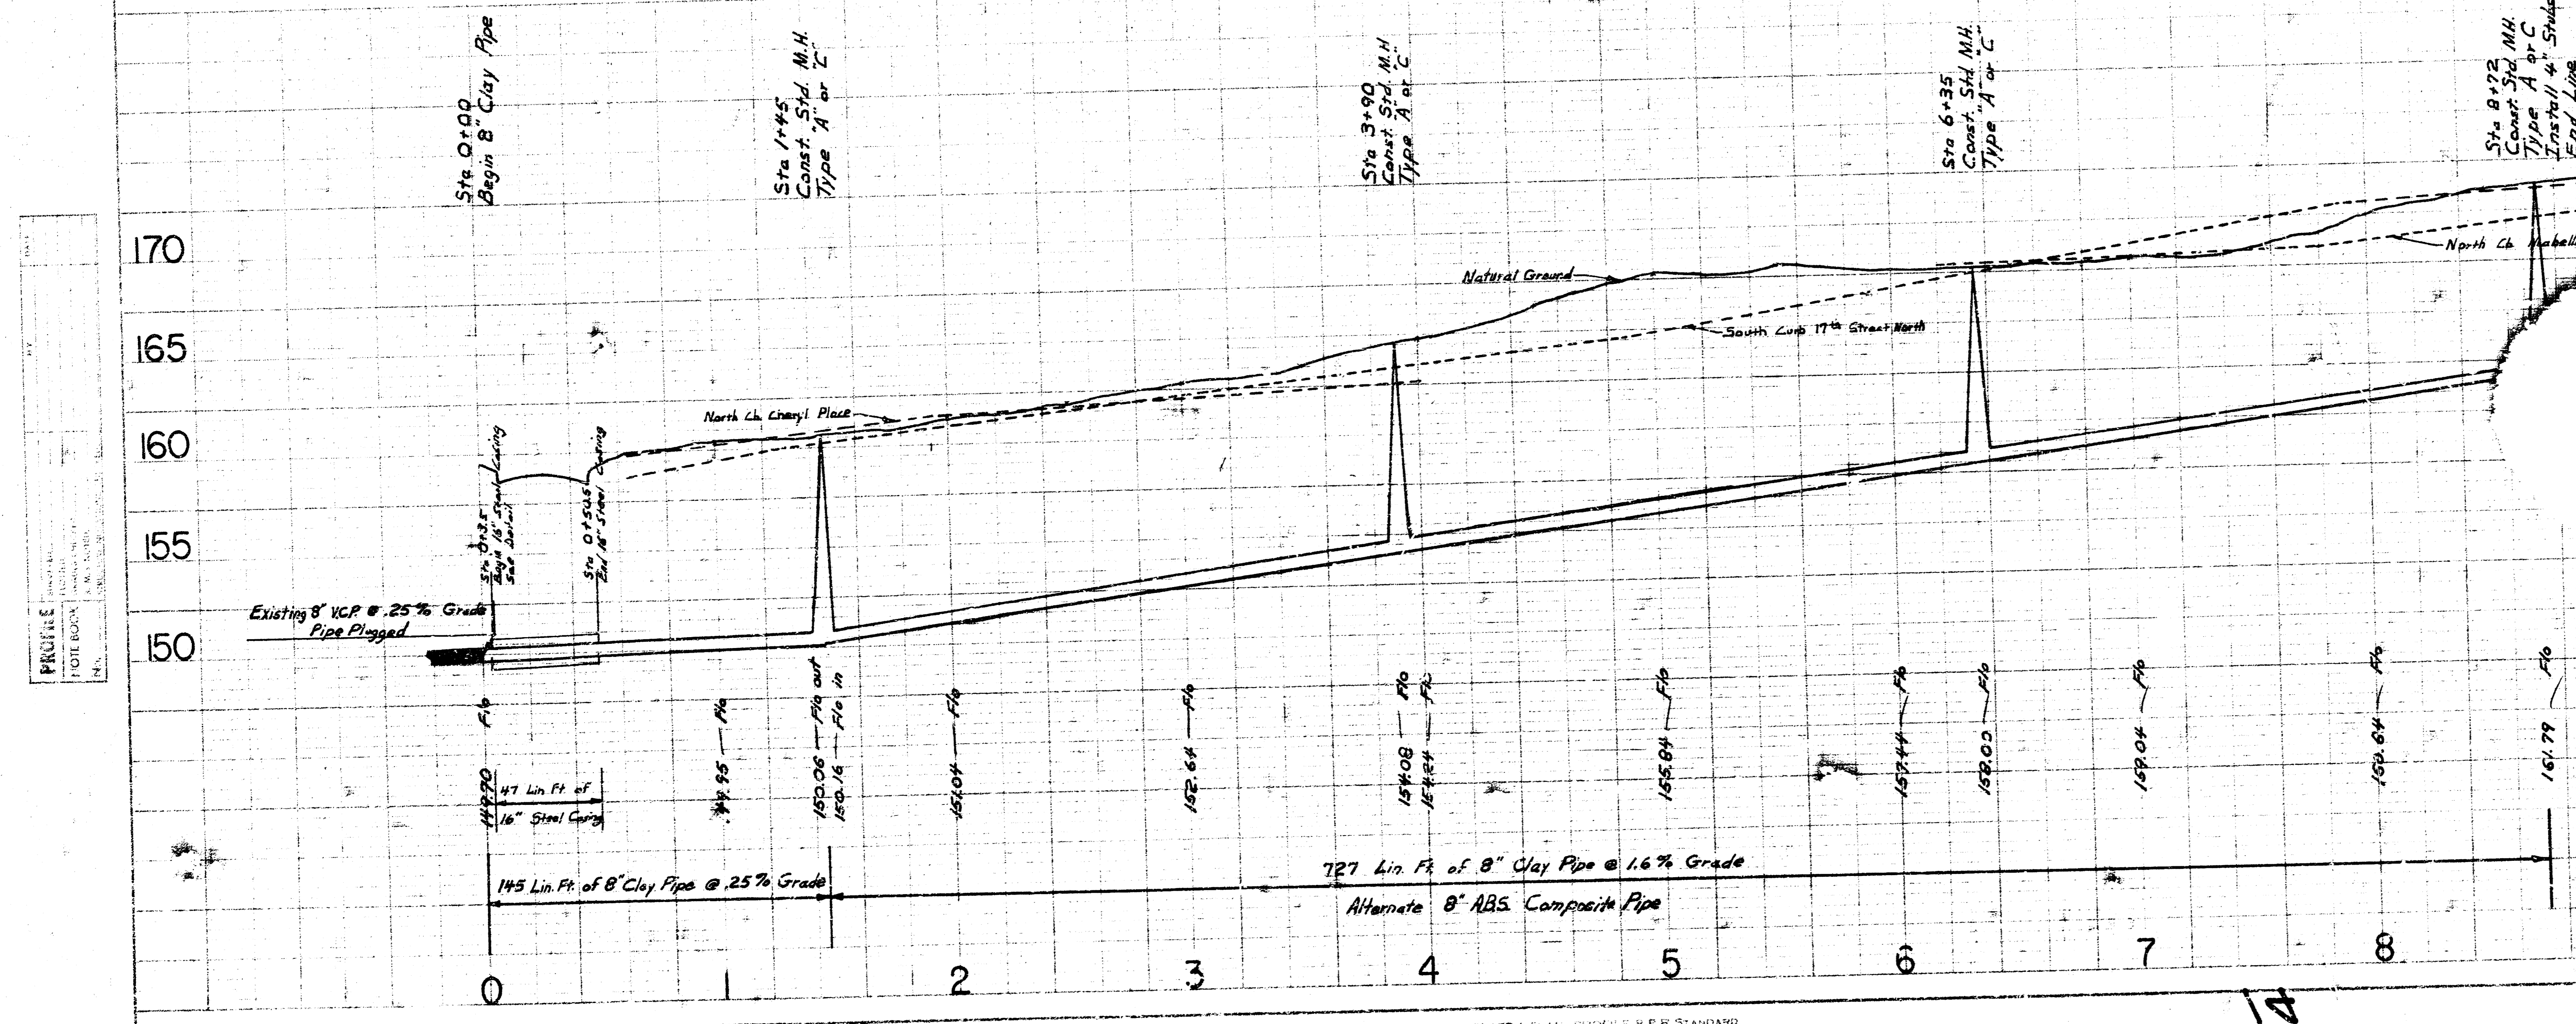

As Built 8-25-76  
**LAT 7 MAIN 3 WESTLINK SEWER**  
 CITY OF WICHITA, KANSAS  
 R. W. LINN CITY ENGINEER  
 Project No. DBKL 574-031

