

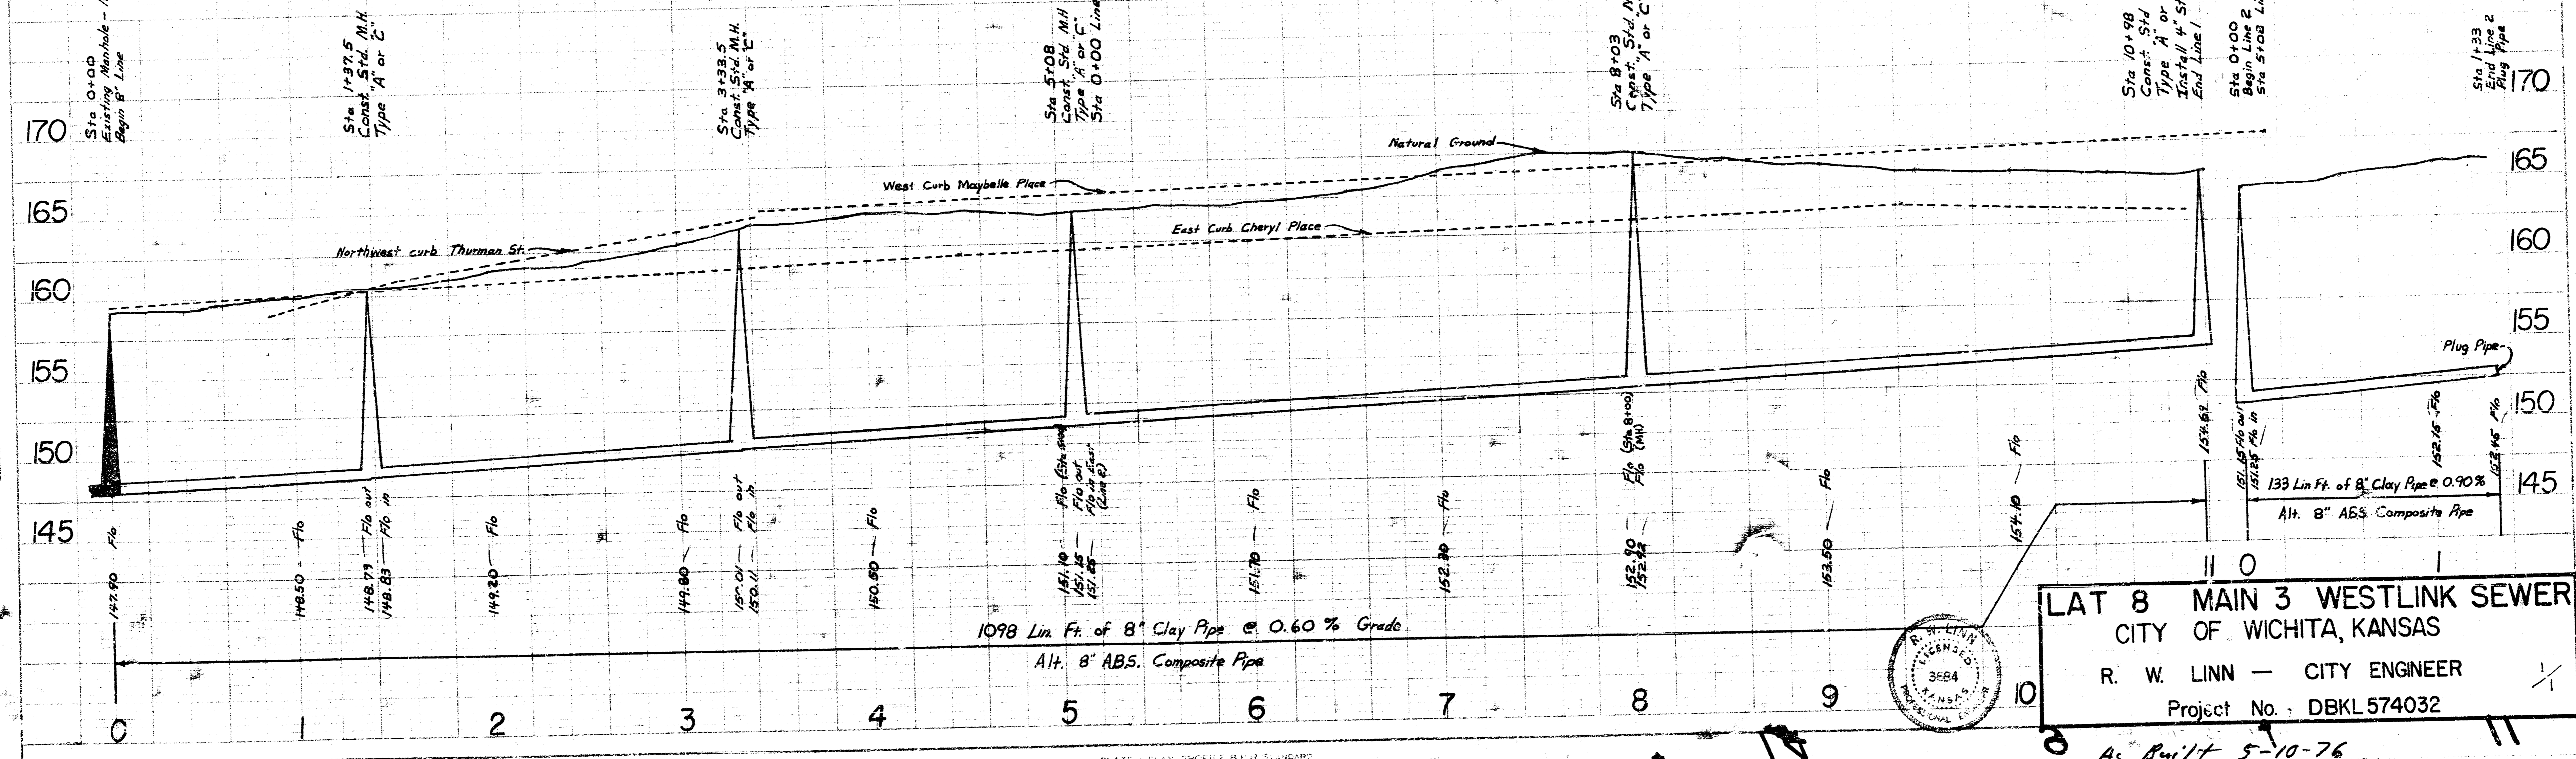



BM. 172.48 City Std. SE corner of 17<sup>th</sup> St. North and Tyler Road  
 BM. 158.75 SE. corner concrete porch 9116 Nantucket

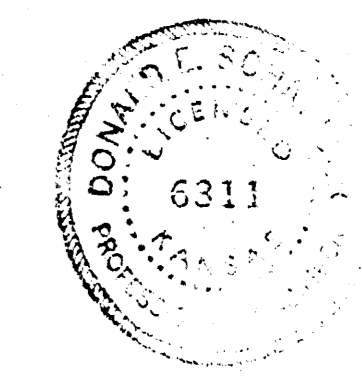

Plan Scale 1" = 40'  
 Profile Scale 1" = 40' Horz.  
 1" = 5' Vert.

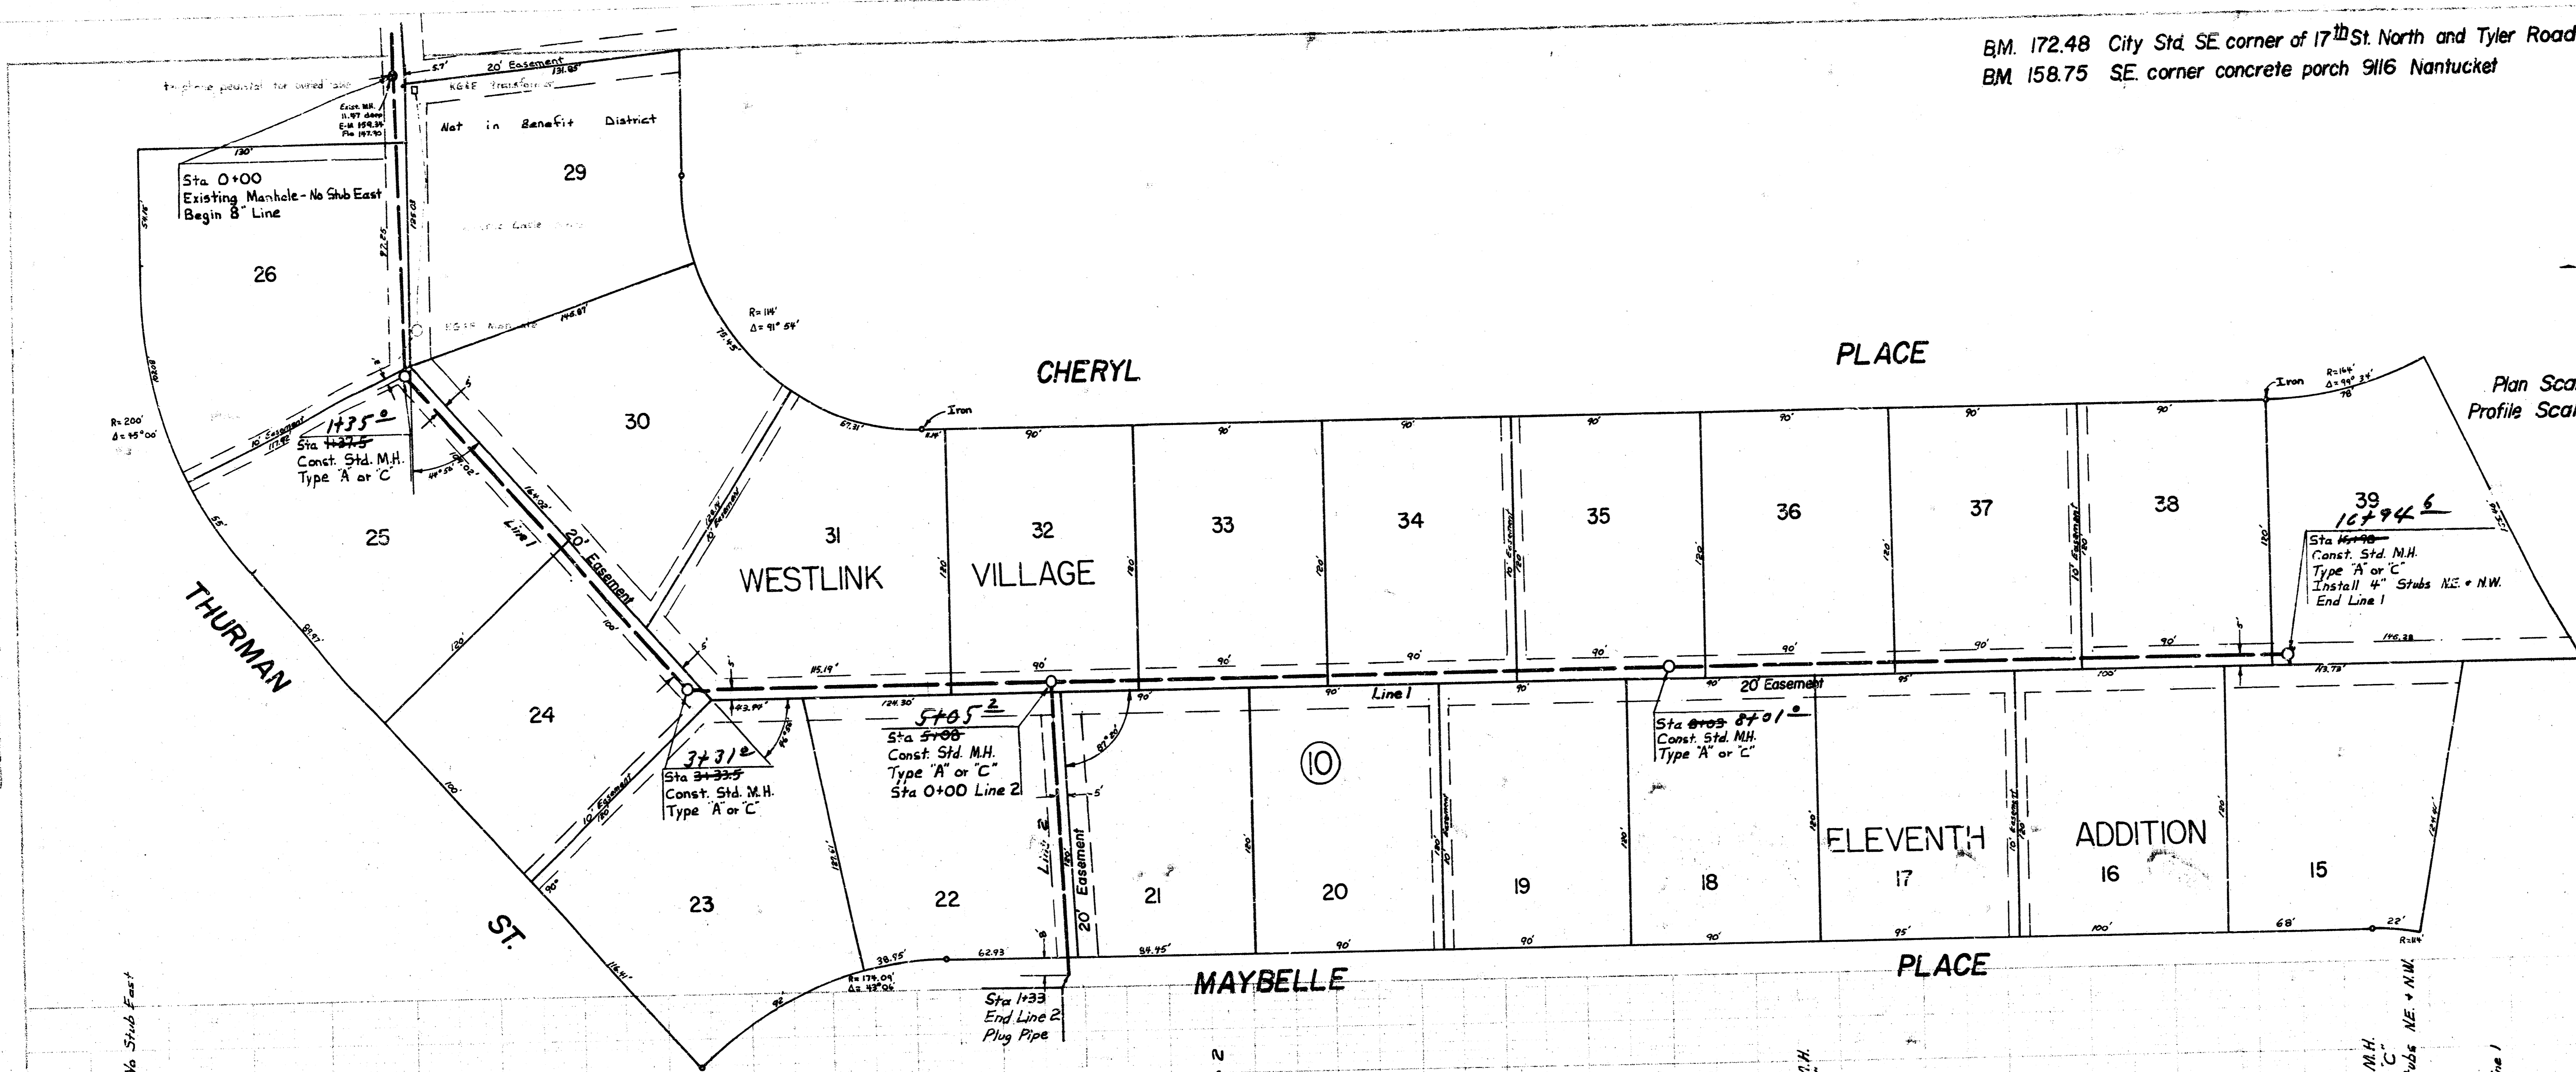

**LAT 8 MAIN 3 WESTLINK SEWER**  
 CITY OF WICHITA, KANSAS  
 R. W. LINN — CITY ENGINEER  
 Project No. DBKL 574032

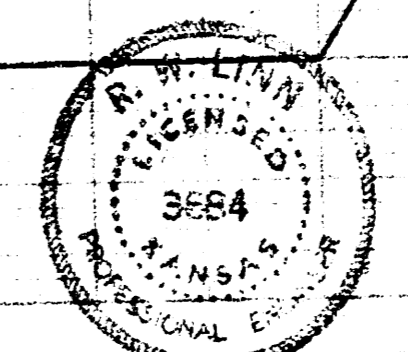

As Built 5-10-76