



CAUTION
UNDERGROUND
UTILITIES

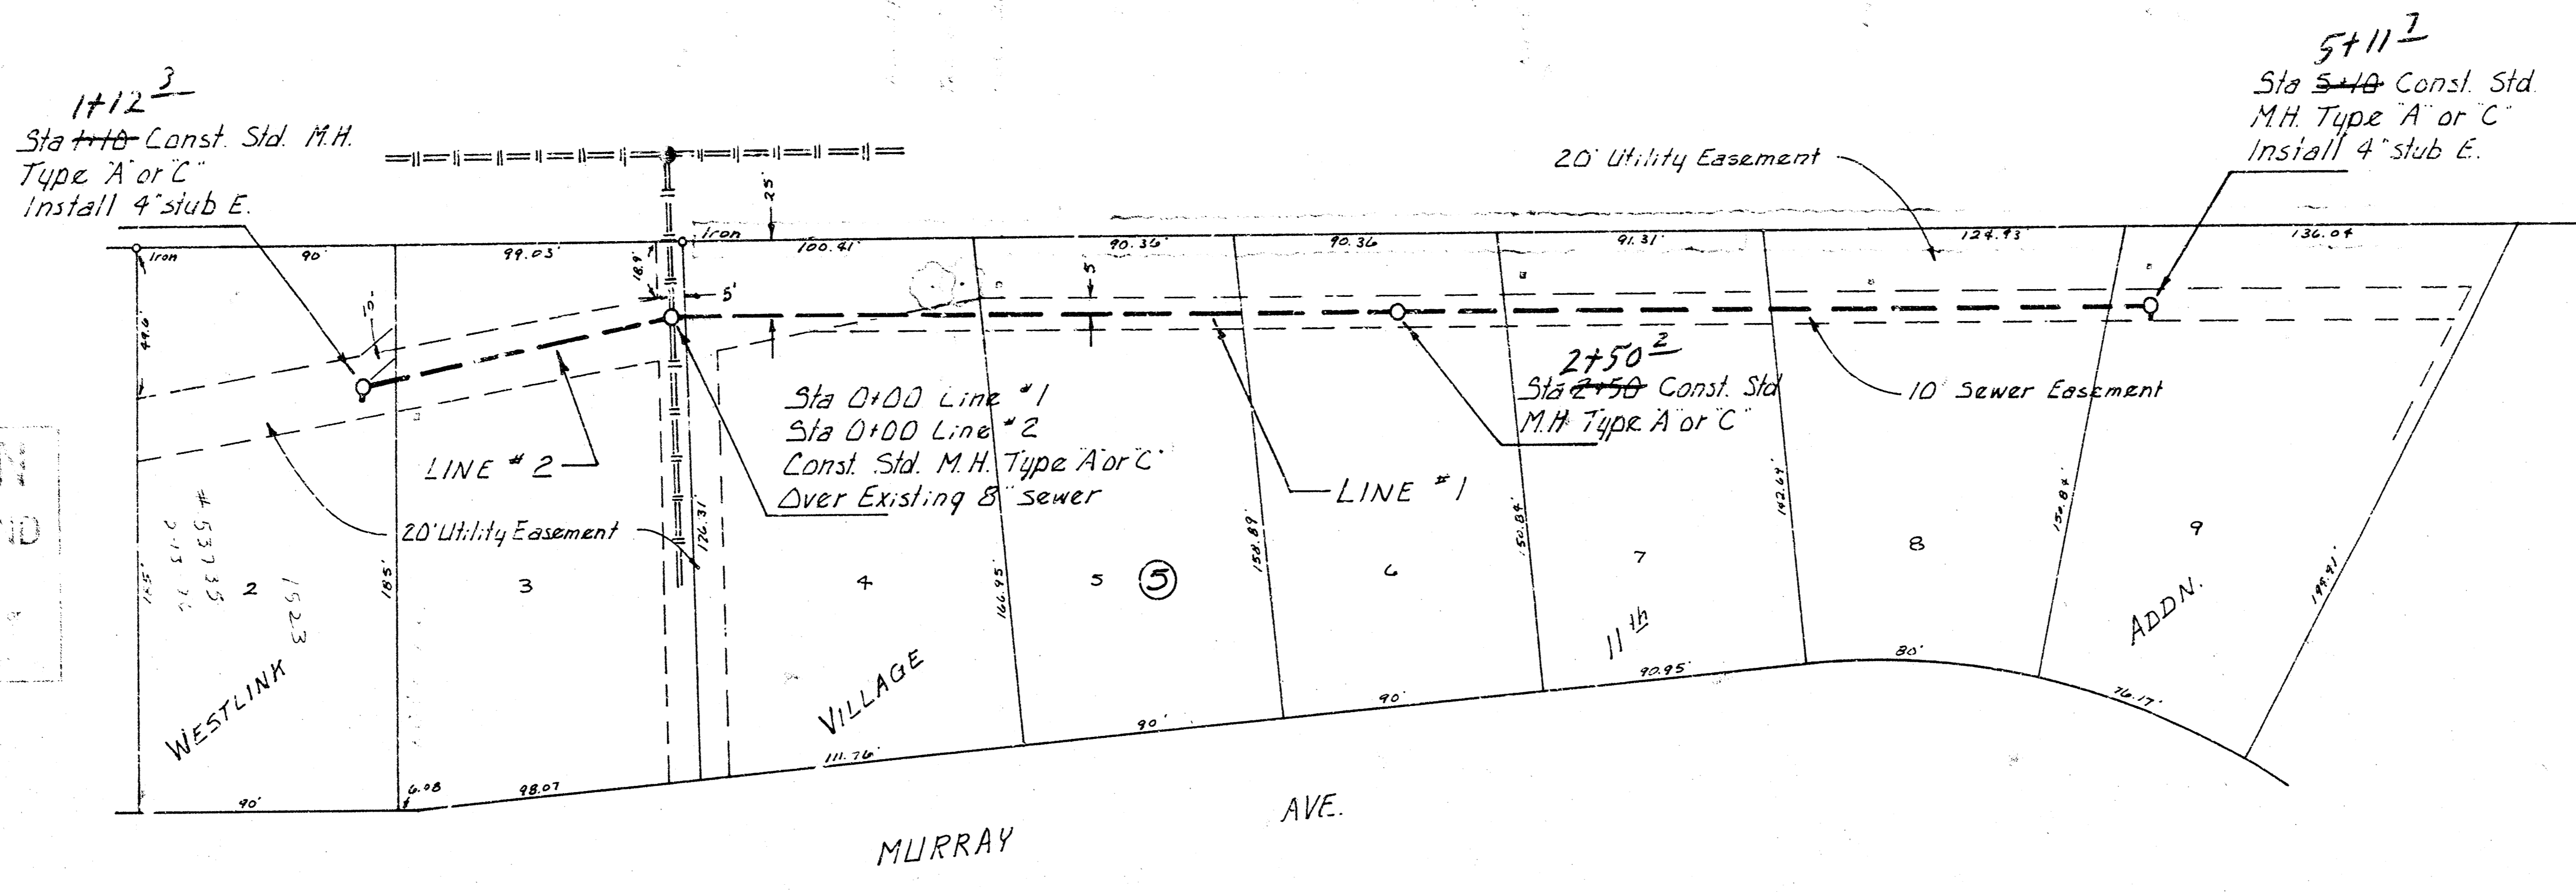

Scale Plan 1" = 40'
 Profile 1" = 40' Horiz.
 1" = 5' Vert.

B.M. 158.58 N.W. Corner conc. porch west side of house at 1502 Murray Ave.

0+00 Line #1, 0+00 Line #2
 Const. Std. M.H. Type A or C
 Over Existing 8" Sewer

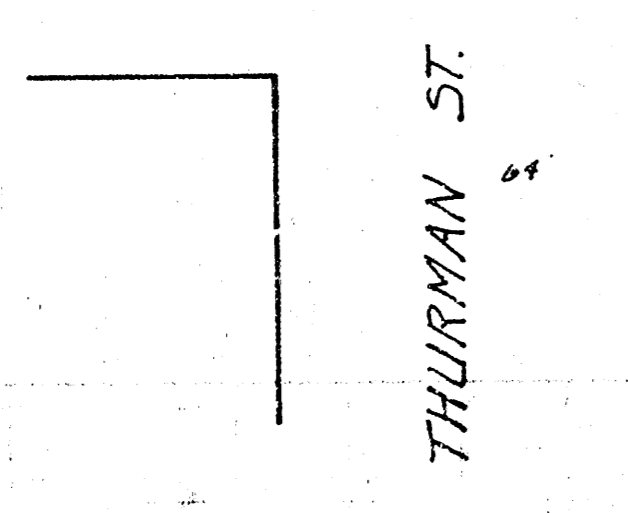


Sta 2+50 Const. Std.
 M.H. Type A or C

Sta 5+10 Const. Std.
 M.H. Type A or C
 Install 4" stub E.

Sta 0+00 Line #2
 Sta 0+00 Line #1

Sta 1+10 Const. Std.
 M.H. Type A or C
 Install 4" stub E.

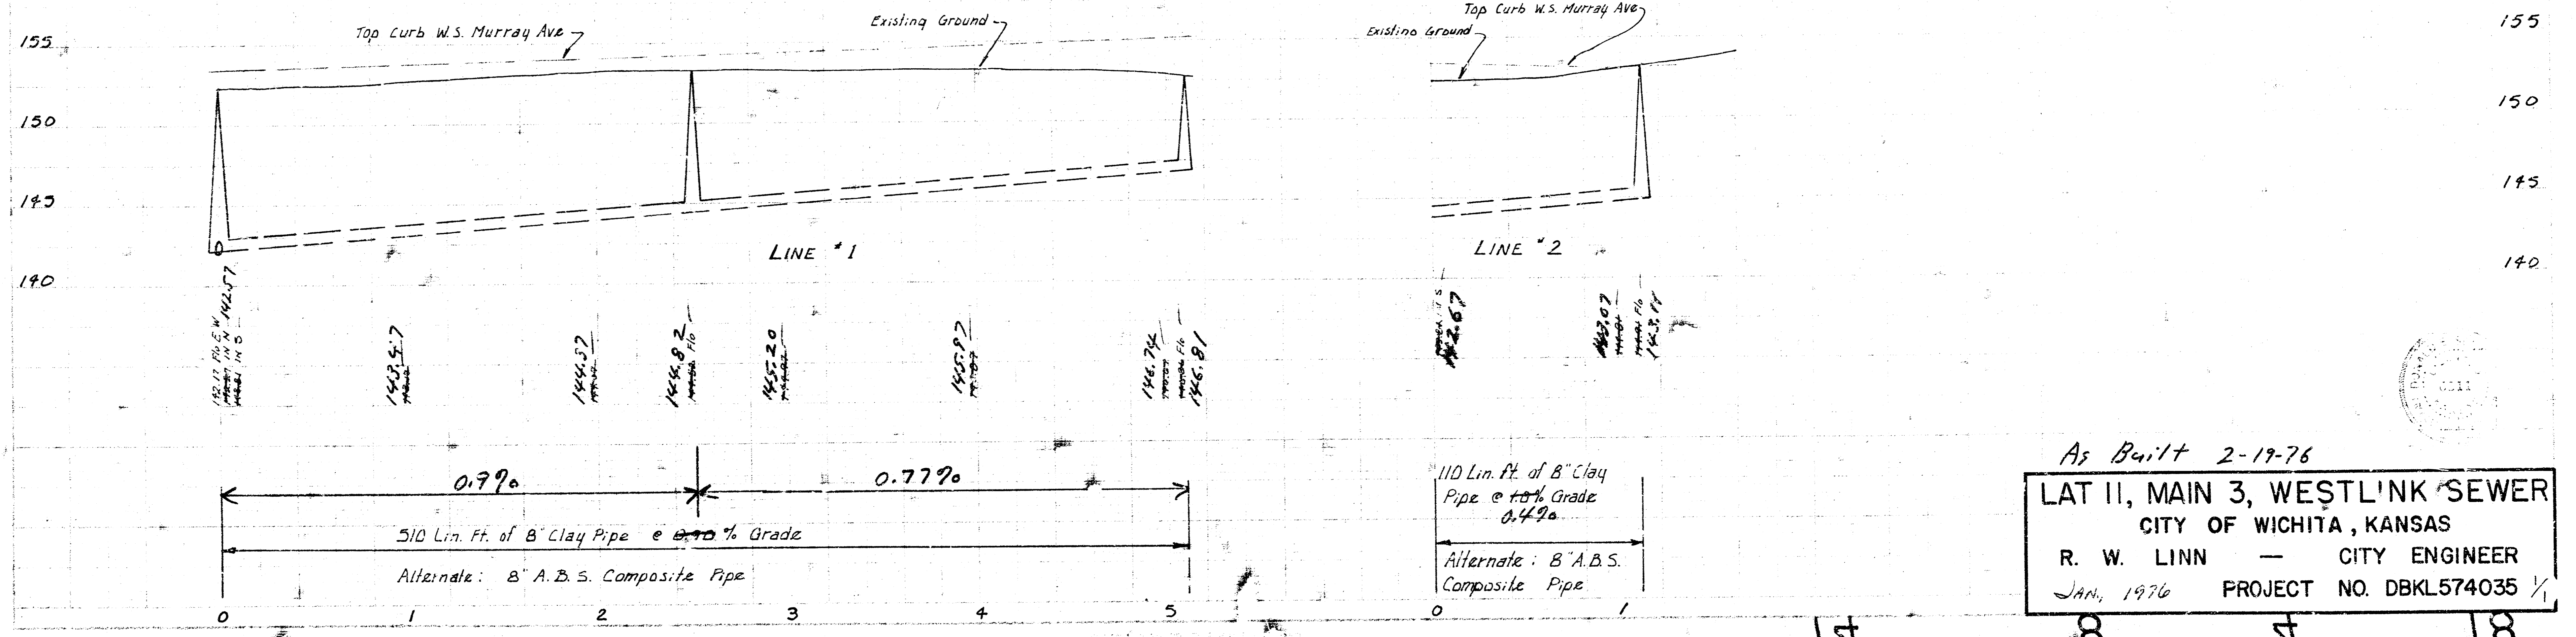

As Built 2-19-76
LAT II, MAIN 3, WESTLINK SEWER
 CITY OF WICHITA, KANSAS
 R. W. LINN — CITY ENGINEER
 Jan., 1976 PROJECT NO. DBKL574035 1/1